


|                                                                                  |          |      |
|----------------------------------------------------------------------------------|----------|------|
| PLAN                                                                             | SURVEYED | DATE |
| NO.                                                                              | BY       |      |
| NOTE: BOOK, PLOTTED, GRADES CHECKED, ALIGNED, CHECKED, BY, OF, AND, CHECKED, NO. |          |      |

|                                                                     |          |      |
|---------------------------------------------------------------------|----------|------|
| PROFILE                                                             | SURVEYED | DATE |
| NO.                                                                 | BY       |      |
| NOTE: BOOK, PLOTTED, GRADES CHECKED, STRUCTURE, NOTATIONS, CHD, NO. |          |      |



**RECORD DRAWING**

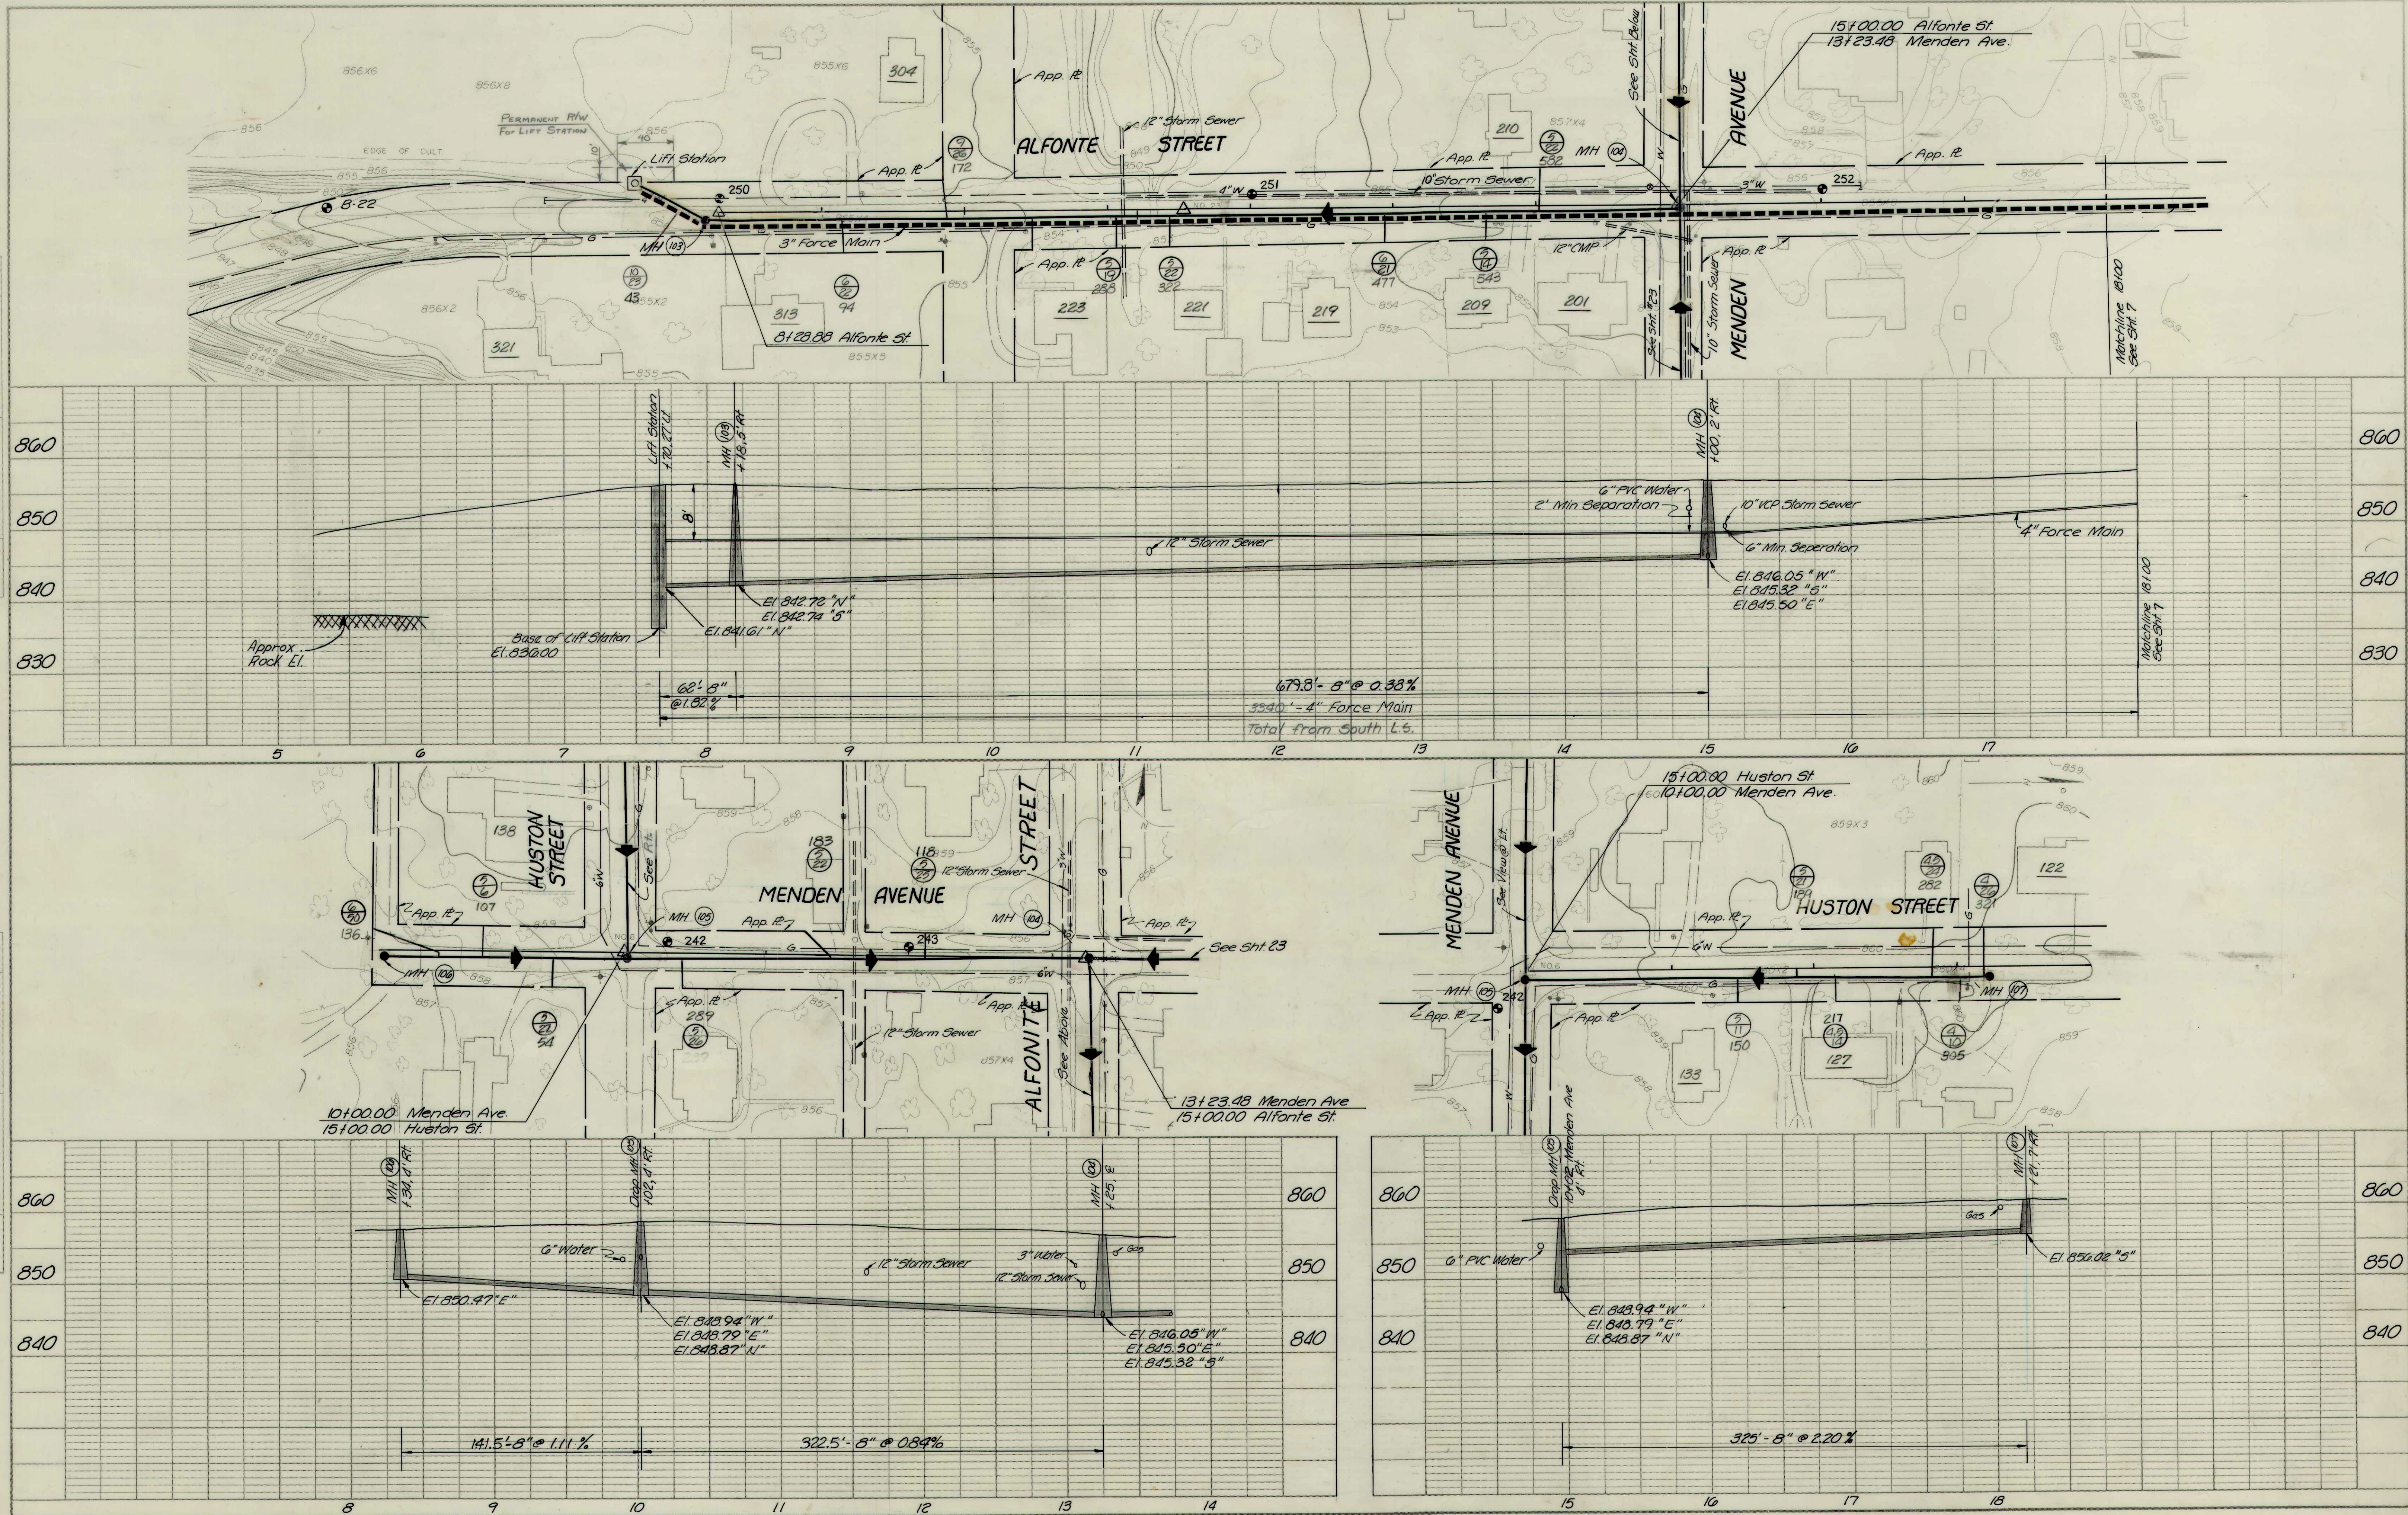

ALFONTE ST. MENDEN AVE.  
HUSTON ST.  
FALL CREEK R.W.D. PLAN & PROFILE SHEET  
HORIZ. 1"=50'  
VERT. 1"=10'  
BEAM, LONGST & NEFF, INC.  
CONSULTING ENGINEERS  
INDIANAPOLIS, INDIANA  
21