
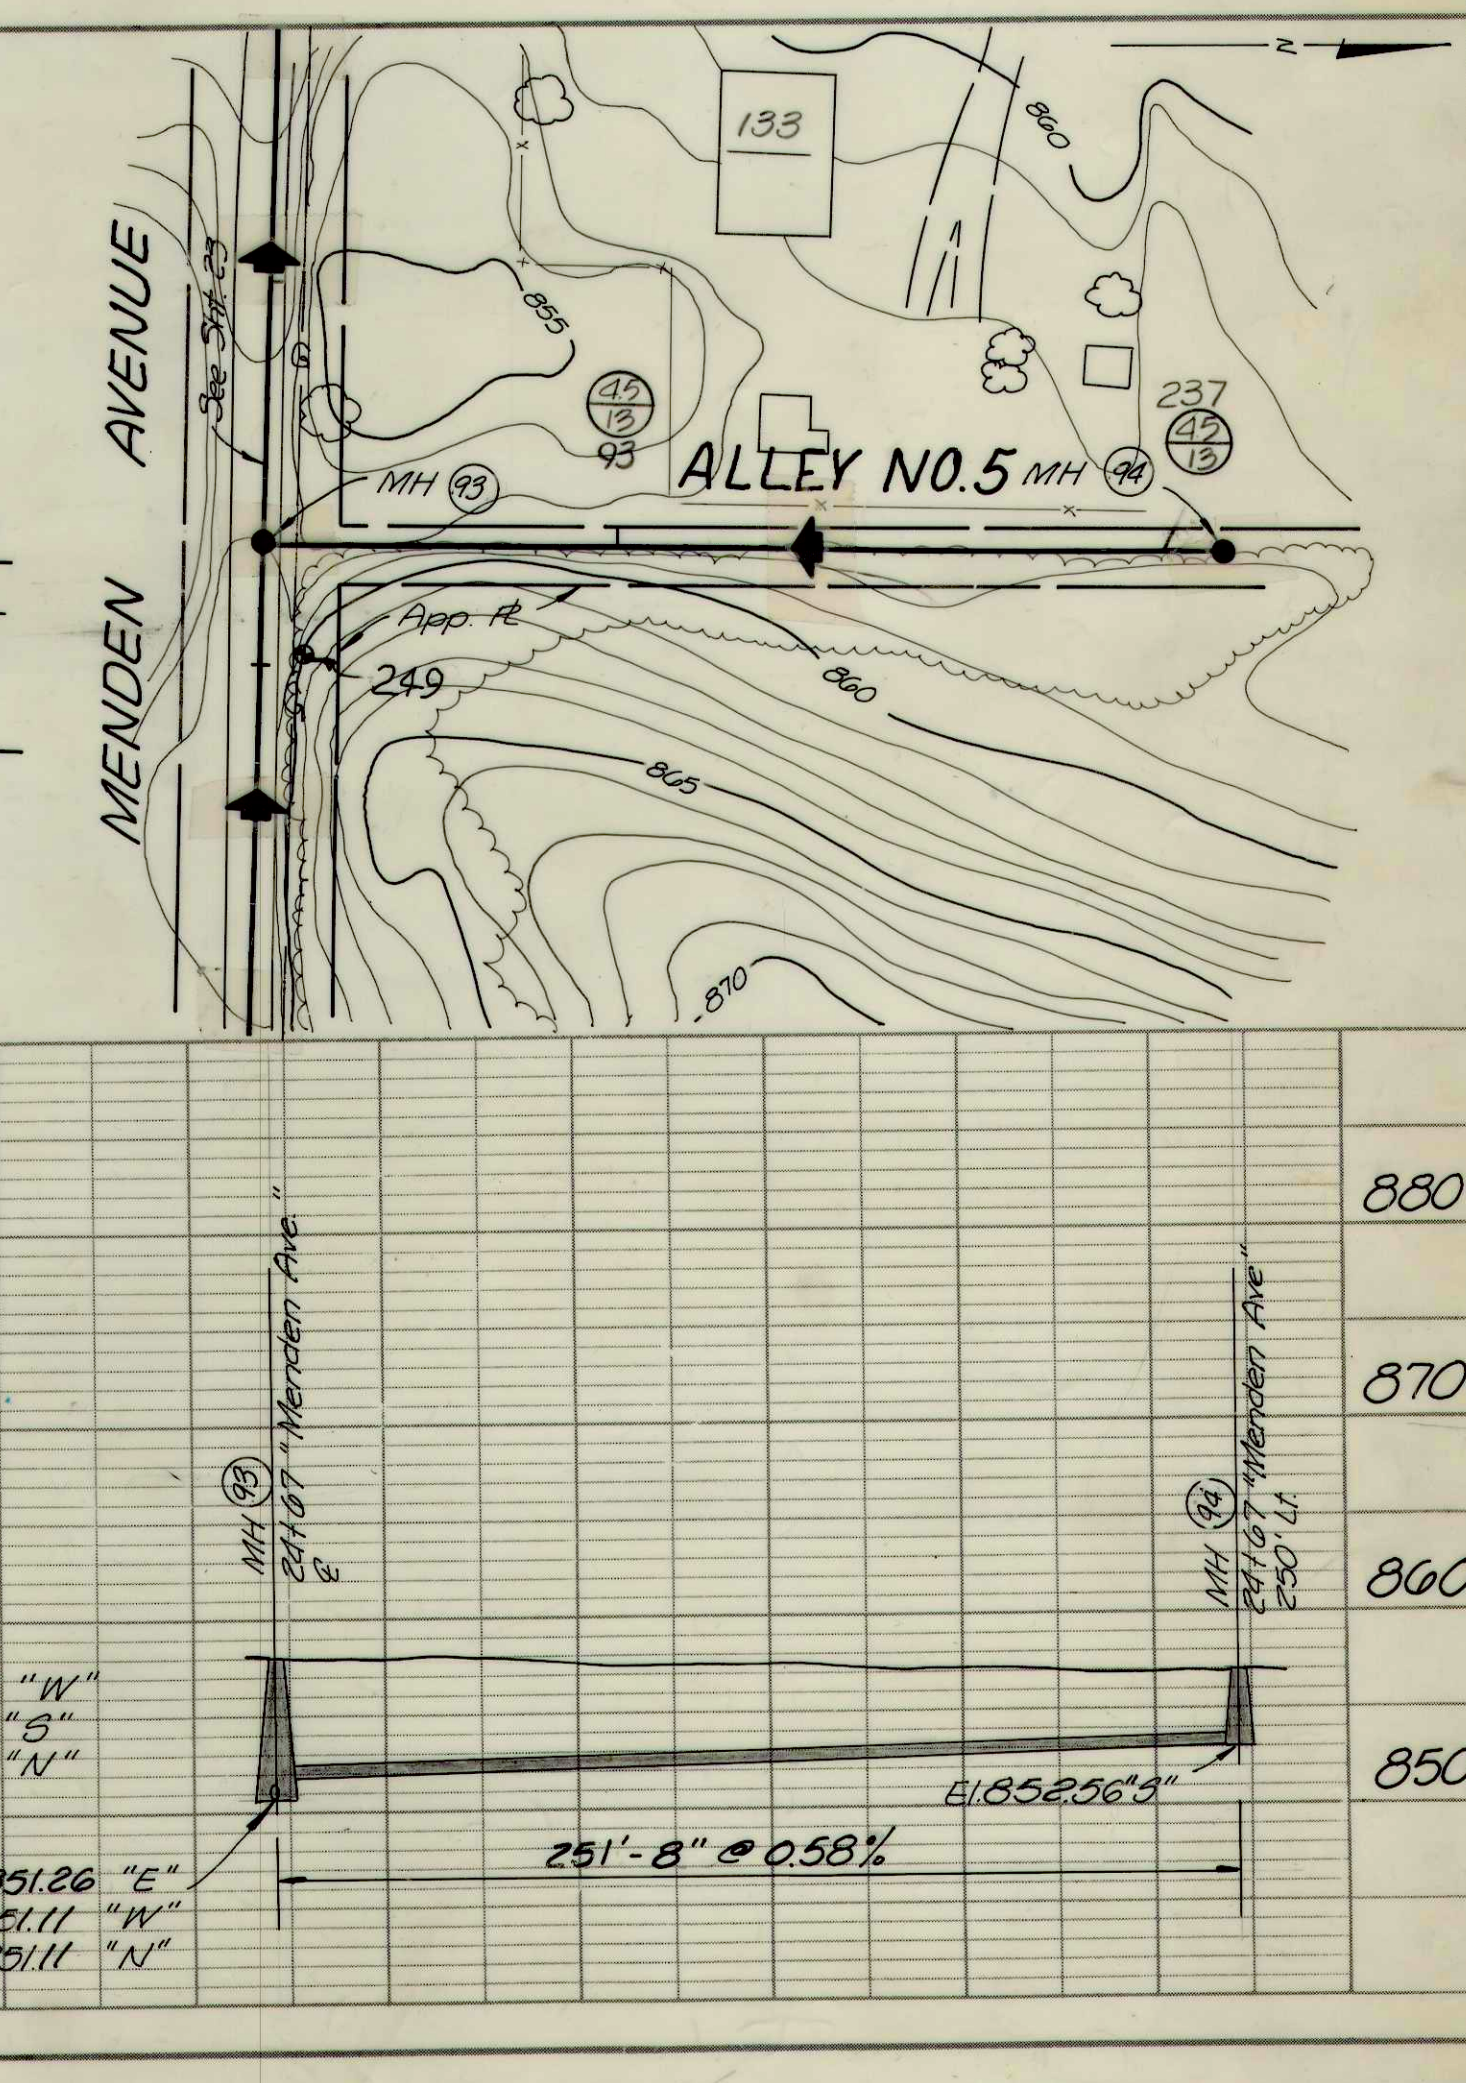
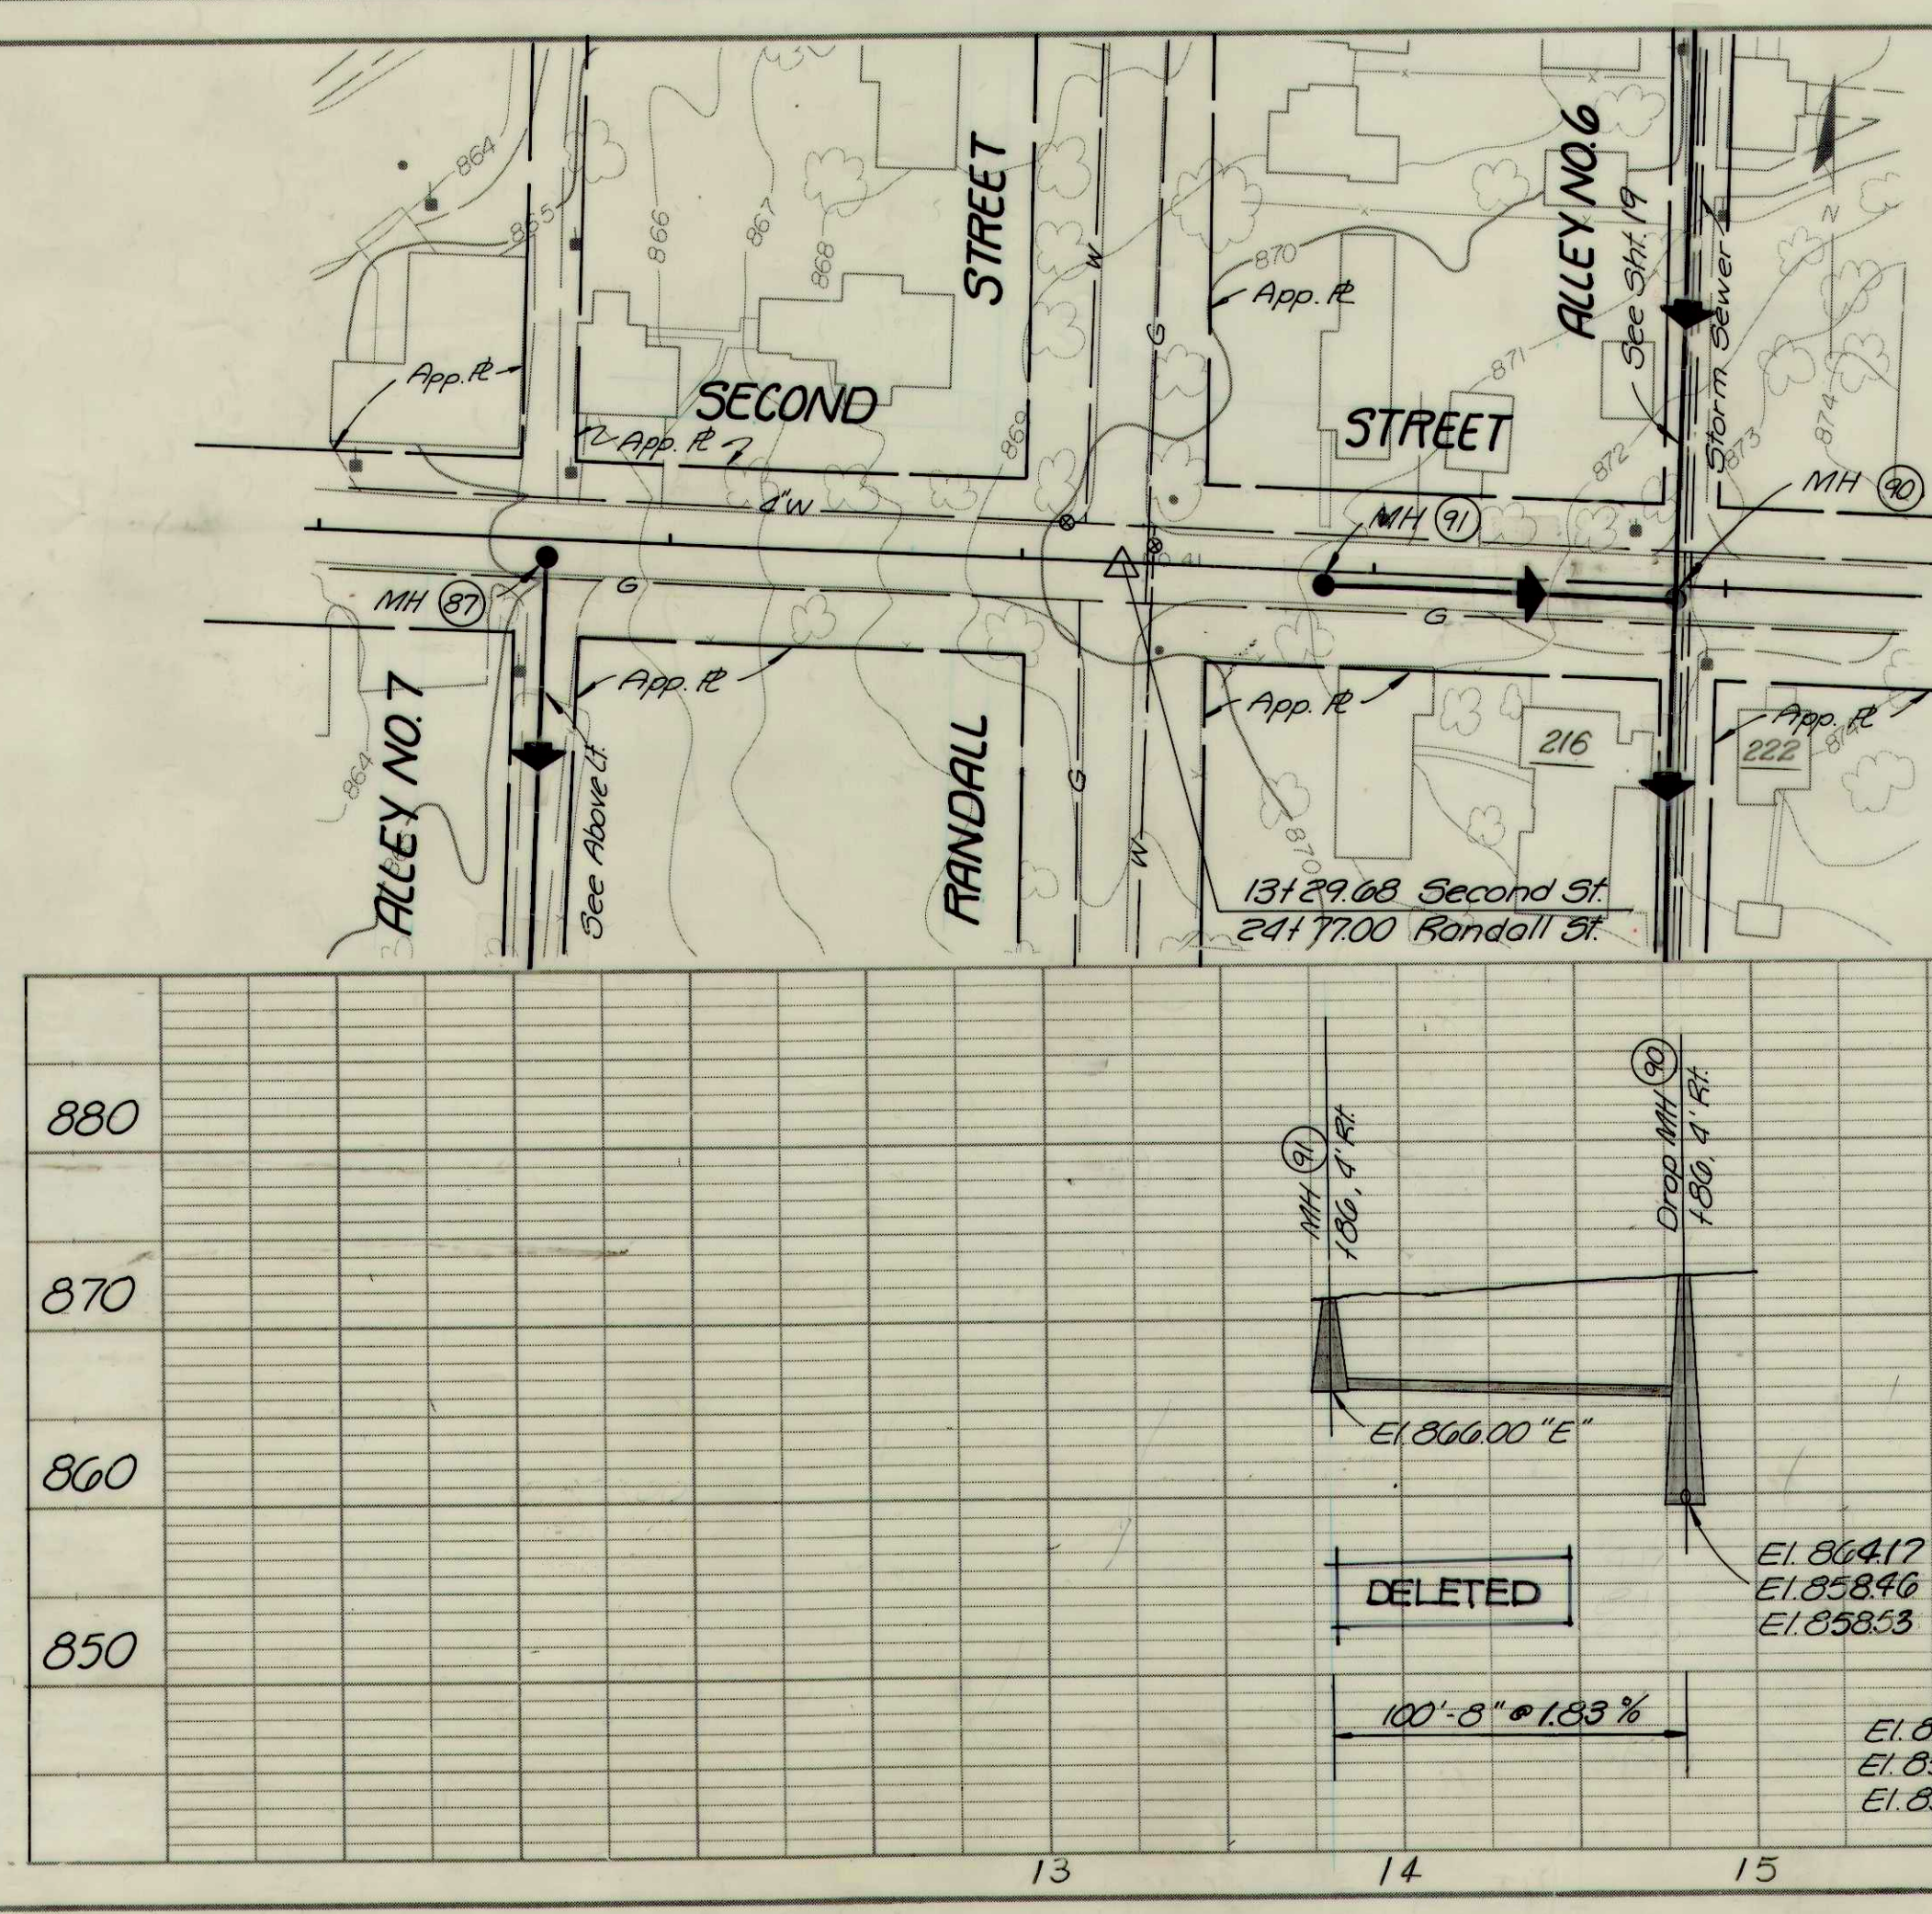
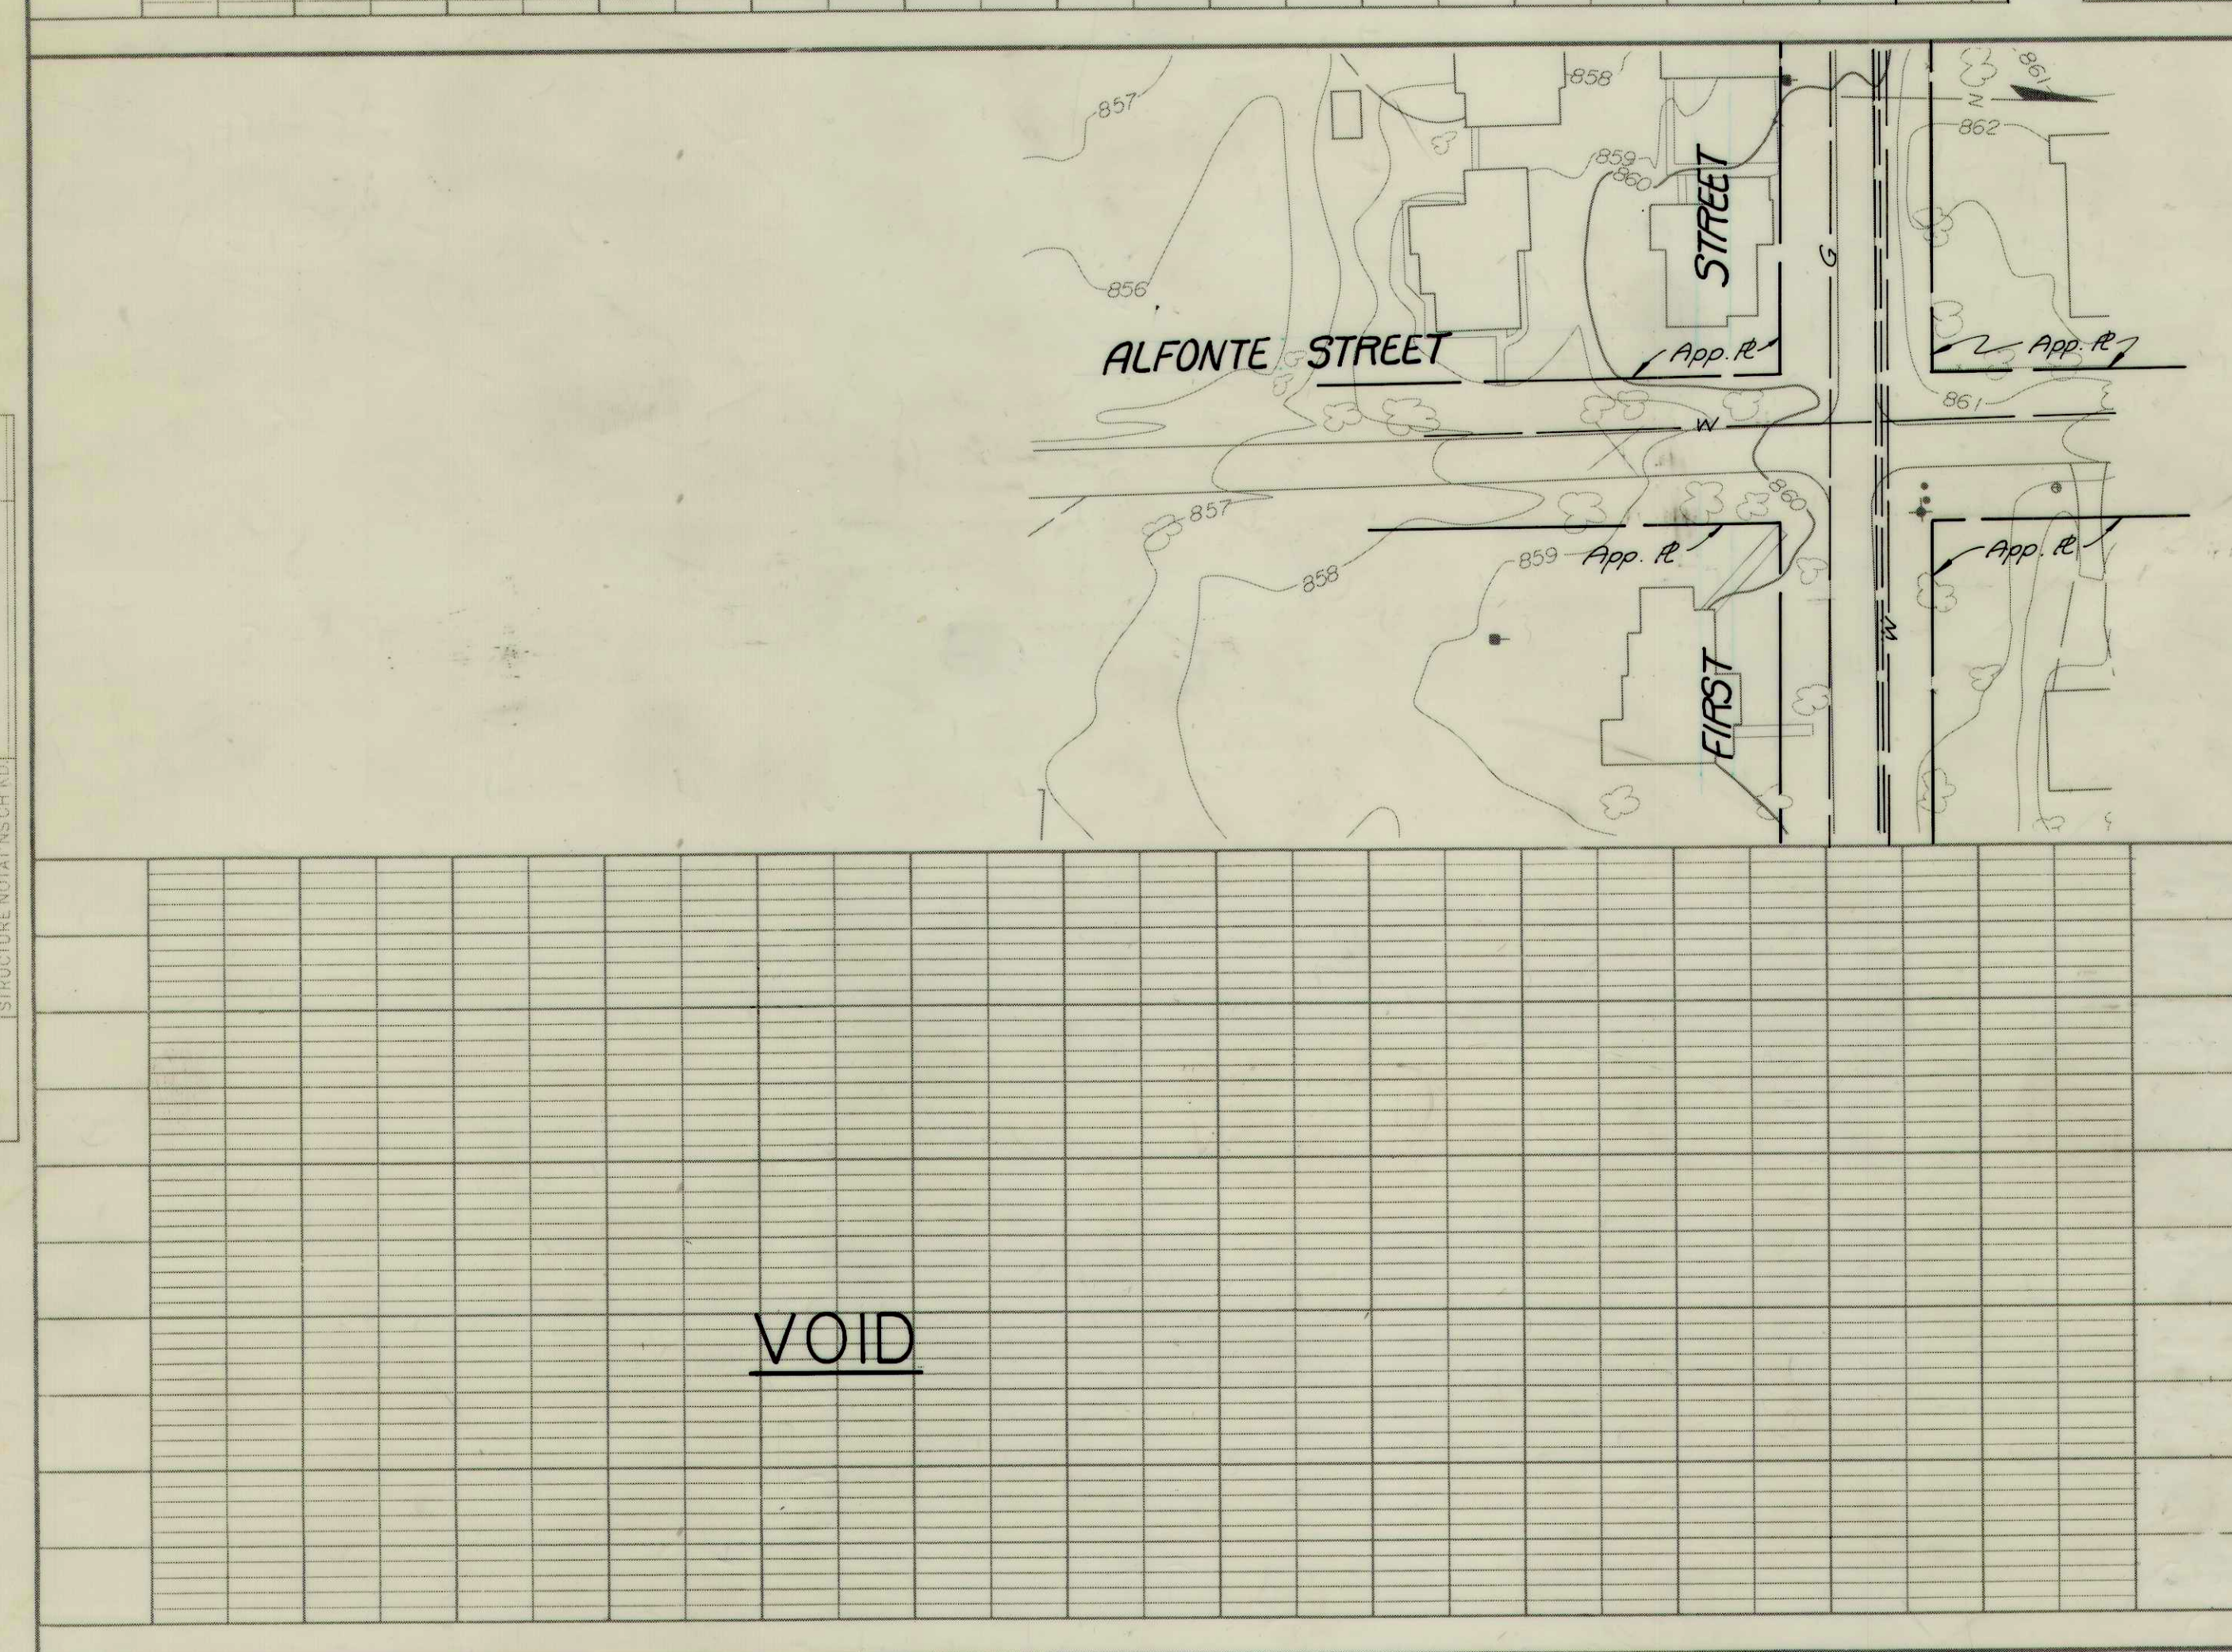


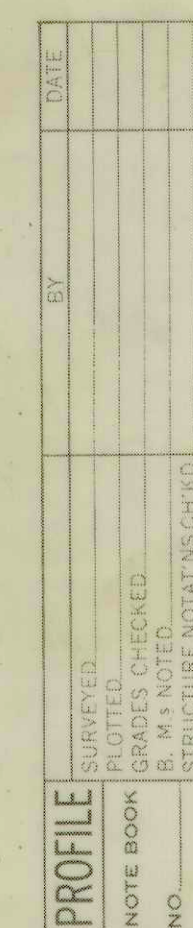

ERIC RESKE
REGISTERED
No. 13442
3-30-02
STATE OF
INDIANA
PROFESSIONAL ENGINEER

22