

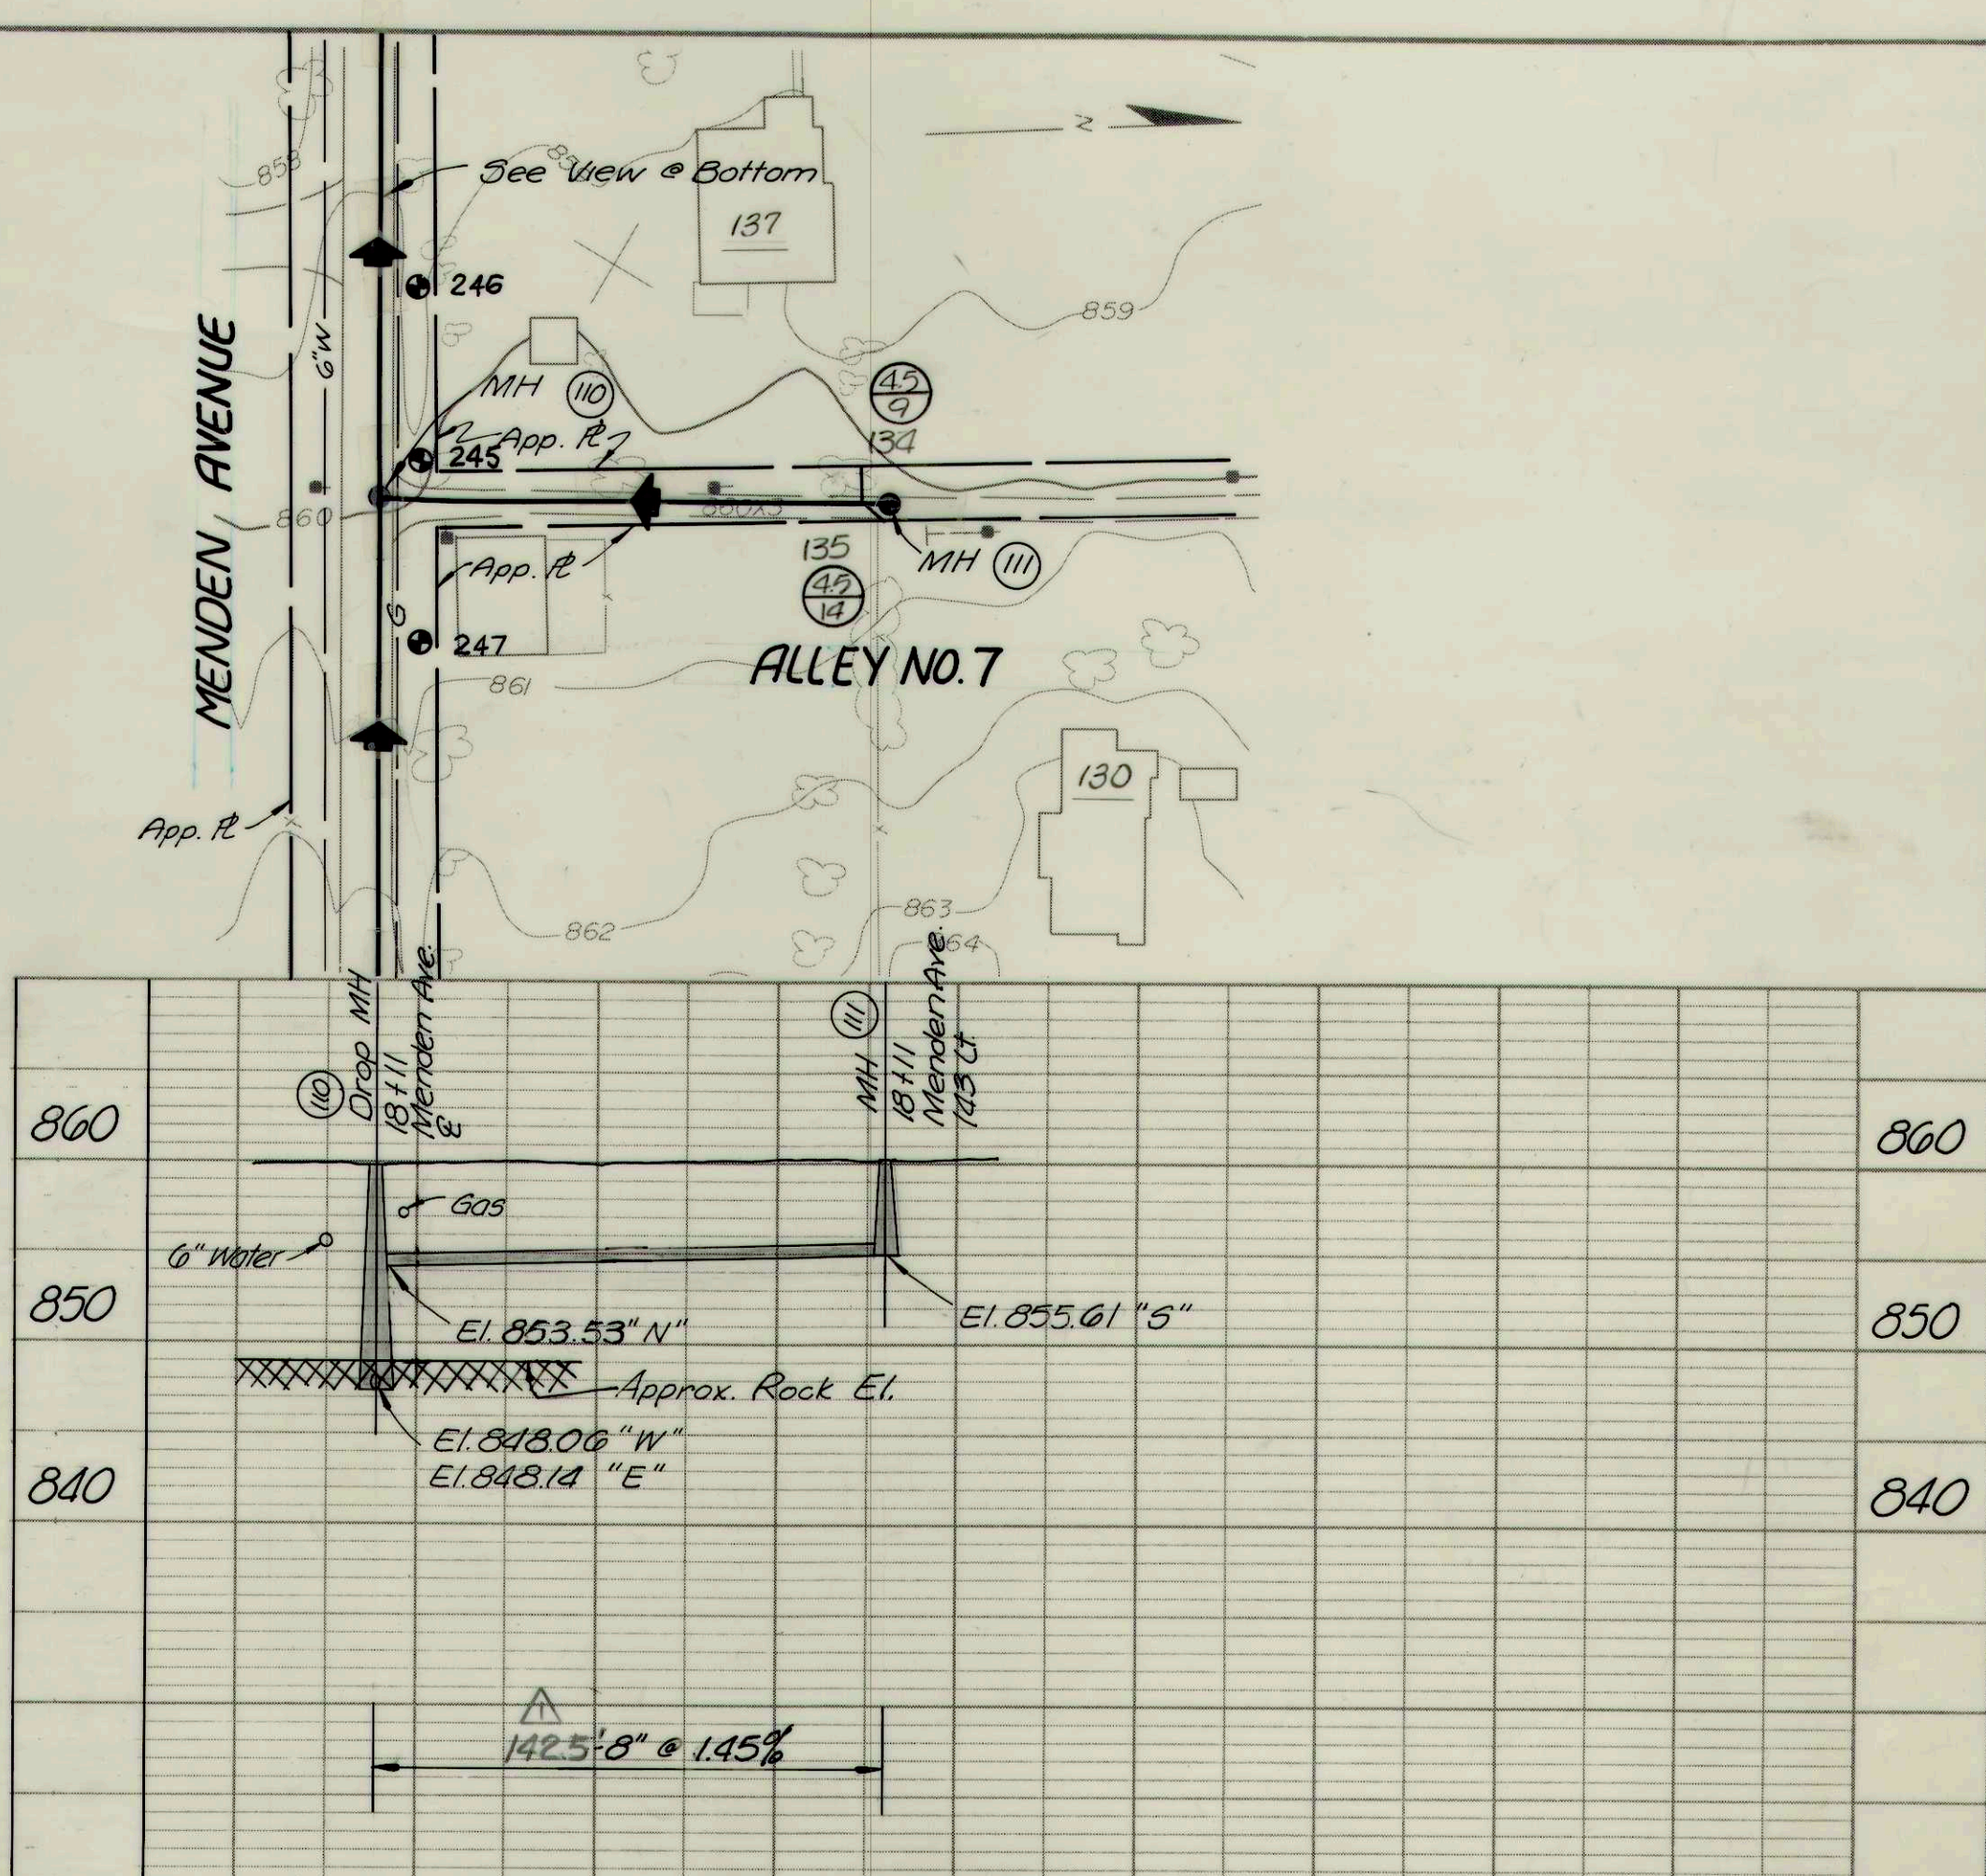
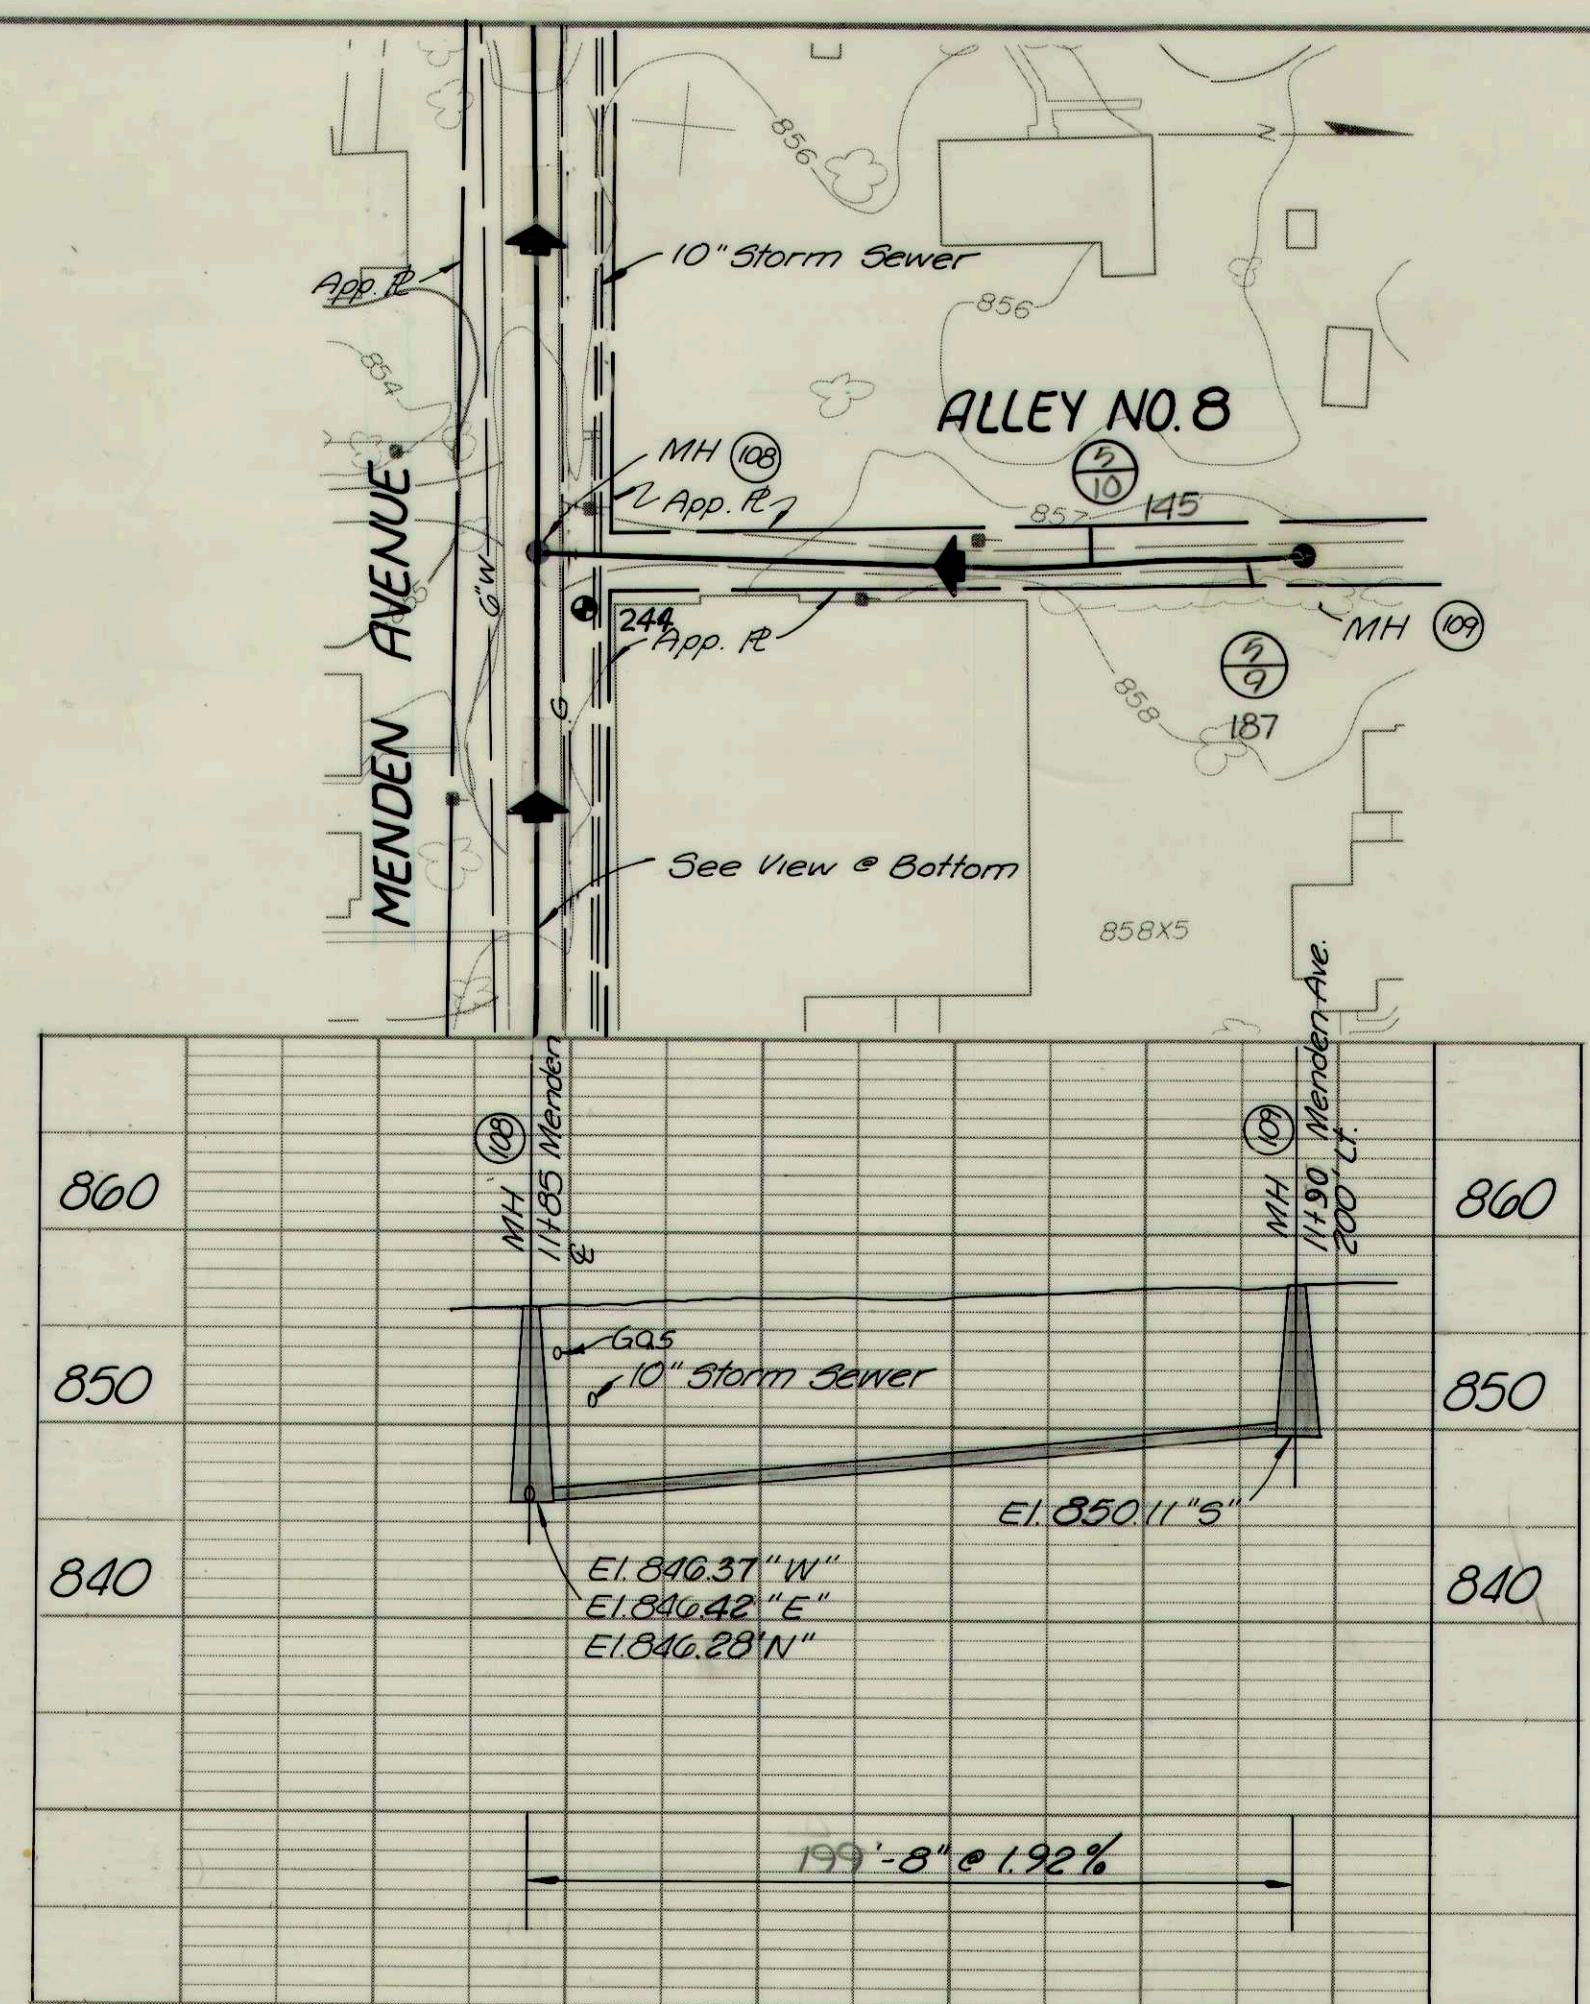


PLAN
 SURVEYED BY DATE
 PLOTTED BY DATE
 NOTE BOOK NO. CHECKED BY DATE
 ET. OF WAY CHECKED BY DATE

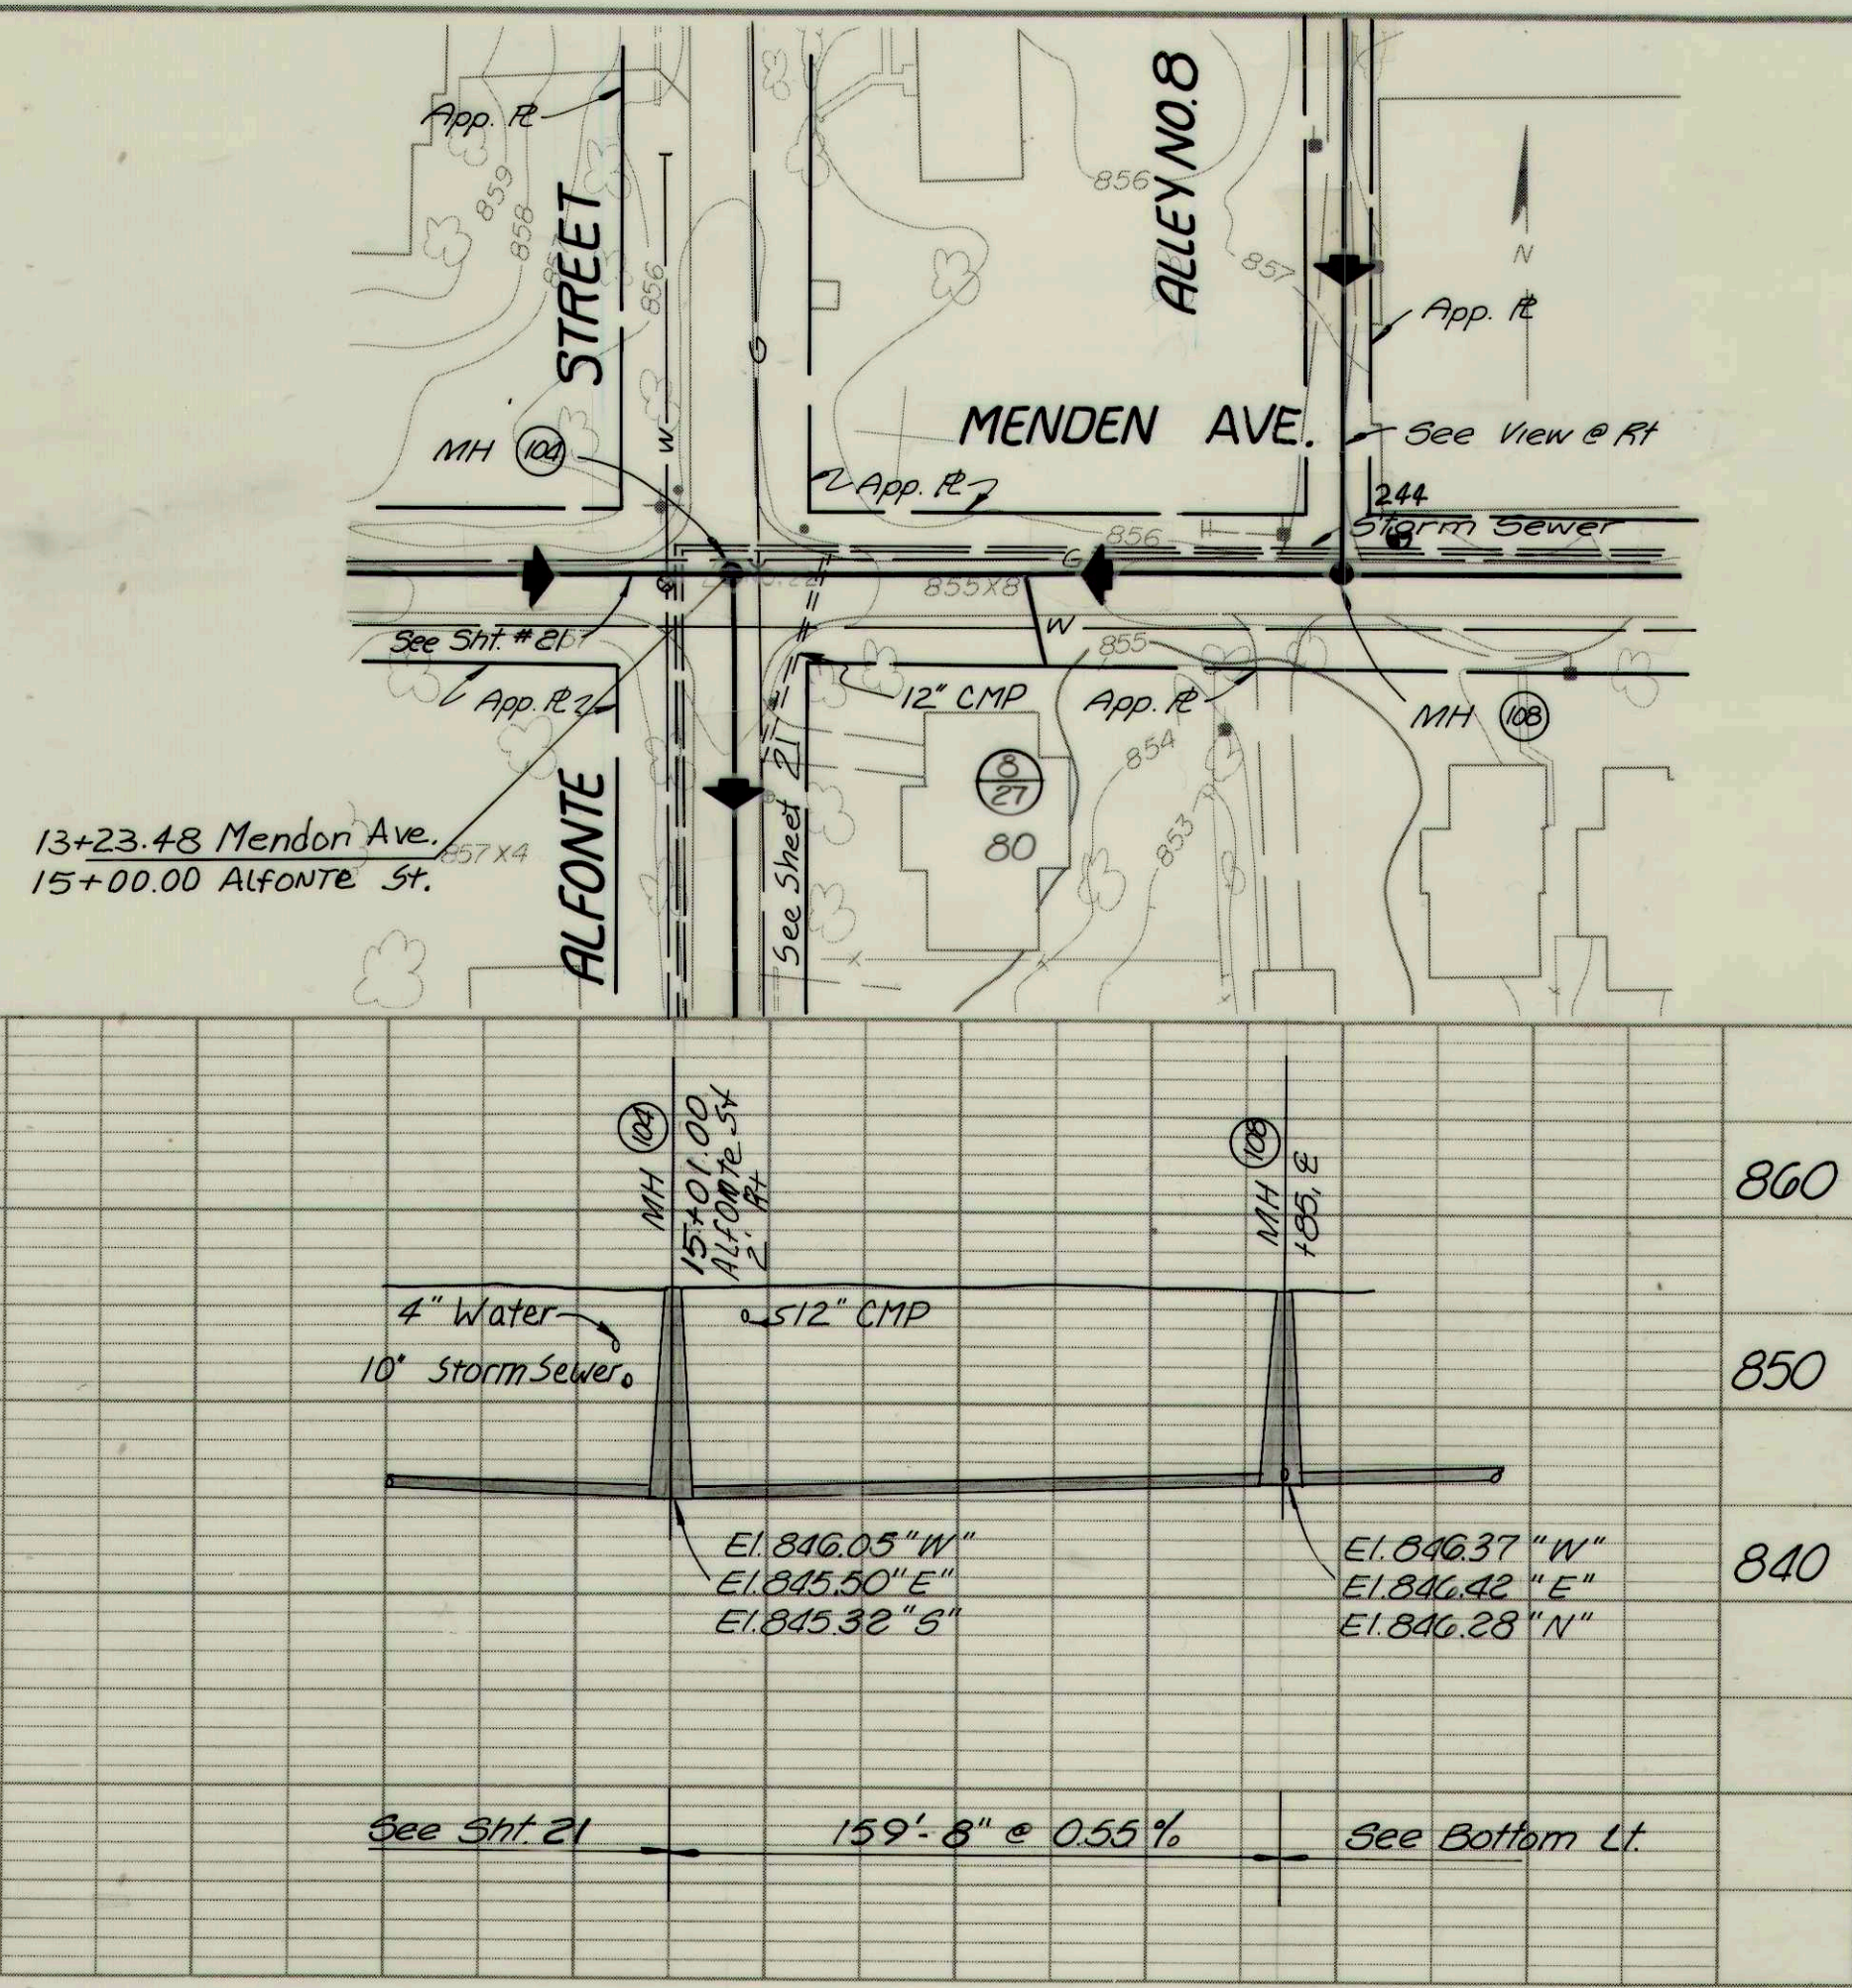

PROFILE
 SURVEYED BY DATE
 PLOTTED BY DATE
 NOTE BOOK NO. CHECKED BY DATE
 ELEVATION NOTATIONS CHG. BY DATE

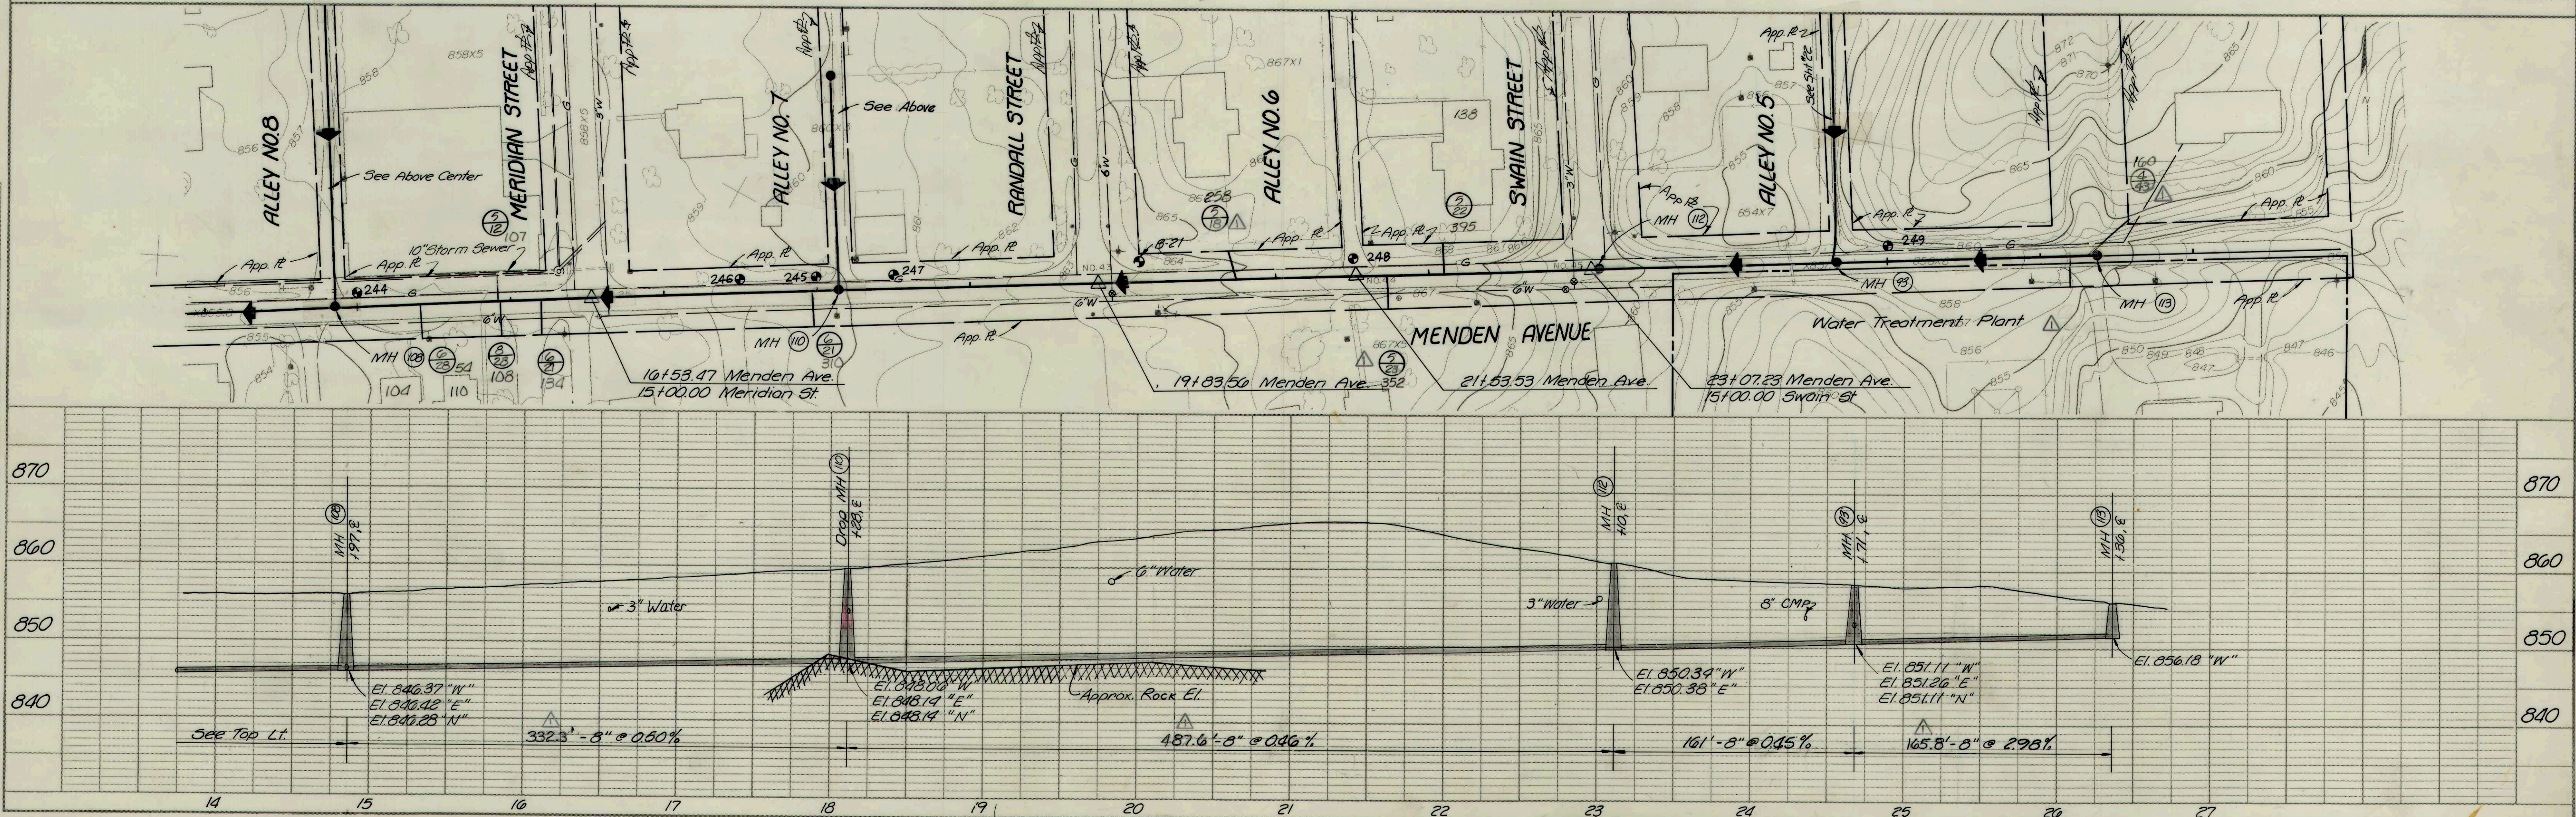

RECORD DRAWING

Δ REVISED 4-17-86



ALLEY #7 & 8 MENDEN AVE.
 FALL CREEK R.W.D. PLAN & PROFILE SHEET
 HORIZ. 1"=50'
 VERT. 1"=10'
 BEAM, LONGEST & NEFF, INC.
 CONSULTING ENGINEERS
 INDIANAPOLIS, INDIANA
 23