
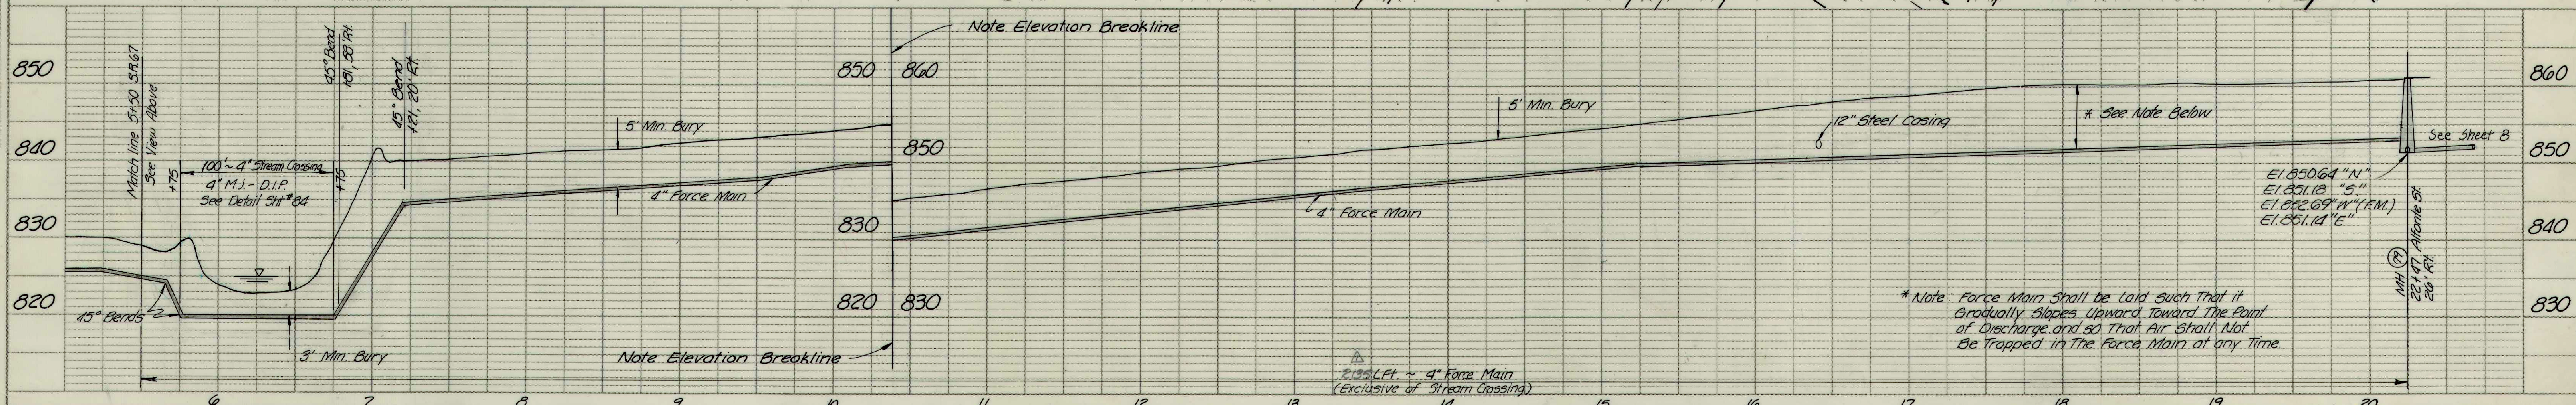
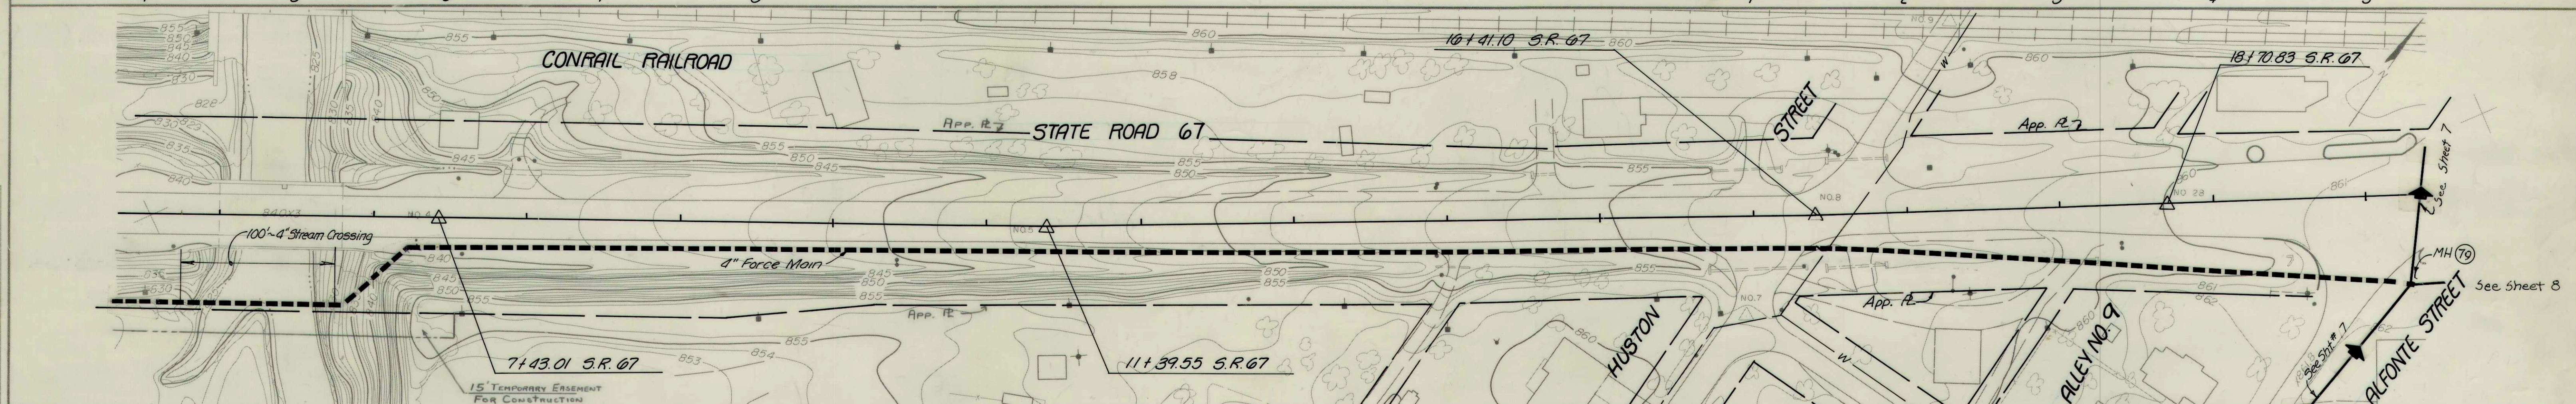
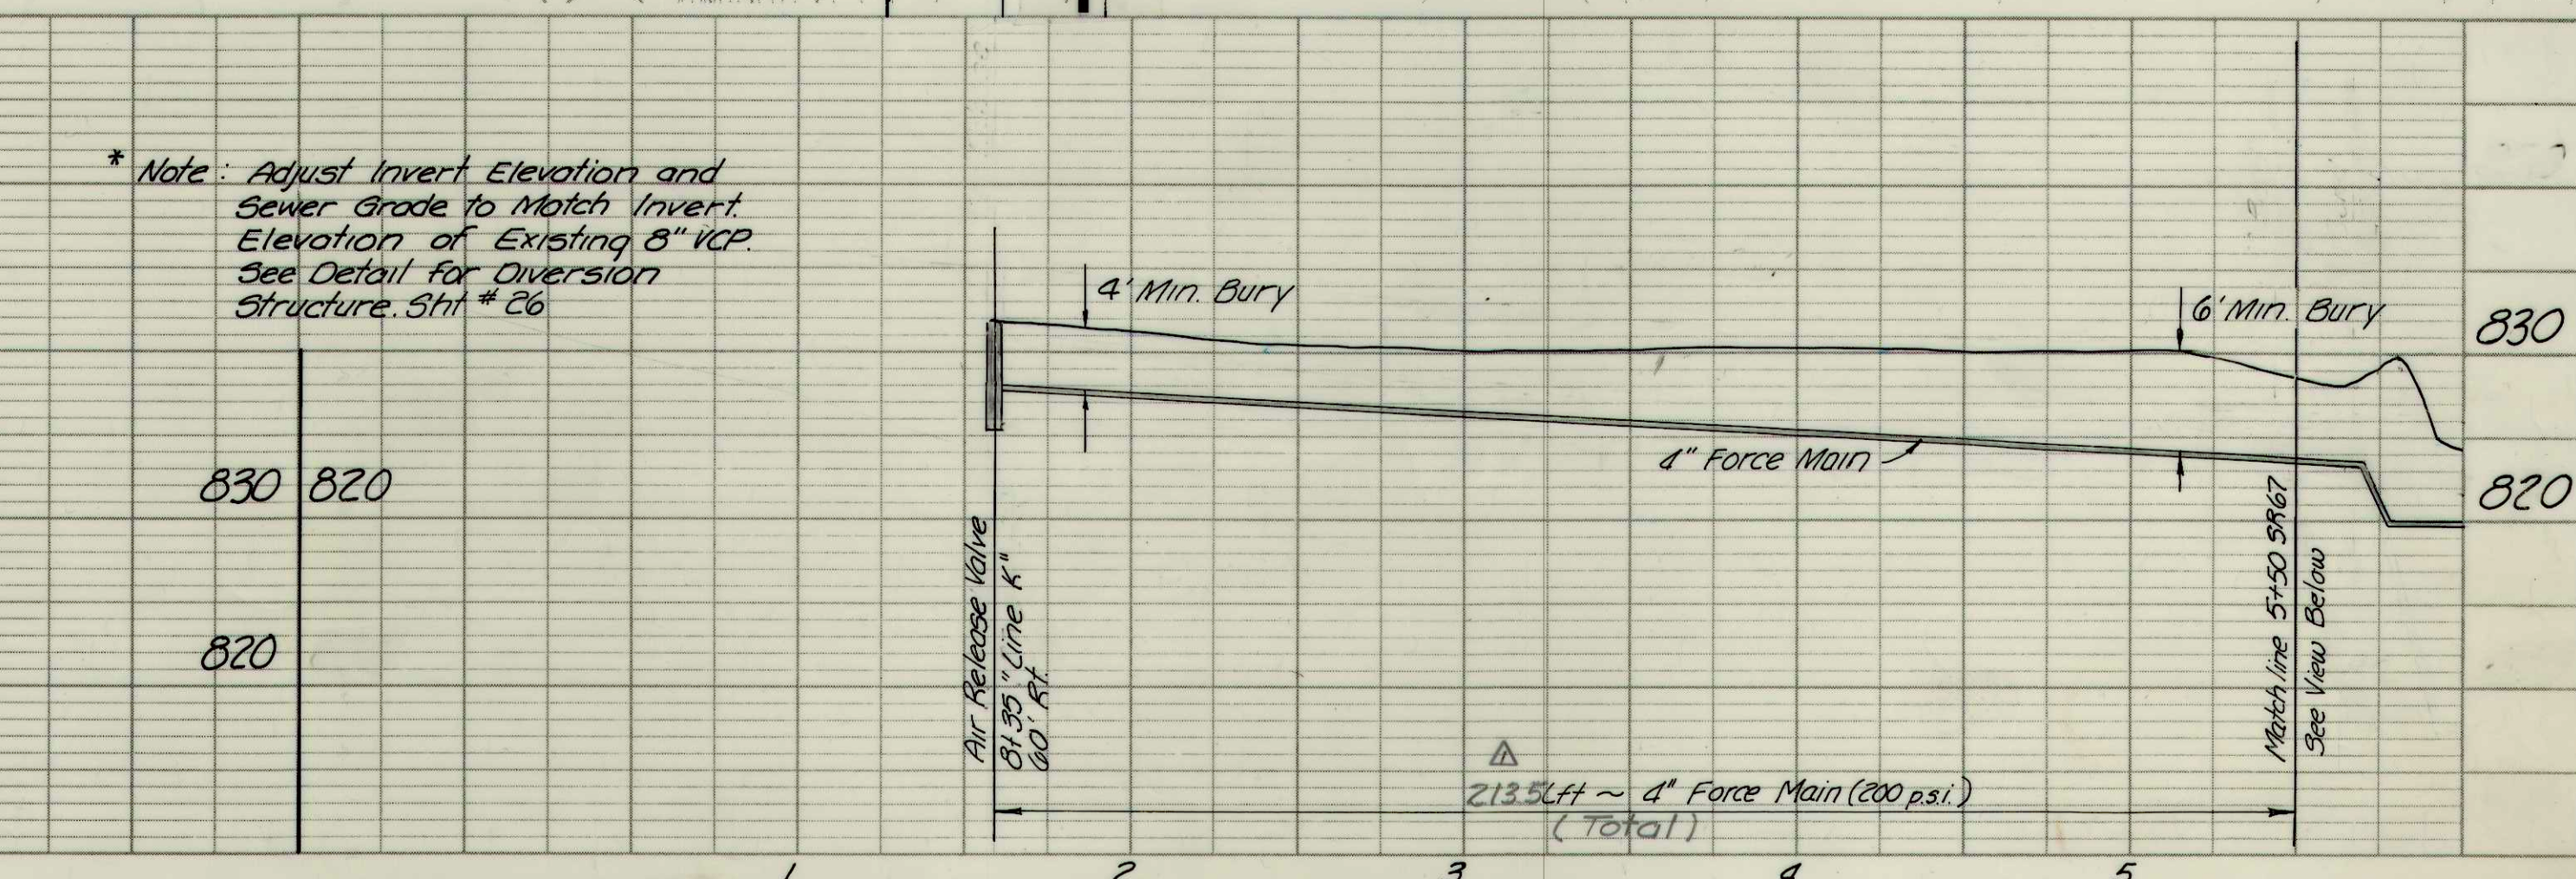
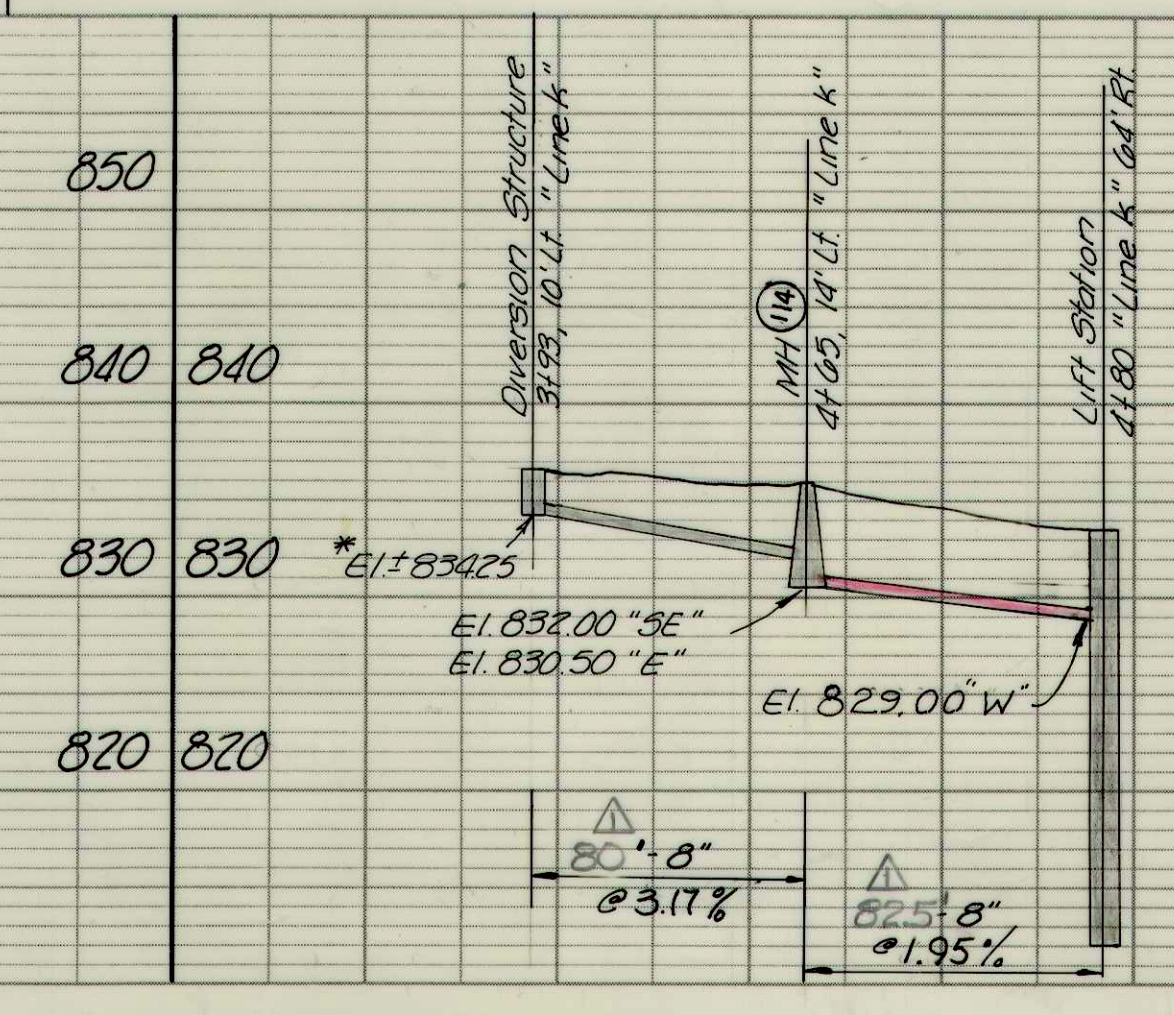
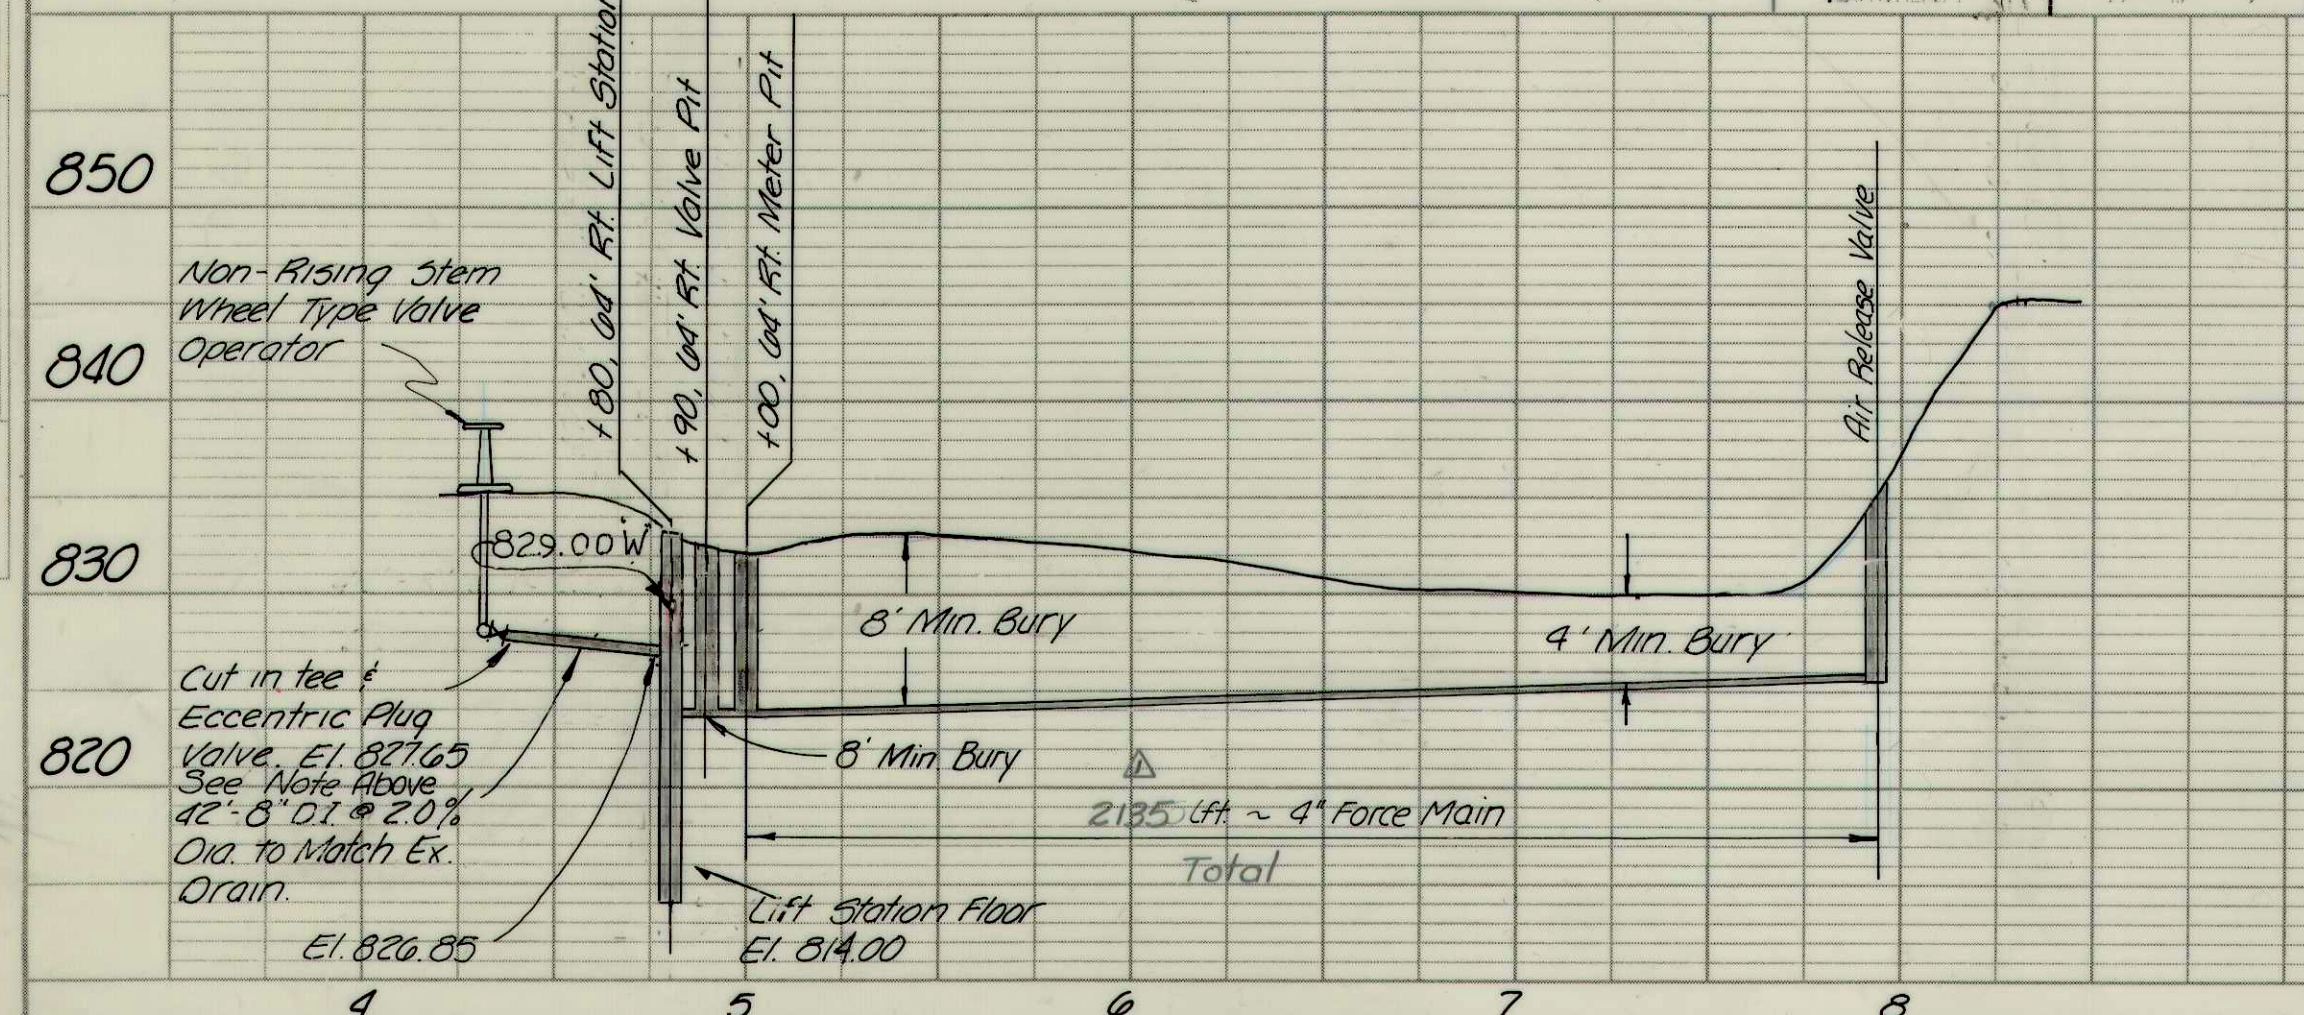


PLAN
 SURVEYED
 PLOTTED
 NOTE BOOK
 NO.

PROFILE
 SURVEYED
 PLOTTED
 NOTE BOOK
 NO.

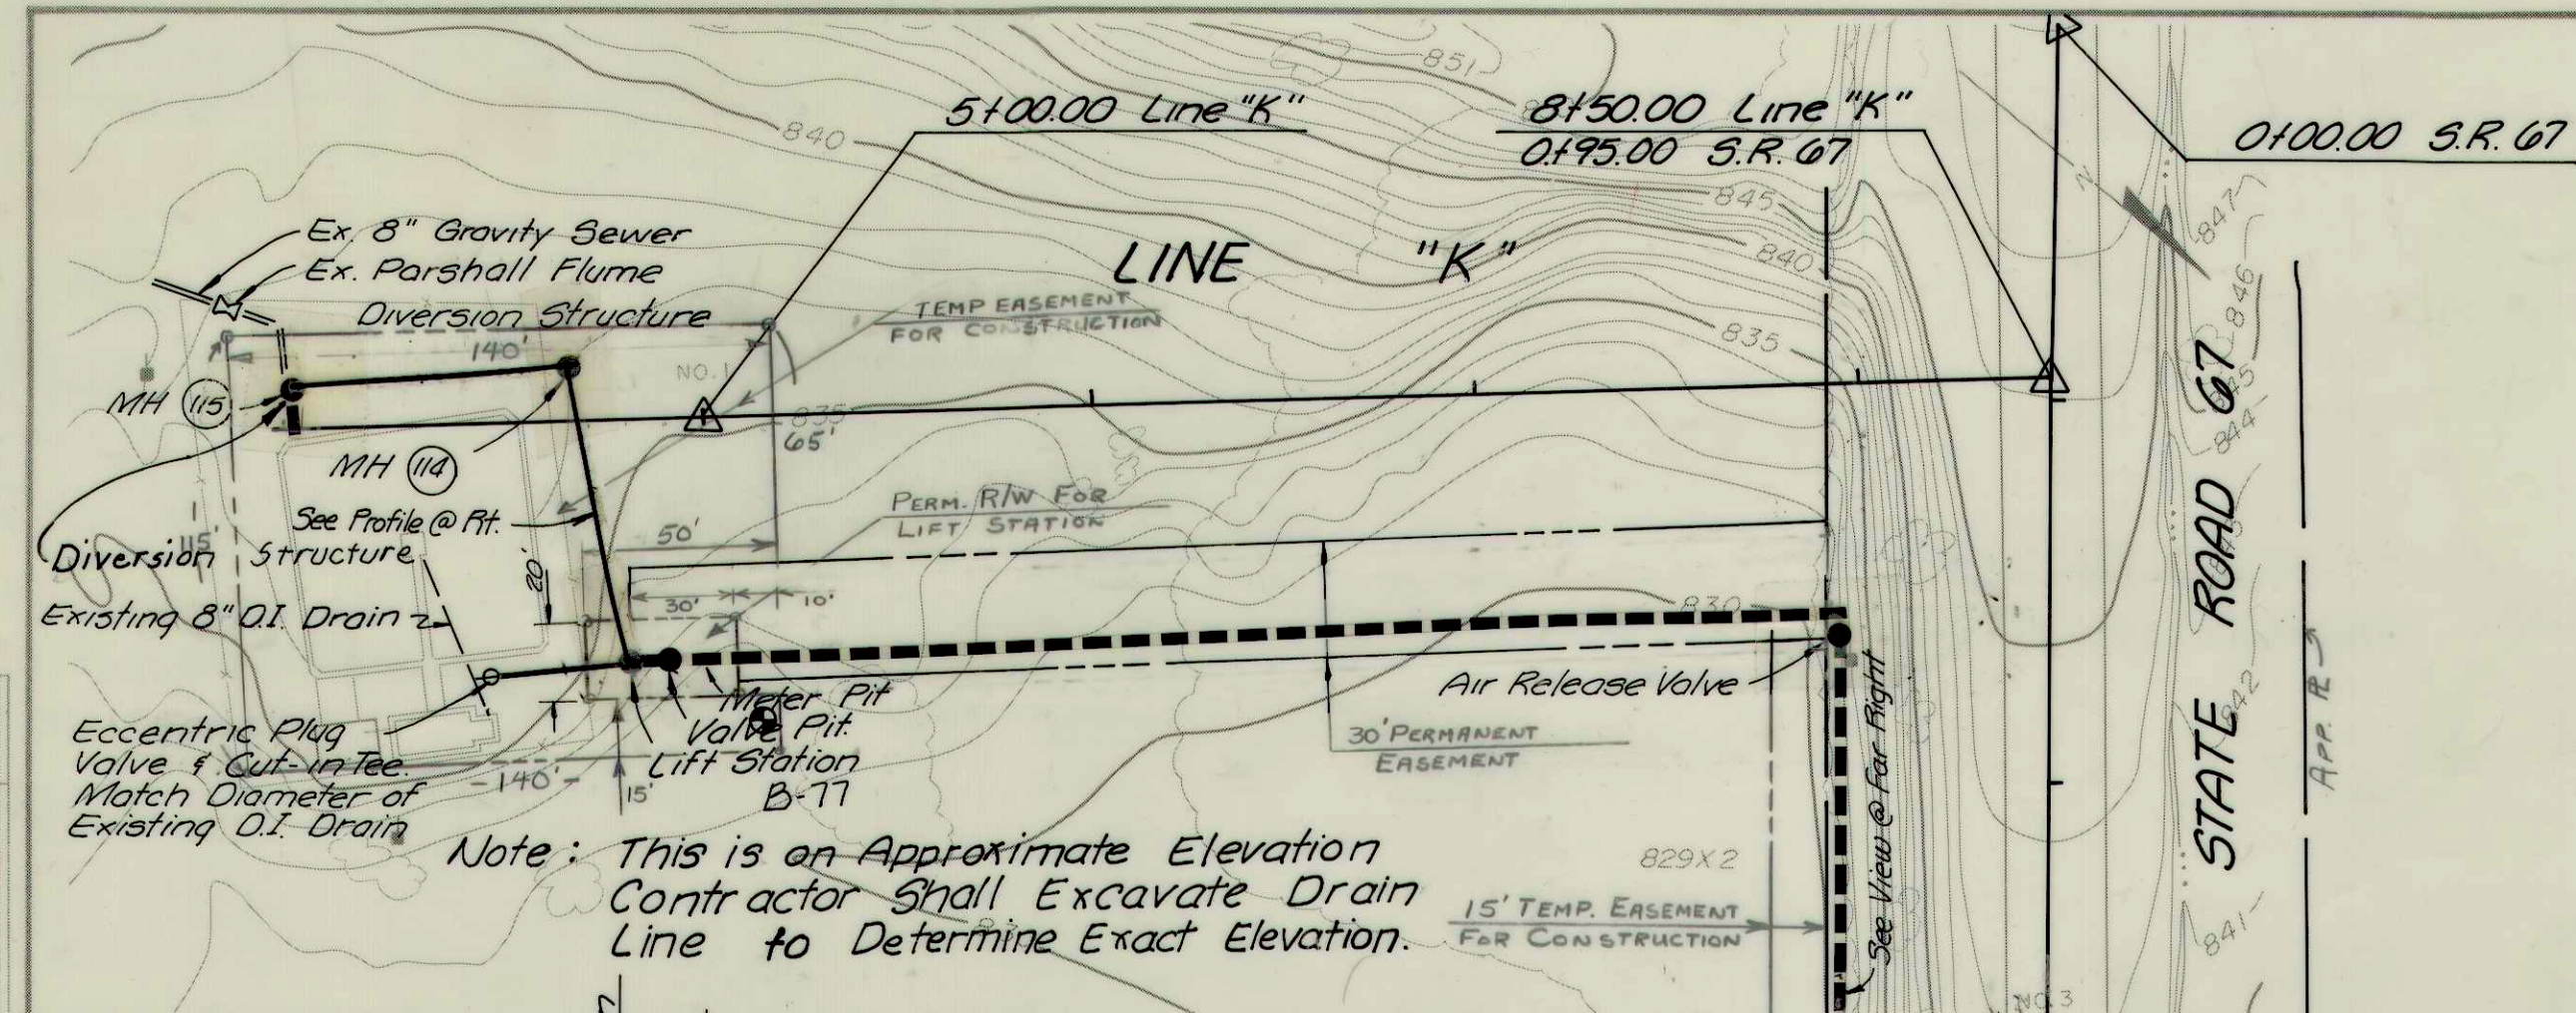

Δ TOTAL ALL 4" F.M. THIS SEC. 2135'

RECORD DRAWING
 Δ REVISED 4-17-86



STATE ROAD 67 & LINE "K"
 FALL CREEK R.W.D. PLAN & PROFILE SHEET
 HORIZ. 1"=50'
 VERT. 1"=10'
 BEAM, LONGEST & NEFF, INC.
 CONSULTING ENGINEERS
 INDIANAPOLIS, INDIANA
 24