

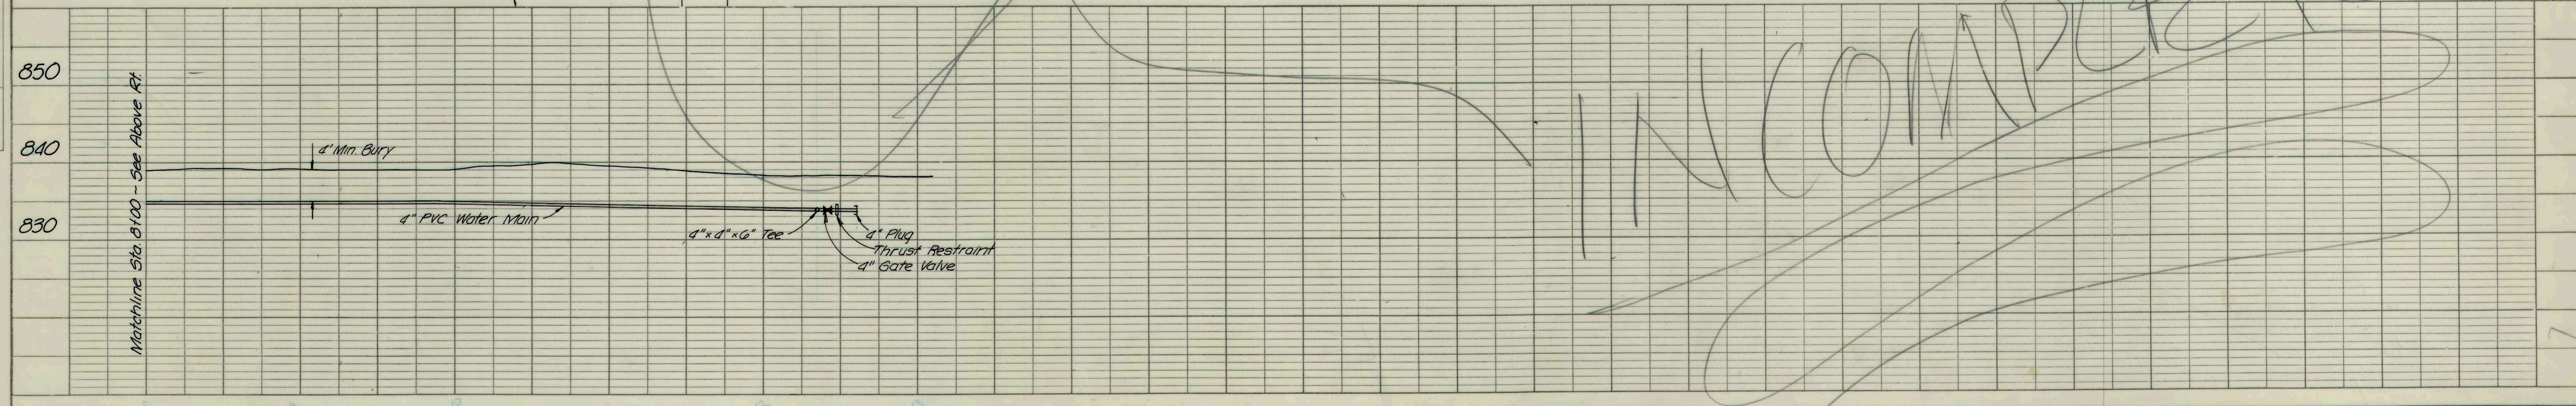
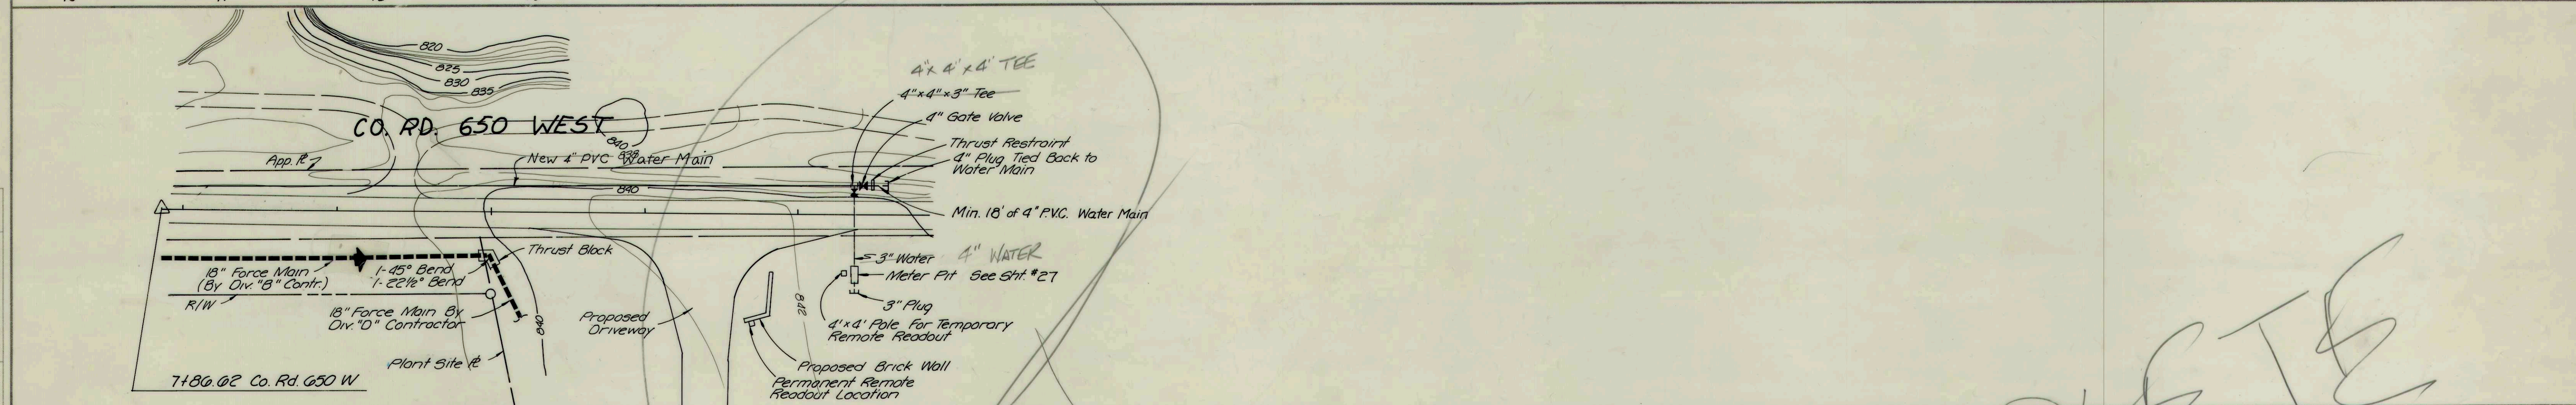


PLAN	DATE	
	BY	
	DESIGNED	
	NOTED	

PROFILE	DATE	
	BY	
	DESIGNED	
	NOTED	

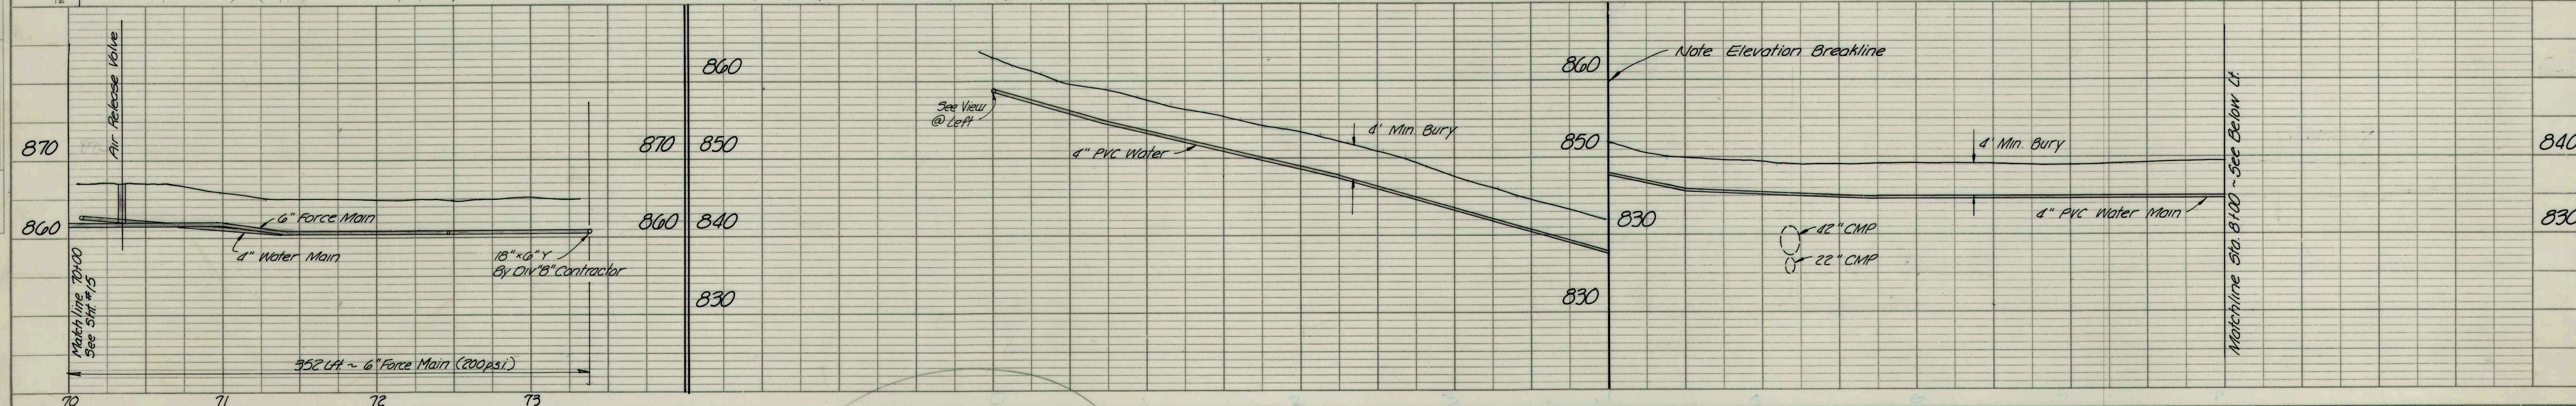

RECORD DRAWING

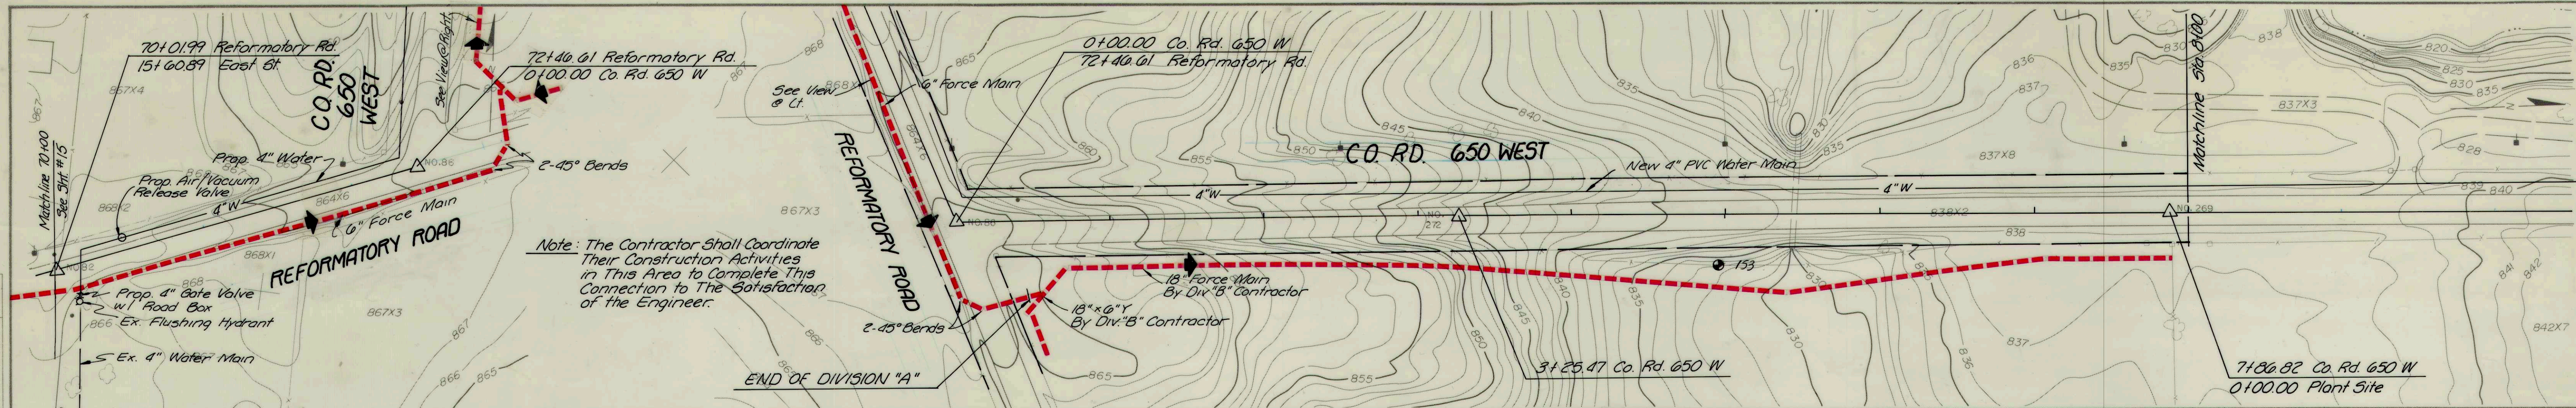

REFORMATORY RD/Co. Rd 650 W	
FALL CREEK R.W.D. PLAN & PROFILE	
HORIZ. 1"=50'	BEAM, LONGEST & NEFF, INC.
VERT. 1"=10'	CONSULTING ENGINEERS
	INDIANAPOLIS, INDIANA
	SHEET 25