




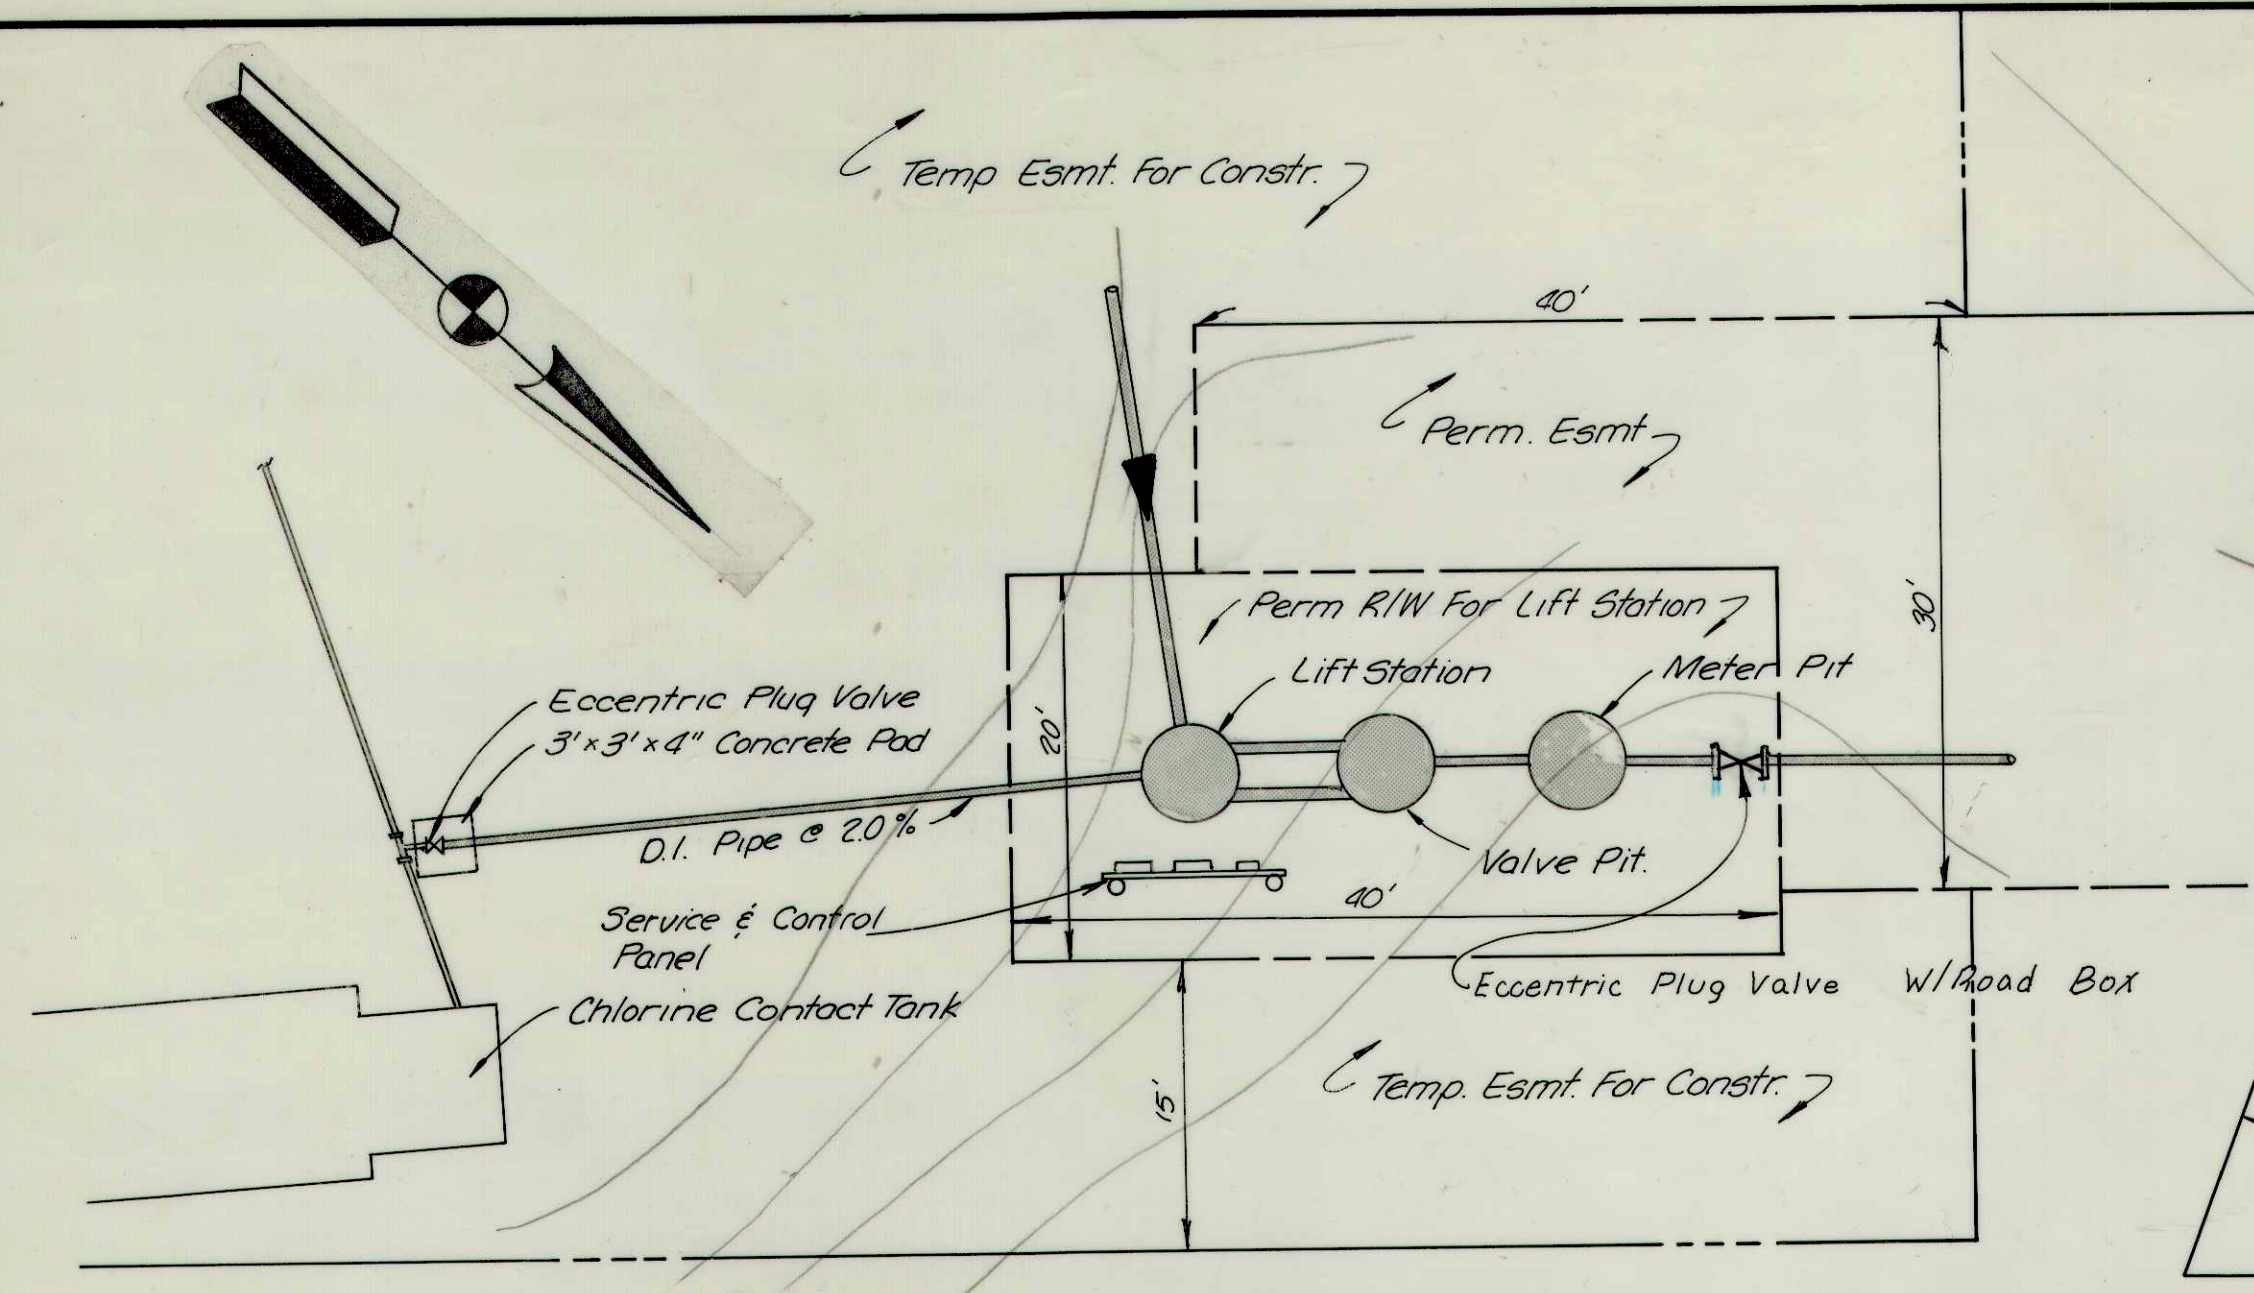



PENTECOSTAL CAMP LIFT STATION
Scale 1"=10'

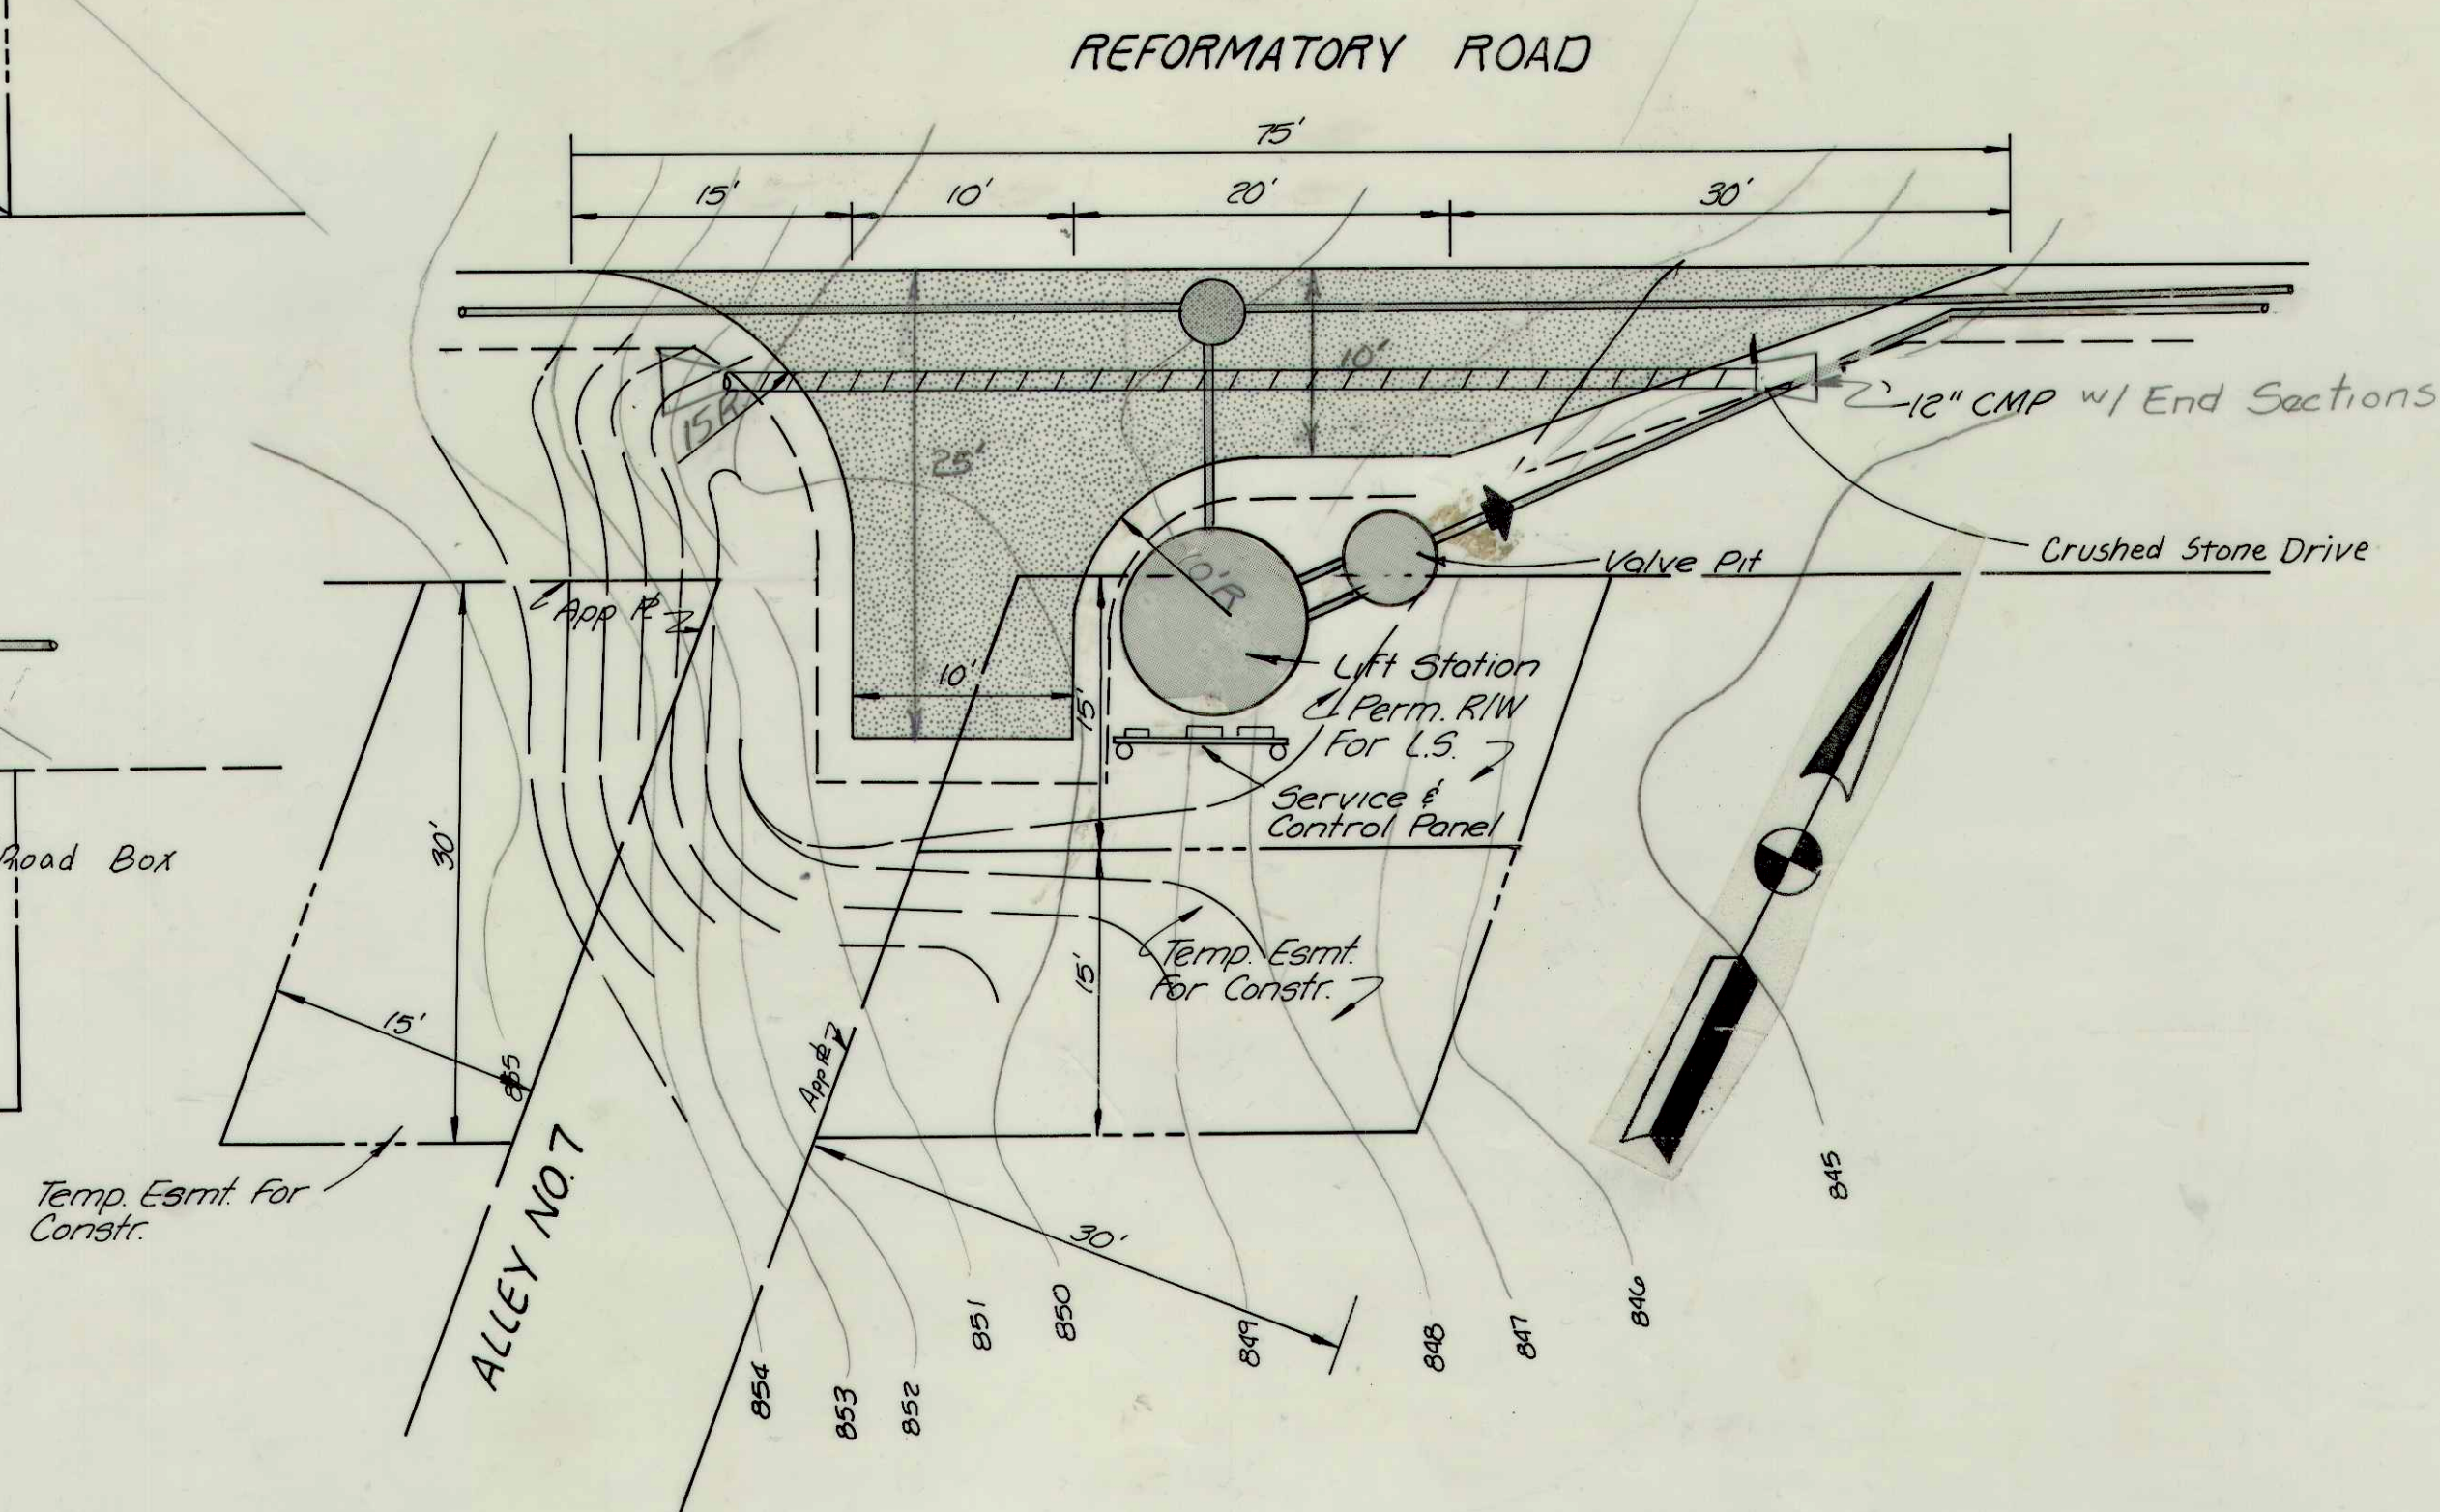

MAIN LIFT STATION
Scale 1"=10'

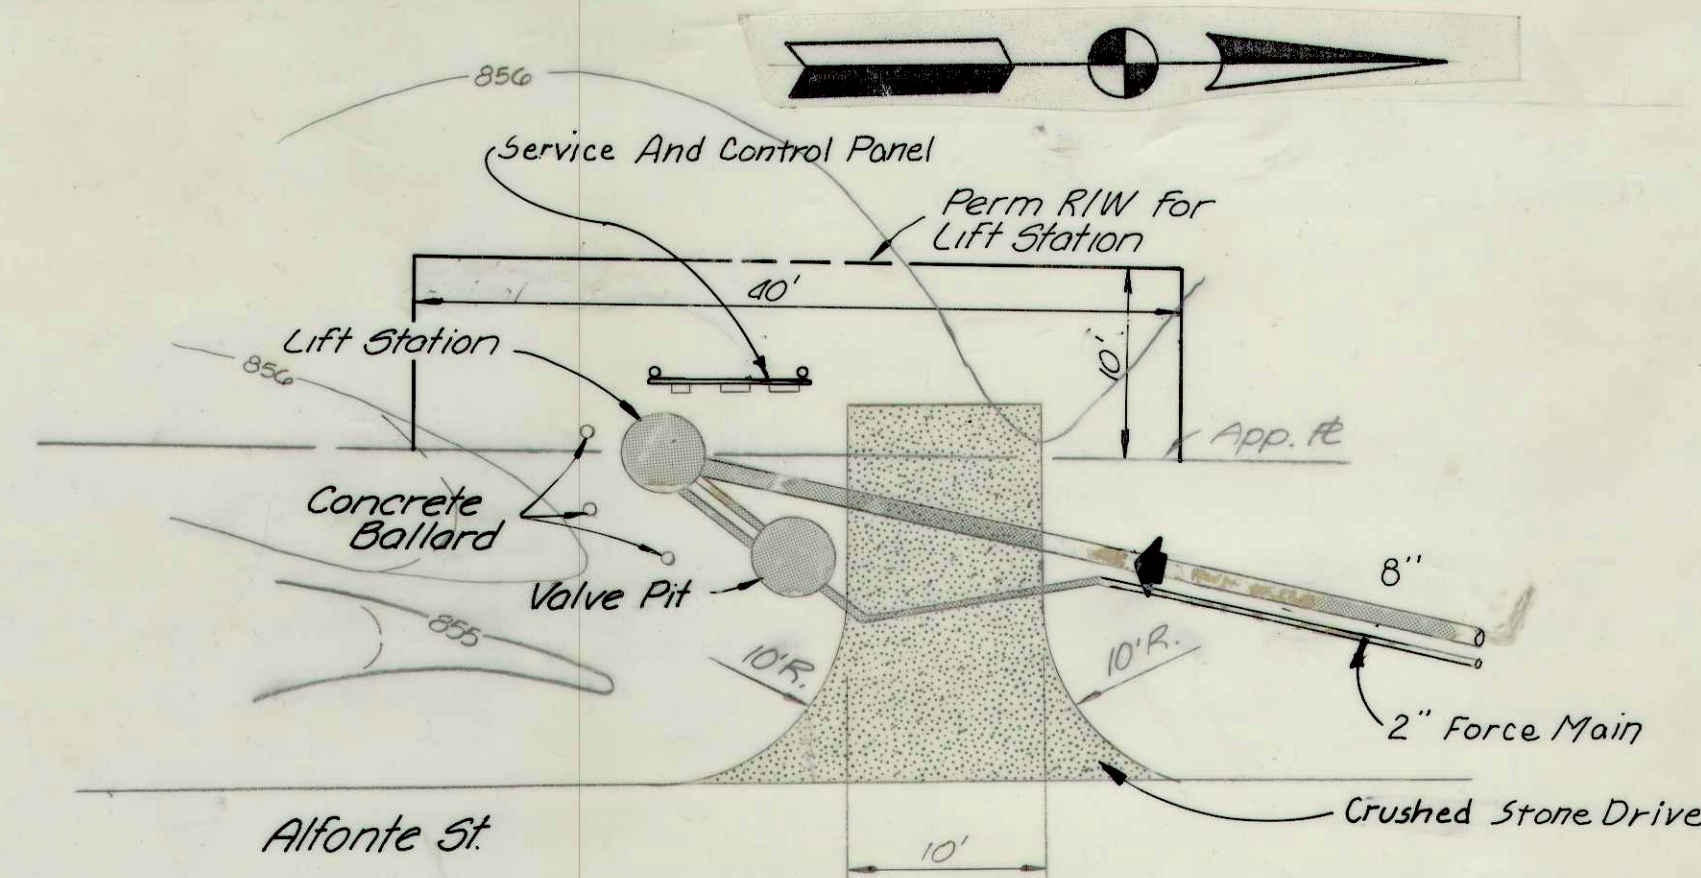


SOUTH LIFT STATION
Scale 1"=10'

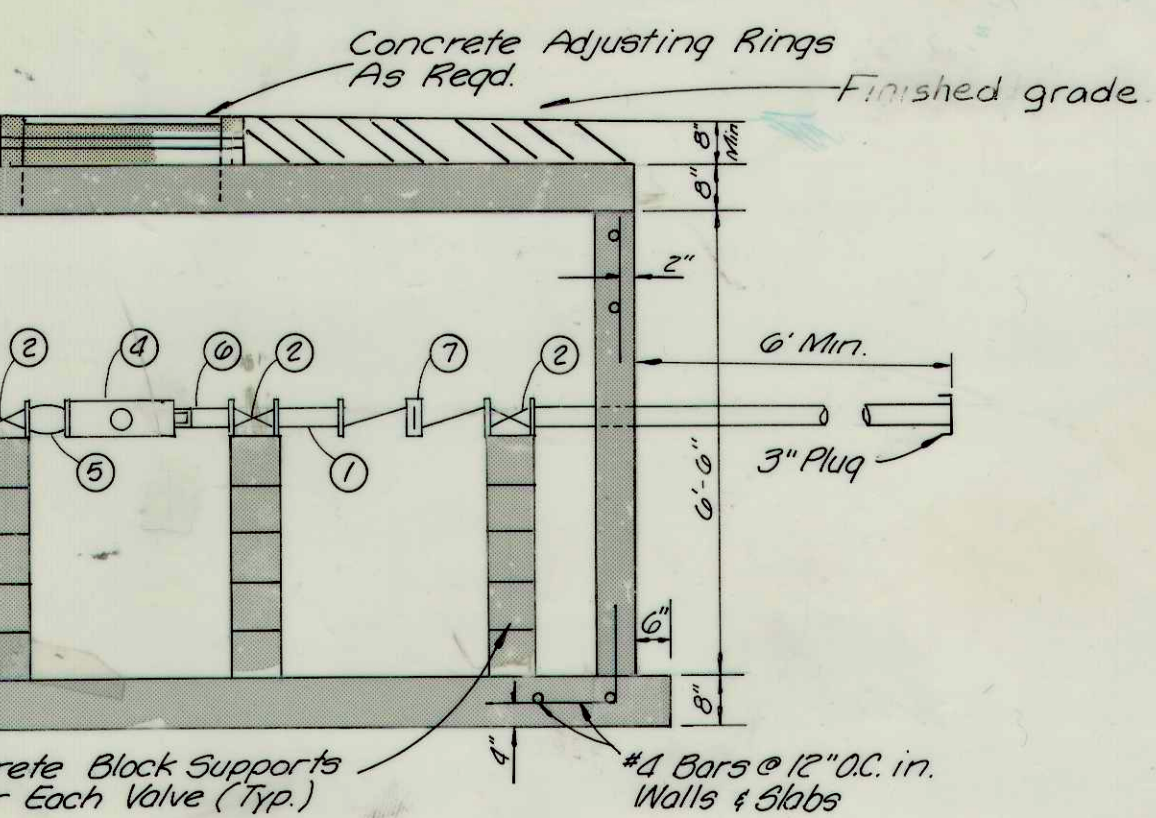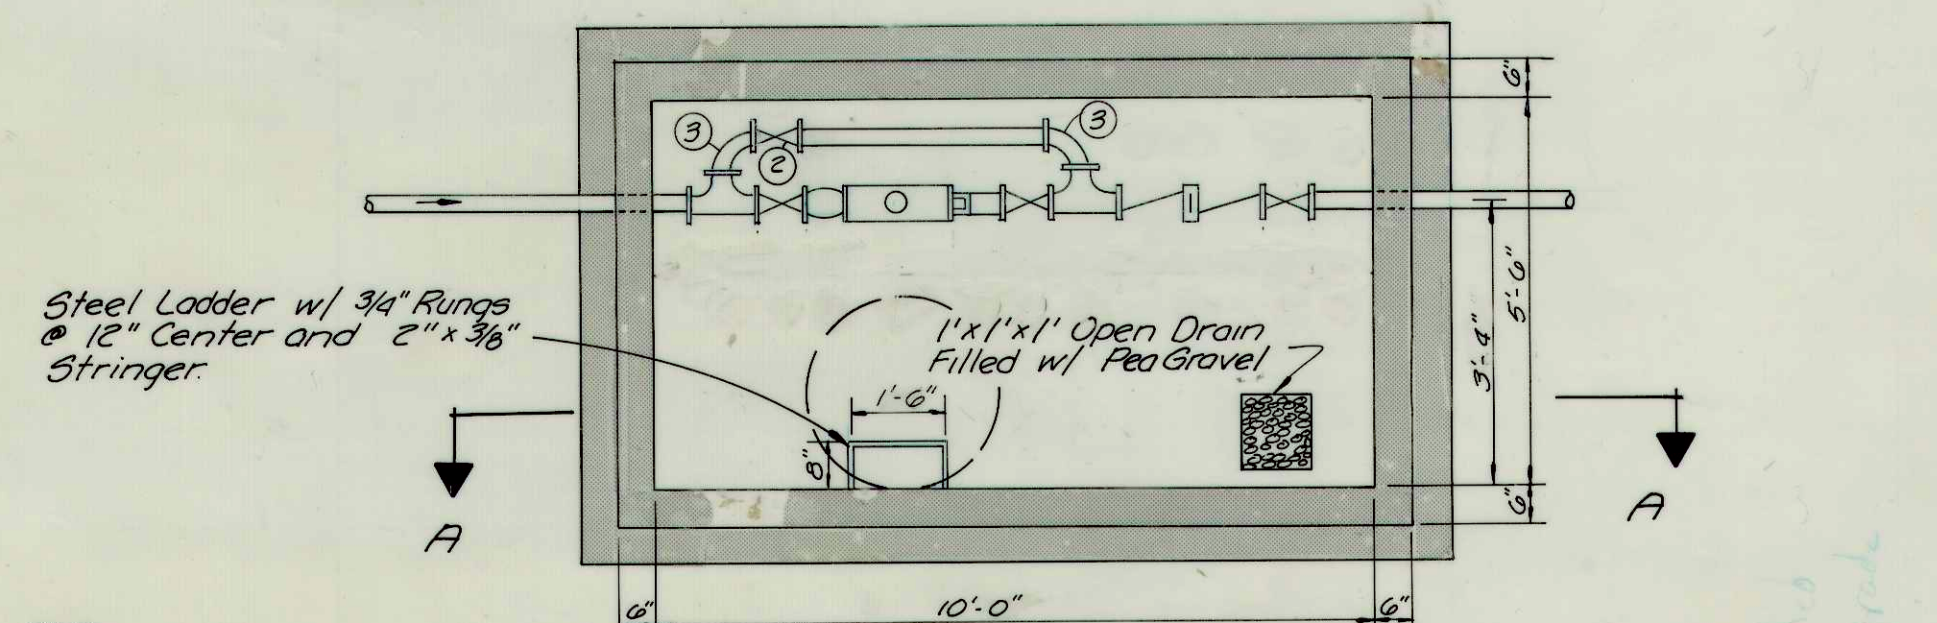


SECTION A-A


WATER METER PIT
Scale 3/8"=1'-0"

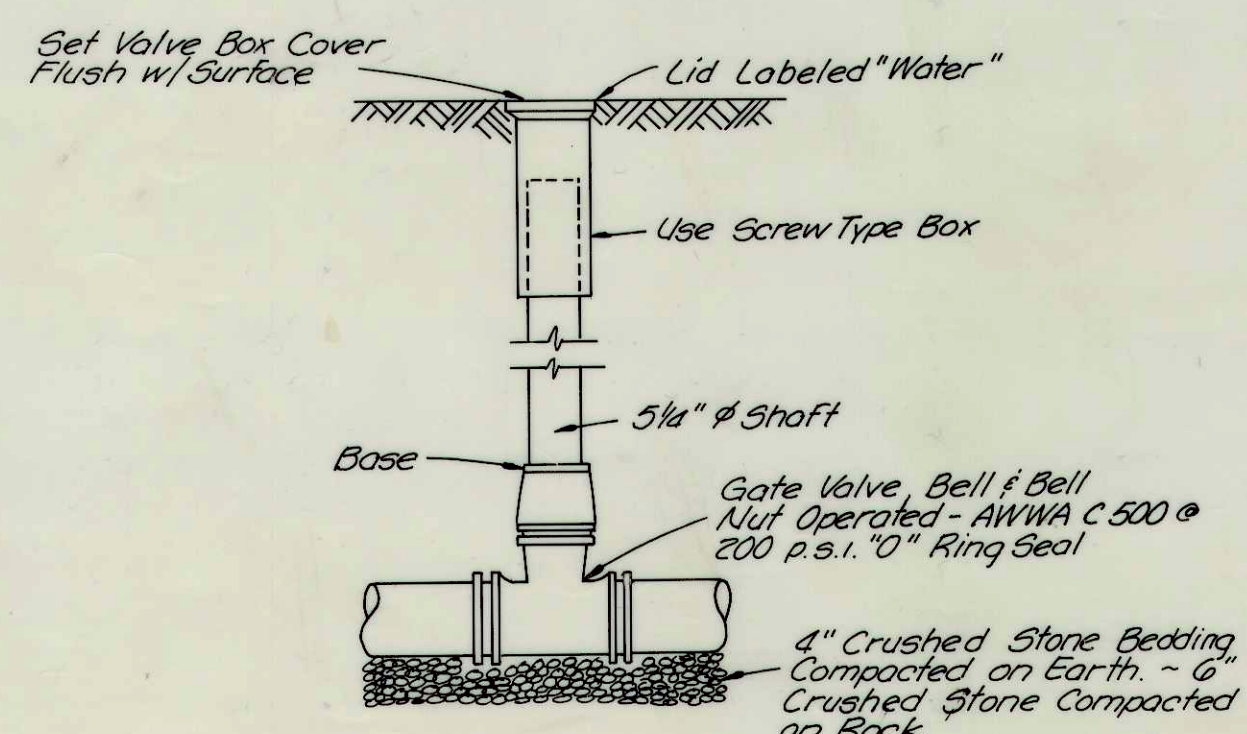

GATE VALVE & VALVE BOX
No Scale

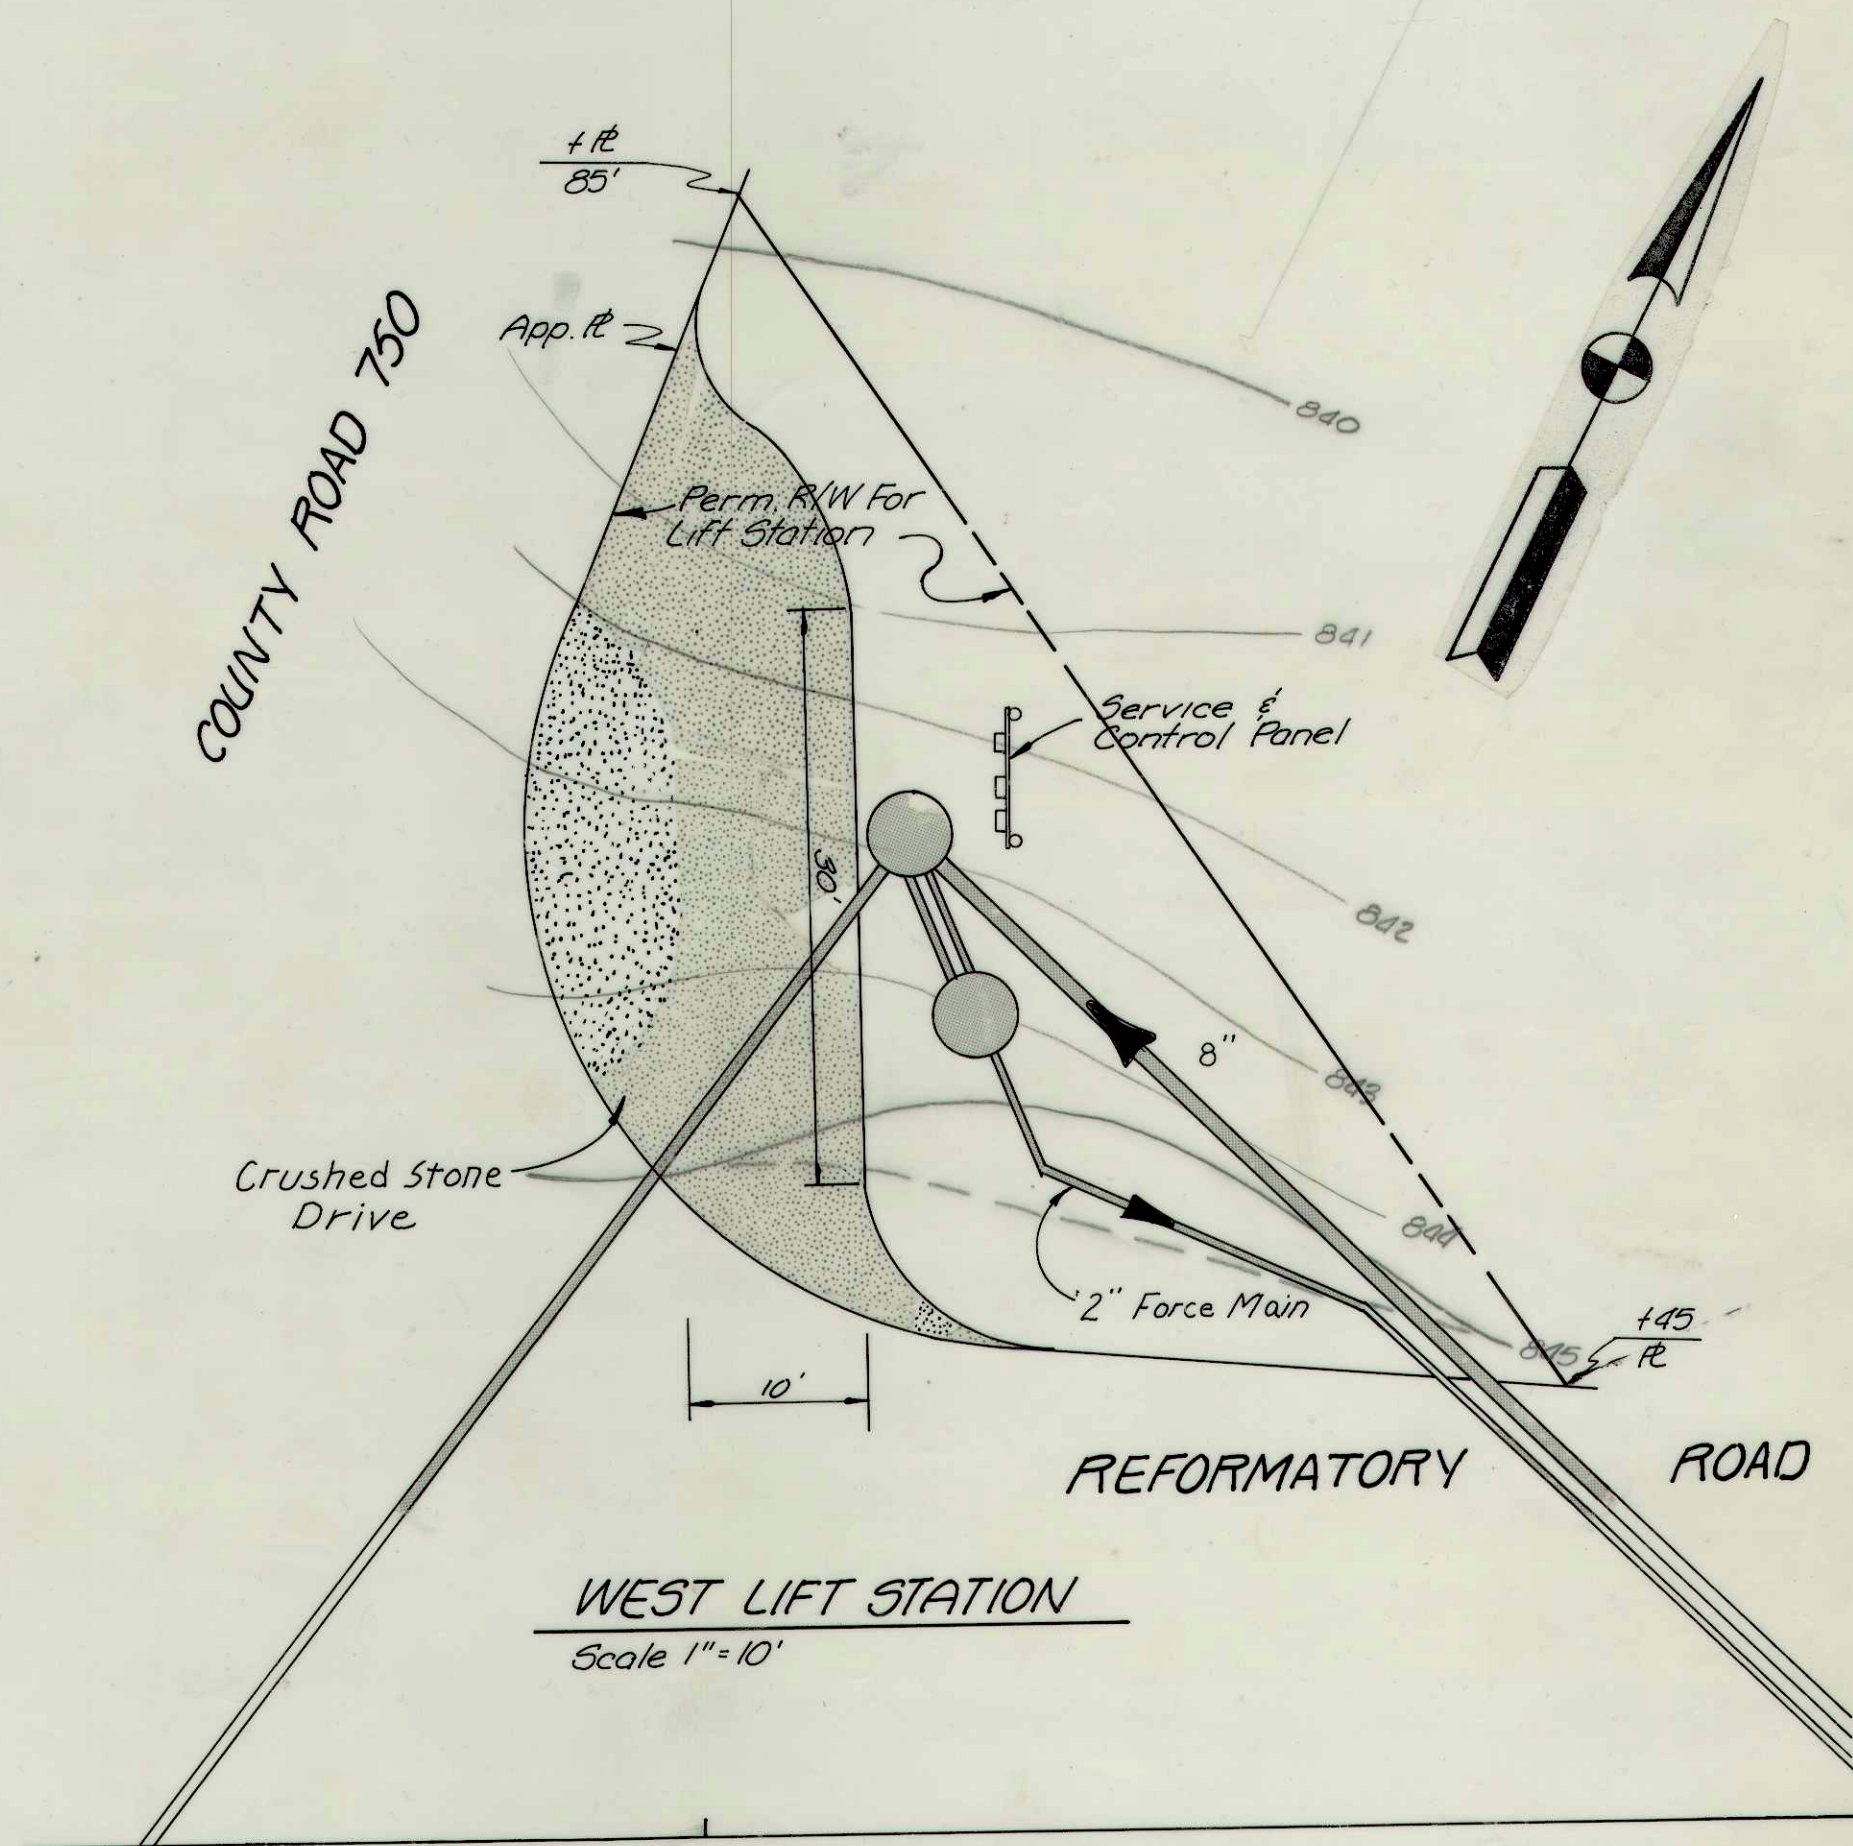

WEST LIFT STATION
Scale 1"=10'

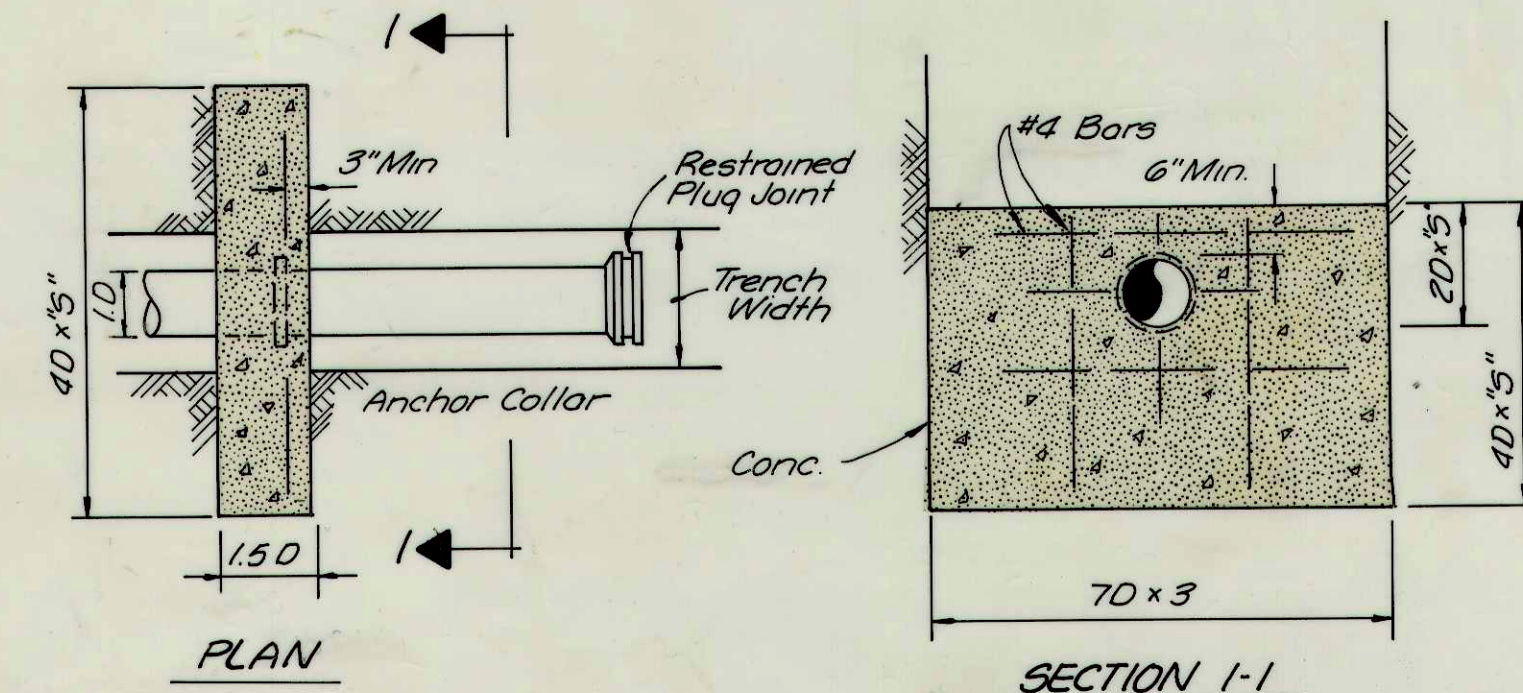

"S" FACTORS

Soft Clay	1.4
Stiff Clay	.58
Hard Clay	.41
Loose Sand	.58
Medium, Compacted Sand	.50
Loose Gravel, Sand Mix	.41

ANCHOR BLOCK DETAILS

No Scale

RECORD DRAWING

INGALLS LIFT STATIONS / DETAILS		
Scale: As Noted	FALL CREEK REGIONAL WASTEWATER DIST.	Sheet
Drawn By: J.B.	BEAM, LONGEST & NEFF	27
Designed By: S.E.	Consulting Engineers	
Certified By: E.R.	8136 Castleton Road Indianapolis In. 46250	