


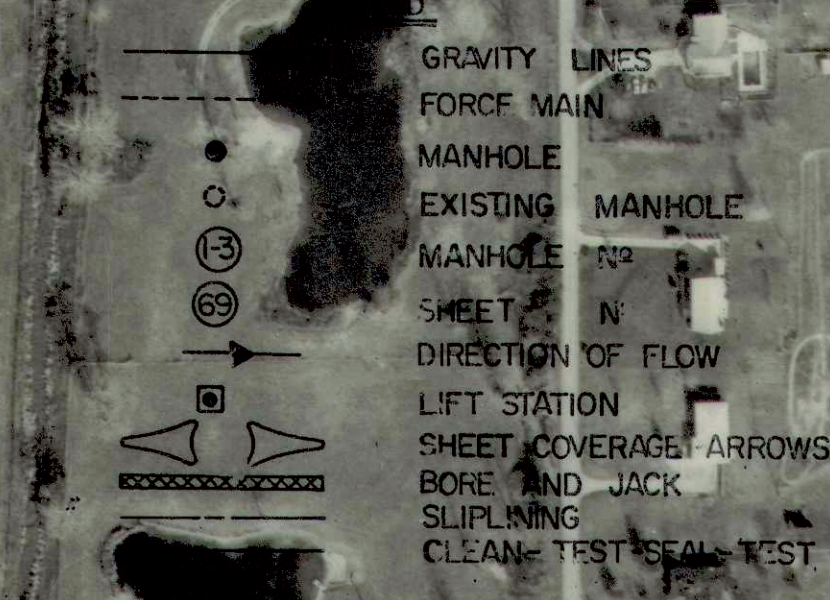

FALL CREEK WASTEWATER FACILITIES		
Scale: 1"=200'	SEWER SYSTEM LAYOUT	Sheet
Drawn By: BAV	BEAM, LONGEST & NEFF Consulting Engineers 8136 Castleton Road Indianapolis, IN 46250	33
Designed By: GDL		
Certified By: E.R.		

Scale: 1" = 200'
Drawn By: G.DV
Designed By: GDL
Certified By: E.R.

SEWER SYSTEM LAYOUT

BEAM, LONGEST & NEFF

Consulting Engineers
8136 Castleton Road
Indianapolis In. 46250

Sheet

33