
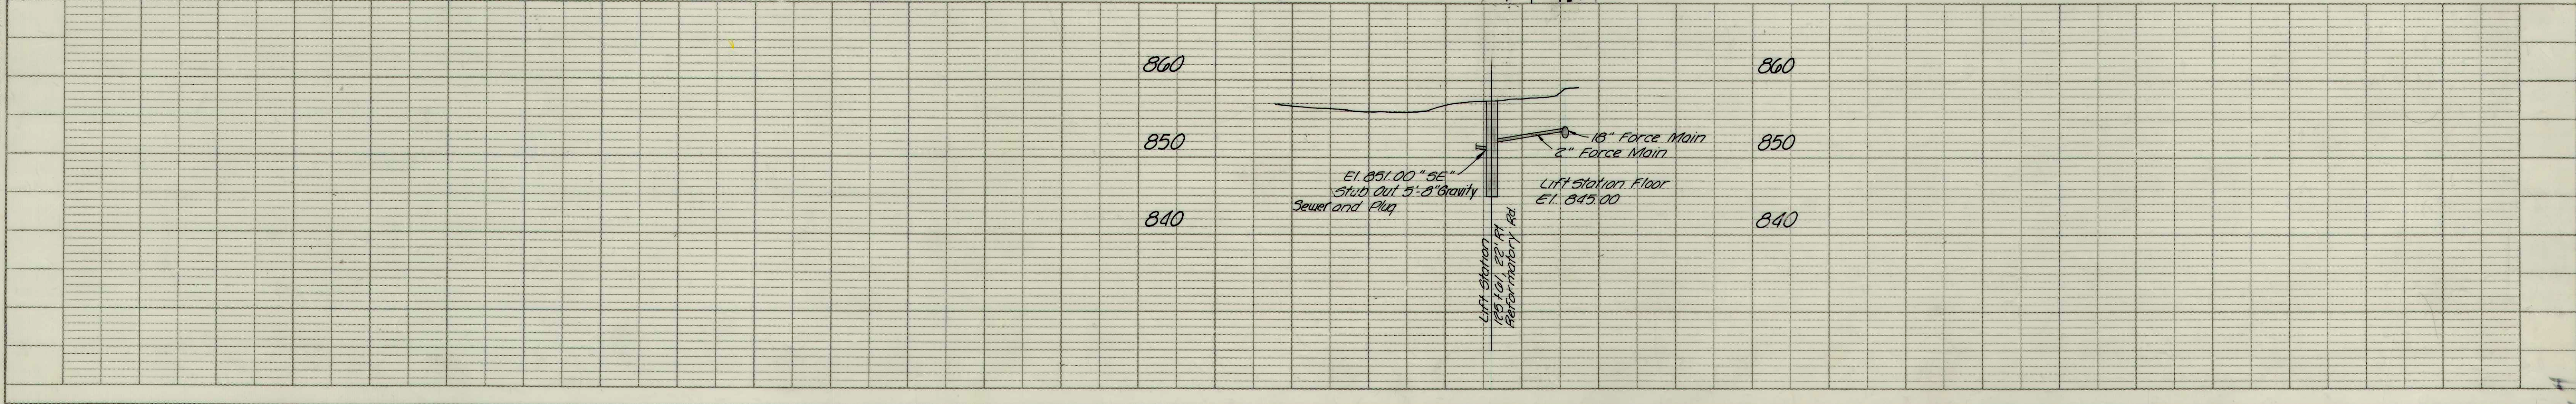
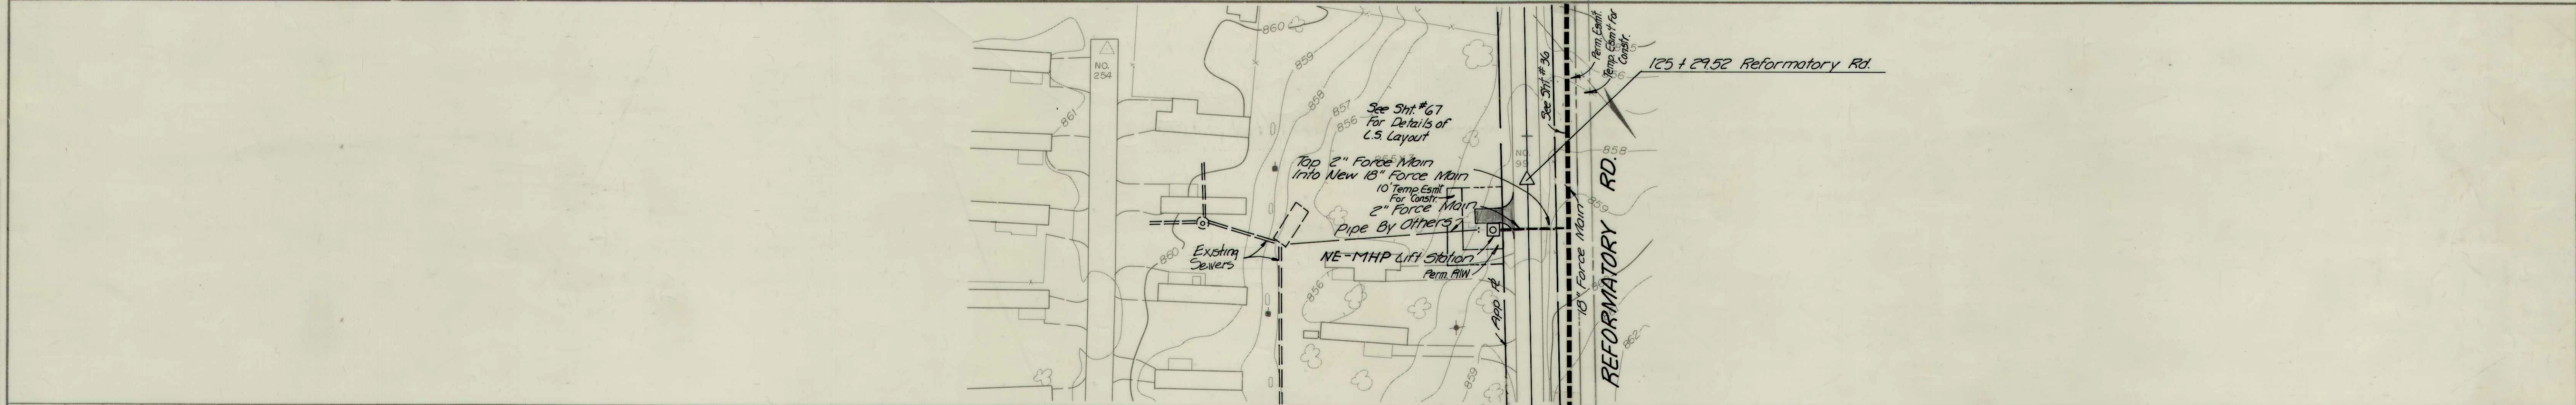


Note
The contractors shall coordinate the construction activities in this area to complete all connections to the satisfaction of Engineer

PLAN	SURVEYED	DATE
	PLOTTED	BY
	NOTED	NO.
	CHECKED	DATE

PROFILE	SURVEYED	DATE
	PLOTTED	BY
	NOTED	NO.
	CHECKED	DATE

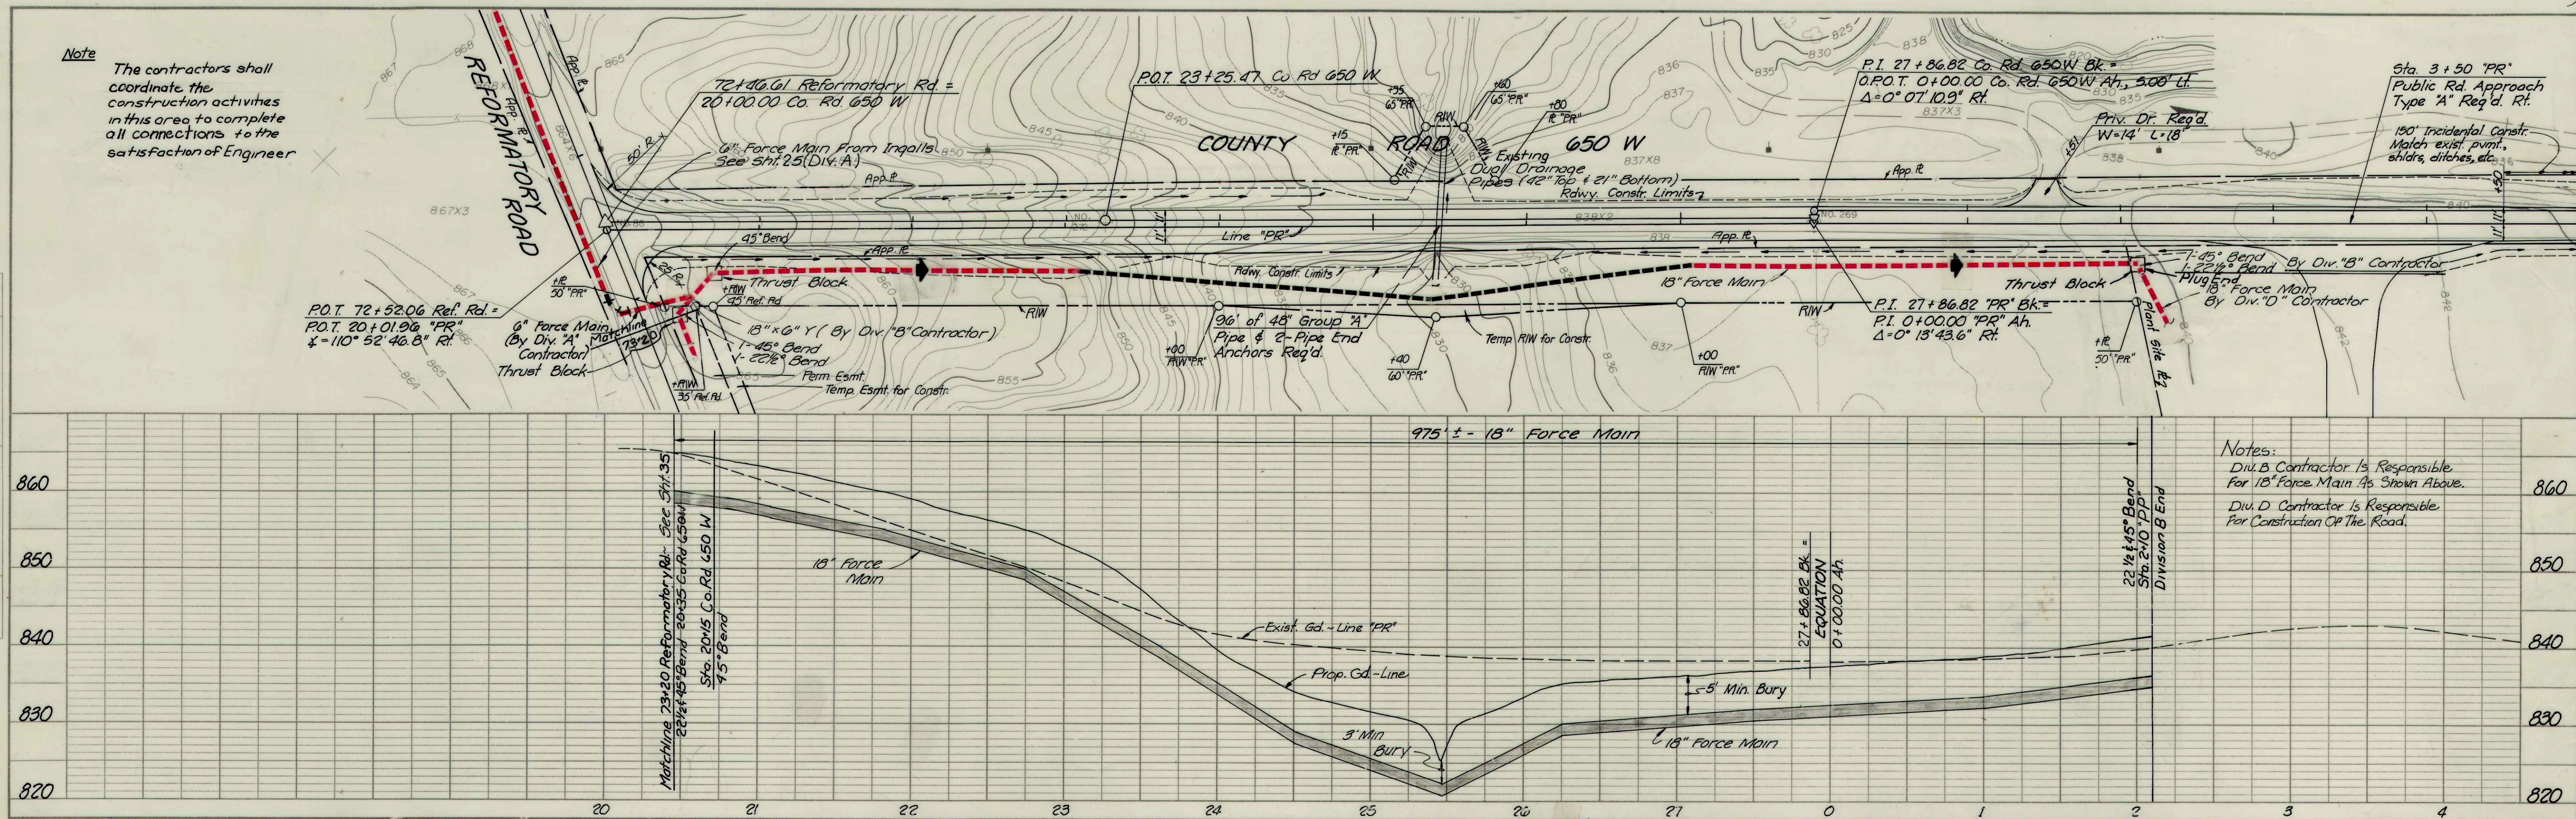

Notes:
Div. B Contractor Is Responsible For 18" Force Main As Shown Above.
Div. D Contractor Is Responsible For Construction Of The Road.

RECORD DRAWING



COUNTY ROAD 650 W.	
FALL CREEK R.W.D. PLAN & PROFILE	SHEET
HORIZ. 1"=50'	BEAM, LONGEST & NEFF, INC.
VERT. 1"=10'	CONSULTING ENGINEERS
	INDIANAPOLIS, INDIANA