


PLAN	DATE	
	BY	
	REVISIONS	
	NO.	

PROFILE	DATE	
	BY	
	REVISIONS	
	NO.	



RECORD DRAWING

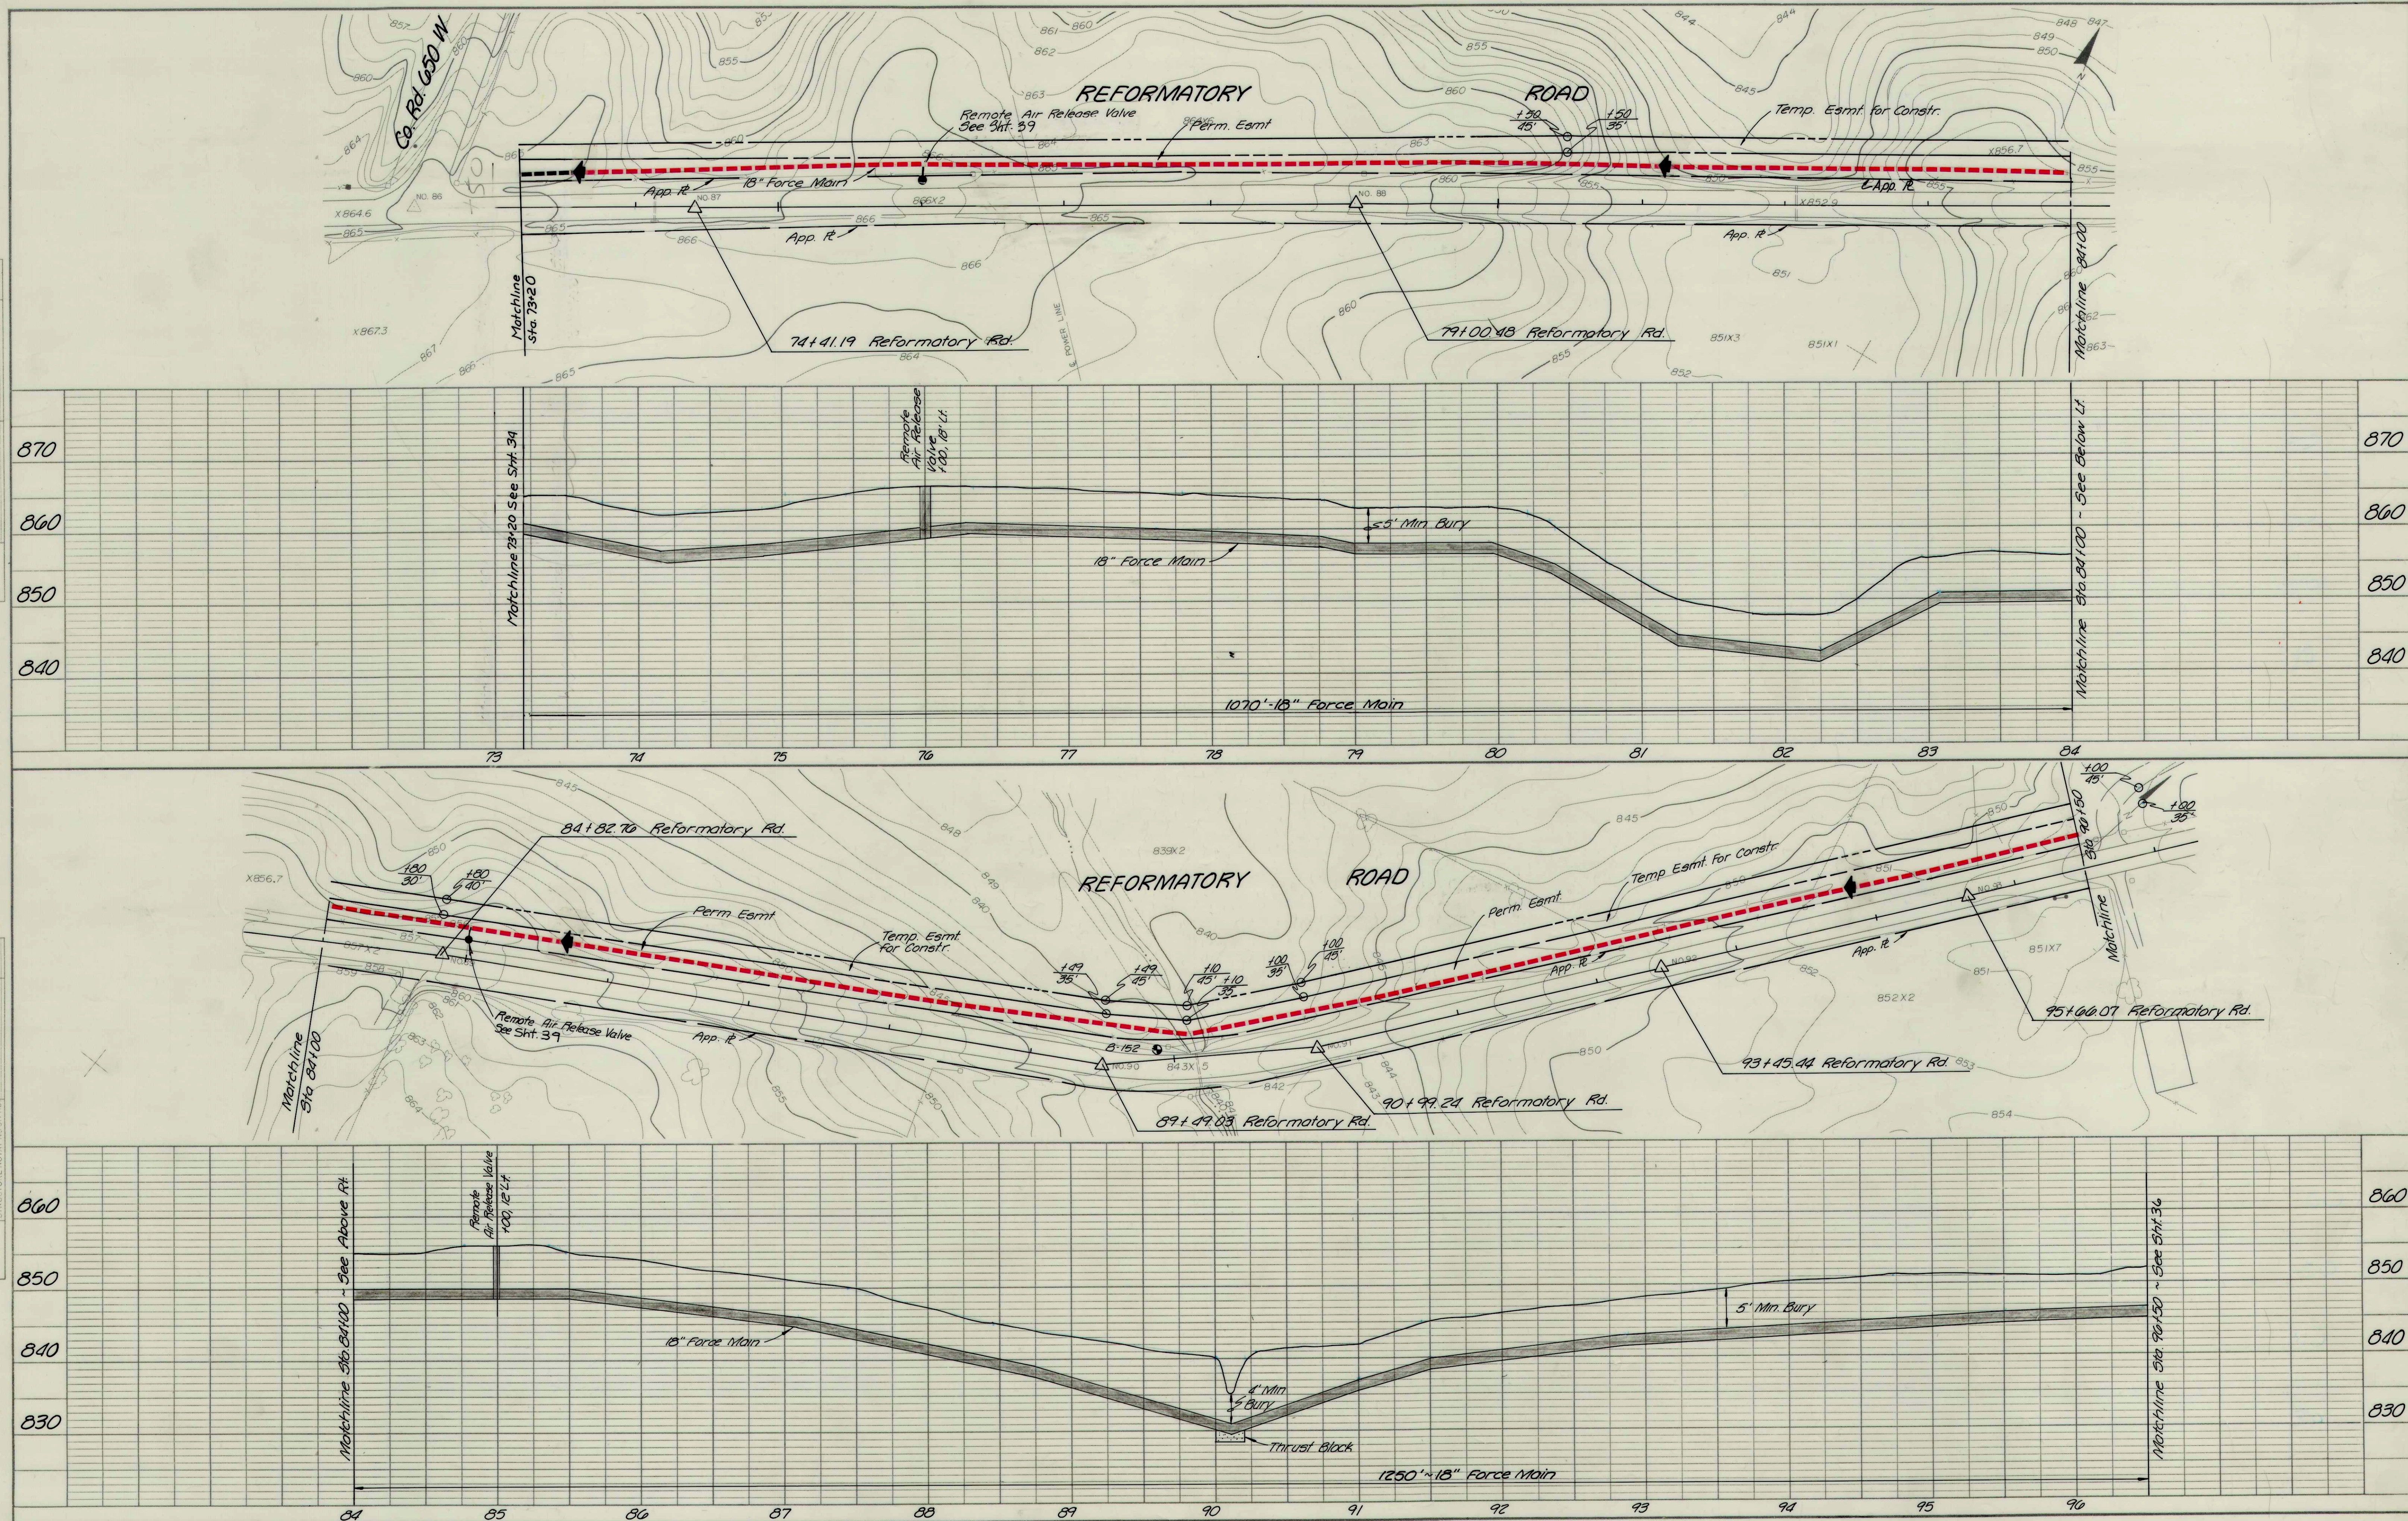

18" FORCE MAIN - REFORMATORY RD.
 FALL CREEK R.W.D. PLAN & PROFILE SHEET
 HORIZ. 1"=50' BEAM, LONGST & NEFF, INC.
 VERT. 1"=10' CONSULTING ENGINEERS
 INDIANAPOLIS, INDIANA 35