


PLAN	SURVEYED	DATE
	PLOTTED	BY
	NOTE BOOK	CHECKED
	NO.	AT

PROFILE	SURVEYED	DATE
	PLOTTED	BY
	NOTE BOOK	CHECKED
	NO.	AT



RECORD DRAWING

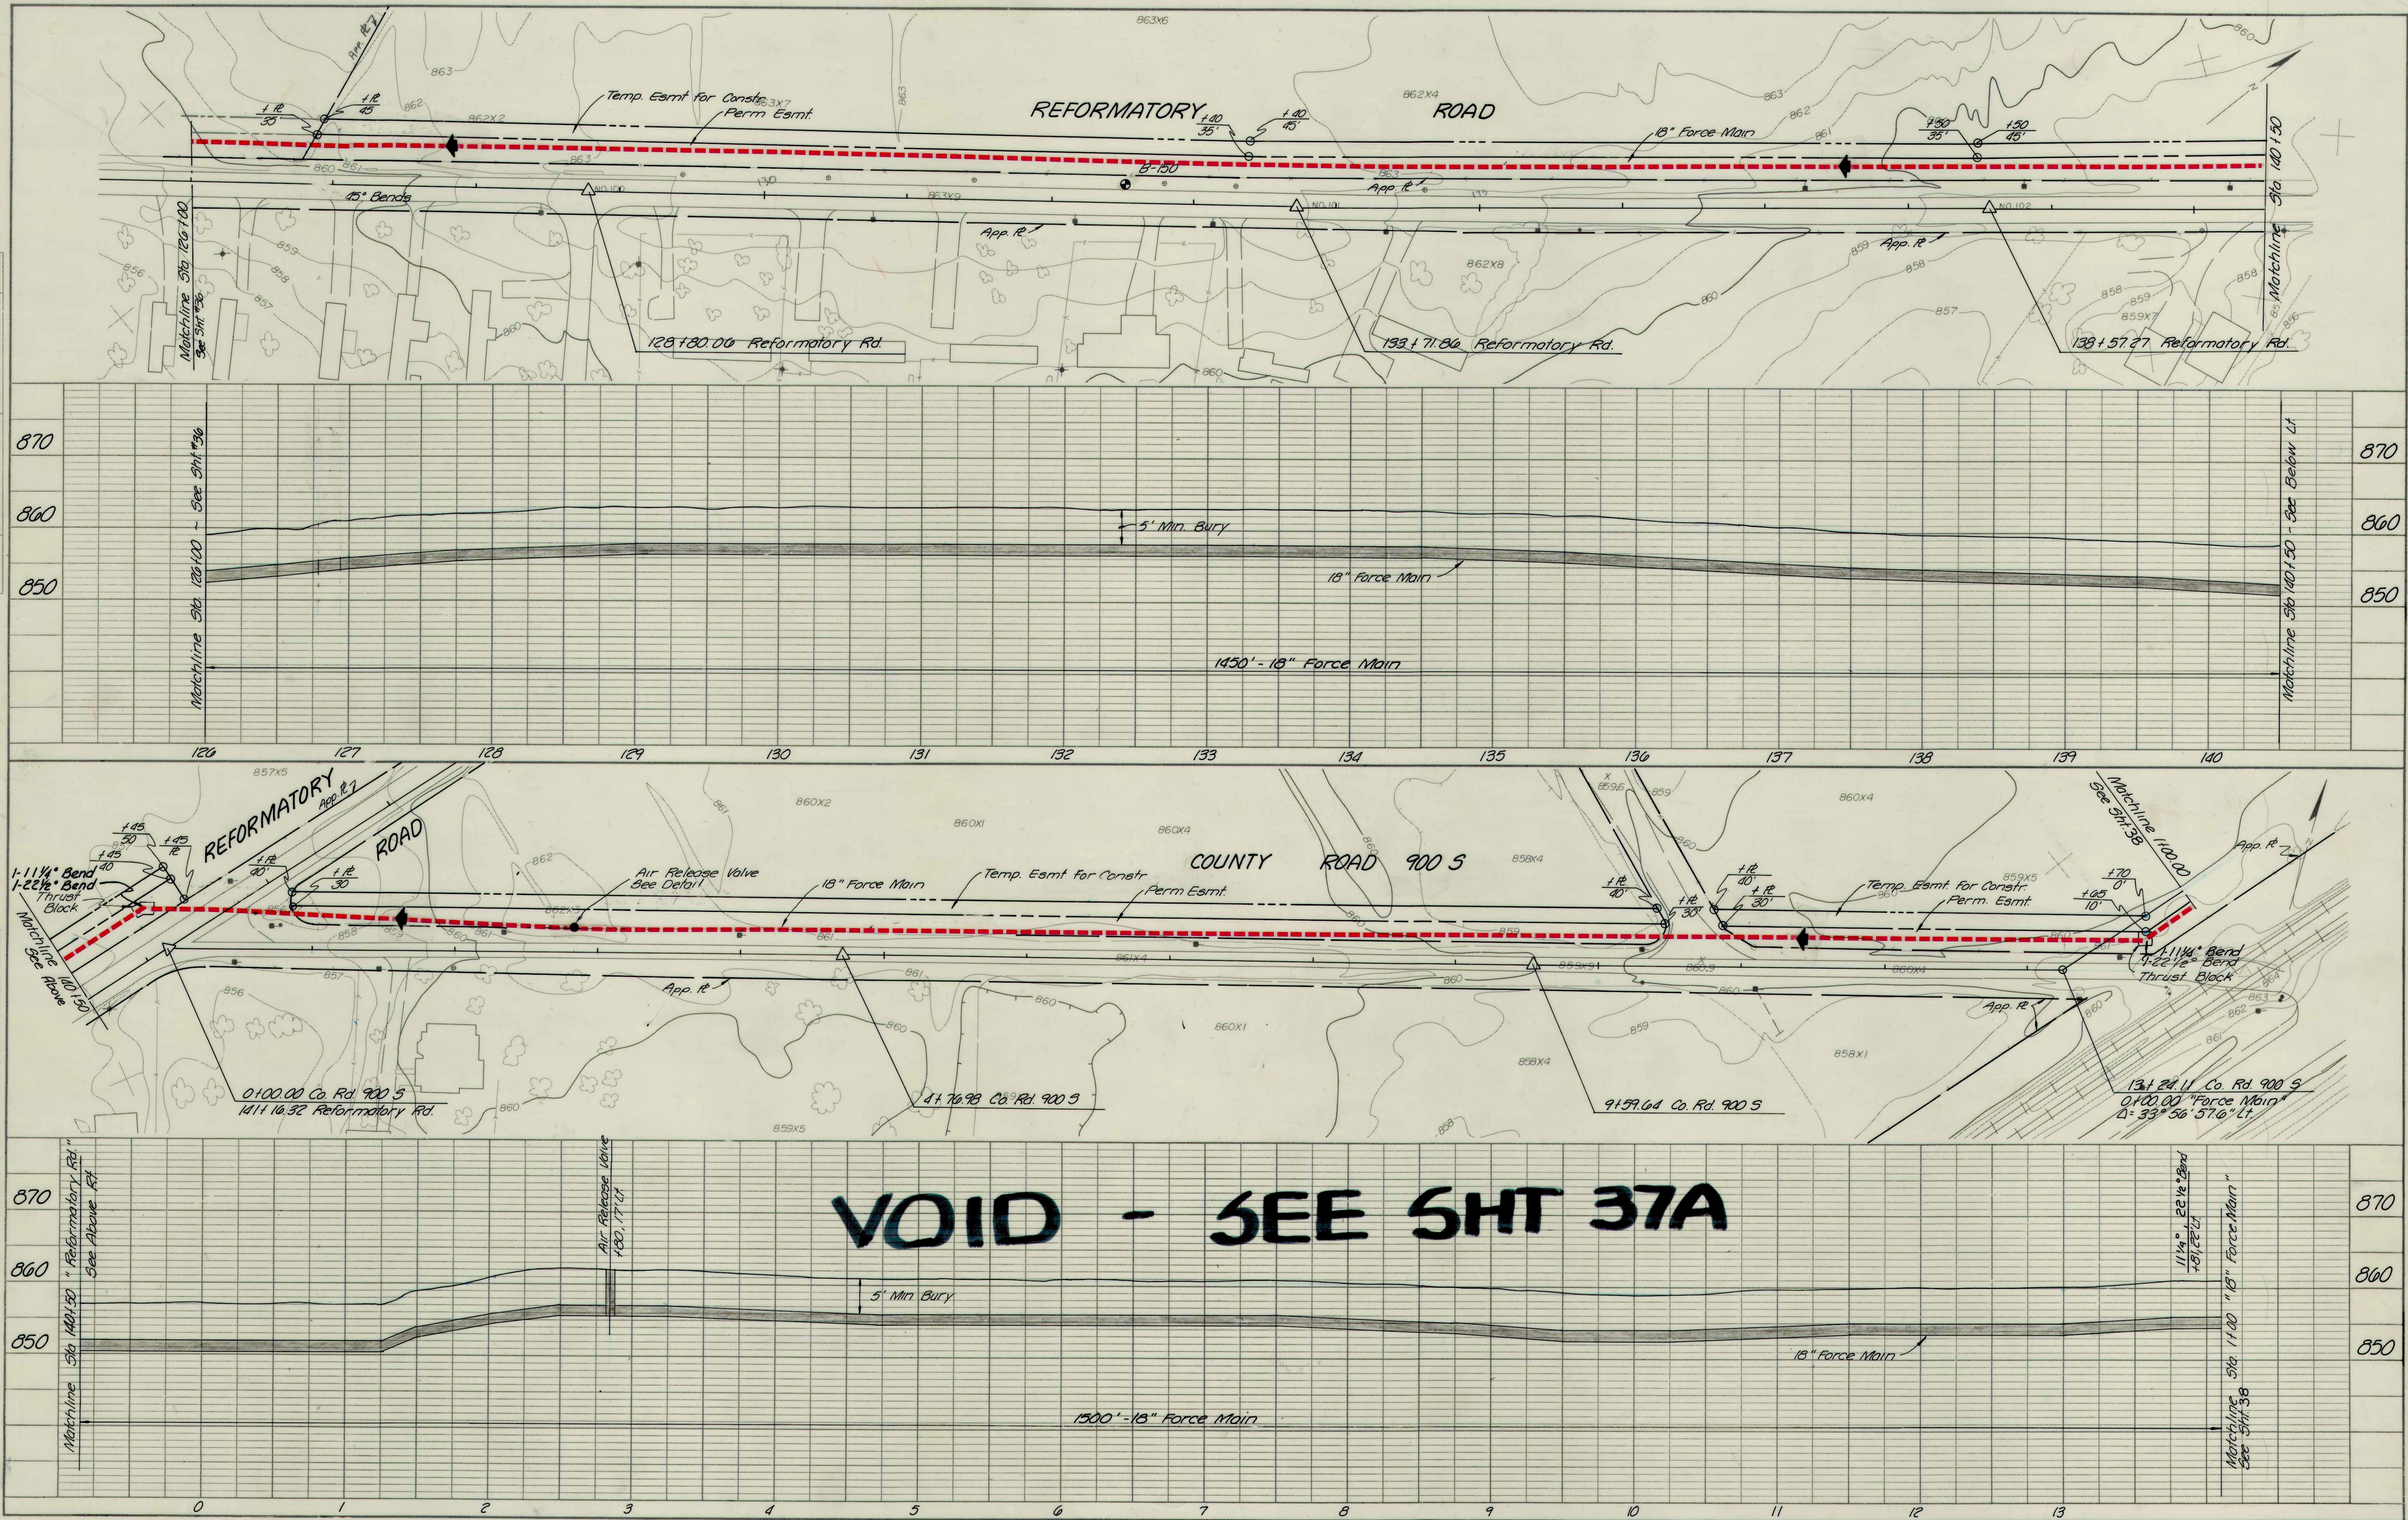

18" FORCE MAIN - 900 S & REFORMATORY RD.
 FALL CREEK R.W.D. PLAN & PROFILE SHEET
 HORIZ. 1"=50'
 VERT. 1"=10'
 BEAM, LONGEST & NEFF, INC.
 CONSULTING ENGINEERS
 INDIANAPOLIS, INDIANA
37