


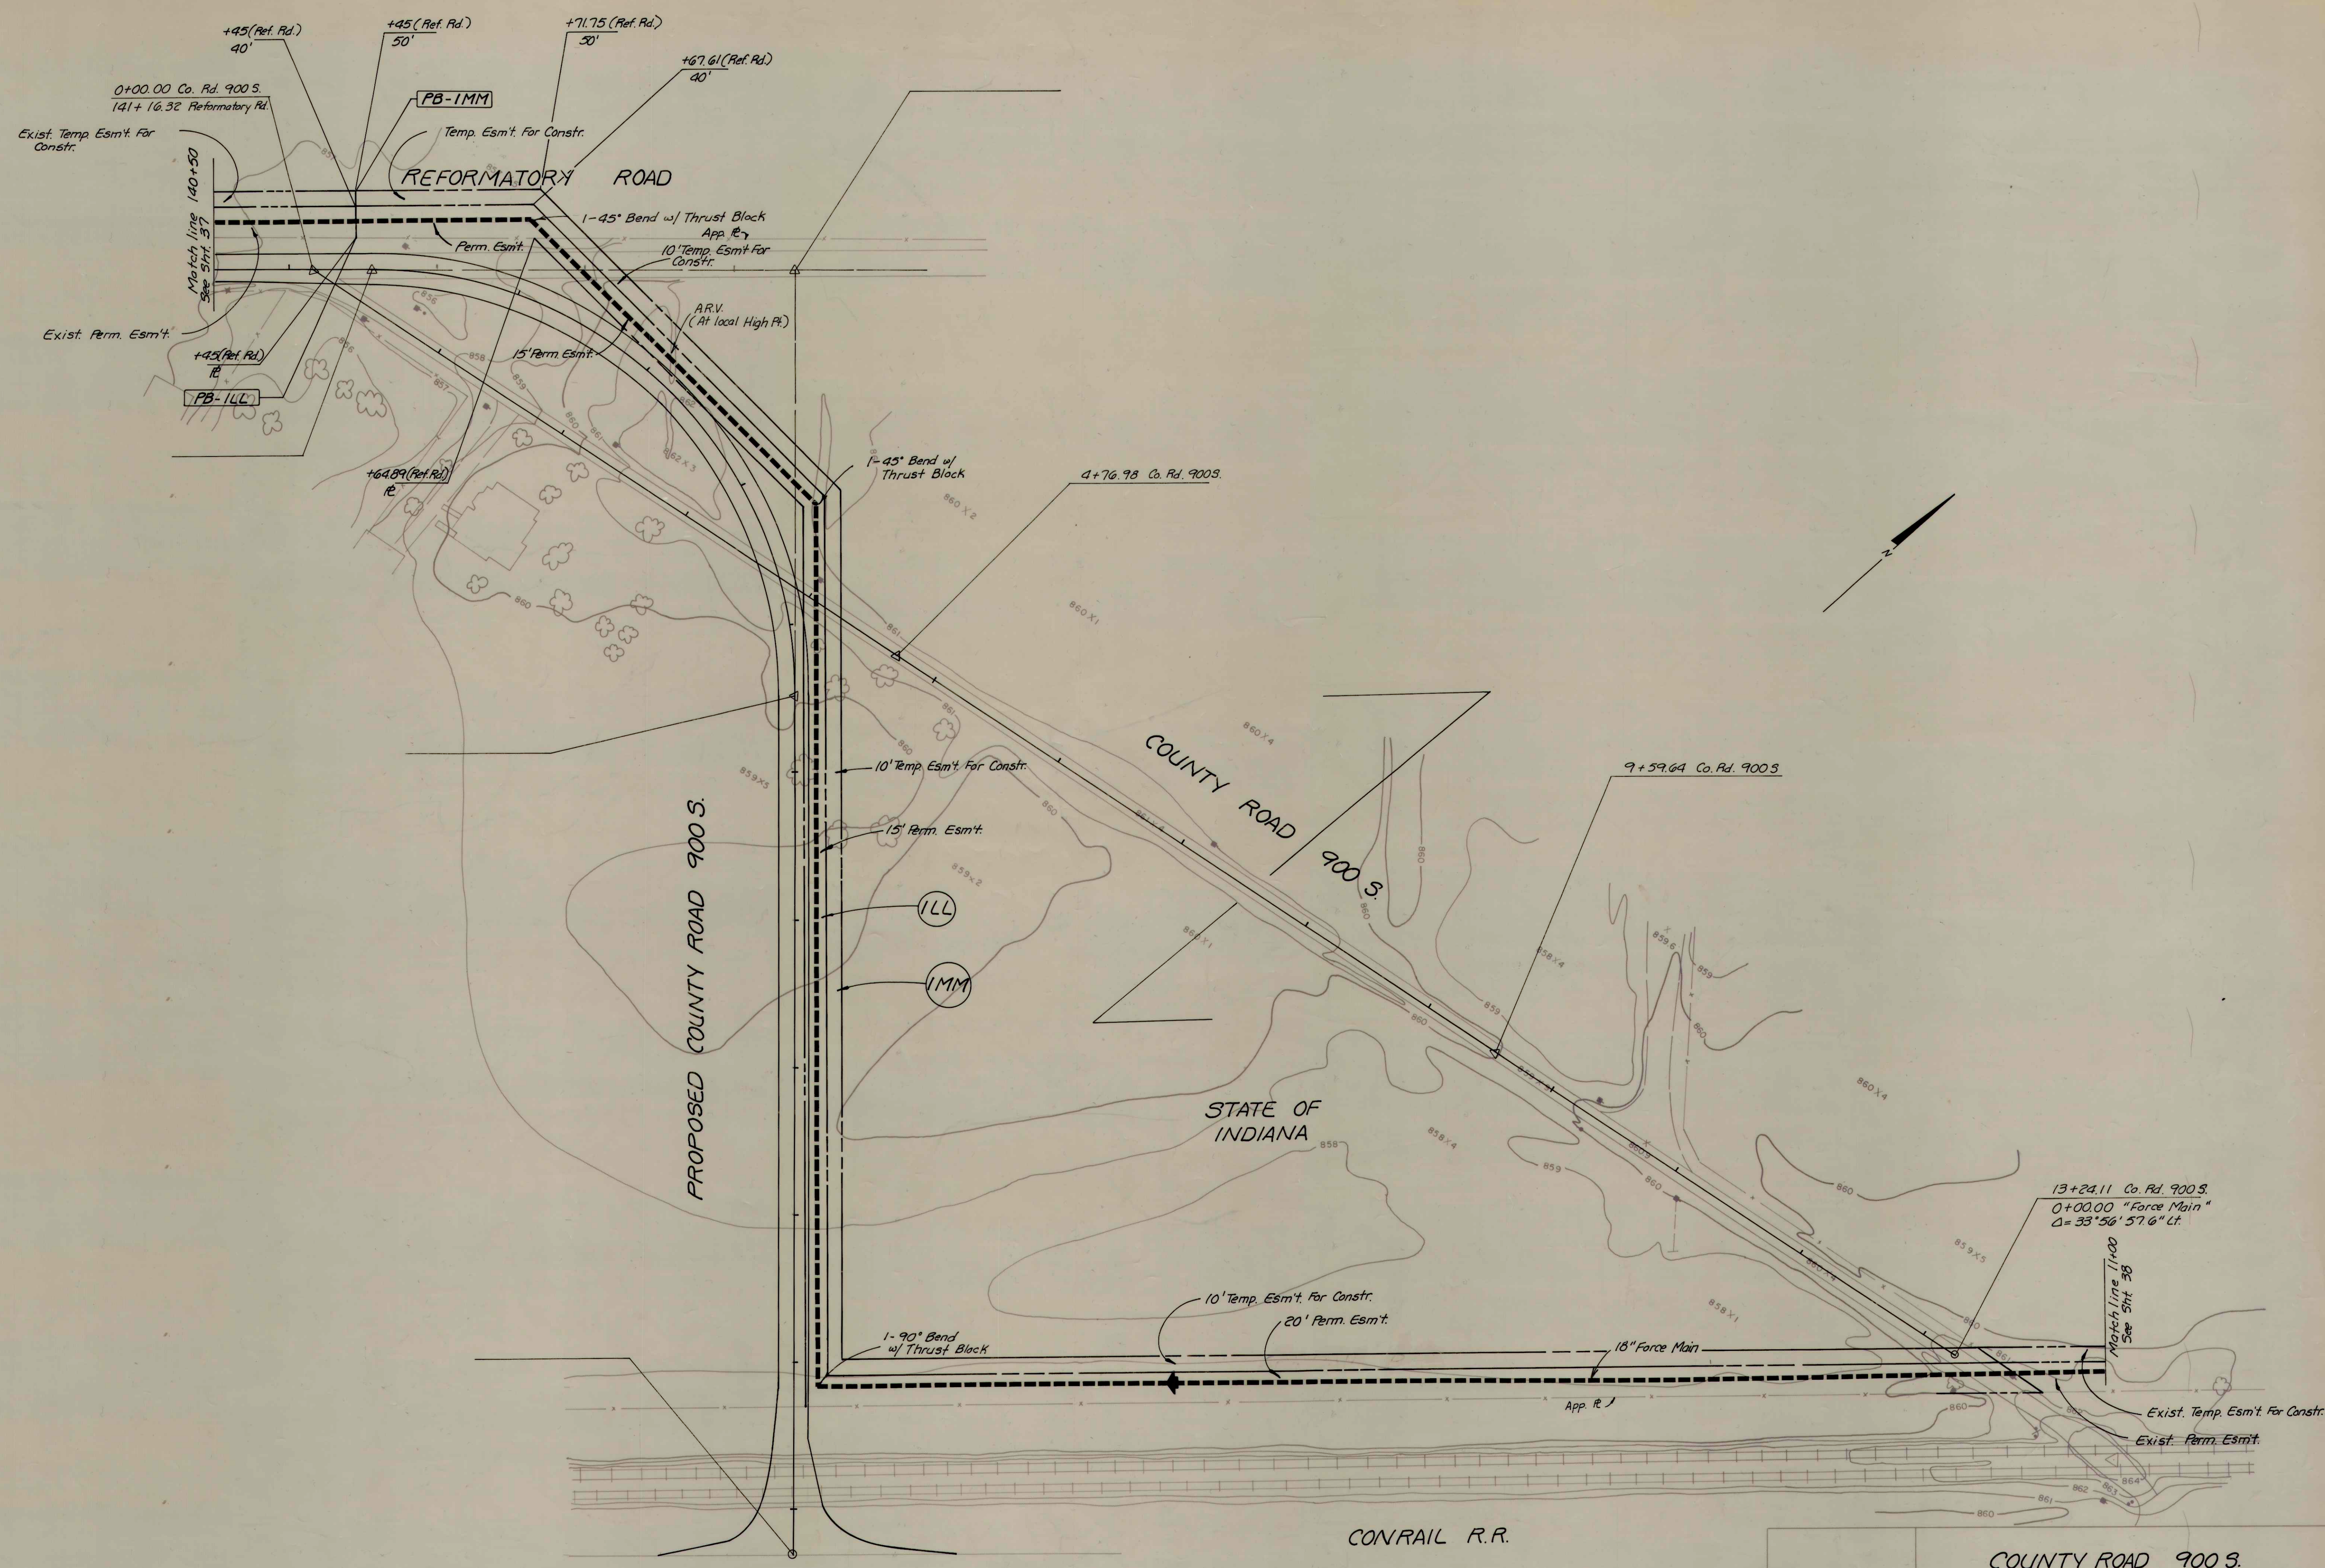

RECORD DRAWING

COUNTY ROAD 900 S.		
Scale: 1"= 50'	FALL CREEK	Sheet
Drawn By: G. DV	BEAM, LONGEST & NEFF	37A
Designed By: DN	Consulting Engineers	
Certified By: EA	8136 Castleton Road Indianapolis, IN 46250	