


PLAN	SURVEYED	DATE
NO.	BY	
	CHECKED	
	DATE	

PROFILE	SURVEYED	DATE
NO.	BY	
	CHECKED	
	DATE	



RECORD DRAWING

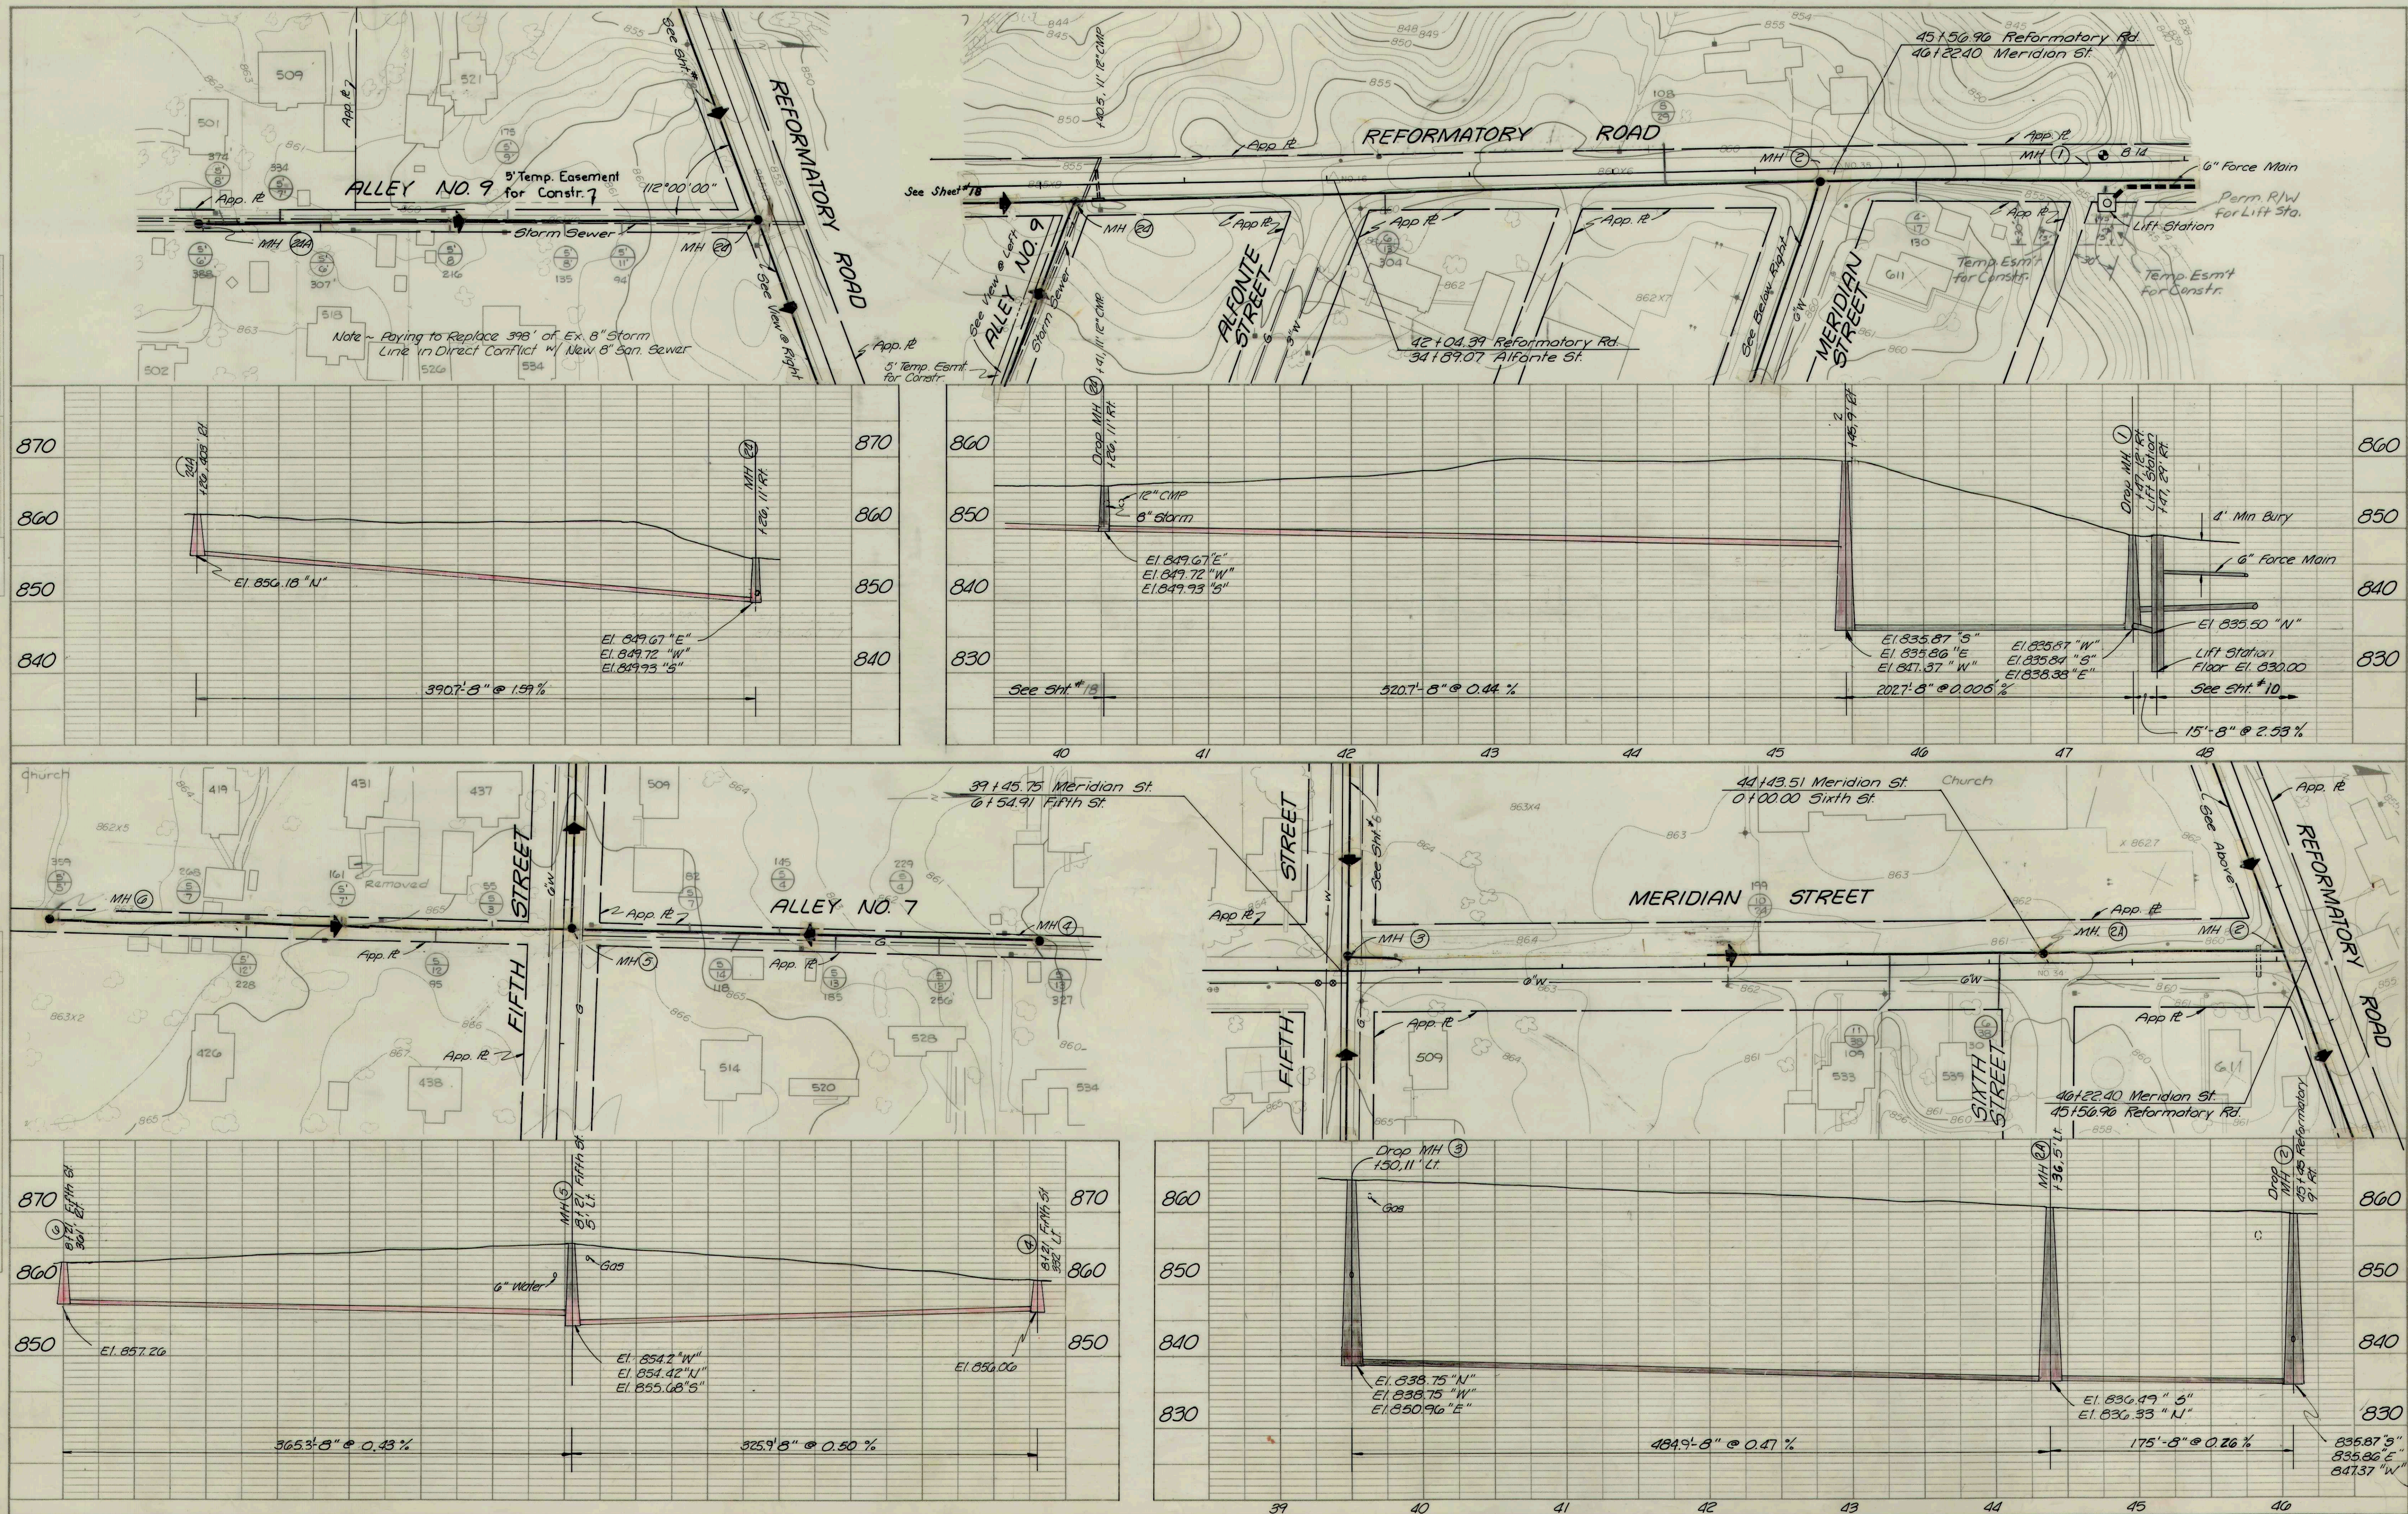

REFORMATORY RD. ALLEY #9
ALLEY #7 MERIDIAN ST.
FALL CREEK R.W.D. PLAN & PROFILE SHEET
HORIZ. 1"=50' BEAM, LONGEST & NEFF, INC.
VERT. 1"=10' CONSULTING ENGINEERS
INDIANAPOLIS, INDIANA