


|      |         |    |
|------|---------|----|
| PLAN | DATE    | BY |
|      | PROJECT |    |
|      | NOTES   |    |
|      | NO.     |    |

|         |         |    |
|---------|---------|----|
| PROFILE | DATE    | BY |
|         | PROJECT |    |
|         | NOTES   |    |
|         | NO.     |    |



RECORD DRAWING

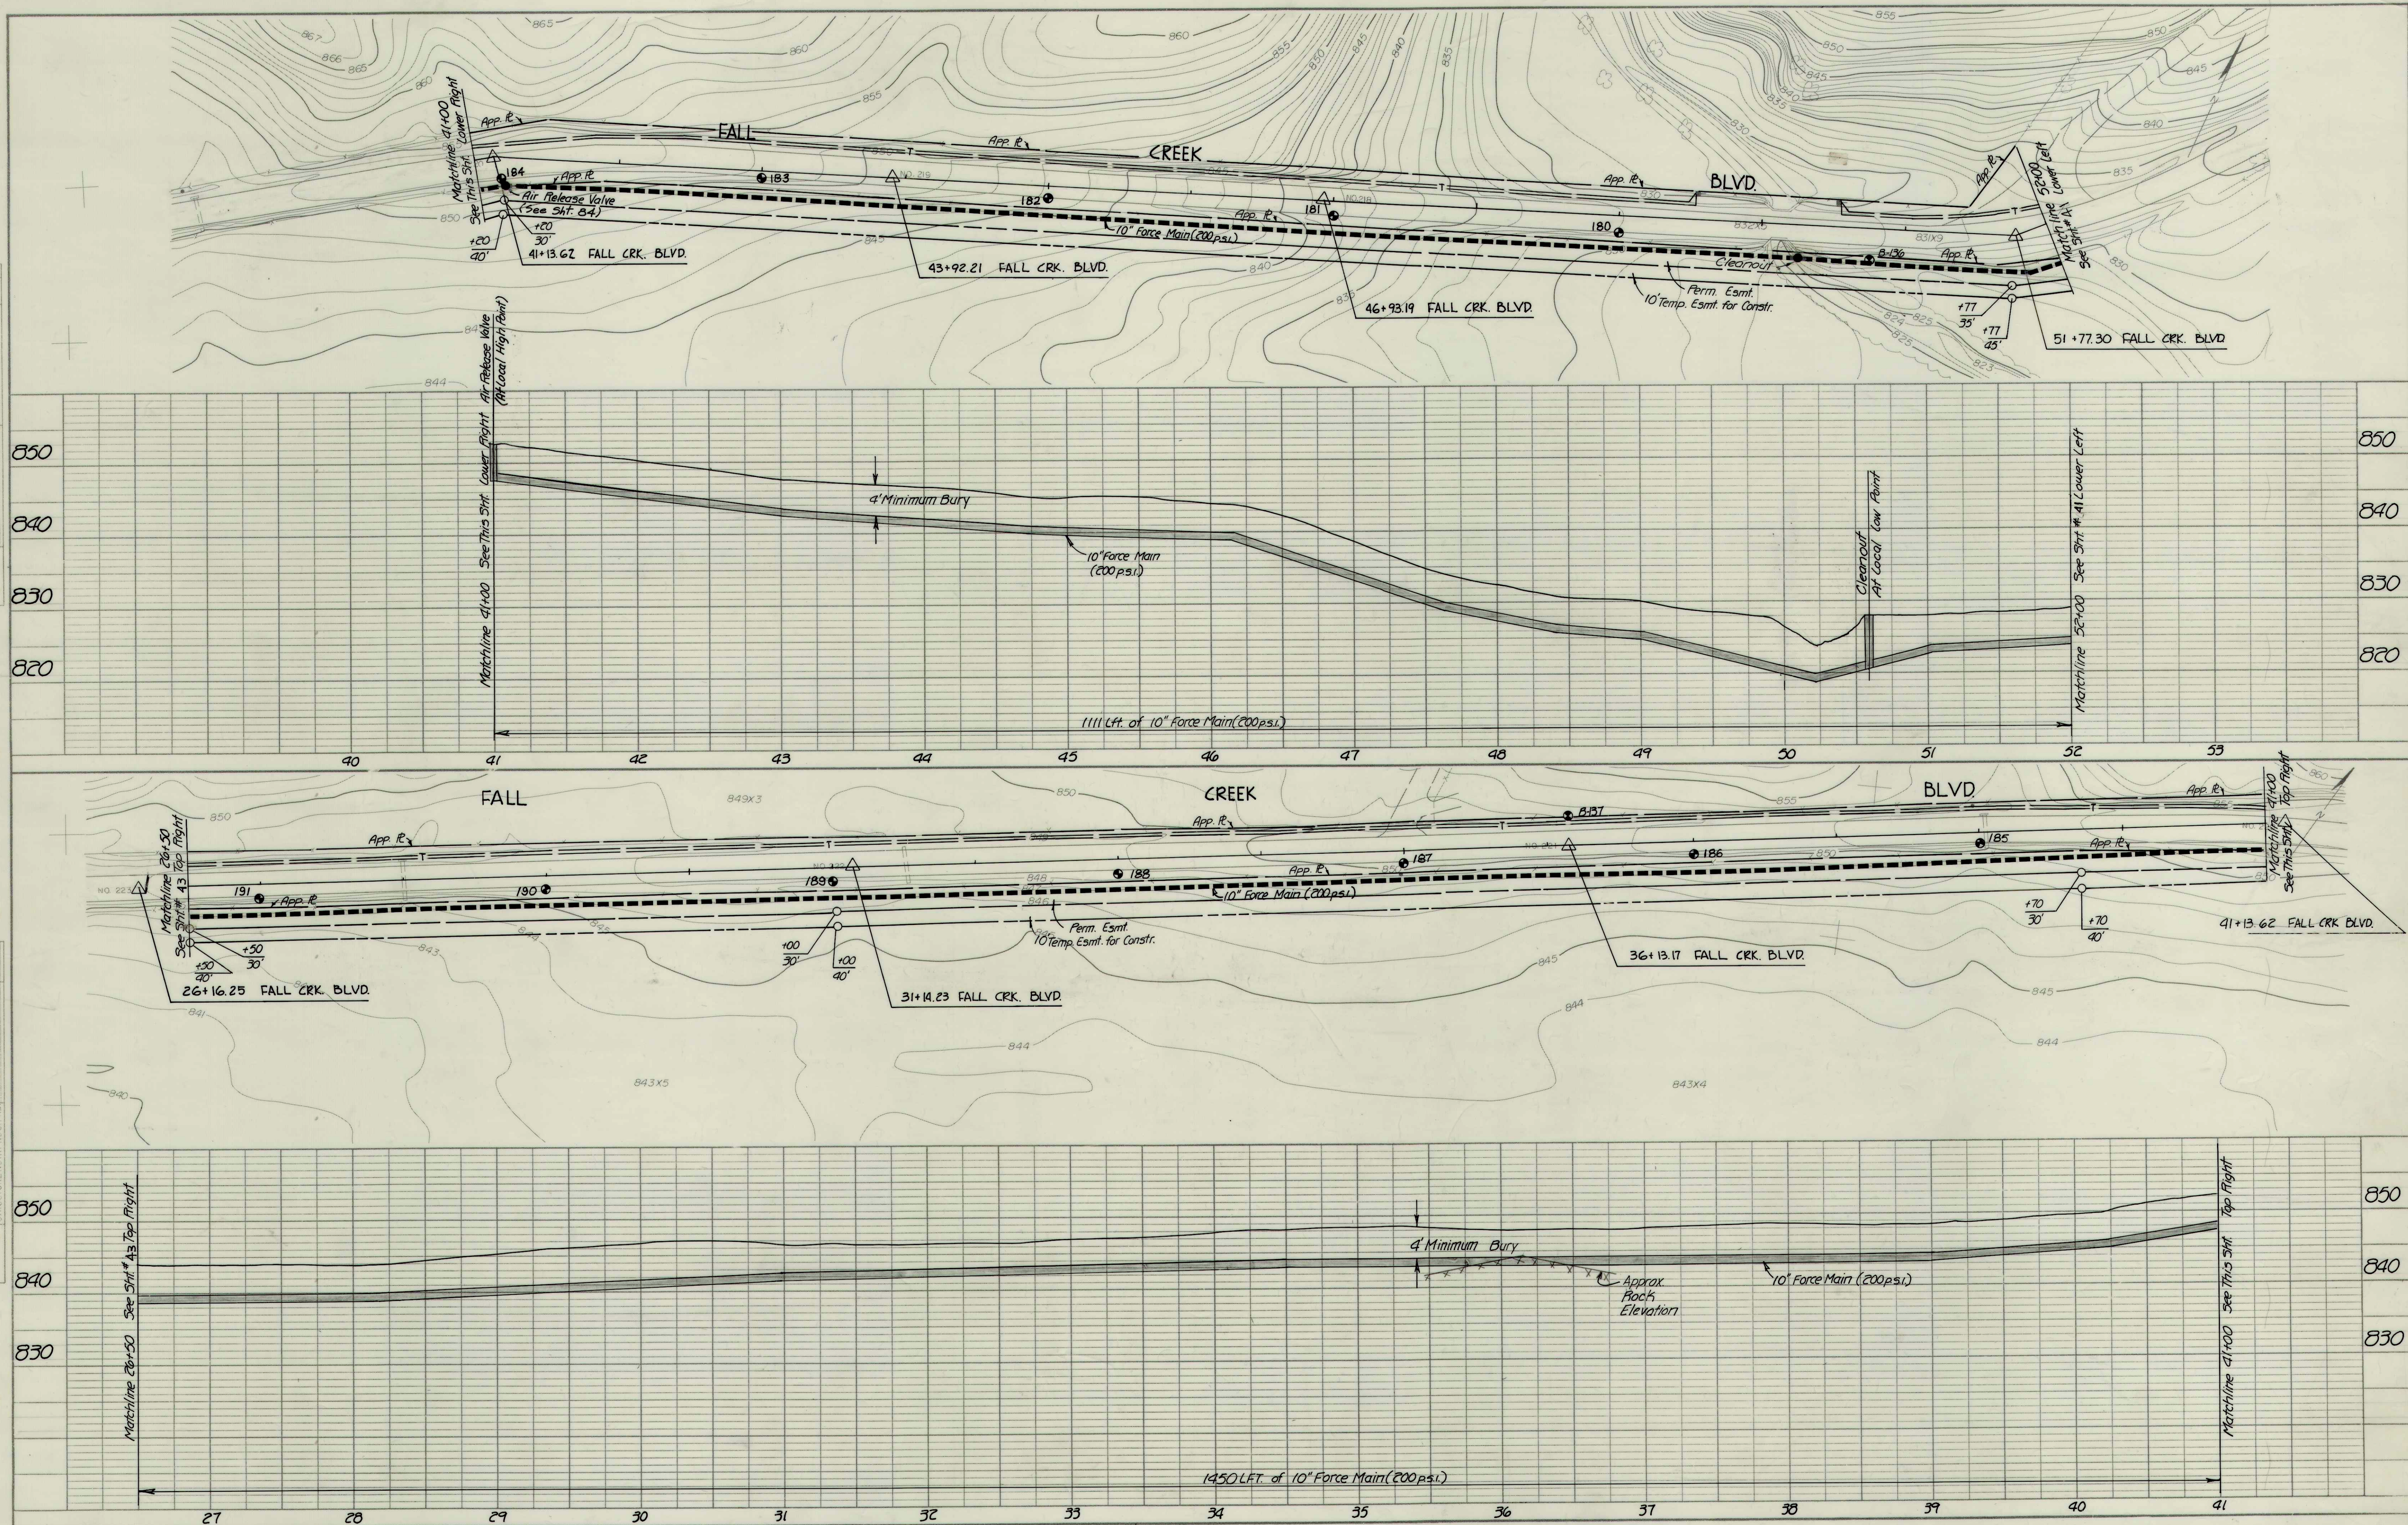

|                                  |                            |
|----------------------------------|----------------------------|
| FALL CREEK BLVD.                 |                            |
| FALL CREEK R.W.D. PLAN & PROFILE |                            |
| HORIZ. 1"=50'                    | BEAM, LONGEST & NEFF, INC. |
| VERT. 1"=10'                     | CONSULTING ENGINEERS       |
|                                  | INDIANAPOLIS, INDIANA      |
|                                  | SHEET 42                   |