


PLAN	SURVEYED	DATE
	PLOTTED	BY
	NOTES CHECKED	
	NO. OF DAYS CHECKED	

PROFILE	SURVEYED	DATE
	PLOTTED	BY
	NOTES CHECKED	
	STRUCTURE NOTATIONS CH. NO.	



RECORD DRAWING

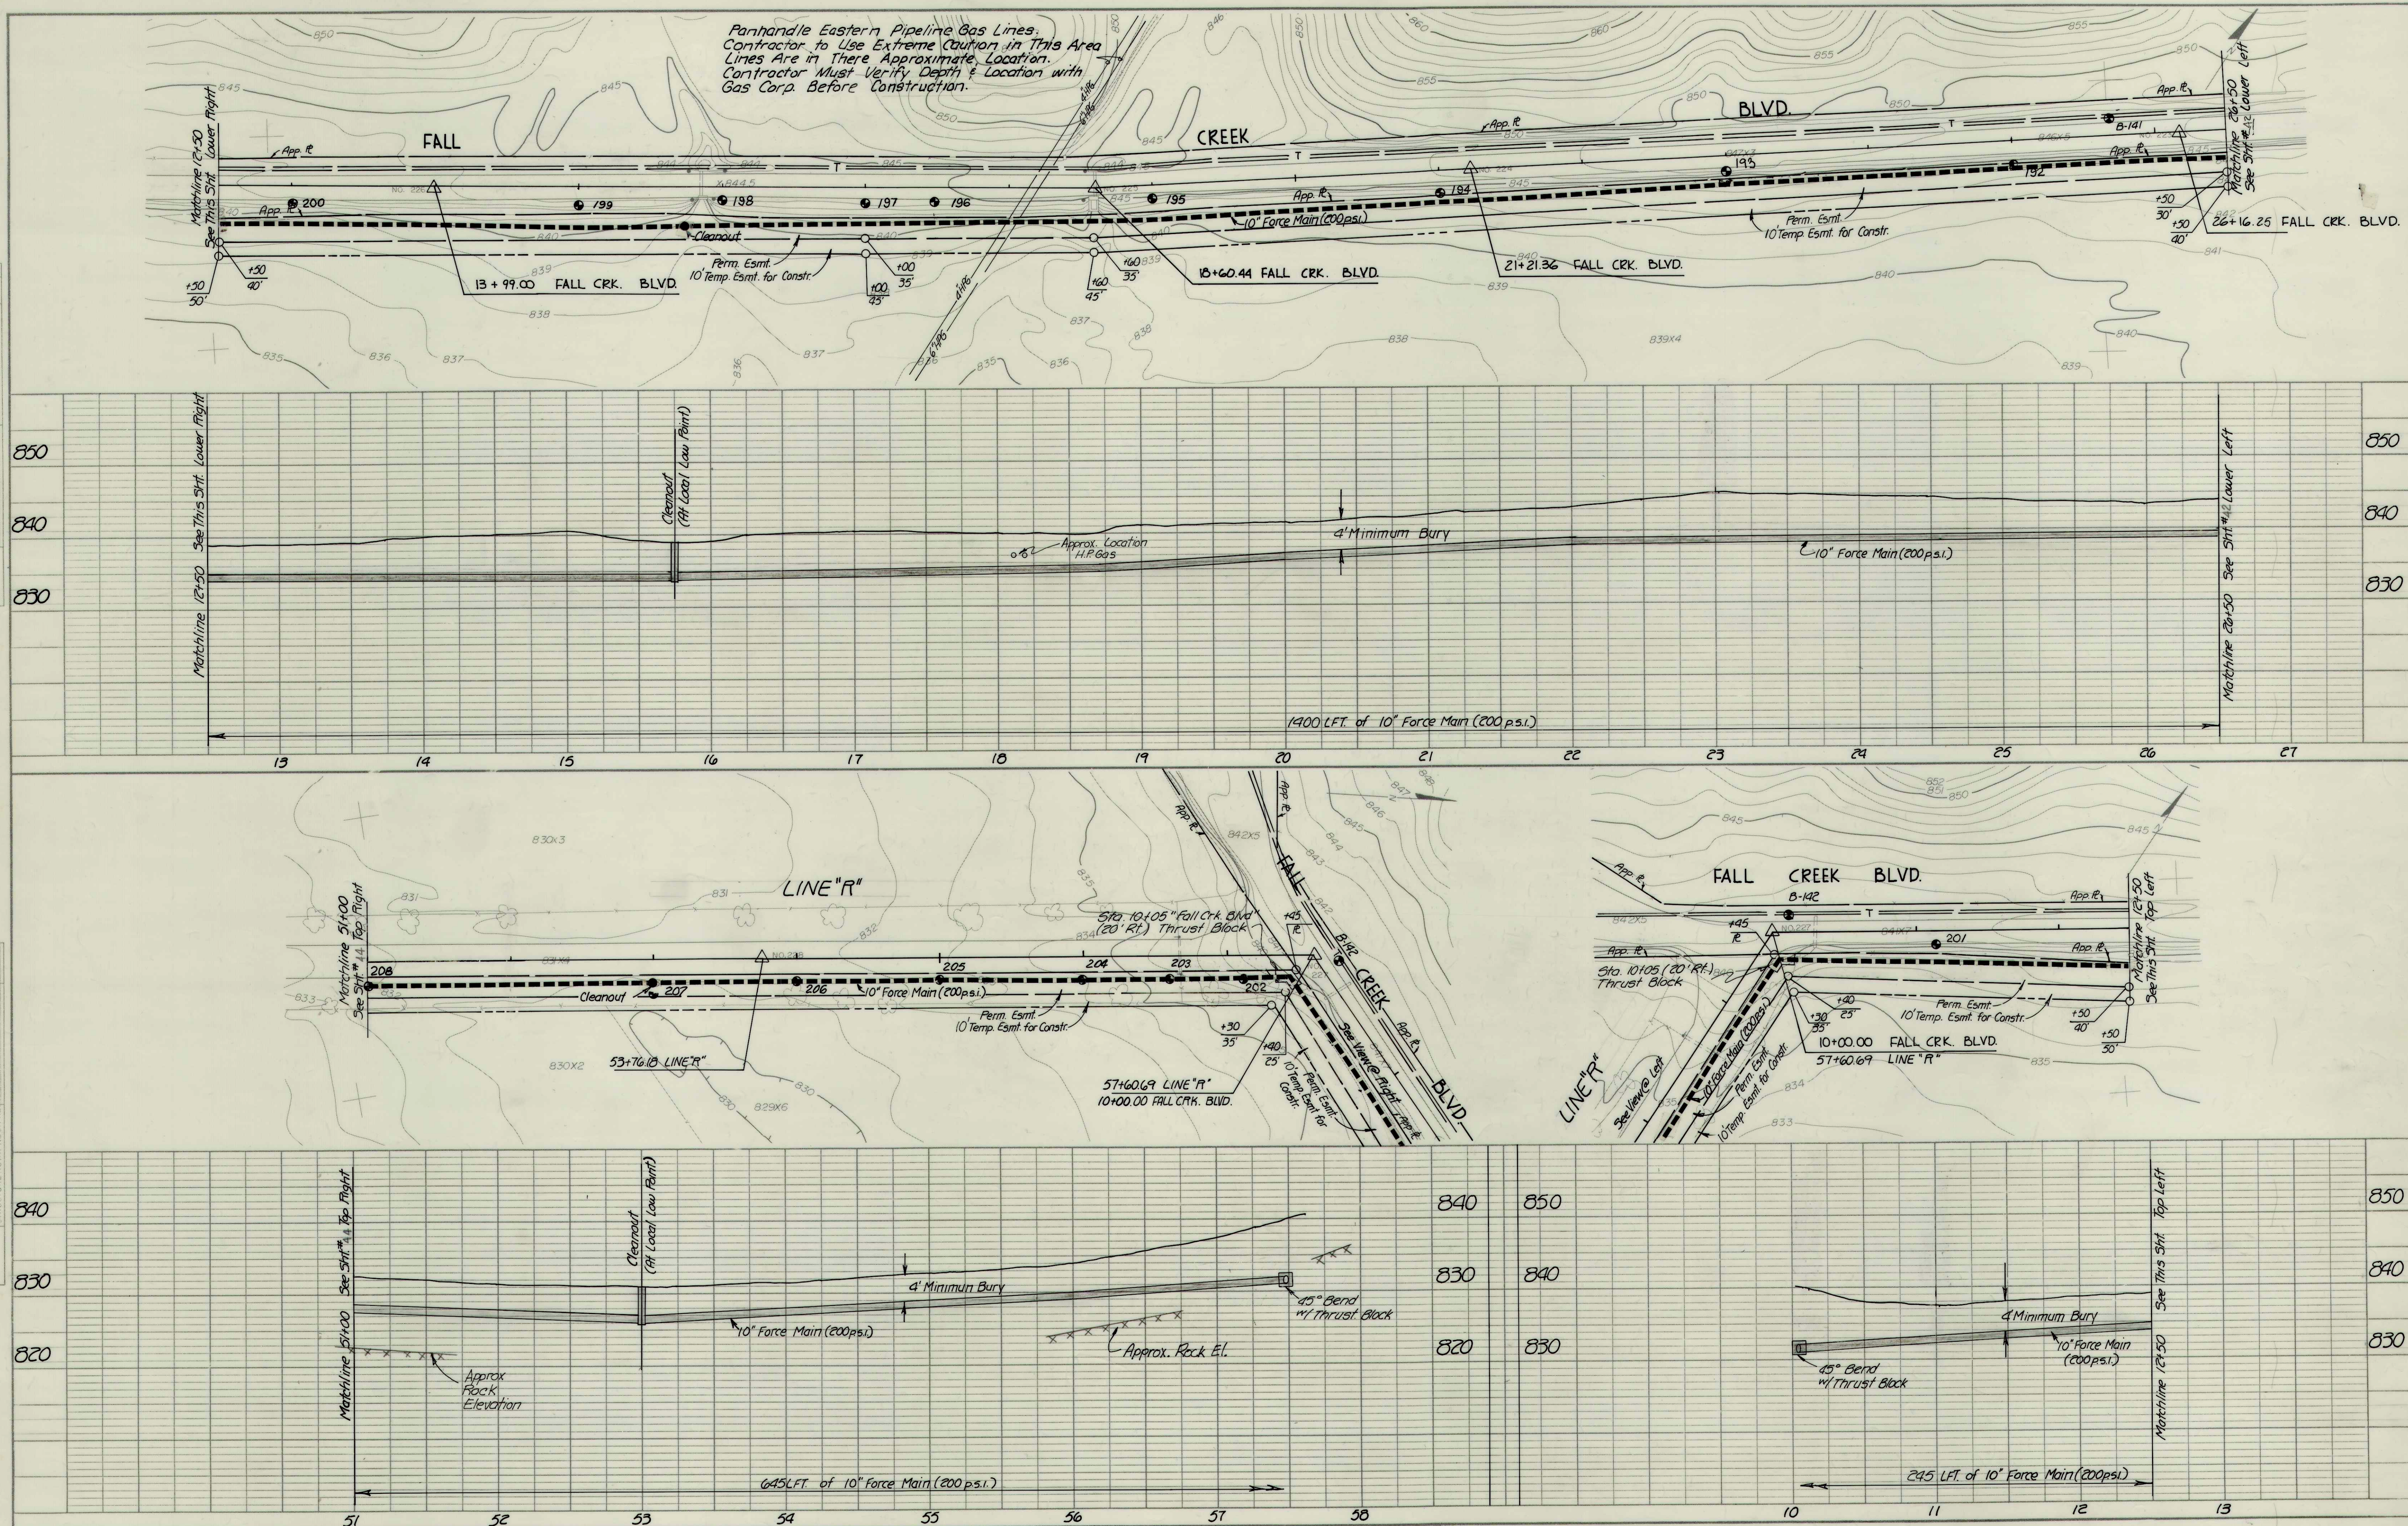

FALL CREEK BLVD / LINE "R"	
FALL CREEK R.W.D. PLAN & PROFILE SHEET	
HORIZ. 1"=50'	BEAM, LONGEST & NEFF, INC.
VERT. 1"=10'	CONSULTING ENGINEERS
	INDIANAPOLIS, INDIANA