


PLAN	DATE	
	BY	
	SURVEYED	
	NOTED	
NOTE BOOK		
ALIGNMENT CHECKED		
RT. OF WAY CHECKED		
NO.		

PROFILE	DATE	
	BY	
	SURVEYED	
	NOTED	
NOTE BOOK		
GRADES CHECKED		
B.M. NOTED		
STRUCTURE DATA PROVIDED		
NO.		



RECORD DRAWING

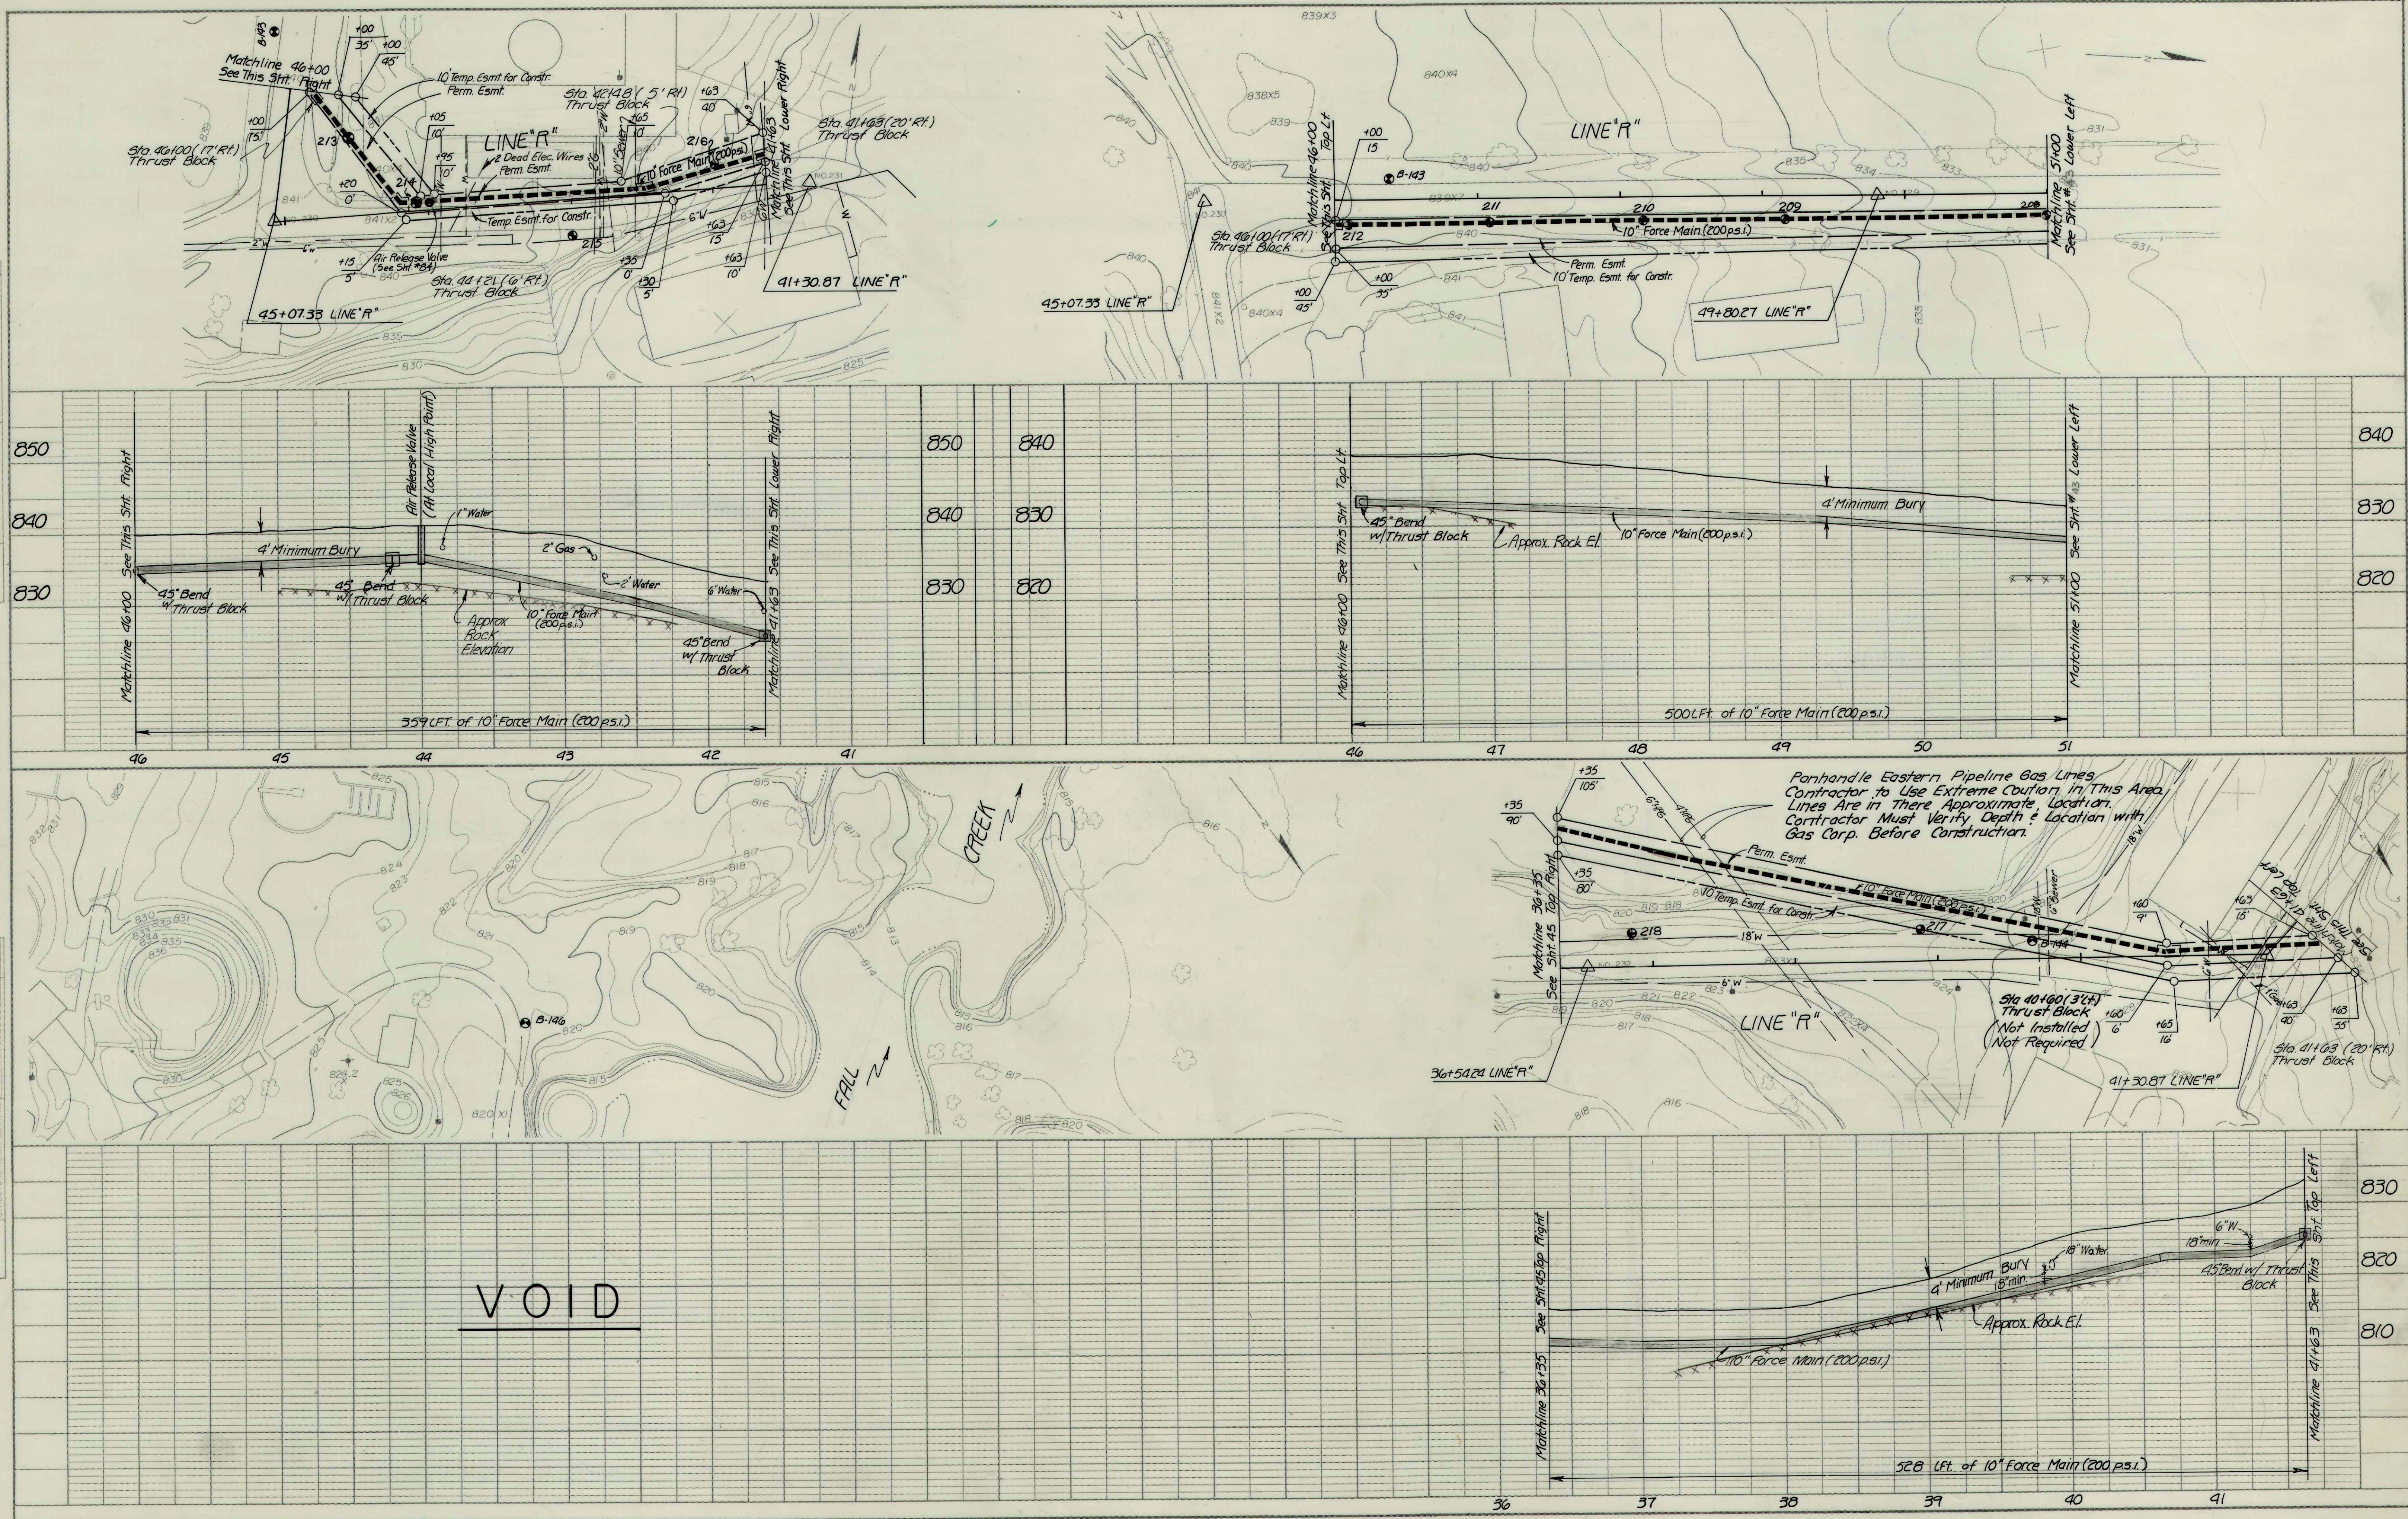

LINE "R"	
FALL CREEK R.W.D. PLAN & PROFILE	
HORIZ. 1"=50'	BEAM, LONGEST & NEFF, INC.
VERT. 1"=10'	CONSULTING ENGINEERS
	INDIANAPOLIS, INDIANA
	44