


PROFILE	SURVEYED	BY	DATE
NOTE BOOK	PLOTTED		
NO.	GRADES CHECKED		
	R. M. NOTED		
	STRUCTURE NOTATIONS CHKD		



REVISED 3-19-84
CHANGED PERM R/W
TO PERM ESMT

RECORD DRAWING

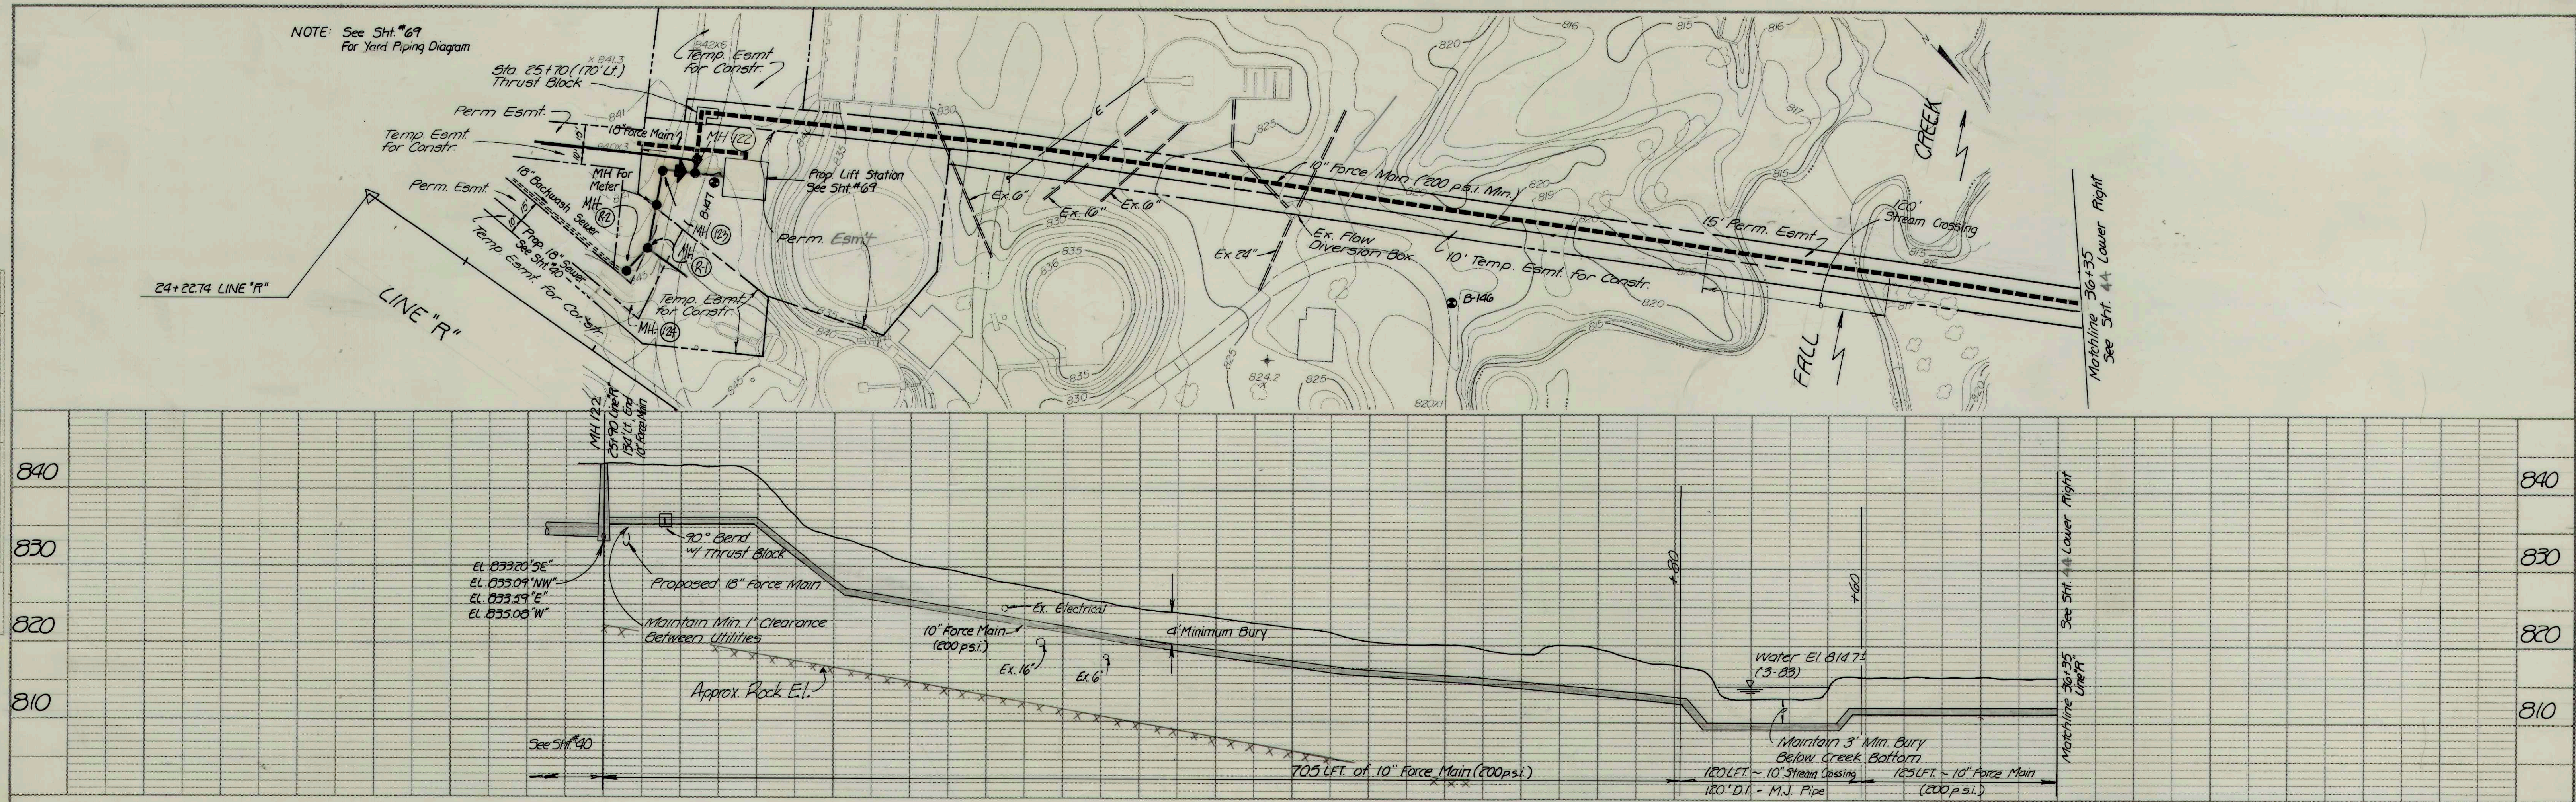

LINE "R"		
FALL CREEK R.W.D. PLAN & PROFILE		SHEET
HORIZ. 1" = 50'	BEAM, LONGEST & NEFF, INC.	
VERT. 1" = 10'	CONSULTING ENGINEERS	
	INDIANAPOLIS, INDIANA	