




RECORD DRAWING

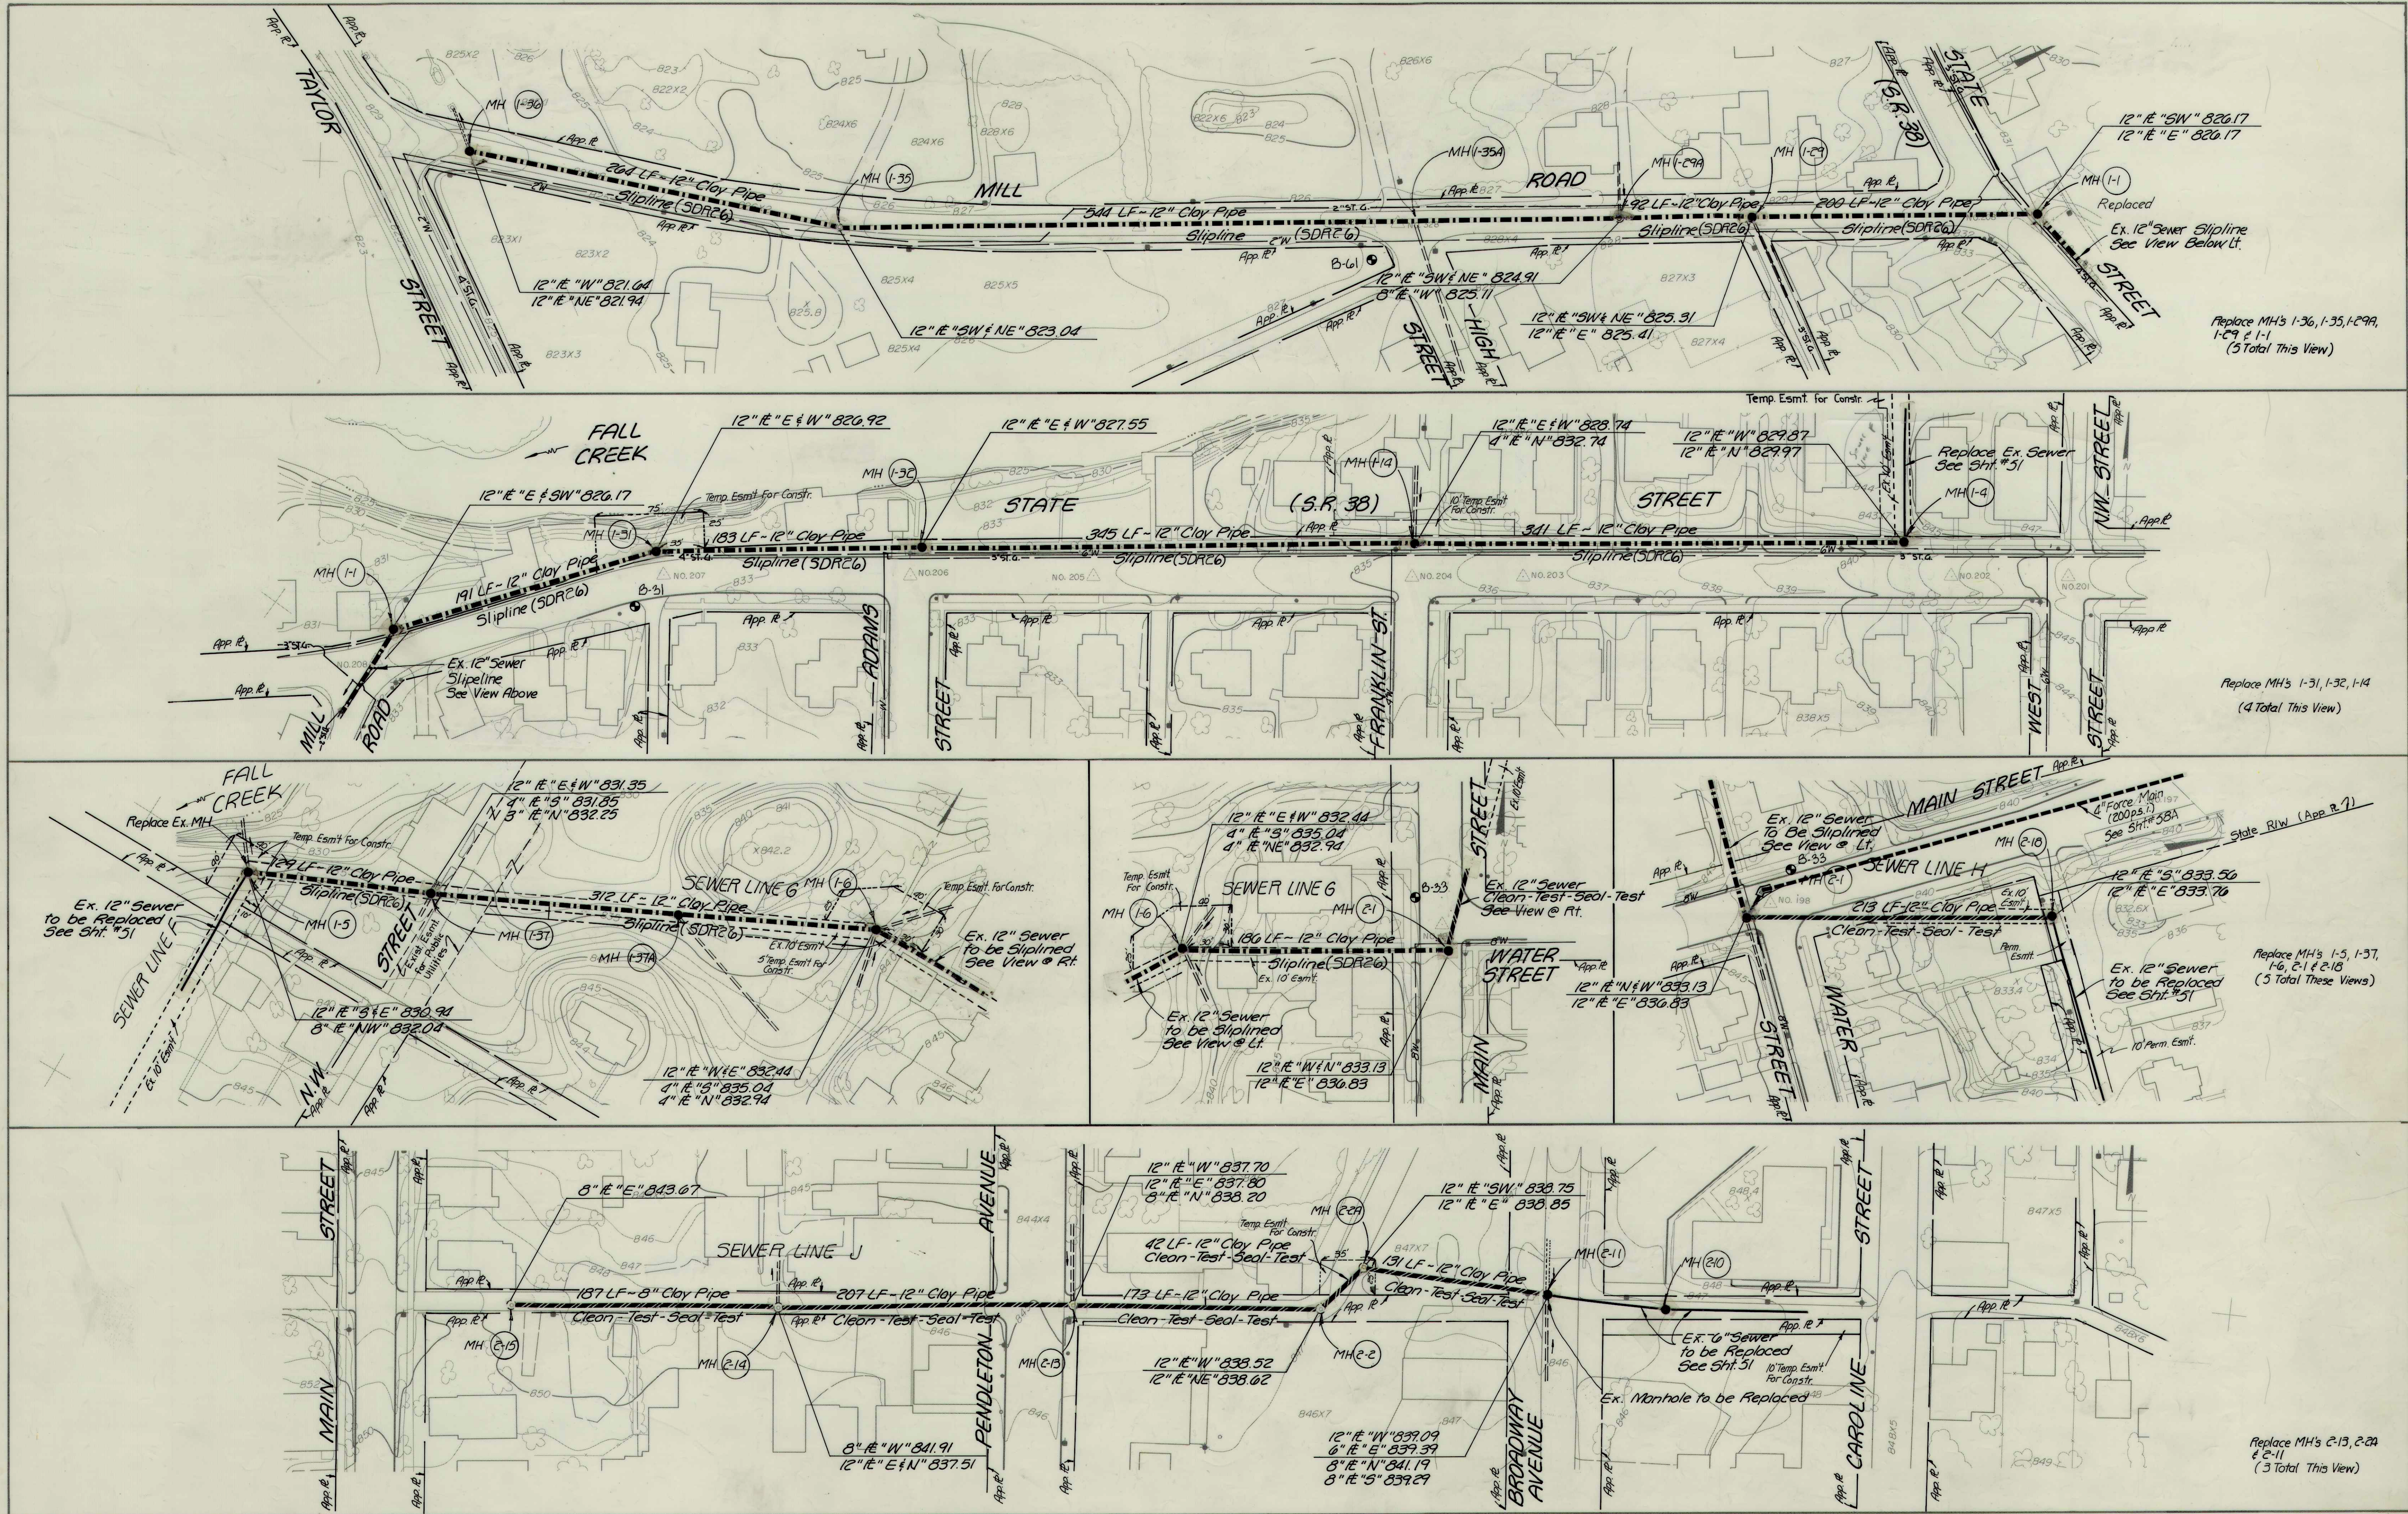

MILL ROAD, STATE STREET, SEWER LINE 6 SEWER LINE H, SEWER LINE J	
FALL CREEK R.W.D. PLAN	
HORIZ. 1"=50'	BEAM, LONGEST & NEFF, INC.
VERT. 1"=10'	CONSULTING ENGINEERS
	INDIANAPOLIS, INDIANA
SLIPLINE / CLEAN-TEST-SEAL-TEST	
SHEET 46	