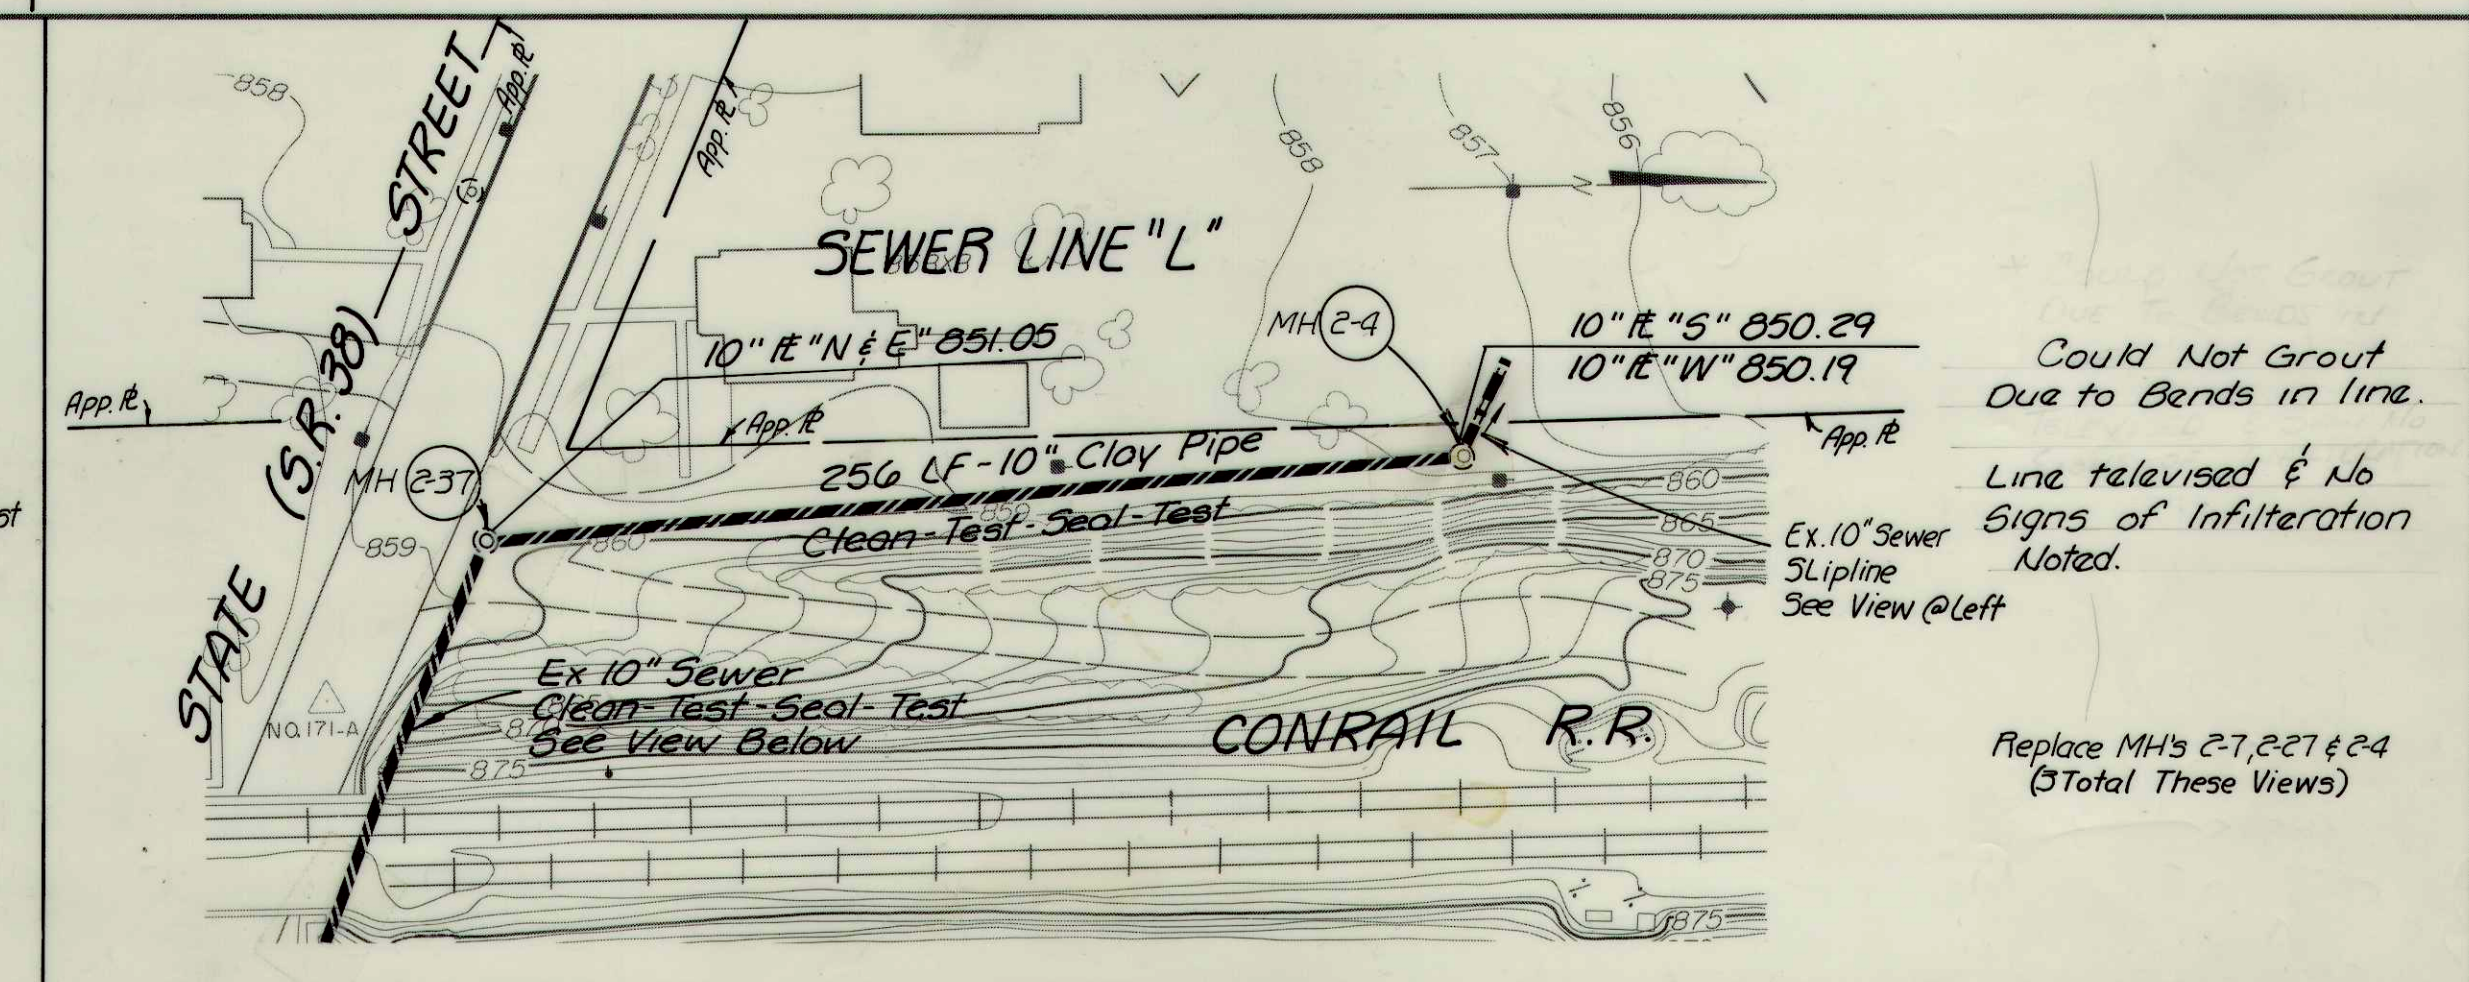
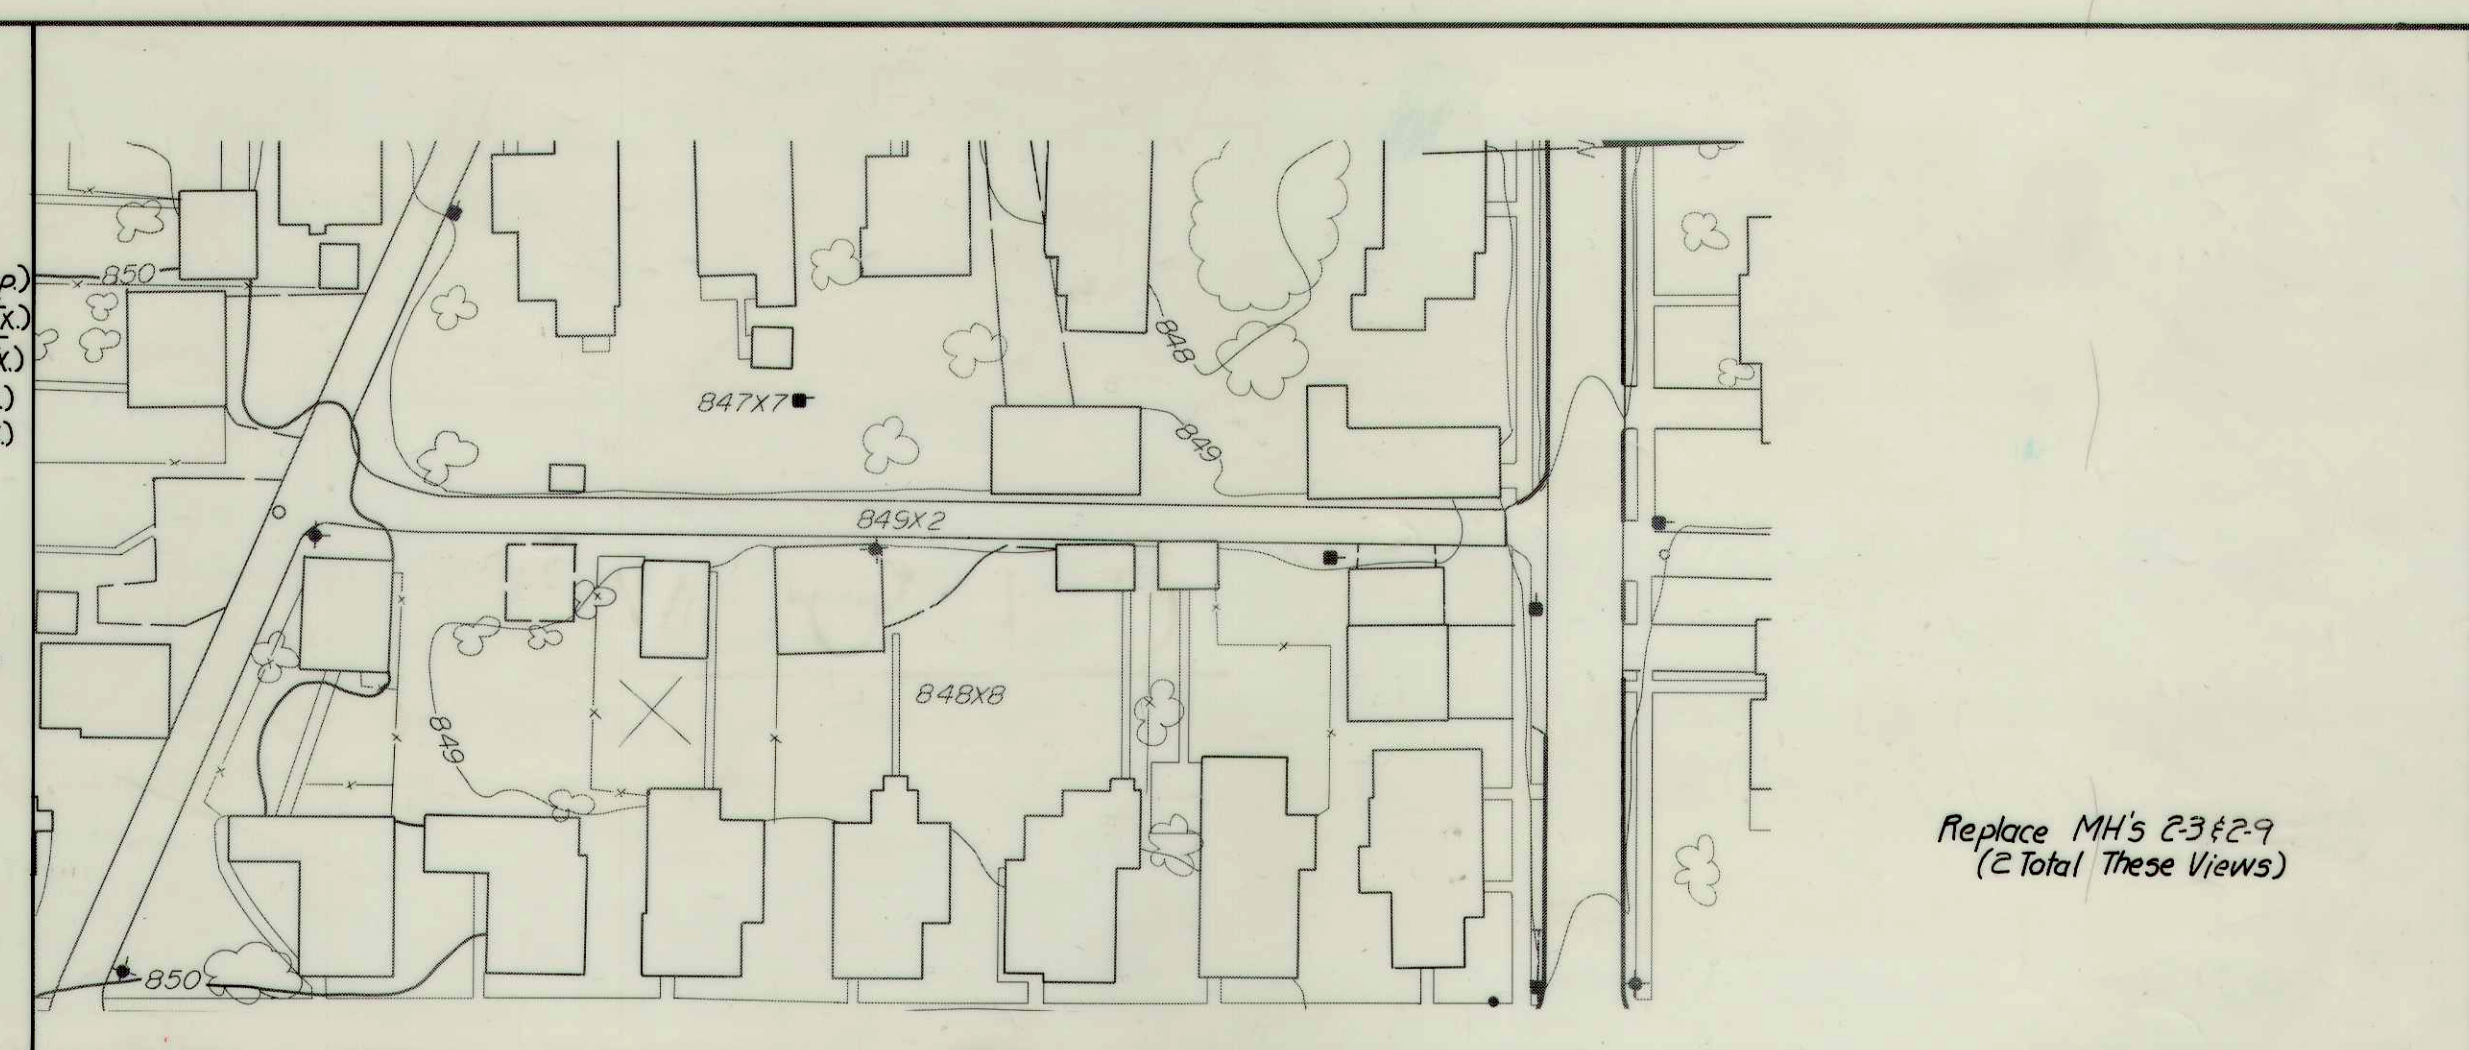


SEWER LINE "K", SEWER LINE "M", SEWER LINE "L" STATE ST, SEWER LINE "S", SEWER LINE "R" & SR 67		
FALL CREEK R.W.D. PLAN		SHEET
HORIZ. 1"=50'	BEAM, LONGEST & NEFF, INC. CONSULTING ENGINEERS INDIANAPOLIS, INDIANA	47
SLIPLINE / CLEAN-TEST-SEAL-TEST		