




RECORD DRAWING

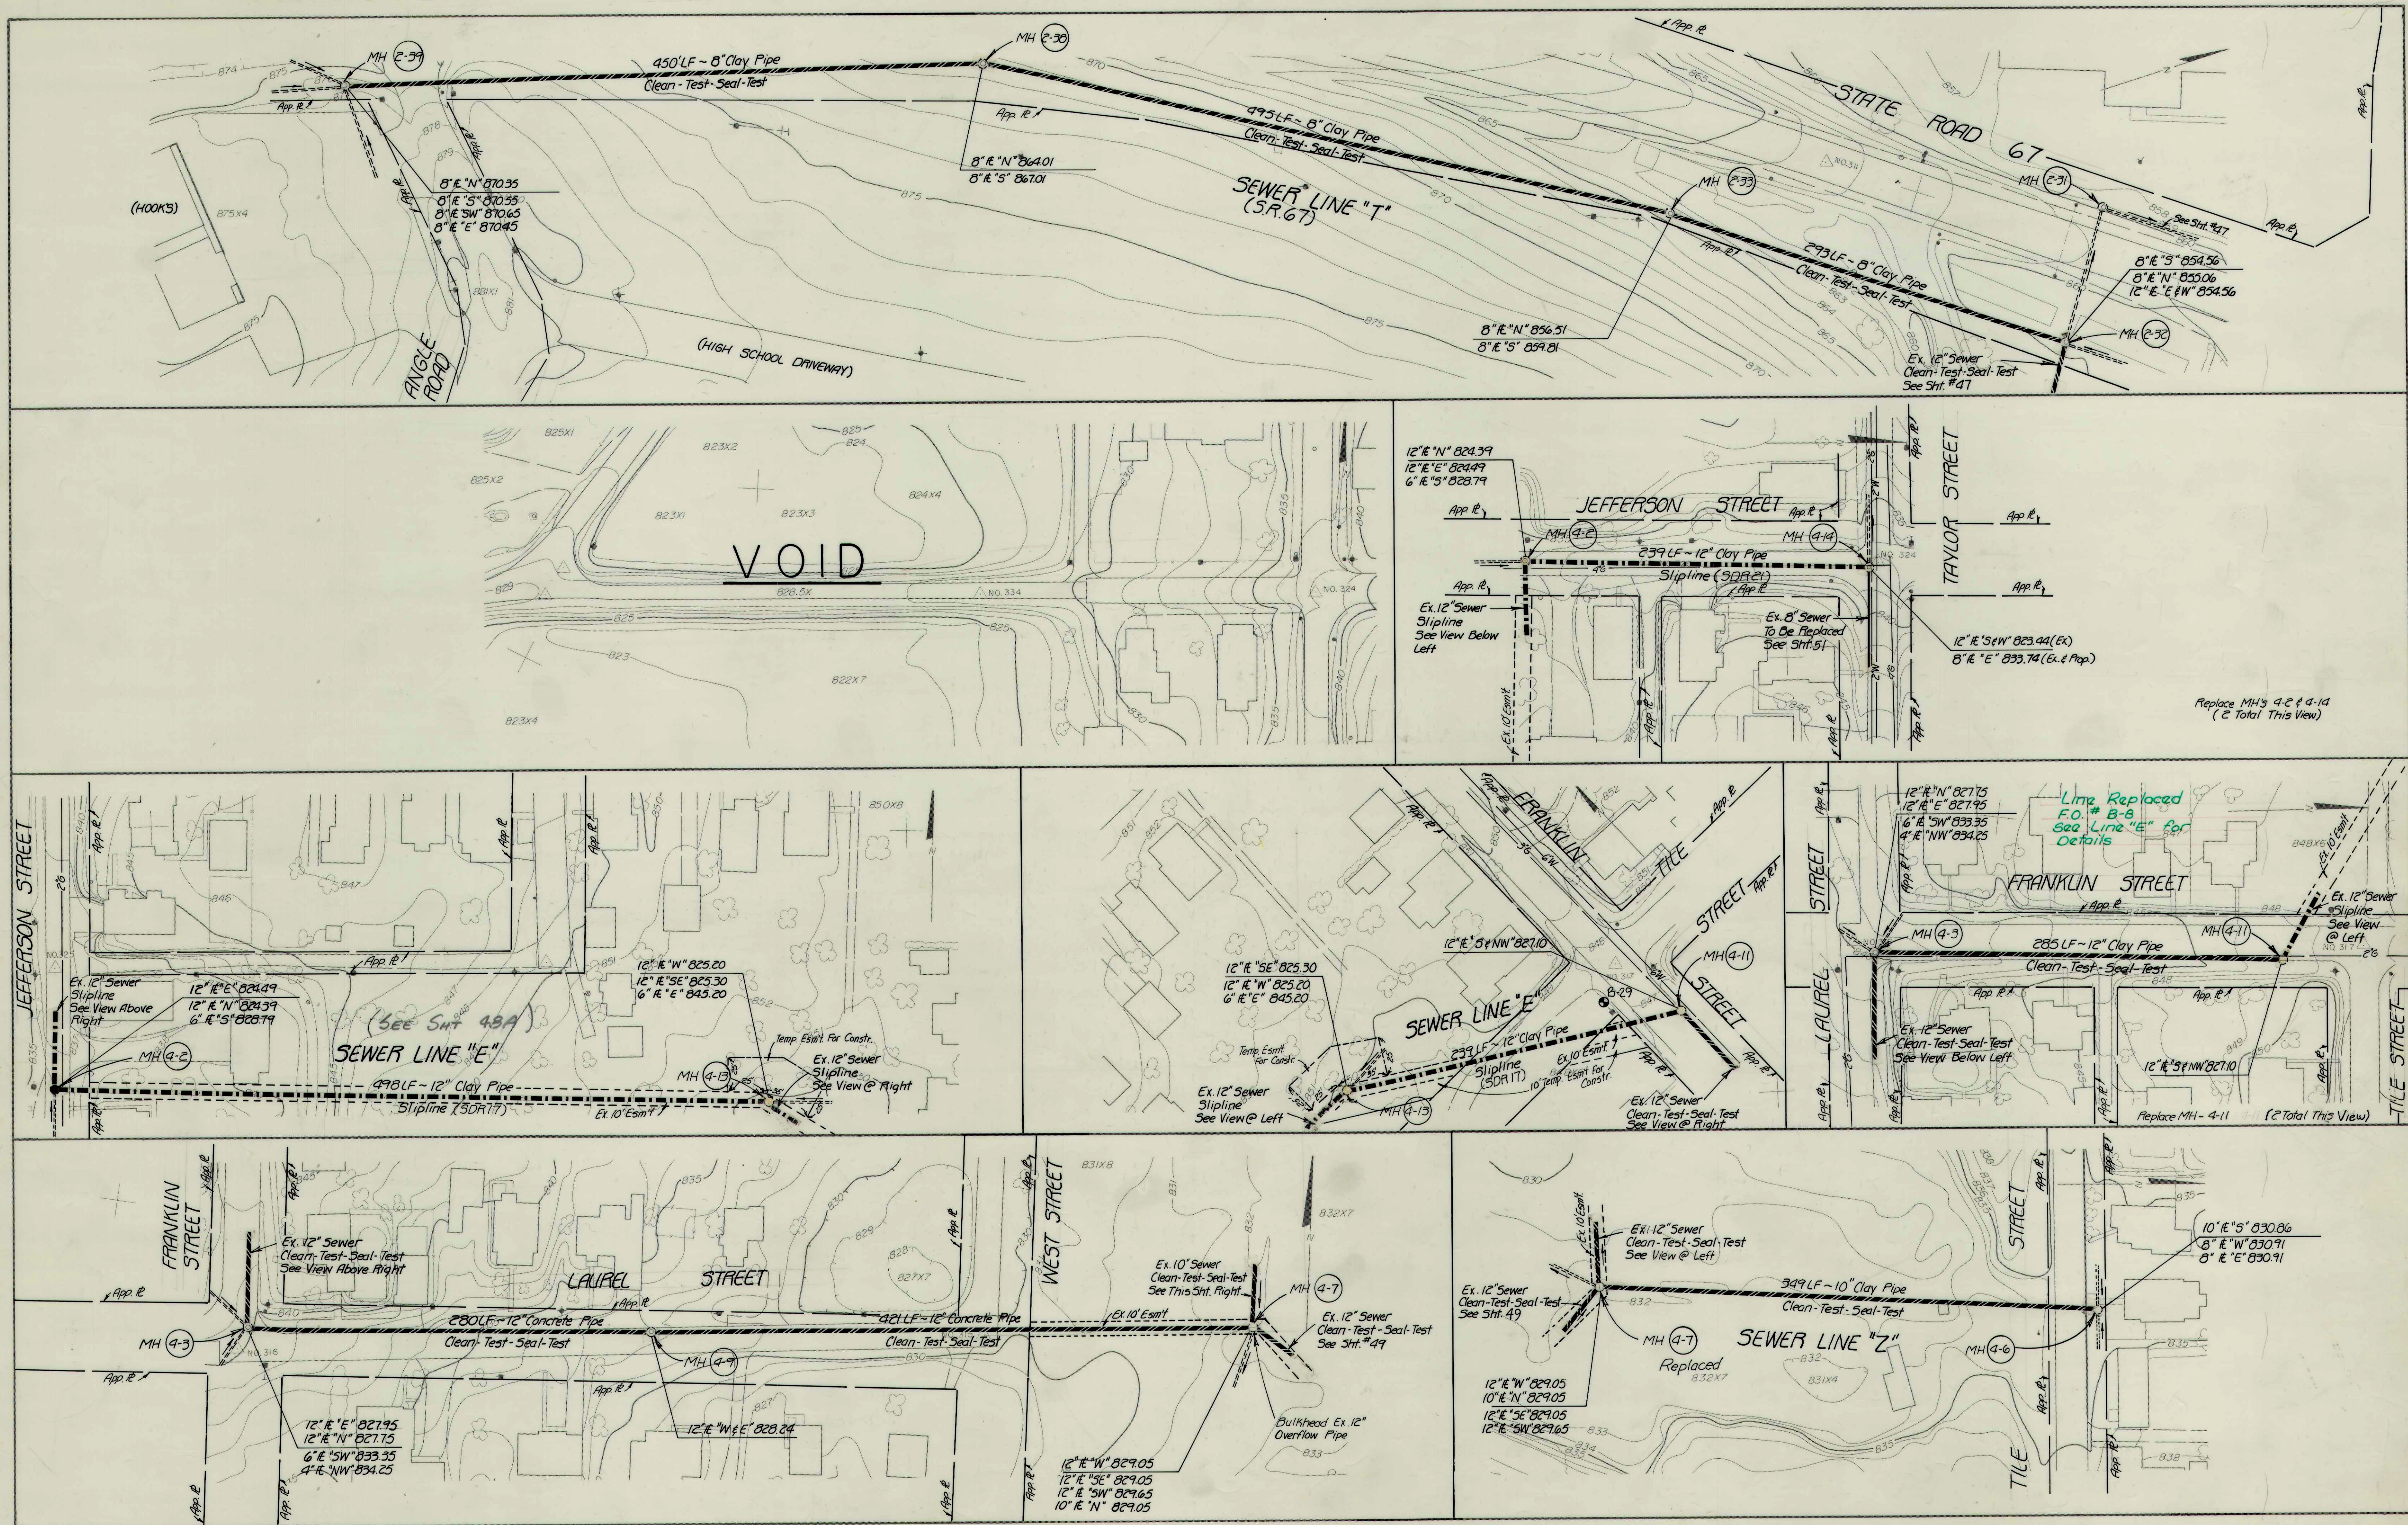

SEWER LINE "T", JEFFERSON ST, SEWER LINE "E" FRANKLIN ST, LAUREL ST, & SEWER LINE "Z"		
FALL CREEK R.W.D. PLAN		
HORIZ. 1"=50'	BEAM, LONGEST & NEFF, INC.	SHEET 48
VERT. 1"=10'	CONSULTING ENGINEERS INDIANAPOLIS, INDIANA	
SLOPIELINE / CLEAN-TEST-SEAL-TEST		