

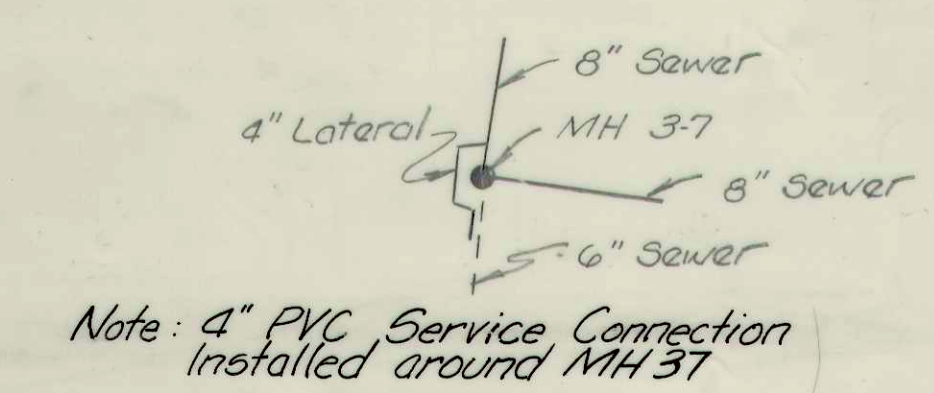
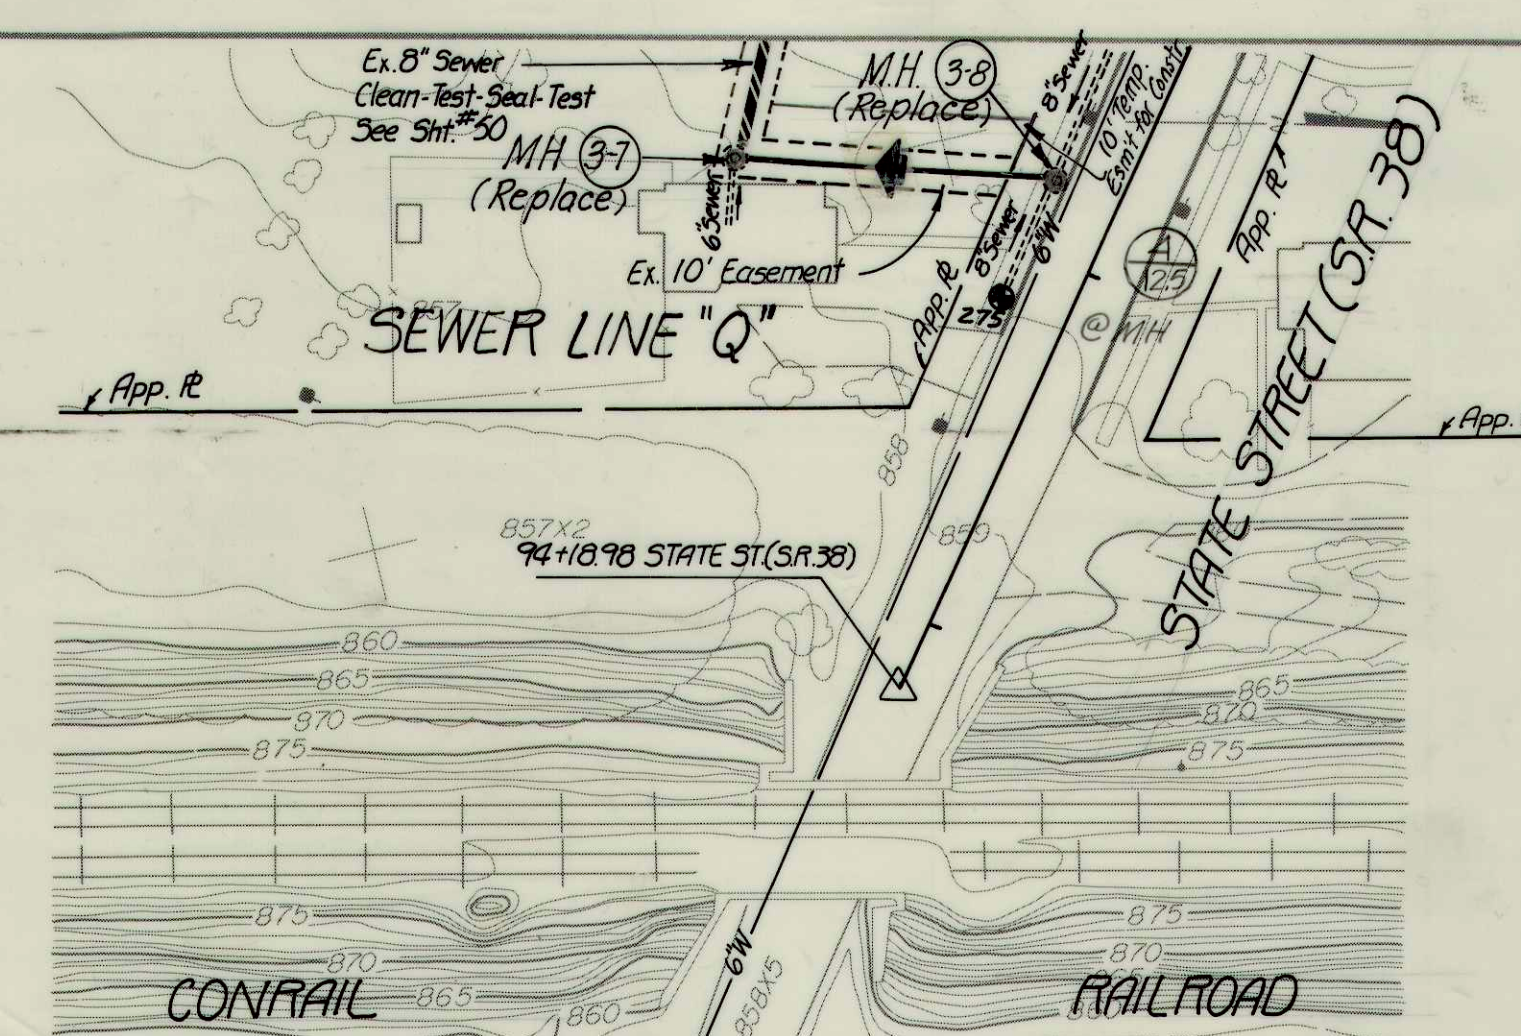
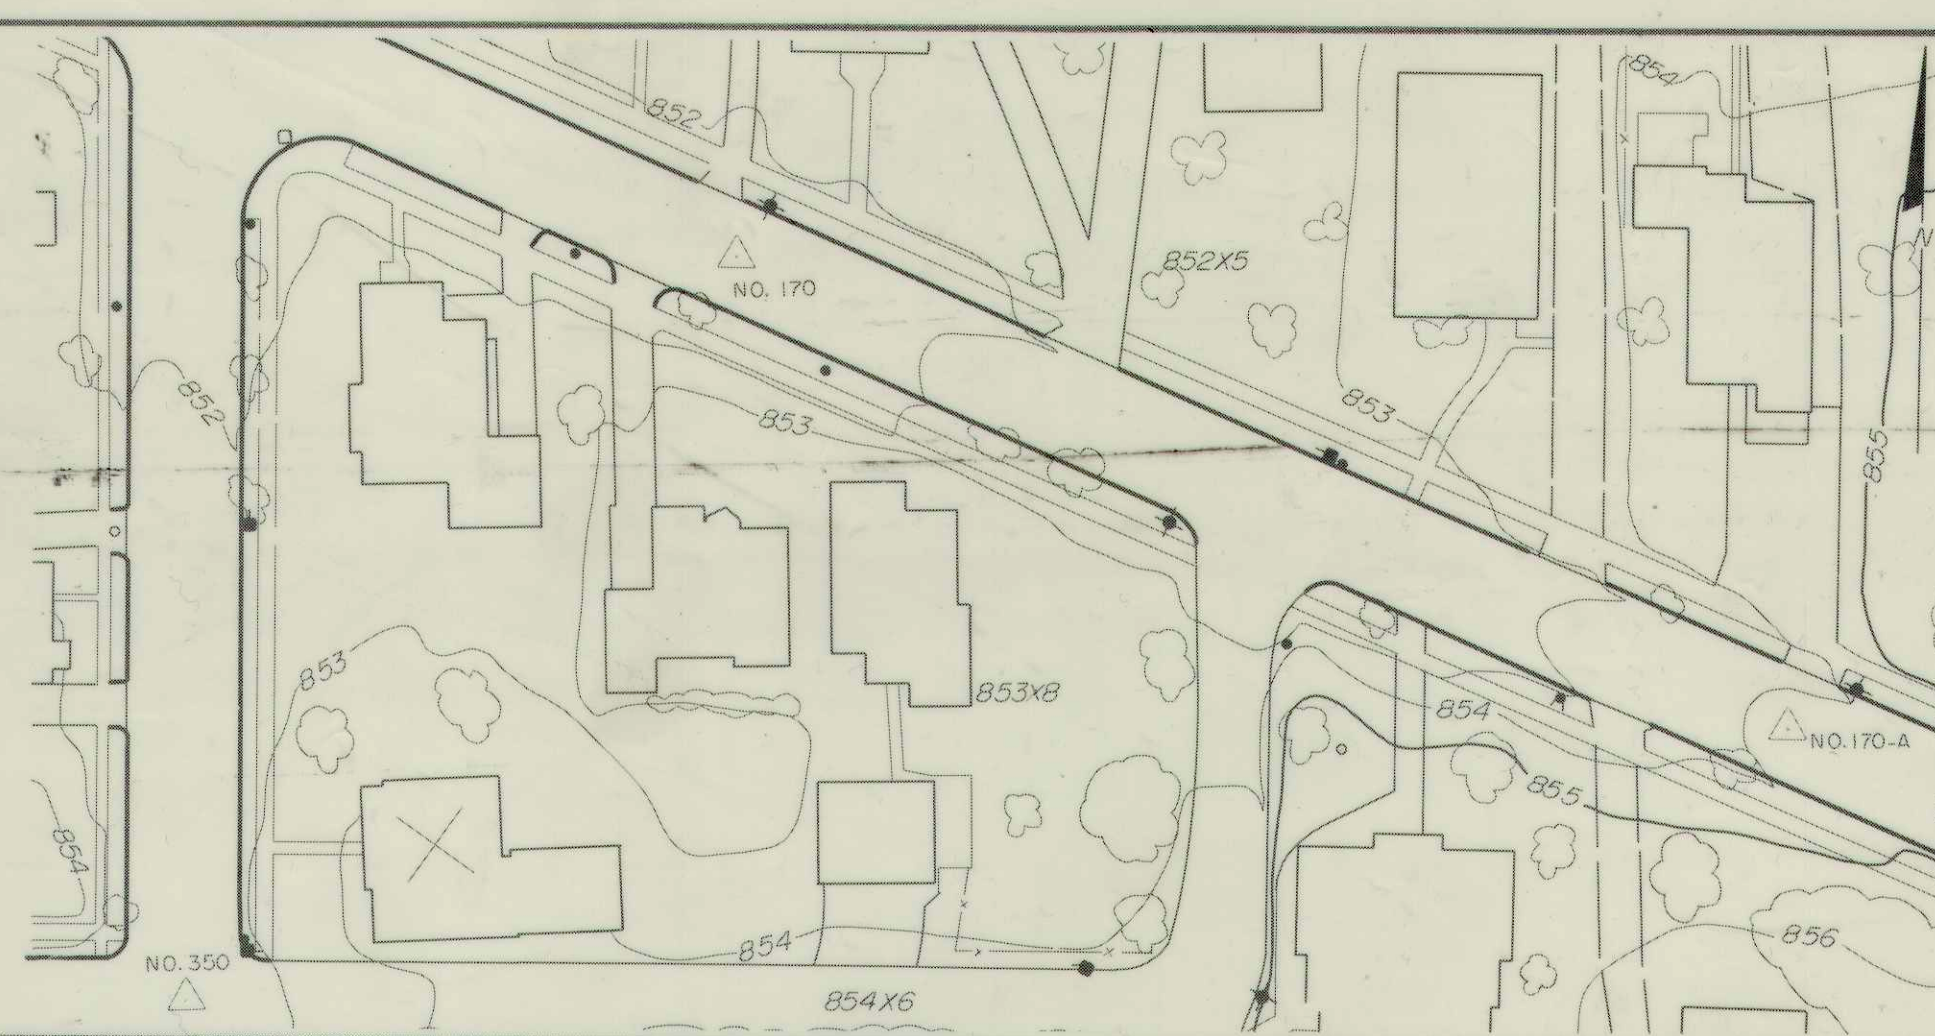
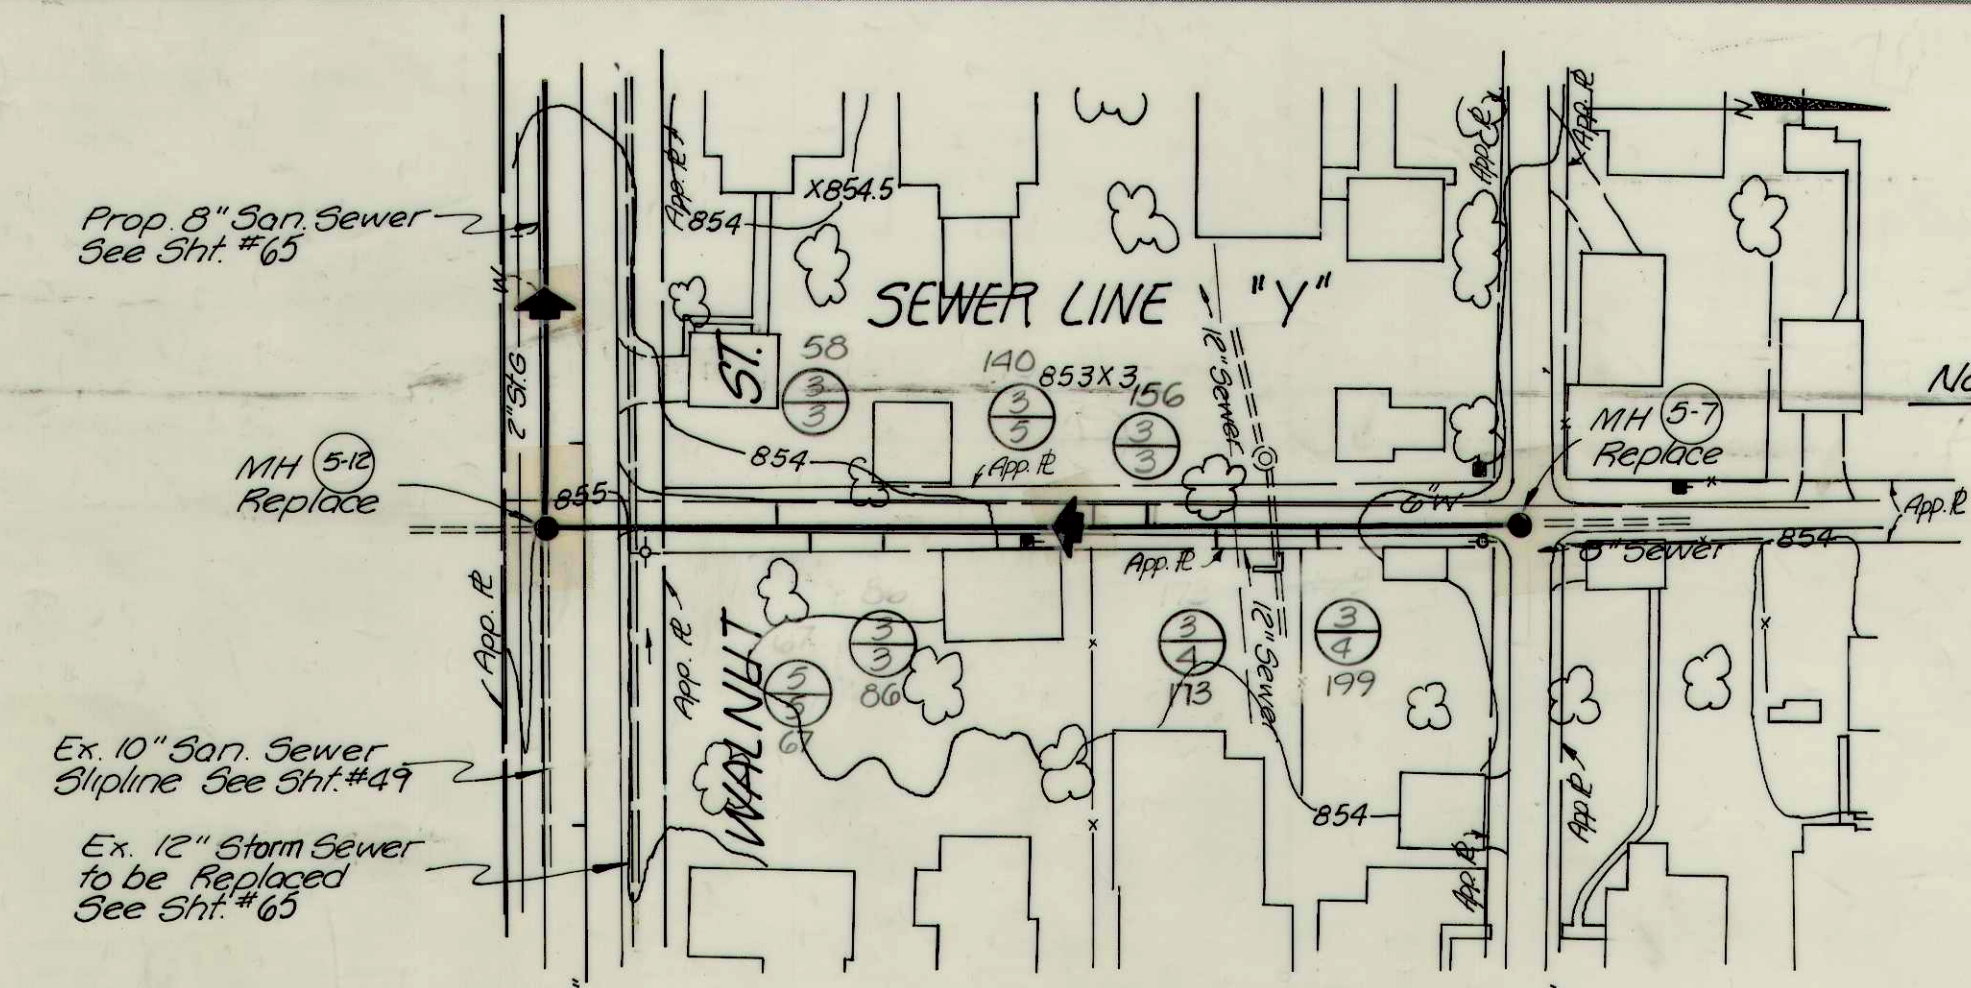


PLAN
 SURVEYED BY DATE
 PLOTTED BY DATE
 NOTE BOOK NO. CHECKED BY DATE
 STRUCTURE NOTATION CH. 60



PROFILE
 SURVEYED BY DATE
 PLOTTED BY DATE
 NOTE BOOK NO. CHECKED BY DATE
 STRUCTURE NOTATION CH. 60

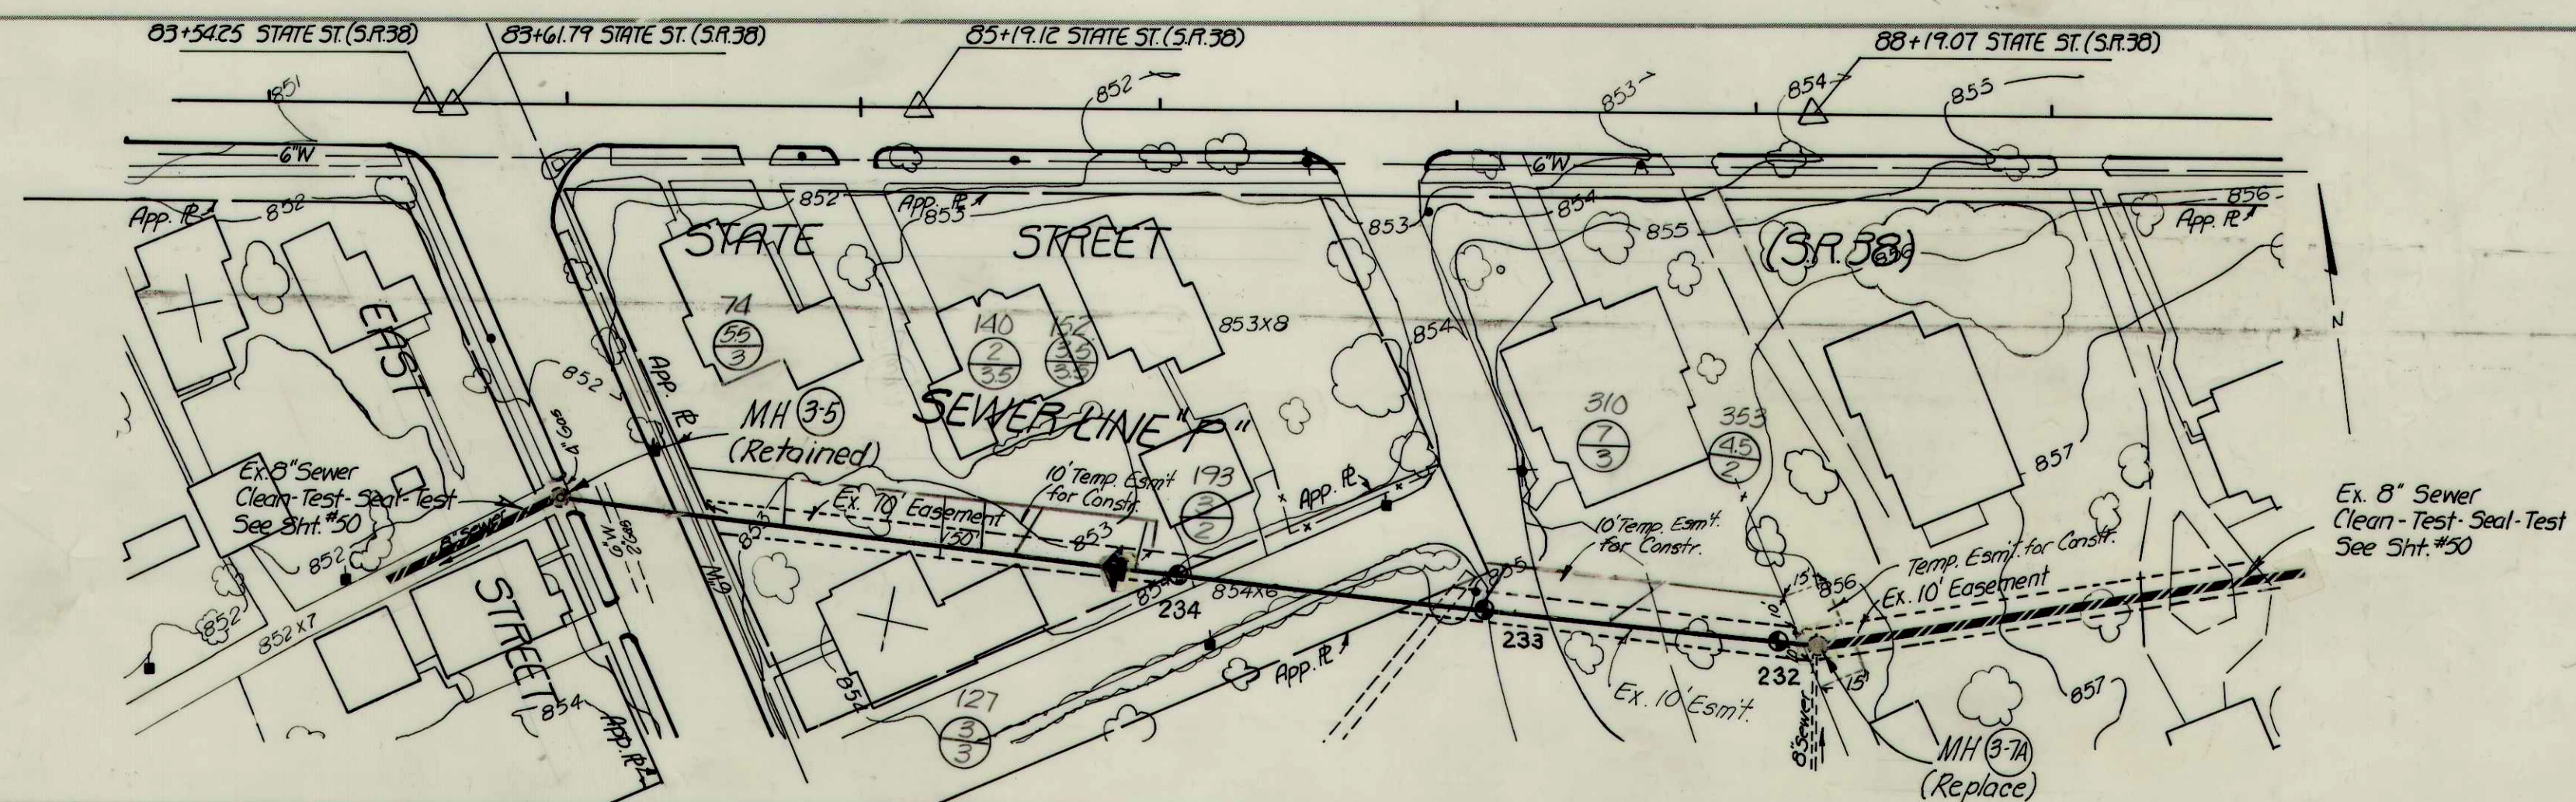

VOID

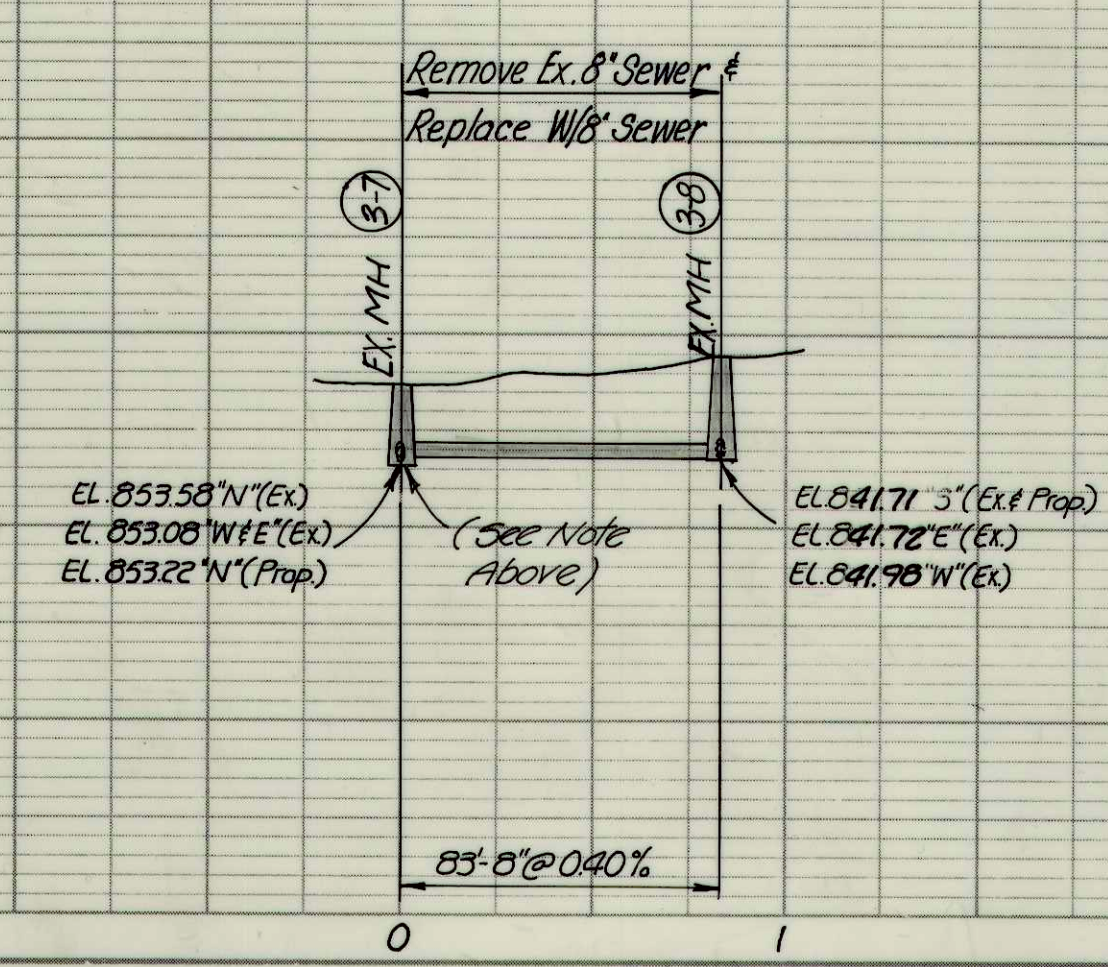

Note: Contractor Shall Bulkhead Ex. 12" Storm Sewer @ Crossing Only After Determining Whether Any Flow is Existing in This Sewer From The East and After Approval of The Engineer and After Construction of New Storm Sewer on East St.

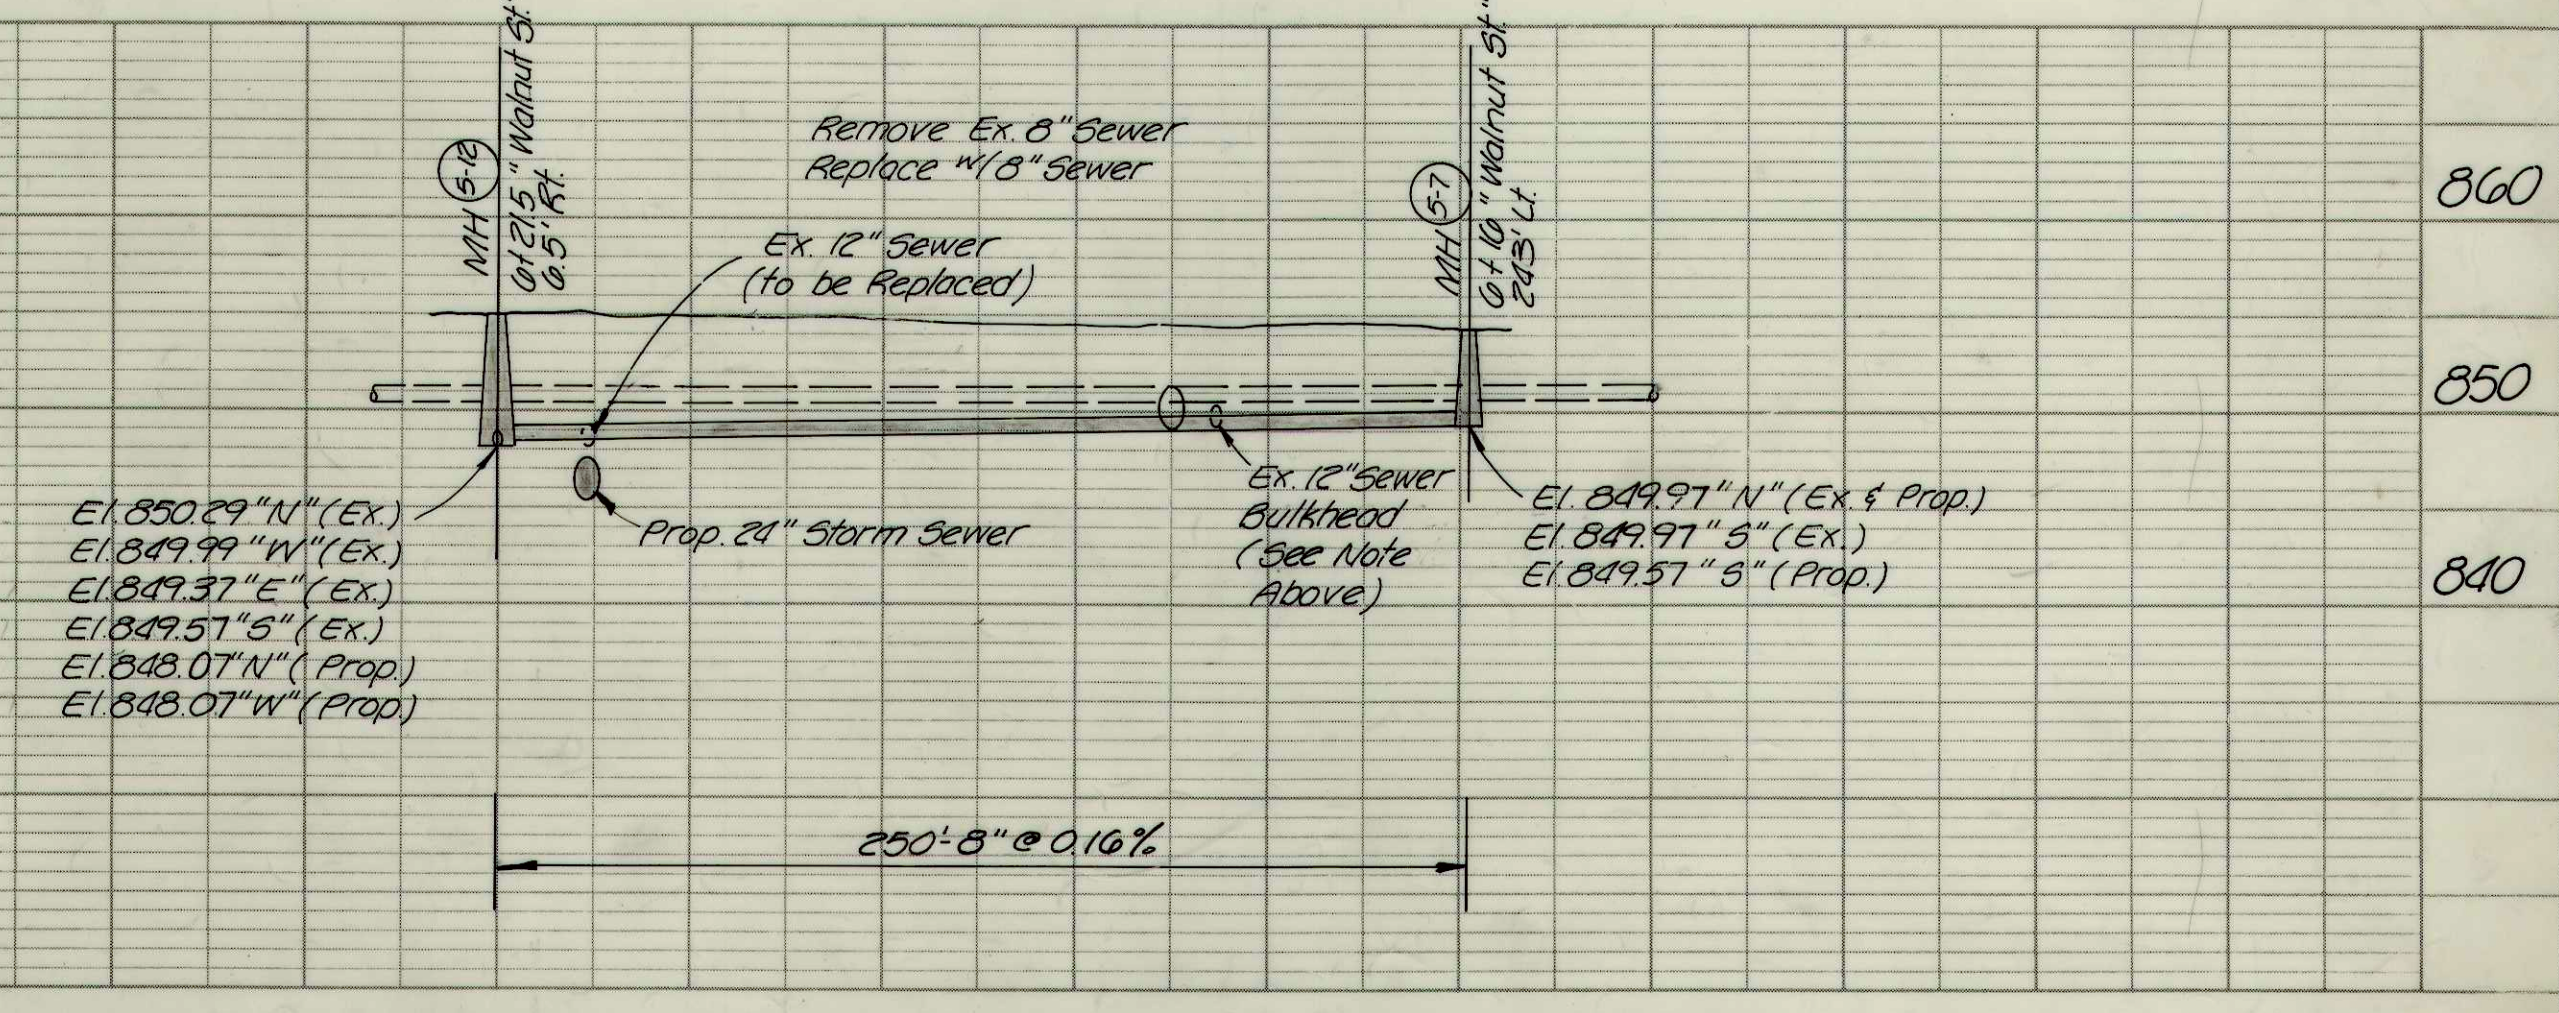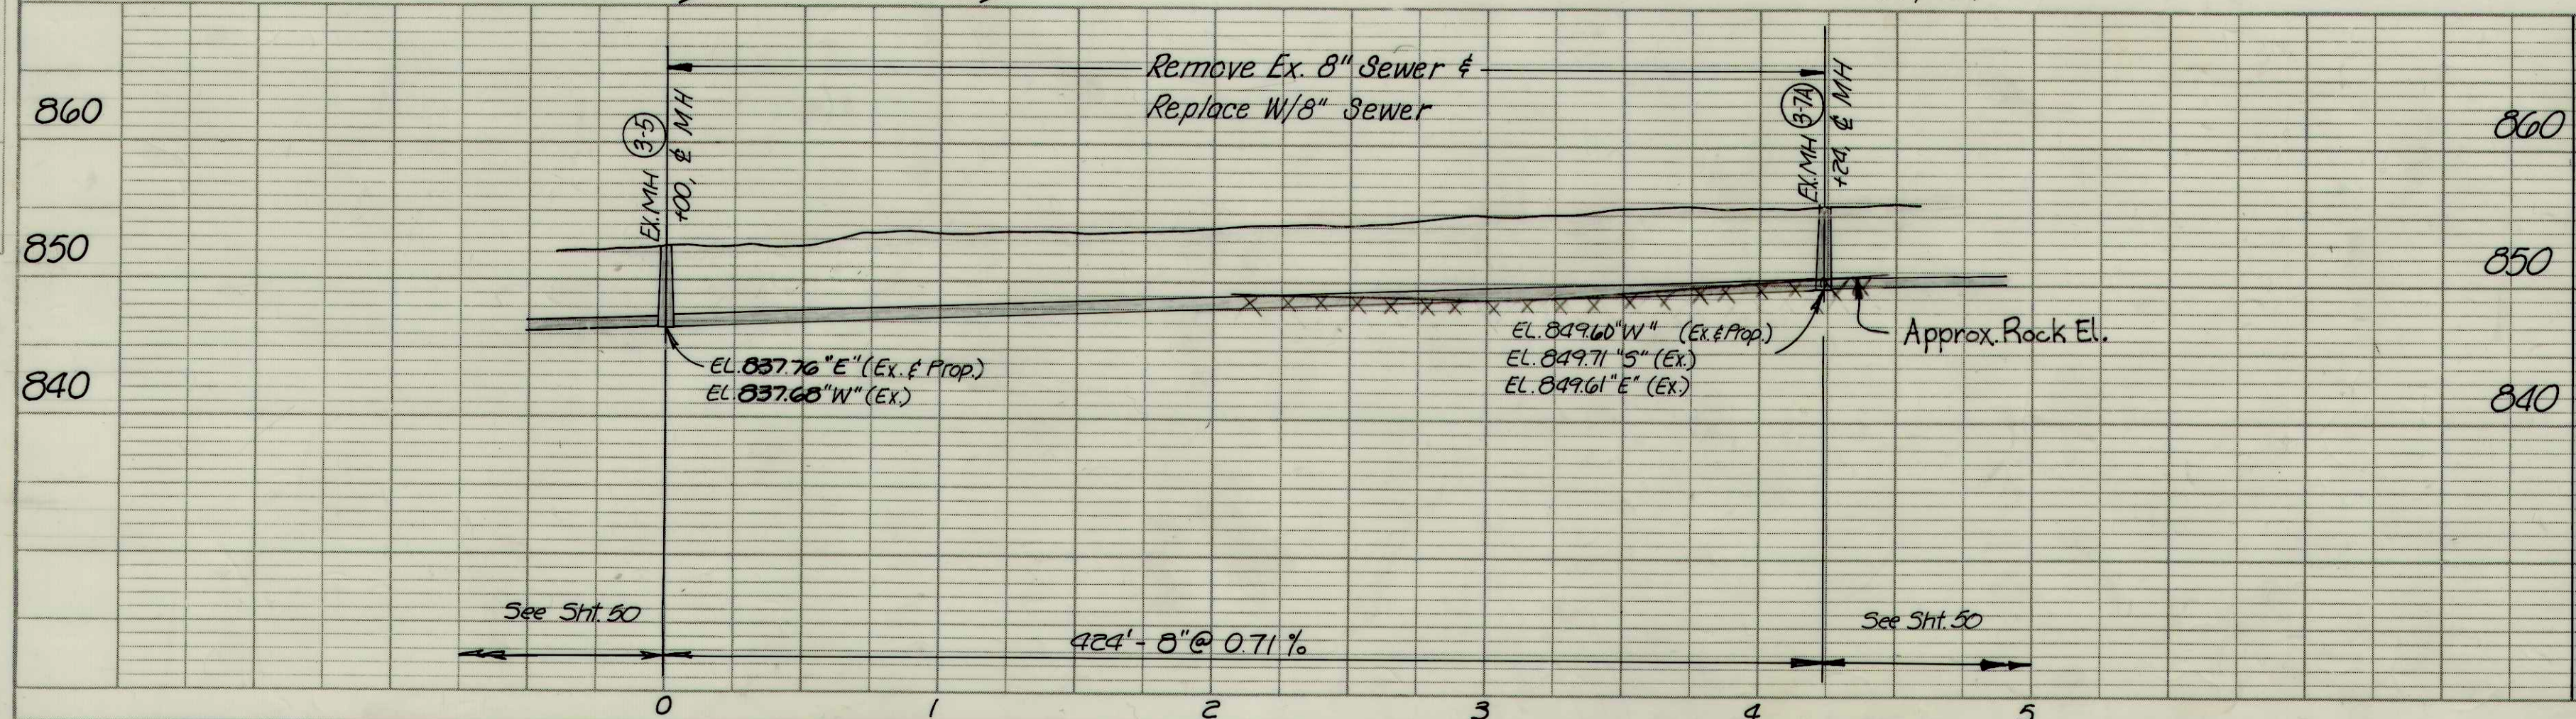

RECORD DRAWING



SEWER LINES "Q, P, Y"
 FALL CREEK R.W.D. PLAN & PROFILE SHEET
 HORIZ. 1"=50'
 VERT. 1"=10'
 BEAM, LONGEST & NEFF, INC.
 CONSULTING ENGINEERS
 INDIANAPOLIS, INDIANA
 53