



PLAN	SUPPLIED	DATE
	NOTED	BY
	NOTED	BY
	NOTED	BY

PROFILE	SUPPLIED	DATE
	NOTED	BY
	NOTED	BY
	NOTED	BY

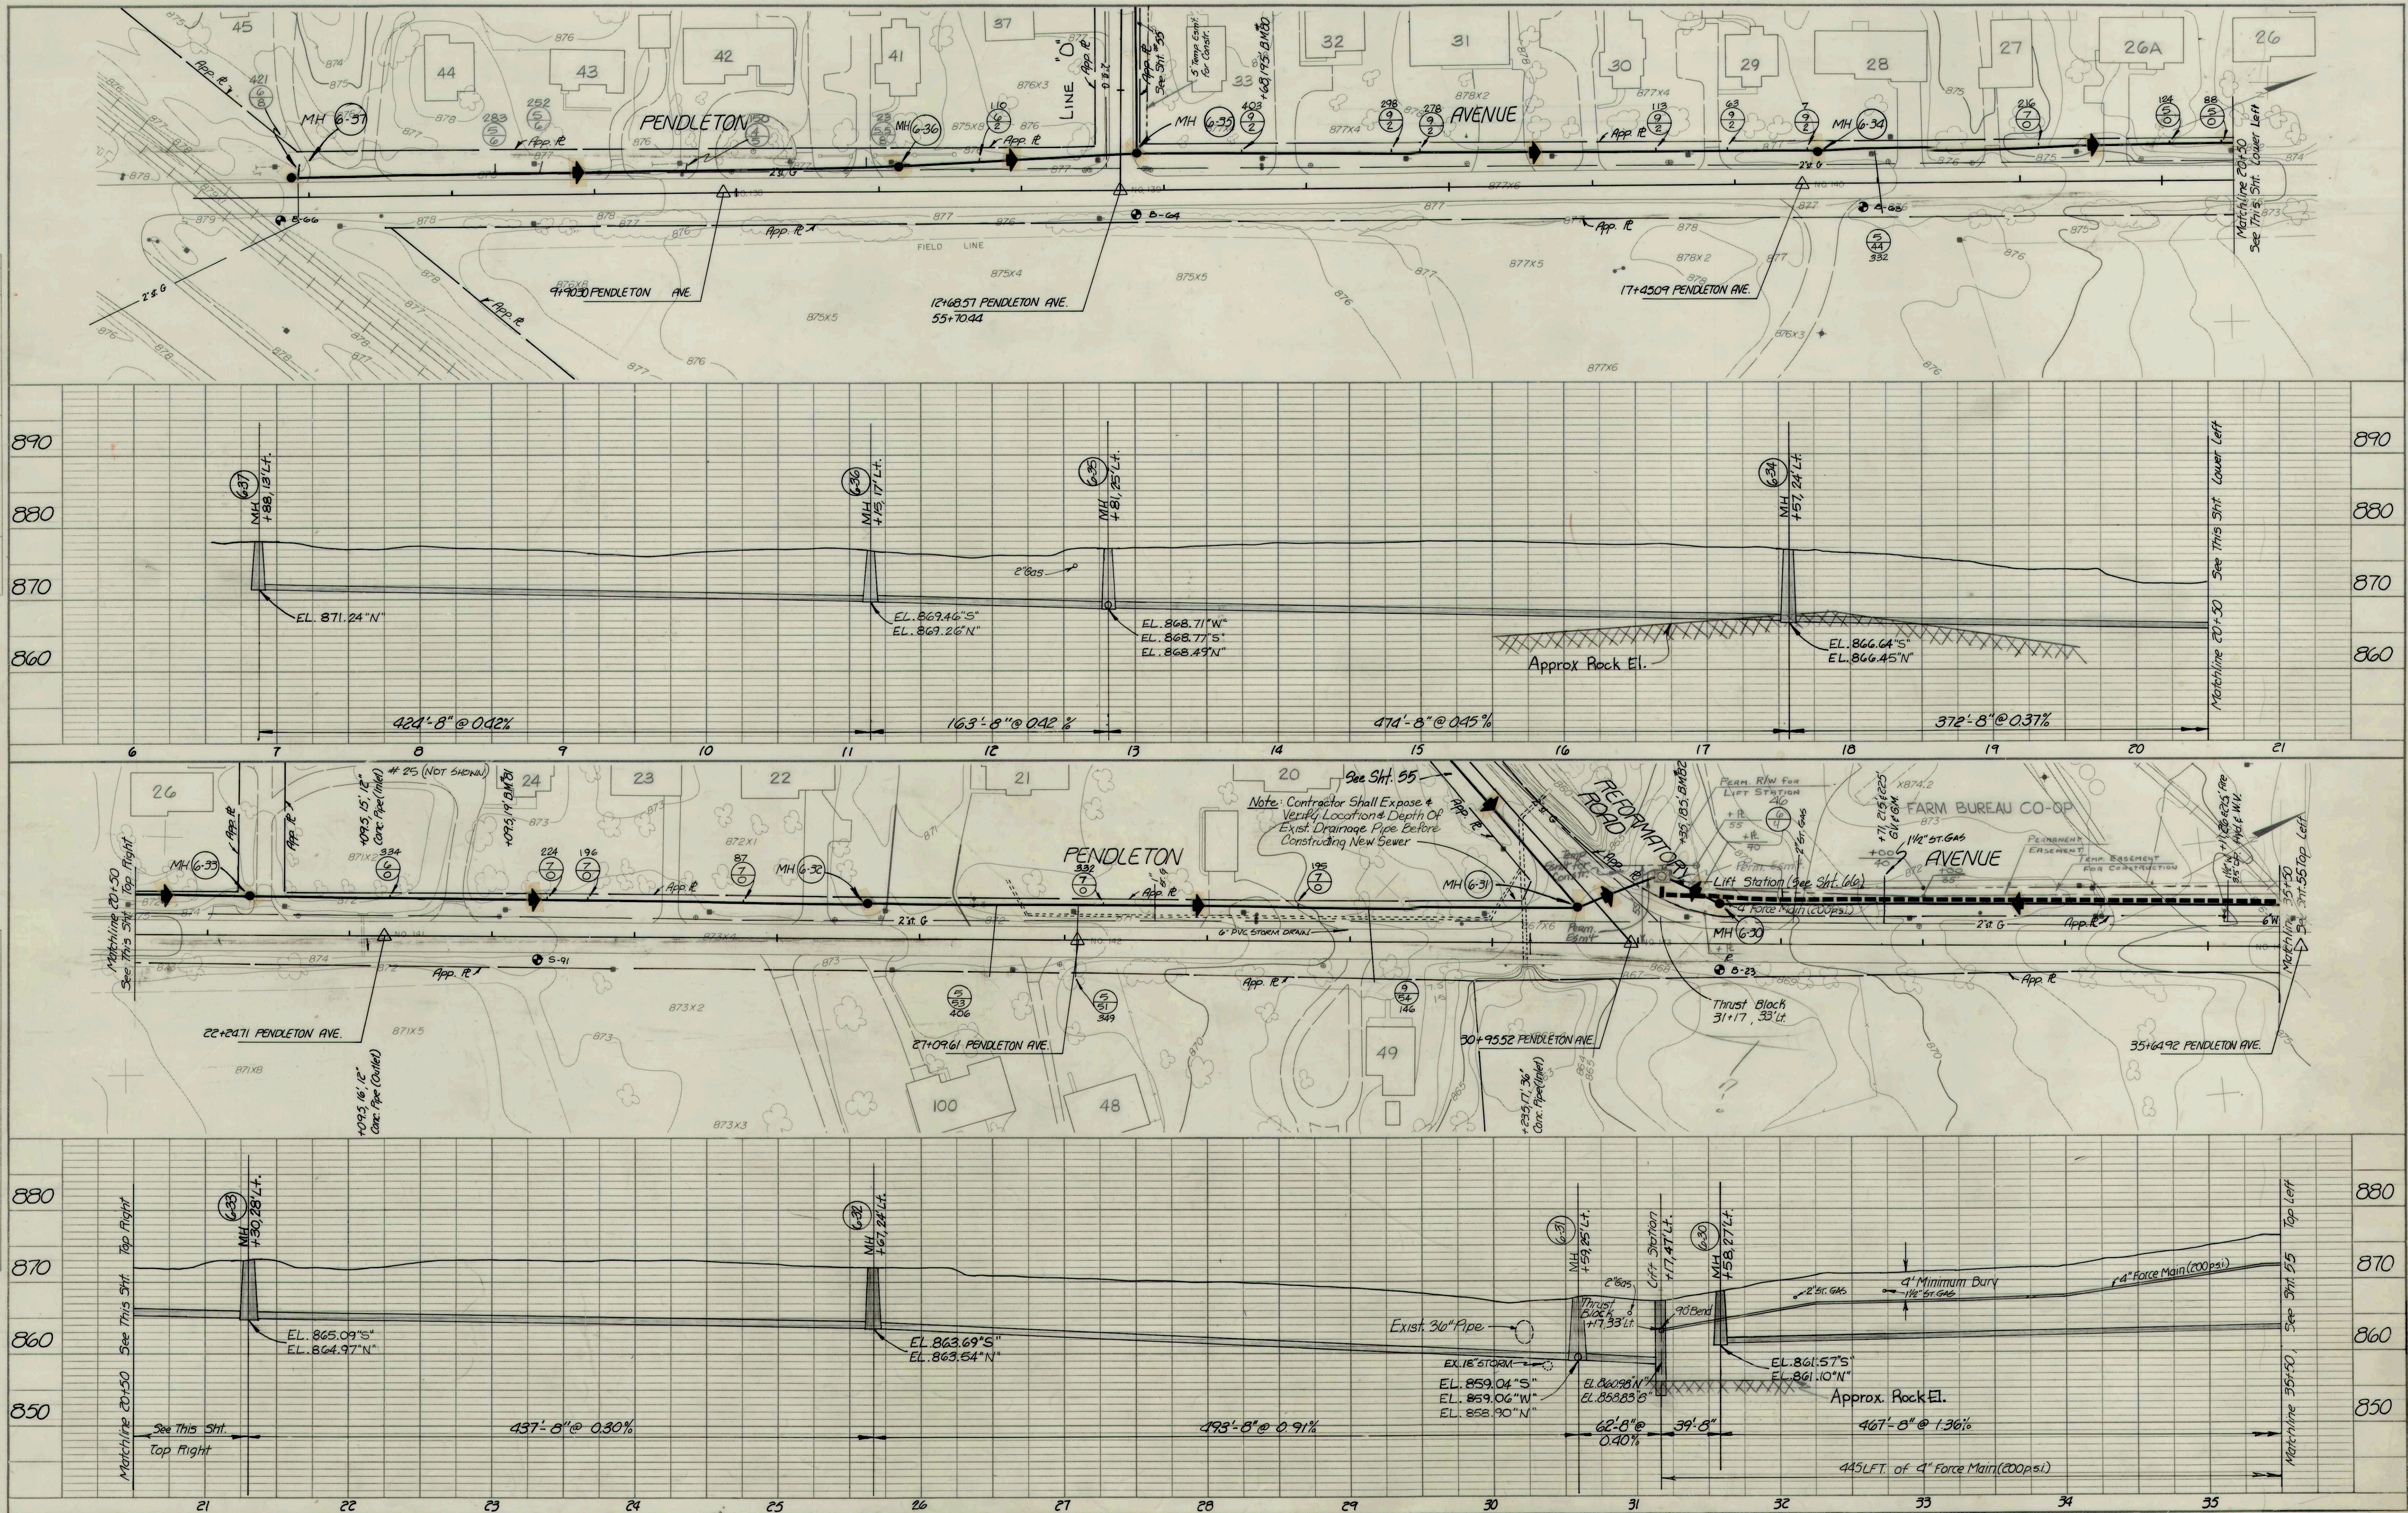

- ① NEED ELEVATIONS OF IN/OUT LINES @ LIFT STATION.
 - ② NEED LOCATION OF 4" PVC FM @ LIFT STATION.
 - ③ NEED LOCATION OF CATCH BASIN @ RAINBOWS.
 - ④ NEED ABOUT LENGTHS.
 - ⑤ NEED LOCATION OF TIGHT BENDS.
- BWC
3/14/85

REVISED 3-19-84
CHANGED R/W AROUND
RECORD DRAWING
Changed Grade From MH 6-30
To MH 6-28

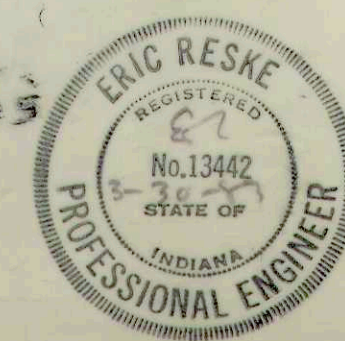

PENDLETON AVENUE
FALL CREEK R.W.D. PLAN & PROFILE SHEET
HORIZ. 1"=50'
VERT. 1"=10'
BEAM, LONGEST & NEFF, INC.
CONSULTING ENGINEERS
INDIANAPOLIS, INDIANA