


PLAN	SURVEYED	DATE
NO.	BY	
NOTE: BOOK NO. 13442		

PROFILE	SURVEYED	DATE
NO.	BY	
NOTE: BOOK NO. 13442		

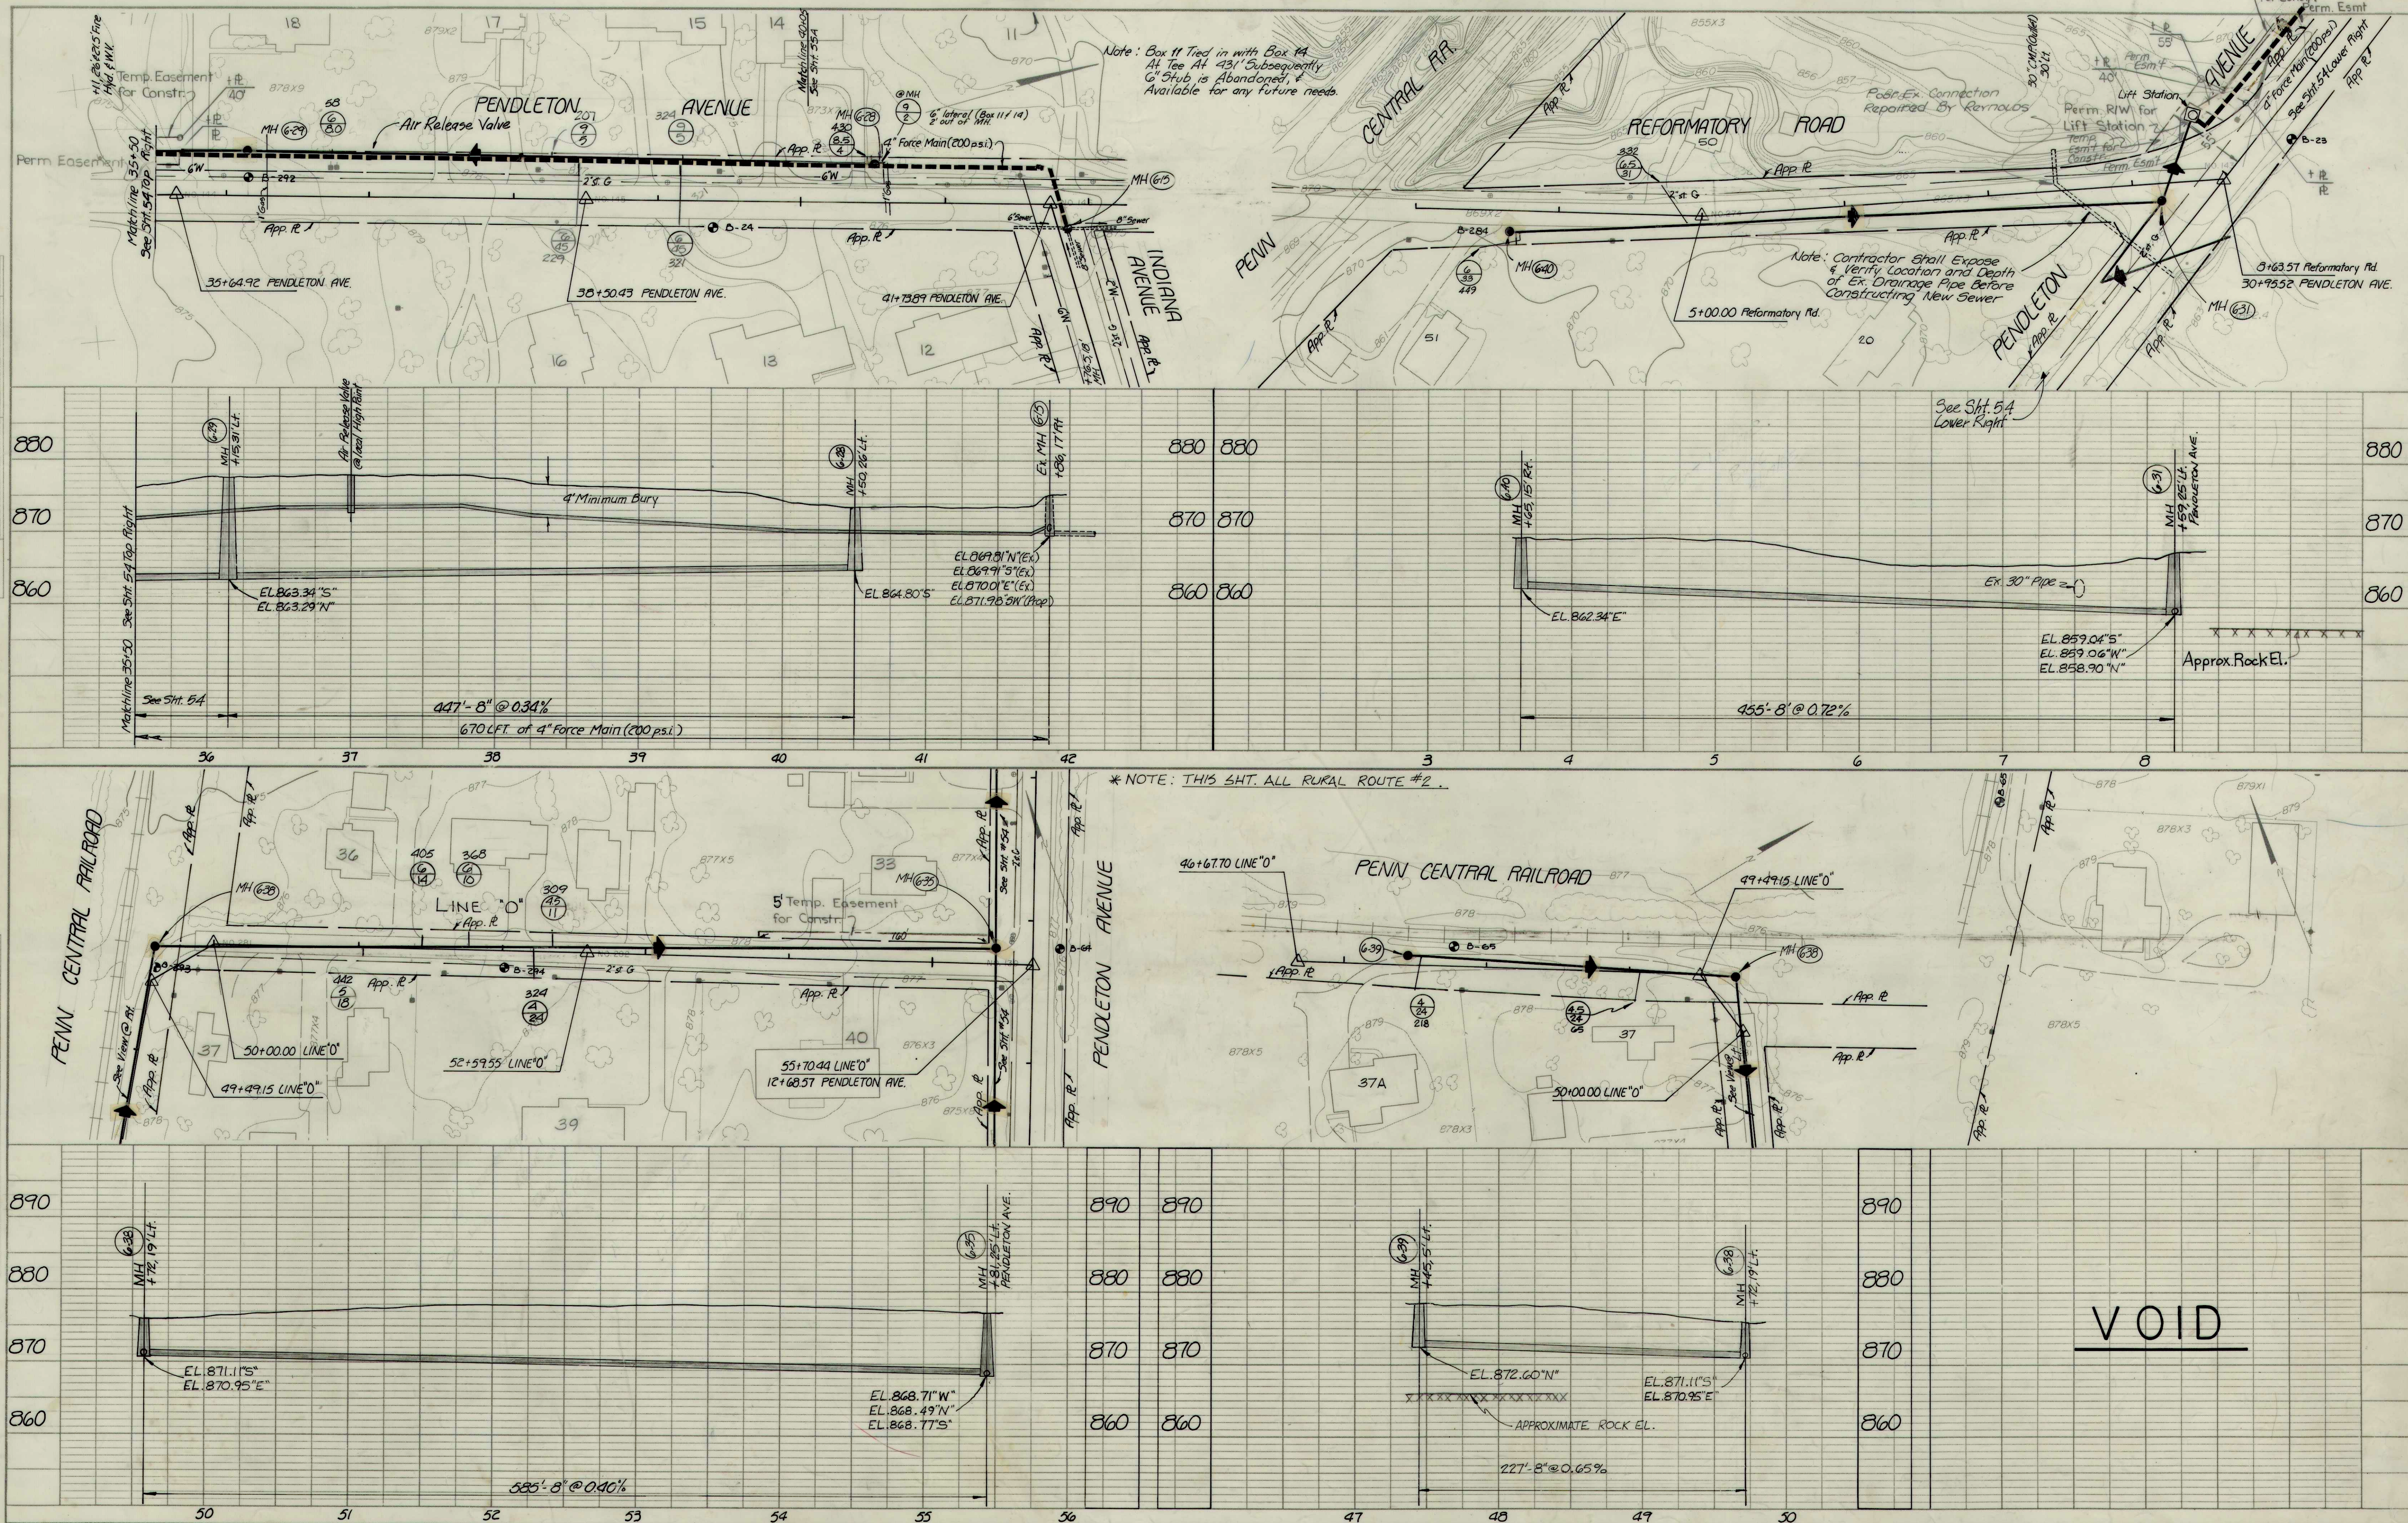

REVISED 3-19-84
CHANGED R/W AROUND
LIFT STATION
REVISED 8-1-84
CHANGED GRADE FROM MH 6-23
TO MH 6-28

RECORD DRAWING

ERIC RESKE
REGISTERED
No. 13442
STATE OF
INDIANA
CONSULTING ENGINEERS

PENDLETON AVE./REFORMATORY RD. & LINE "O"

FALL CREEK R.W.D. PLAN & PROFILE SHEET

HORIZ. 1"=50'
VERT. 1"=10'

BEAM, LONGEST & NEFF, INC.
CONSULTING ENGINEERS
INDIANAPOLIS, INDIANA

55