


PLAN	DATE	
	BY	
	SURVEYED	
	NOTED	
NOTE: BOOK NO. OF MAP SHEETS		

PROFILE	DATE	
	BY	
	SURVEYED	
	NOTED	
NOTE: BOOK NO. OF MAP SHEETS		



RECORD DRAWING

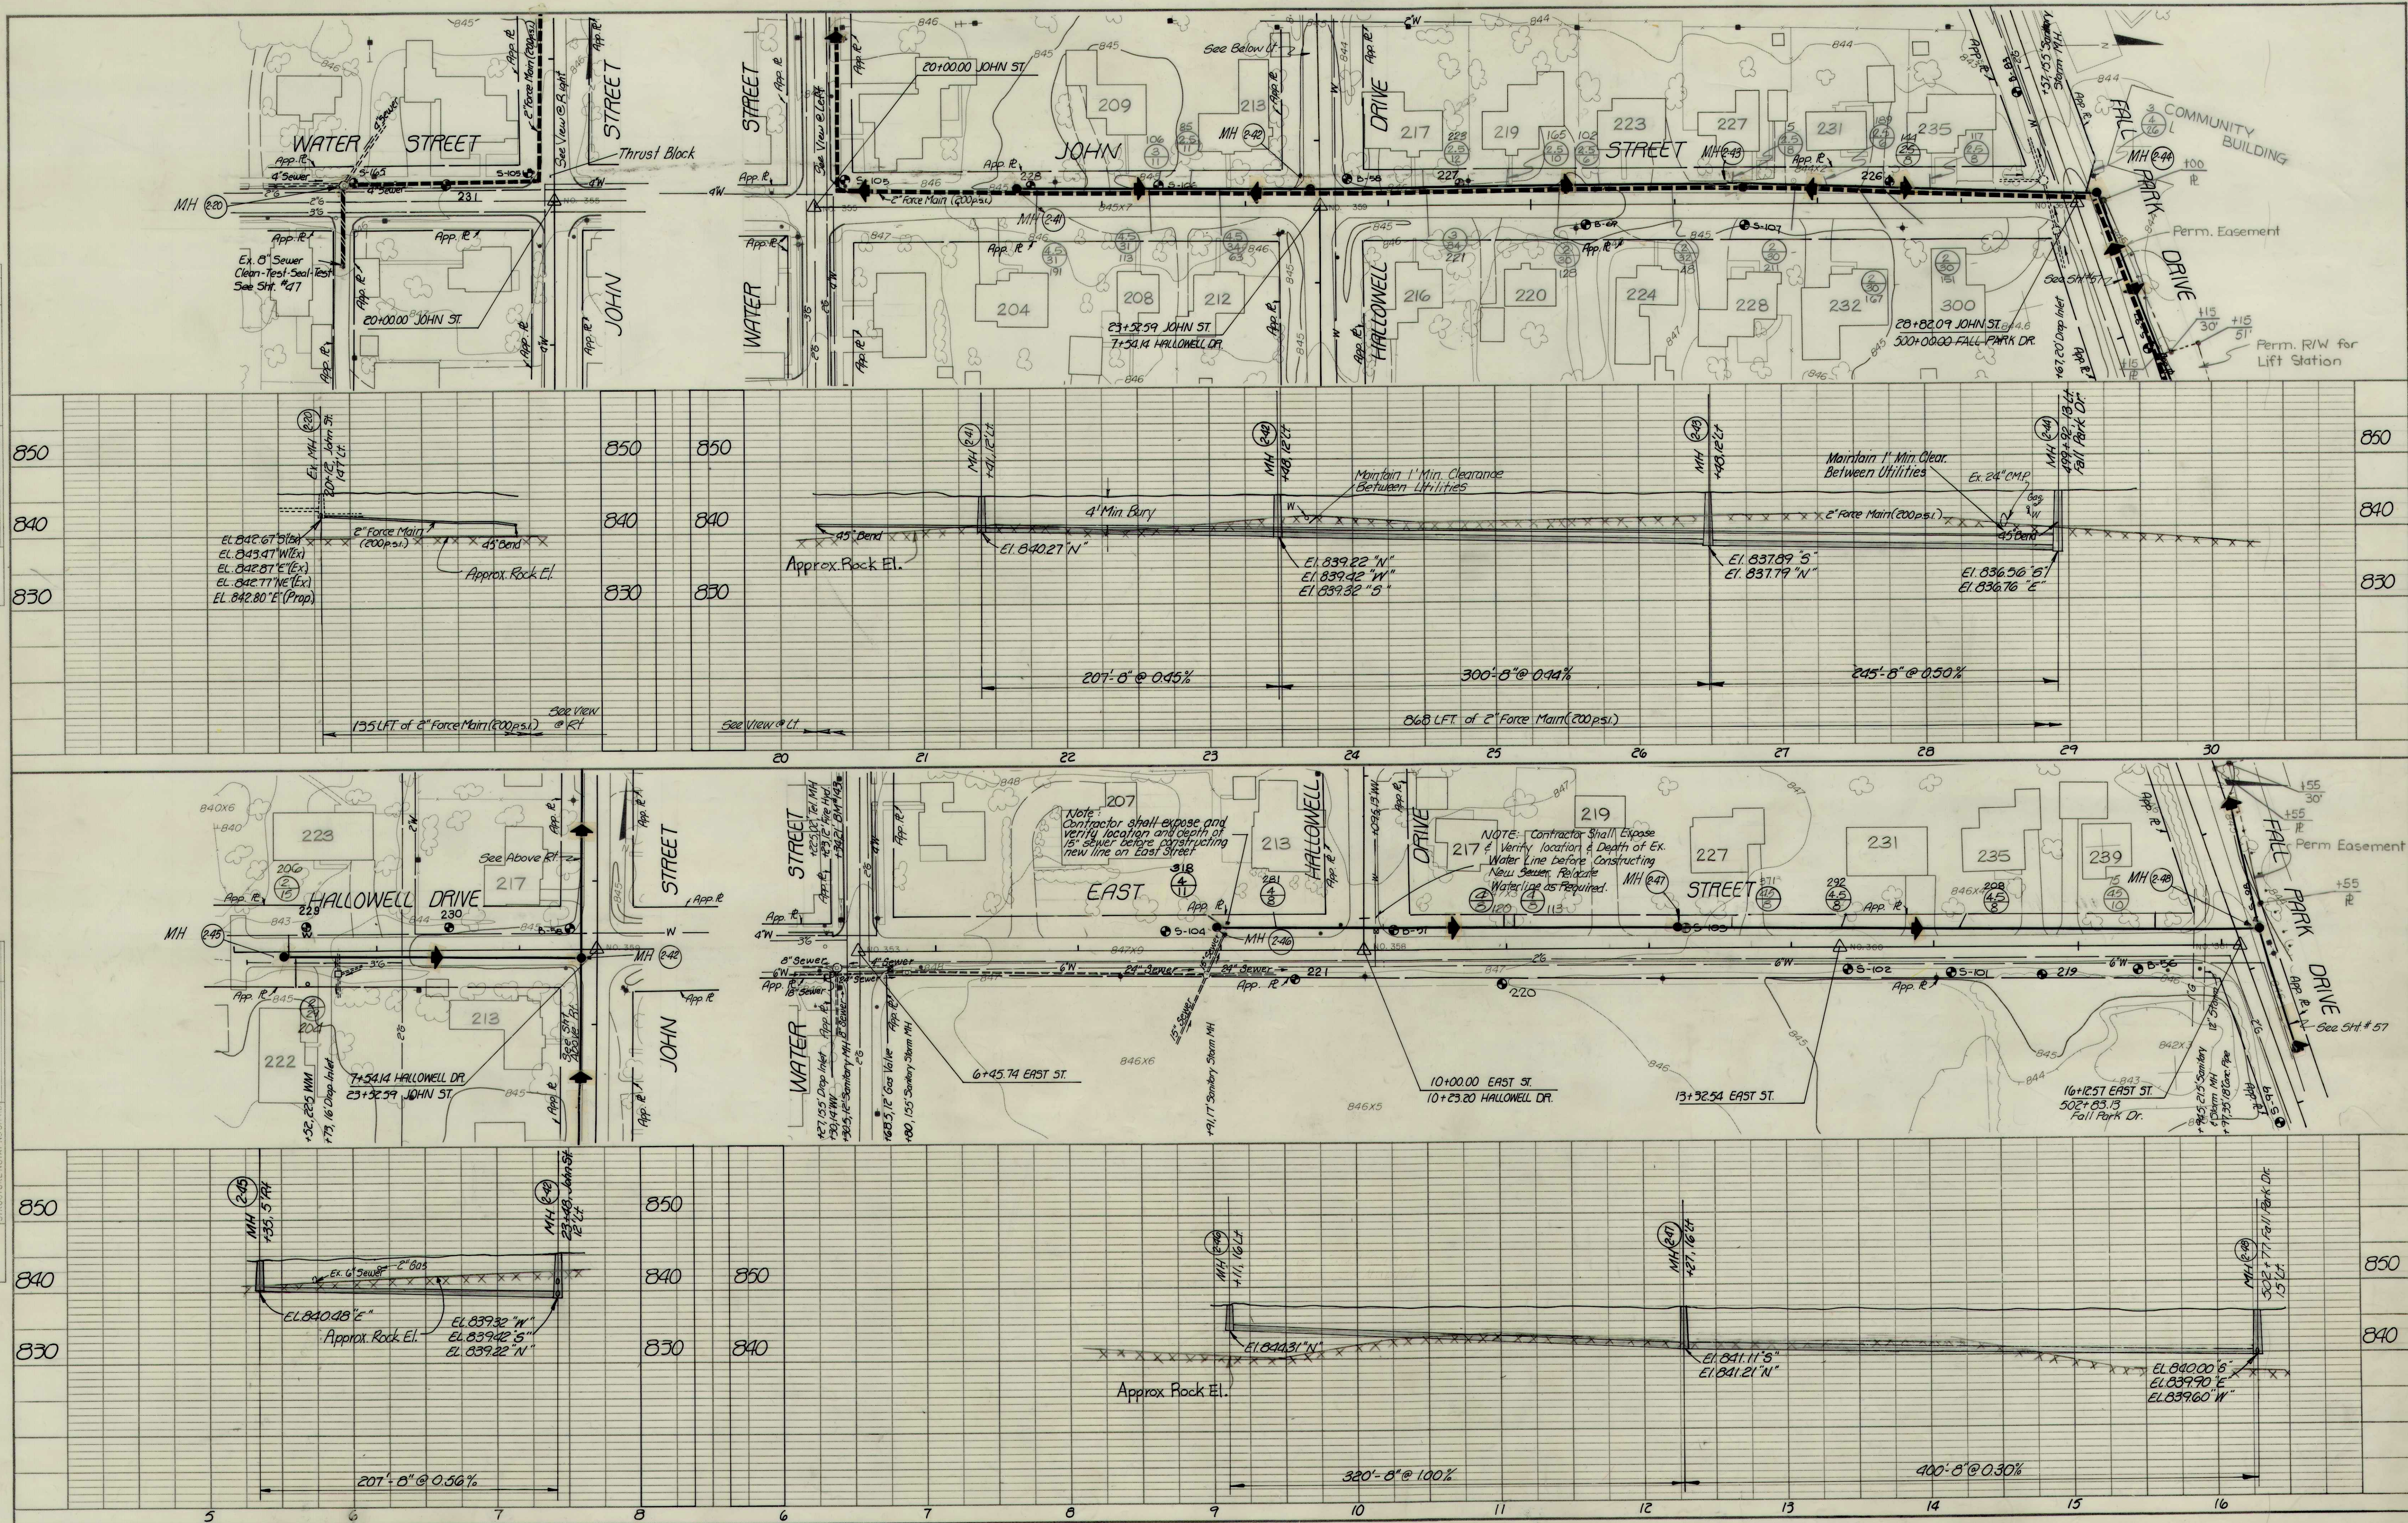

**WATER STREET / JOHN STREET
HALLOWELL DRIVE / EAST STREET**
FALL CREEK R.W.D. PLAN & PROFILE SHEET
HORIZ. 1"=50'
VERT. 1"=10'
BEAM, LONGEST & NEFF, INC.
CONSULTING ENGINEERS
INDIANAPOLIS, INDIANA