


PLAN	SURVEYED	DATE
	NOTED	BY
NO.	NO.	NO.
	NO.	NO.

PROFILE	SURVEYED	DATE
	NOTED	BY
NO.	NO.	NO.
	NO.	NO.



RECORD DRAWING

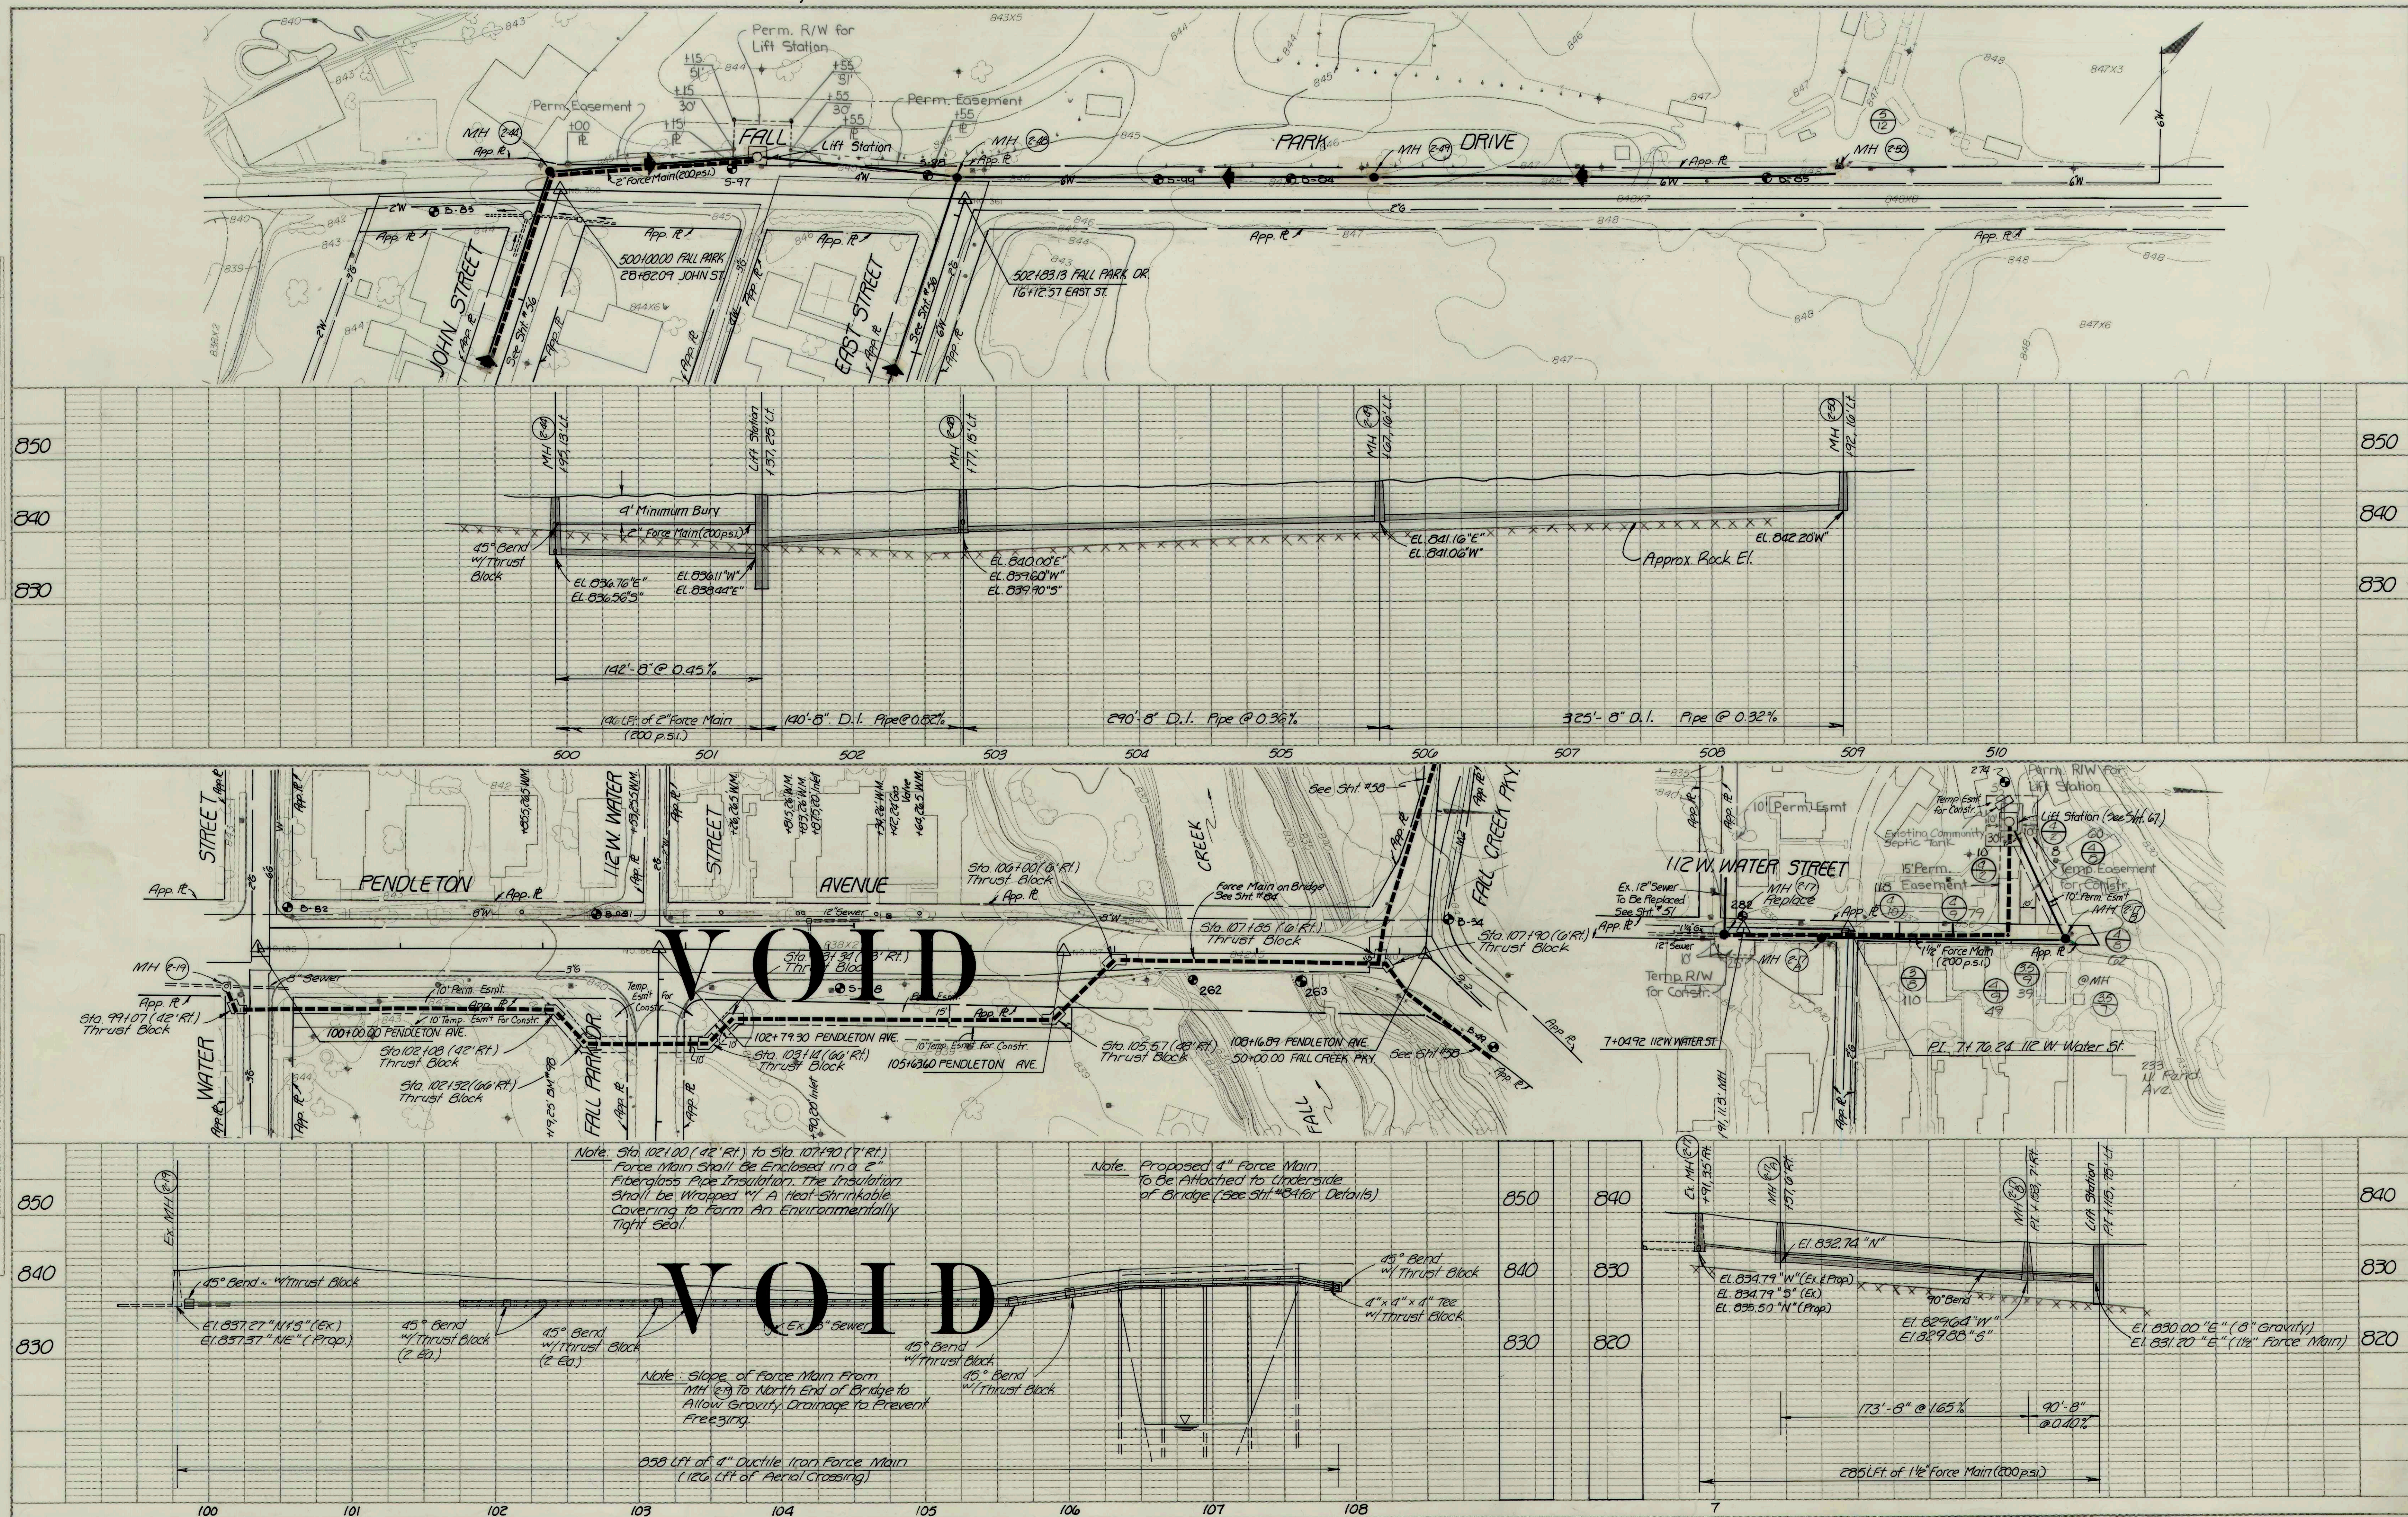

**FALL PARK DRIVE/PENDLETON AVENUE
112 W. WATER STREET**
FALL CREEK R.W.D. PLAN & PROFILE SHEET
HORIZ. 1"=50'
VERT. 1"=10'
BEAM, LONGEST & NEFF, INC.
CONSULTING ENGINEERS
INDIANAPOLIS, INDIANA
57