

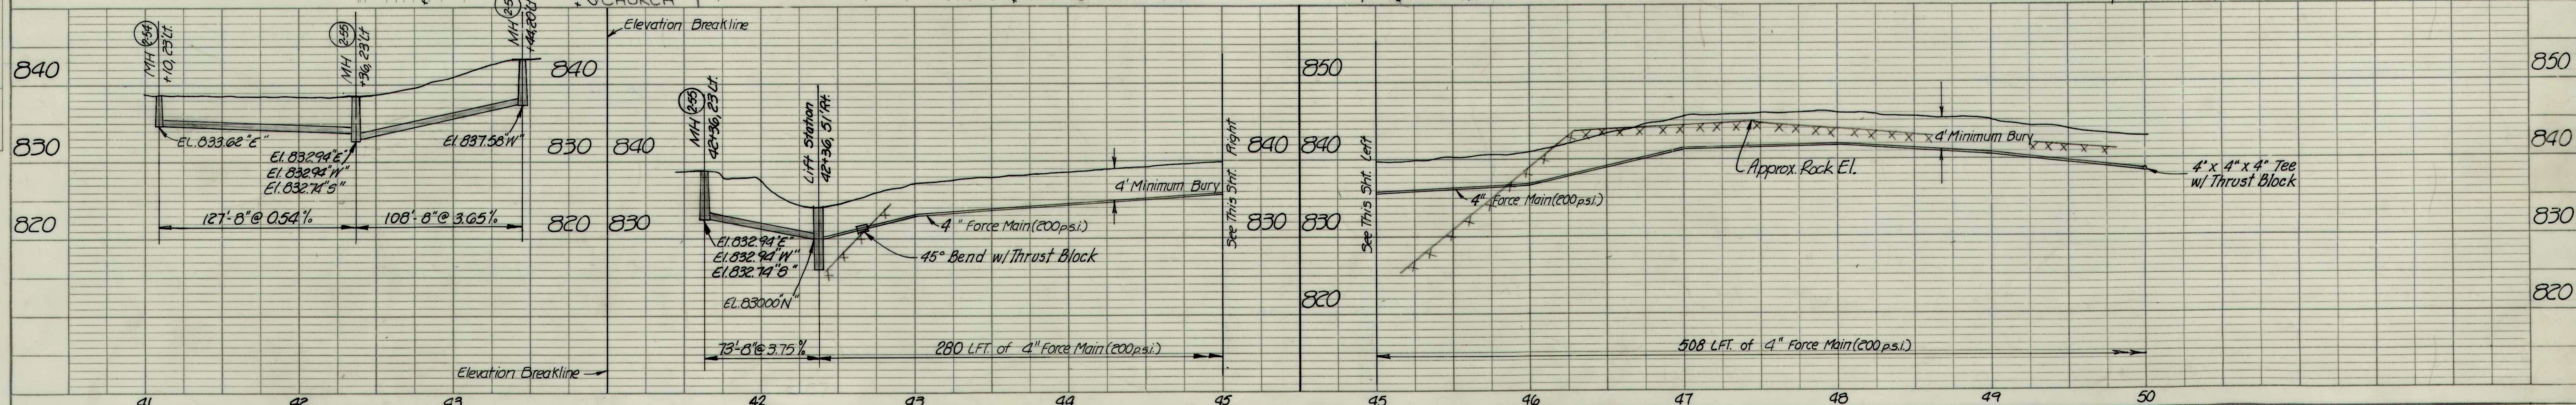
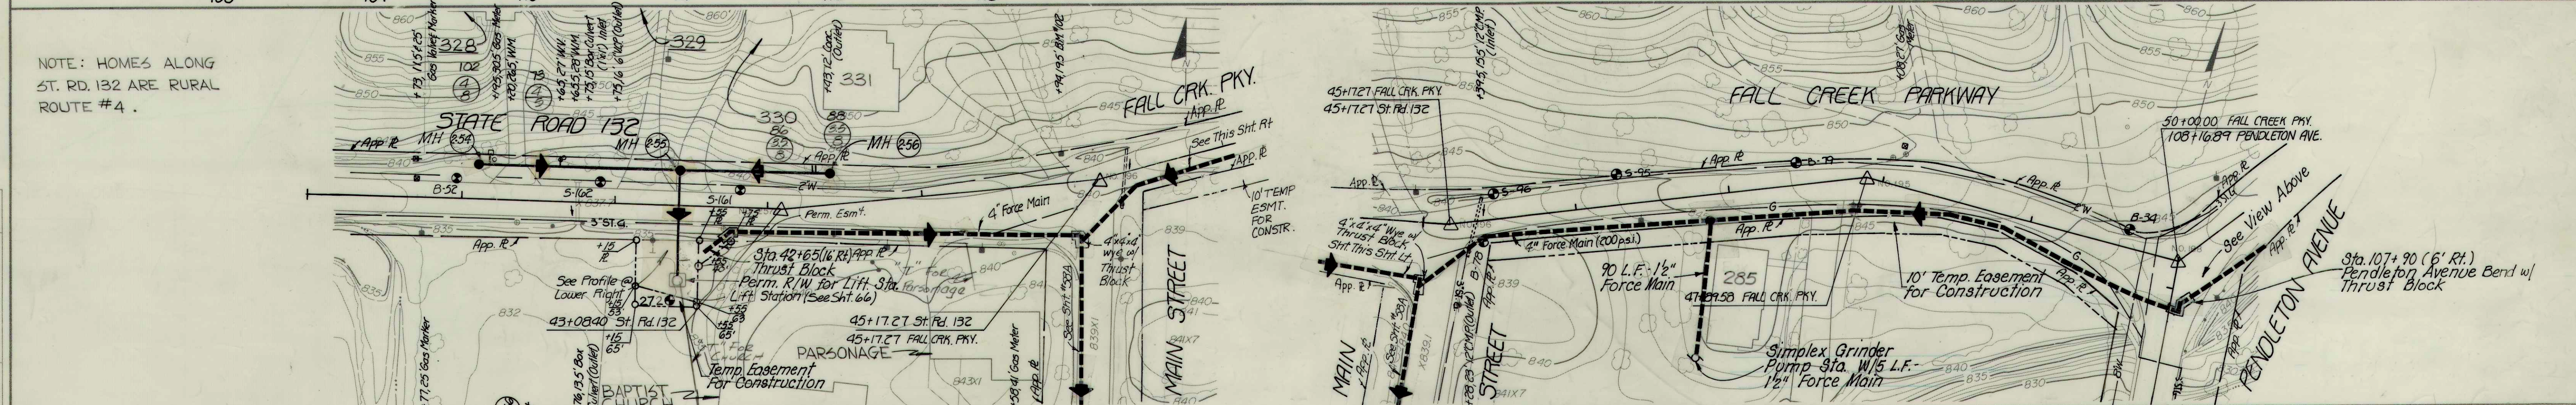


PLAN
SURVEYED
PLOTTED
CHECKED
BY
DATE

PROFILE
SURVEYED
PLOTTED
CHECKED
BY
DATE

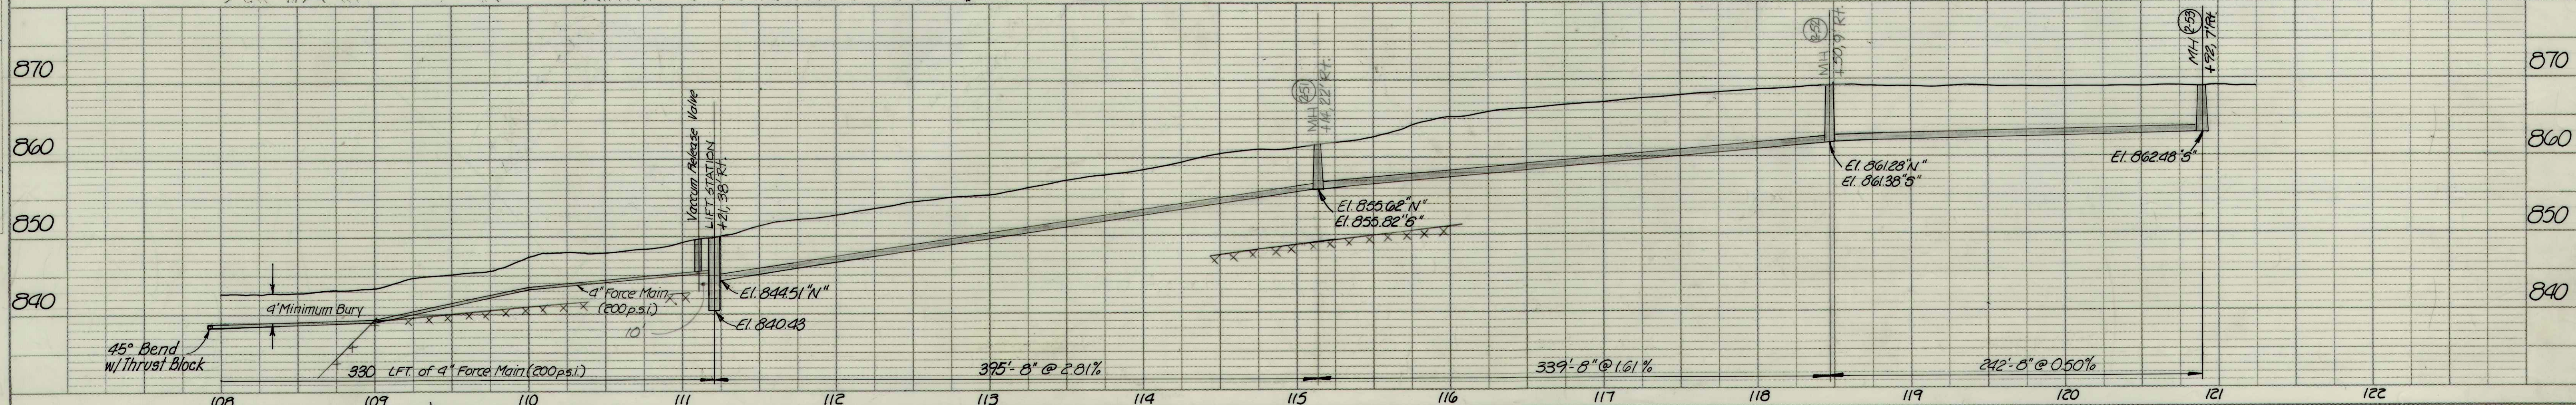

RECORD DRAWING

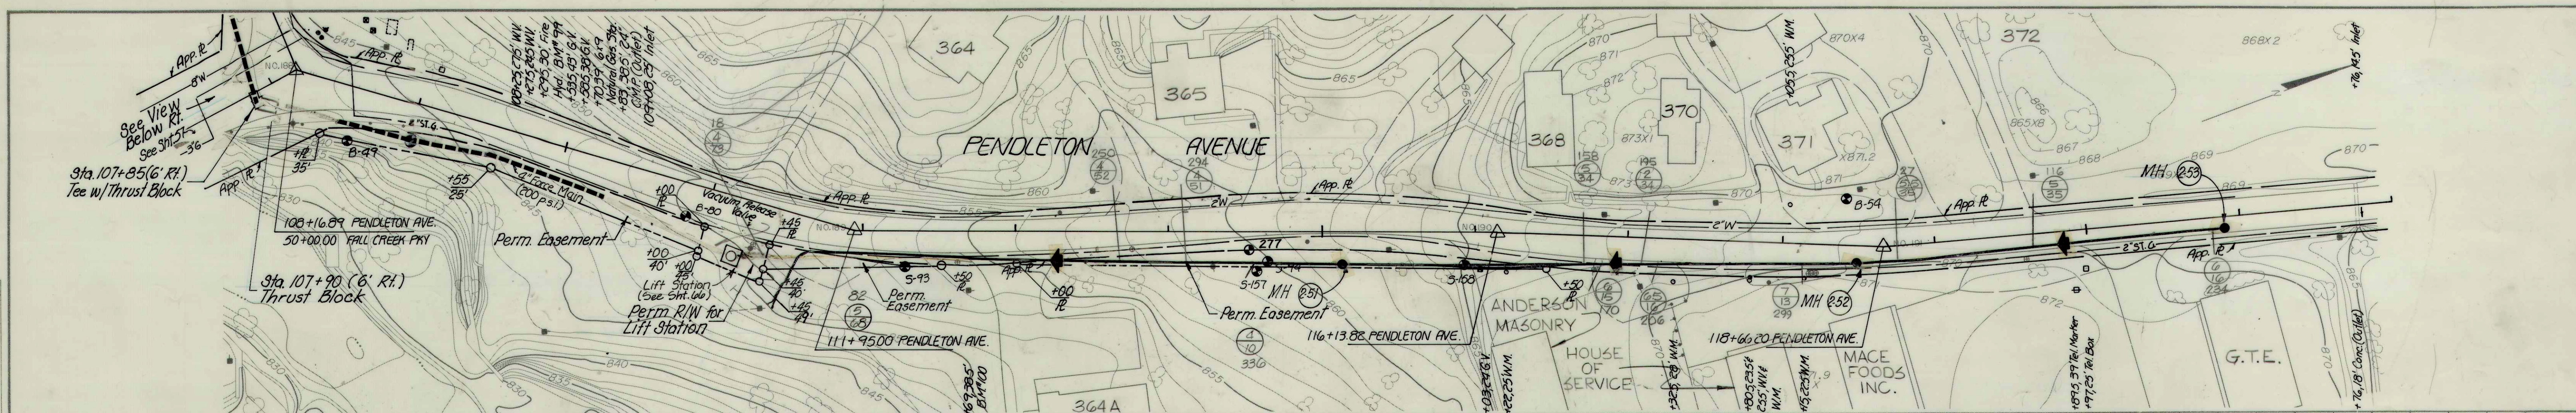

PENDLETON AVENUE
STATE ROAD 132 / FALL CREEK PKY.
FALL CREEK R.W.D. PLAN & PROFILE SHEET
HORIZ. 1"=50'
VERT. 1"=10'
BEAM, LONGEST & NEFF, INC.
CONSULTING ENGINEERS
INDIANAPOLIS, INDIANA