



PLAN	SURVEYED	DATE
	PLOTTED	BY
	NOTE BOOK	NO.
	RT. OF WAY CHECKED	

PROFILE	SURVEYED	DATE
	PLOTTED	BY
	NOTE BOOK	NO.
	STRUCTURE NOTATION CHECKED	

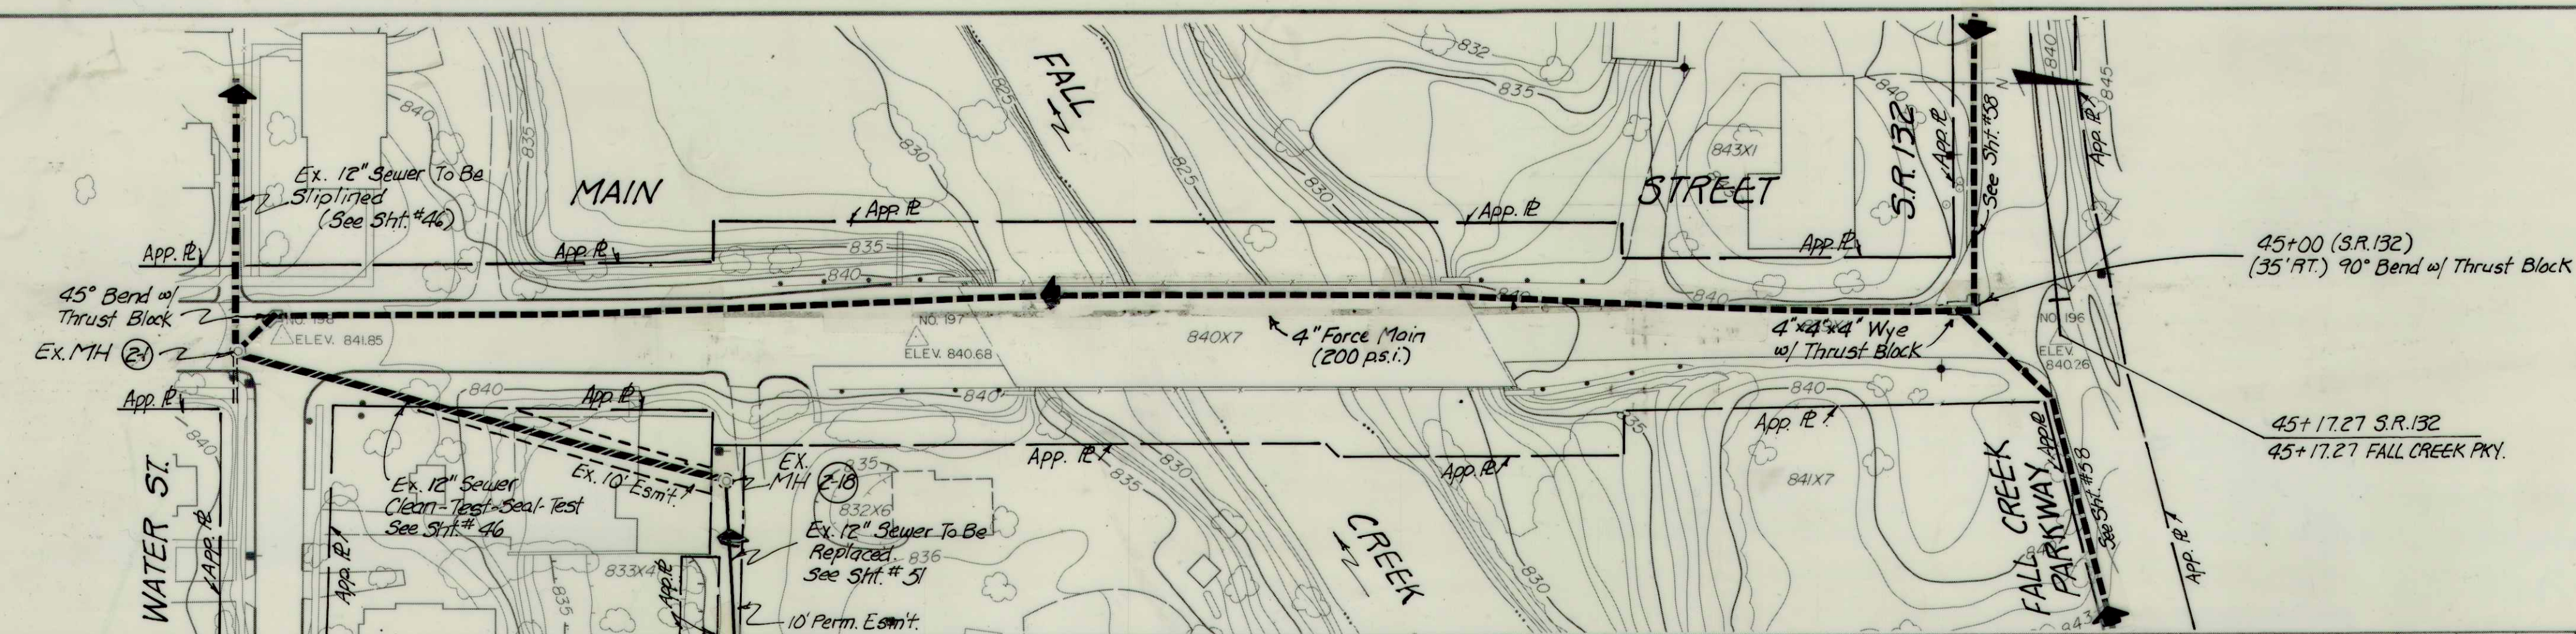

NOTE: 1. Proposed Force Main To Be Attached To Underside of Bridge (See Sht. #4 for Details)
 2. Approx. 250' of Pipe Shall be Enclosed in a 2" Fiberglass Pipe Insulation. The Insulation Shall be Wrapped w/ Heat Shrinkable Covering to Form an Environmentally Tight Seal.

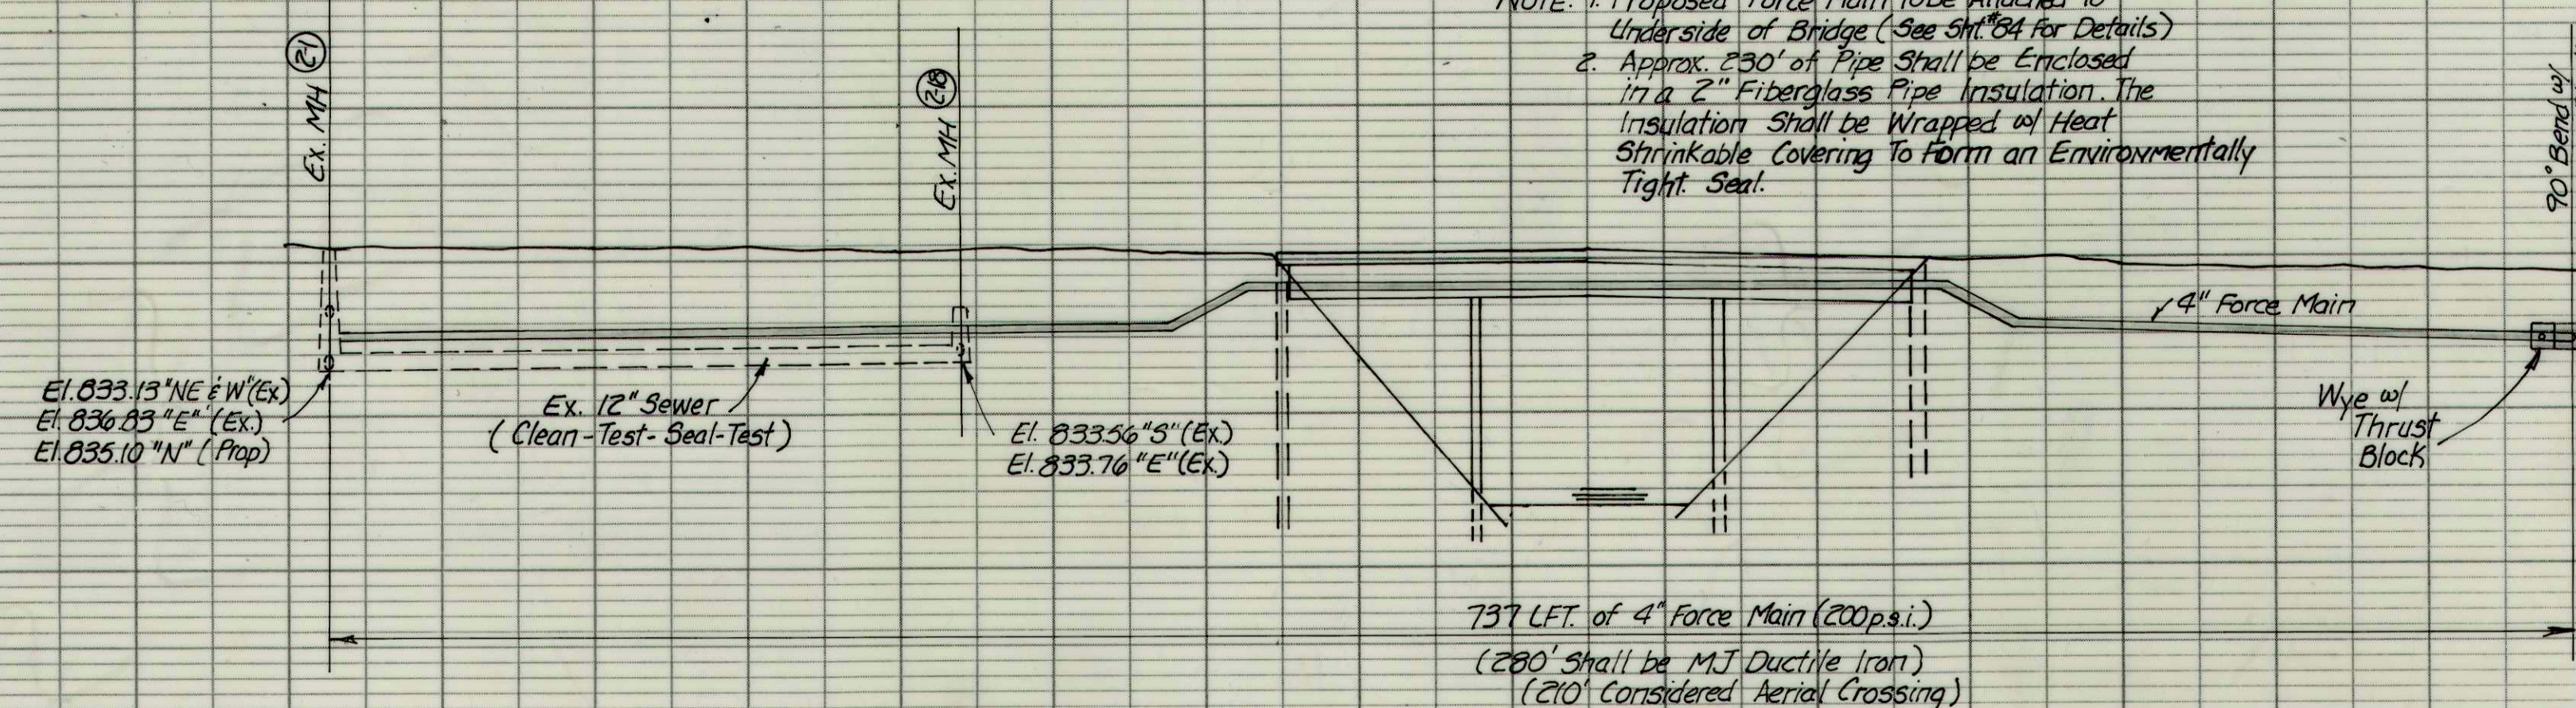

RECORD DRAWING



MAIN STREET	
FALL CREEK R.W.D. PLAN & PROFILE	SHEET
HORIZ. 1"=50'	BEAM, LONGEST & NEFF, INC.
VERT. 1"=10'	CONSULTING ENGINEERS
	INDIANAPOLIS, INDIANA

58A