

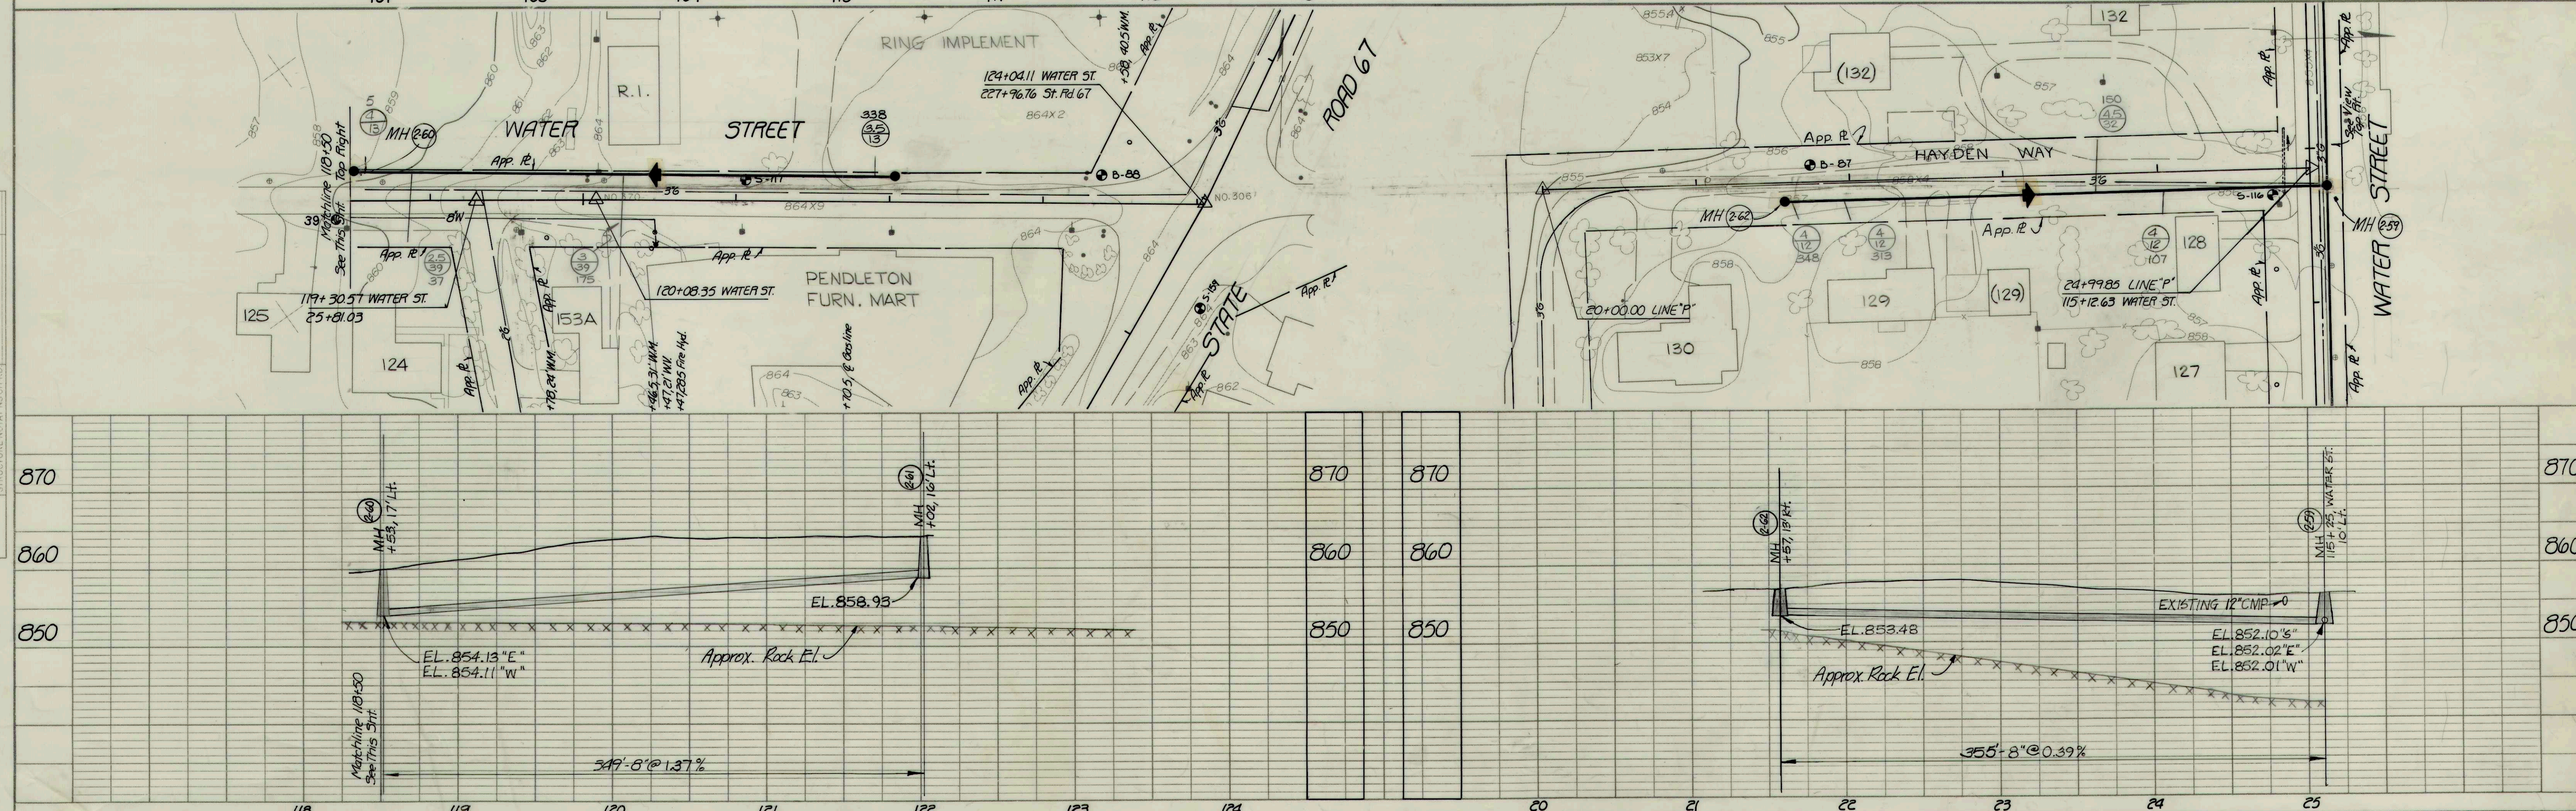


PLAN	SURVEYED	DATE
NO.	BY	
	NOTED	
	CHECKED	
	RT. OF WAY CHECKED	

PROFILE	SURVEYED	DATE
NO.	BY	
	NOTED	
	CHECKED	
	STRUCTURE NOTATIONS CHYD	

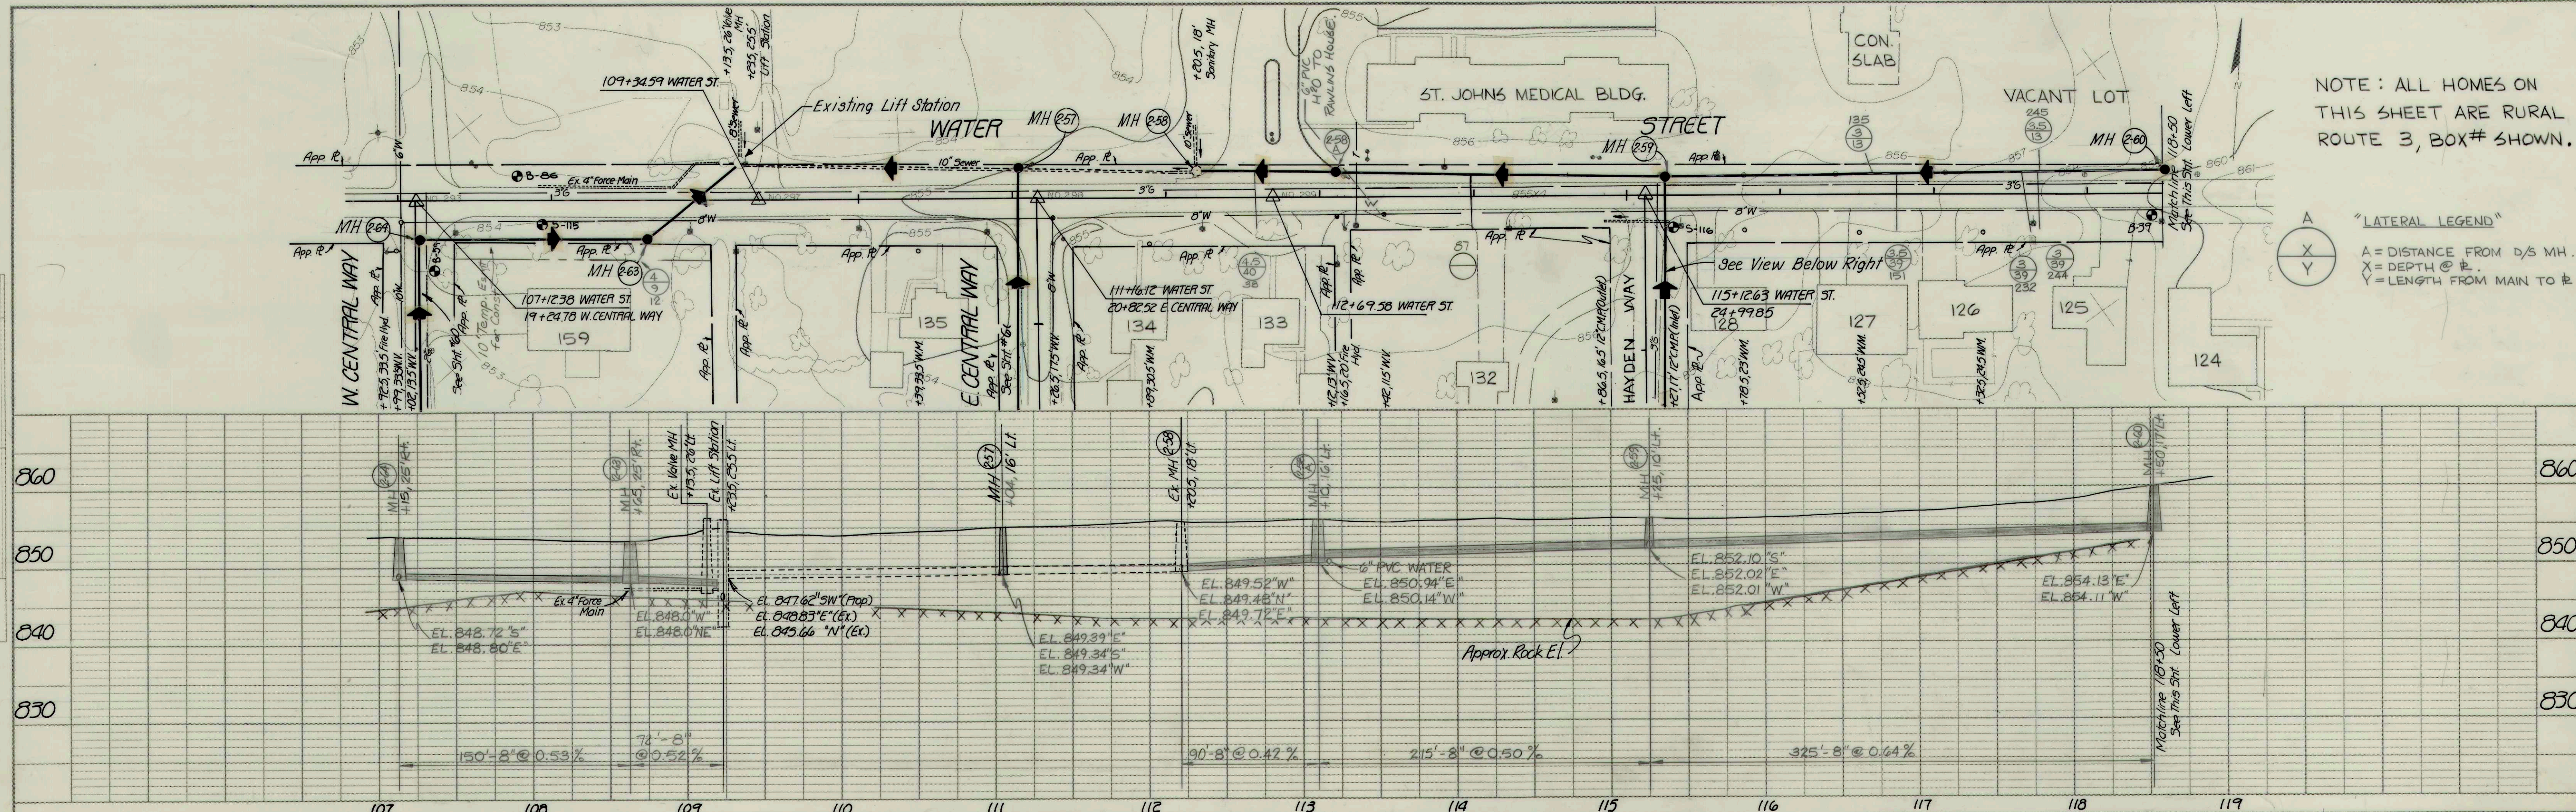

RECORD DRAWING

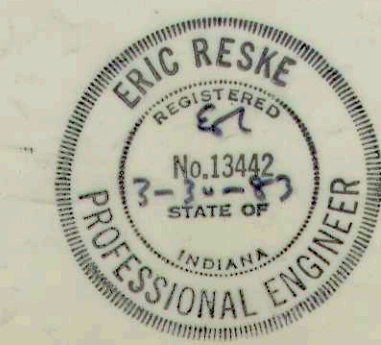

WATER STREET/ LINE "P"
 FALL CREEK R.W.D. PLAN & PROFILE SHEET
 HORIZ. 1"=50' BEAM, LONGEST & NEFF, INC.
 VERT. 1"=10' CONSULTING ENGINEERS
 INDIANAPOLIS, INDIANA
 "AS BUILT" 1/25/85 BWC
 59