
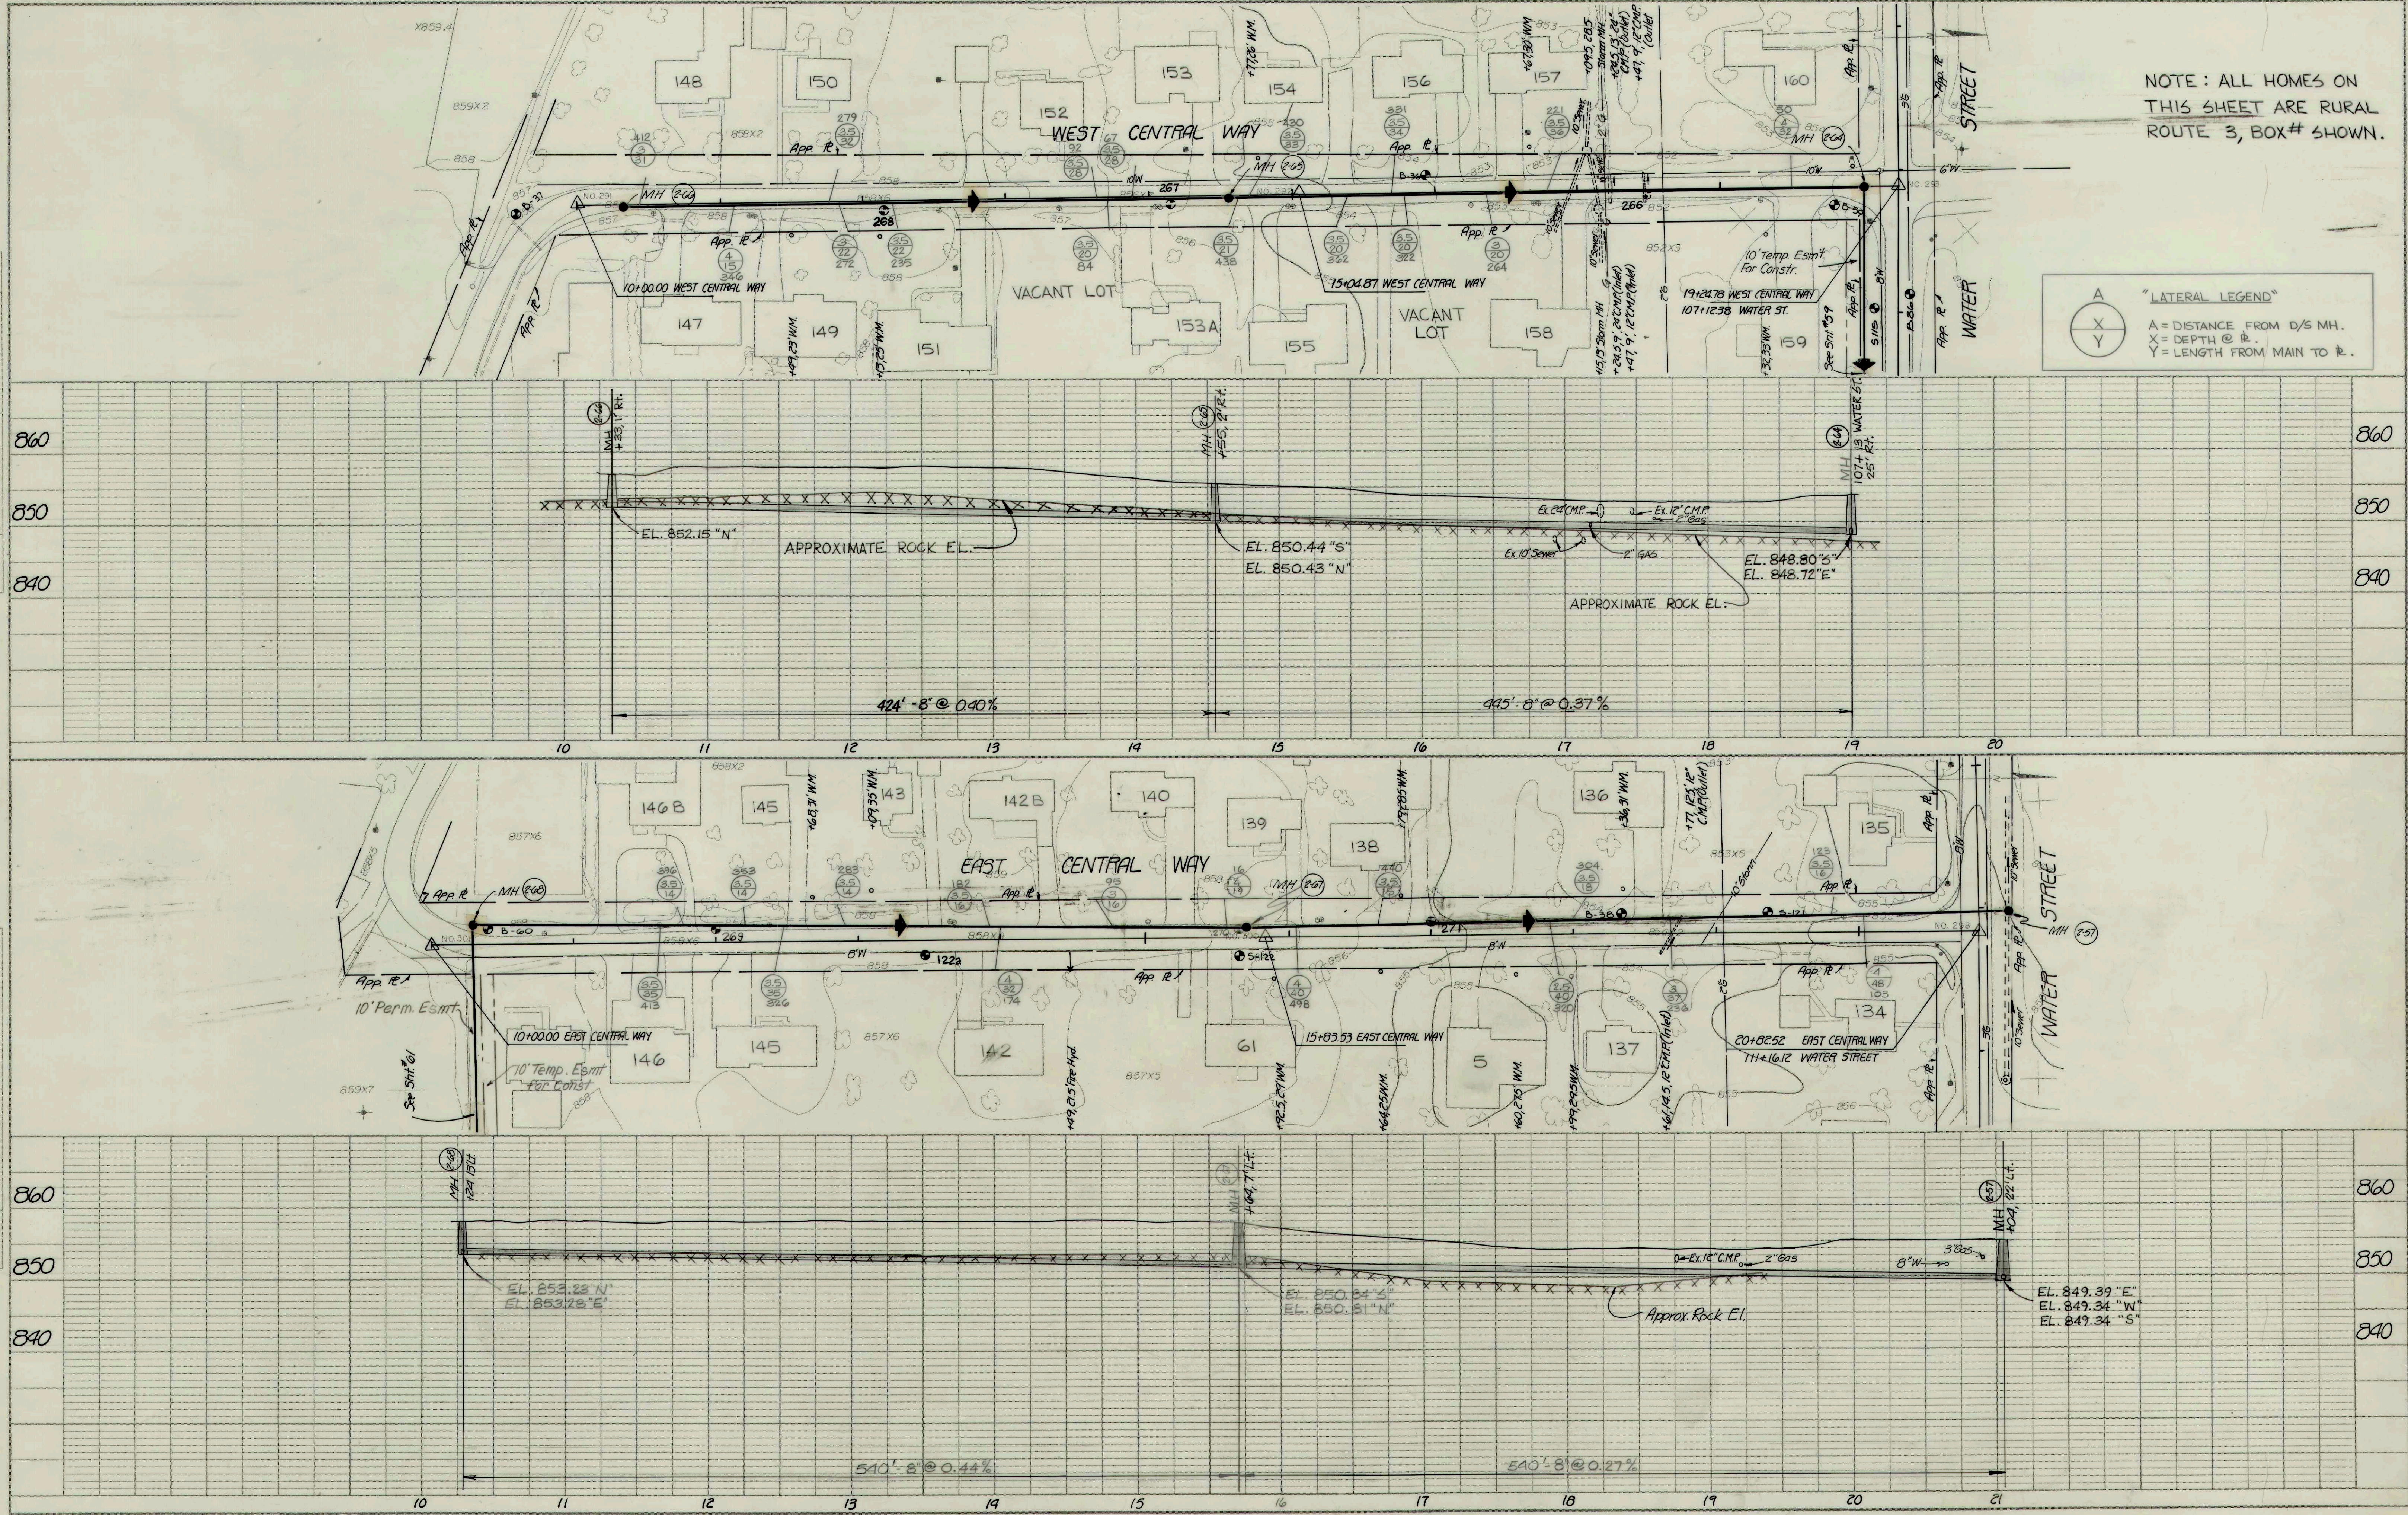


PLAN	DATE	
	BY	
	SURVEYED	
	NOTED	

PROFILE	DATE	
	BY	
	SURVEYED	
	NOTED	

NOTE: ALL HOMES ON THIS SHEET ARE RURAL ROUTE 3, BOX # SHOWN.

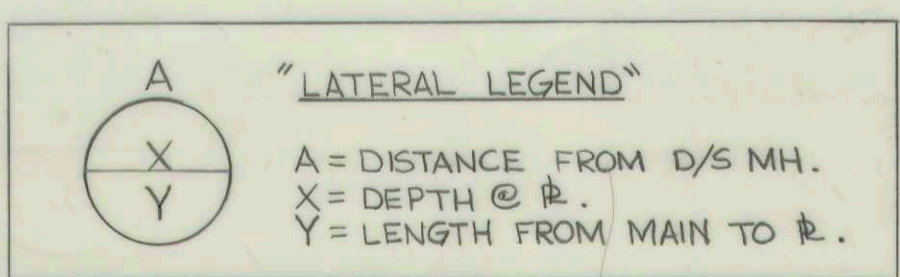

RECORD DRAWING



WEST & EAST CENTRAL WAY	
FALL CREEK R.W.D. PLAN & PROFILE SHEET	
HORIZ. 1"=50'	BEAM, LONGEST & NEFF, INC.
VERT. 1"=10'	CONSULTING ENGINEERS
	INDIANAPOLIS, INDIANA
"ASBUILT" 1/23/85 BWC	60