
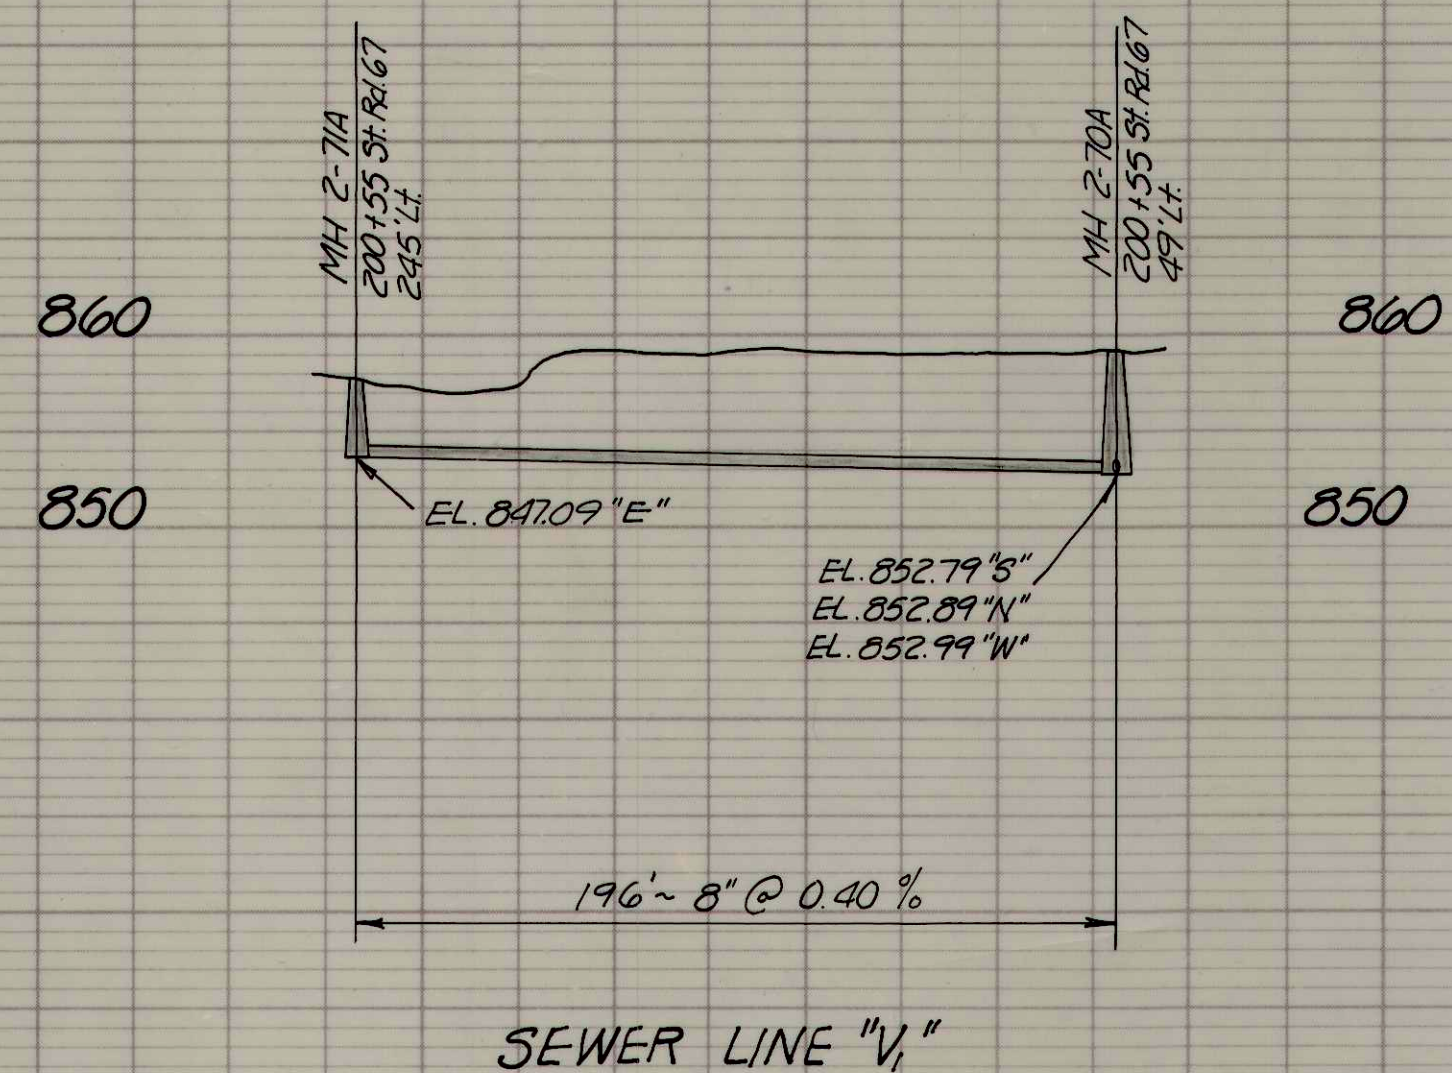


PLAN	SURVEYED	DATE
	NOTED	BY
	NOTE BOOK	ALIGNED CHECKED
	No.	BY

PROFILE	SURVEYED	DATE
	NOTED	BY
	NOTE BOOK	GRADES CHECKED
	No.	STRUCTURE NOTATIONS CHECKED

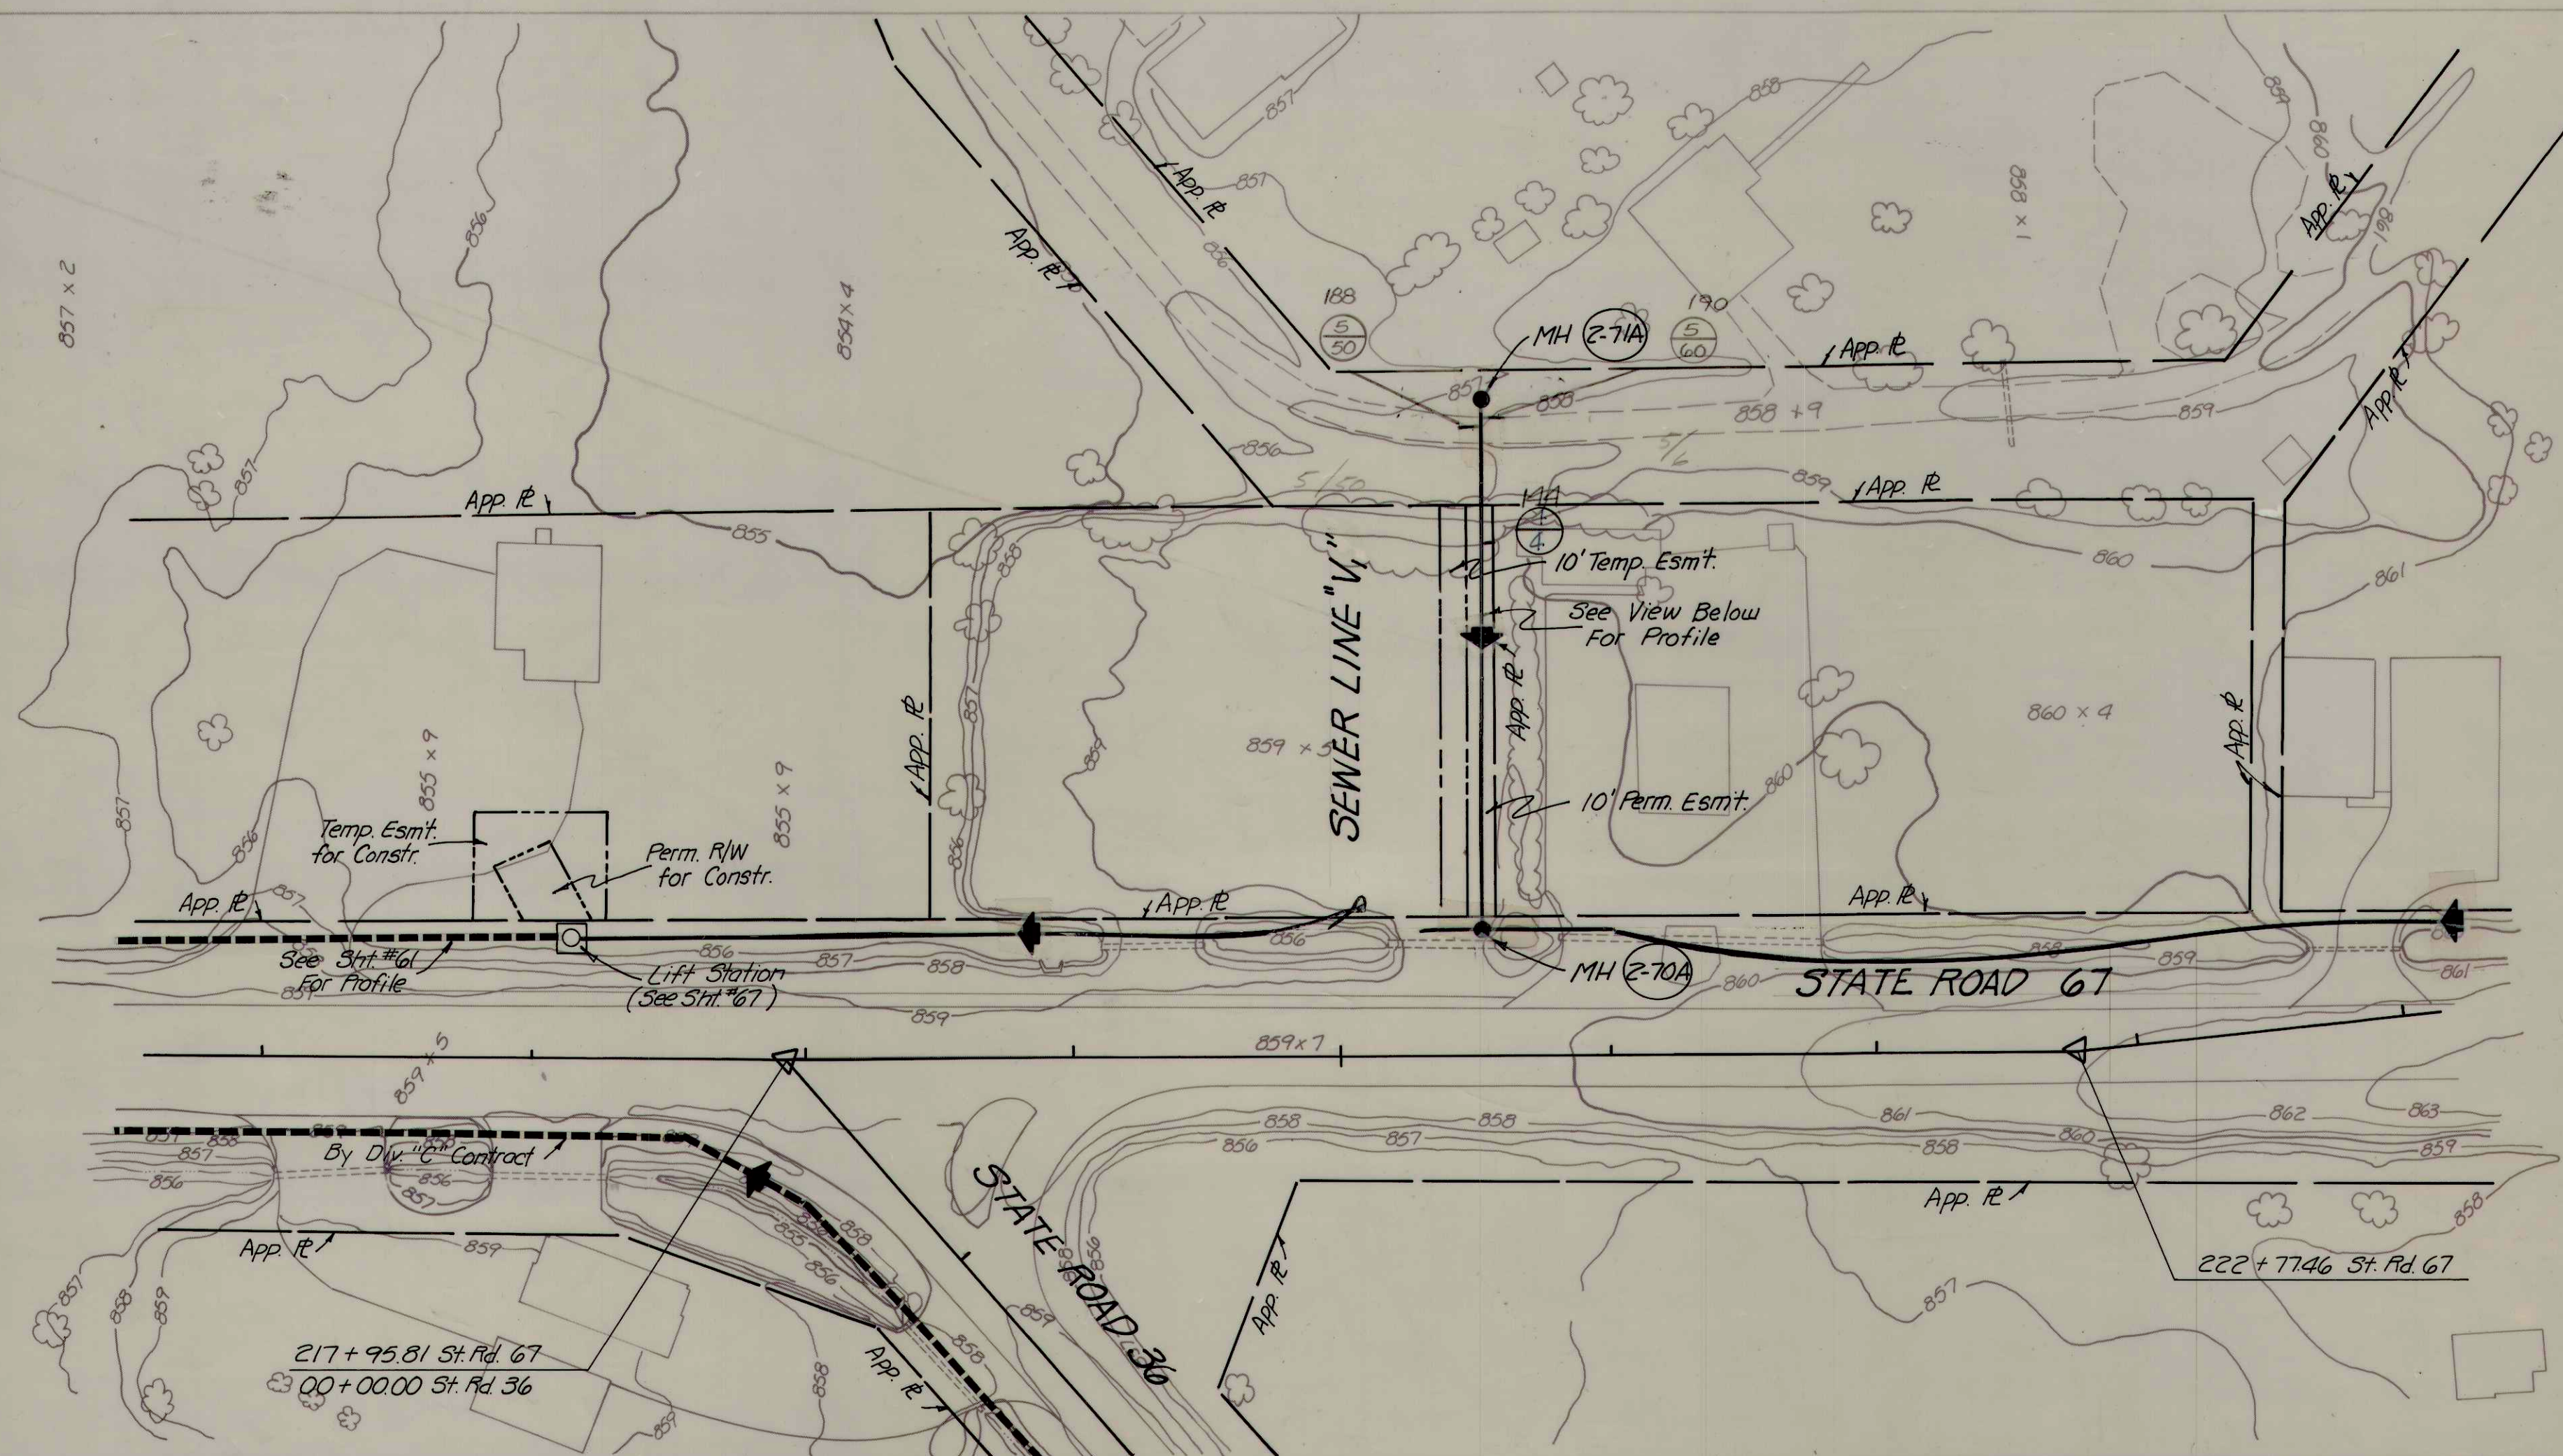

STATE ROAD 67
 FALL CREEK R.W.D. PLAN & PROFILE SHEET
 HORIZ. 1"=50'
 VERT. 1"=10'
 BEAM, LONGEST & NEFF, INC.
 CONSULTING ENGINEERS
 INDIANAPOLIS, INDIANA
 61A