


PLAN	SURVEYED	DATE
	PLOTTED	BY
	NOTE BOOK ALIGNMENT CHECKED	
	NO. OF WAY CHECKED	

PROFILE	SURVEYED	DATE
	GRADES CHECKED	BY
	NOTE BOOK	
	STRUCTURE NOTATIONS CHECKED	



RECORD DRAWING

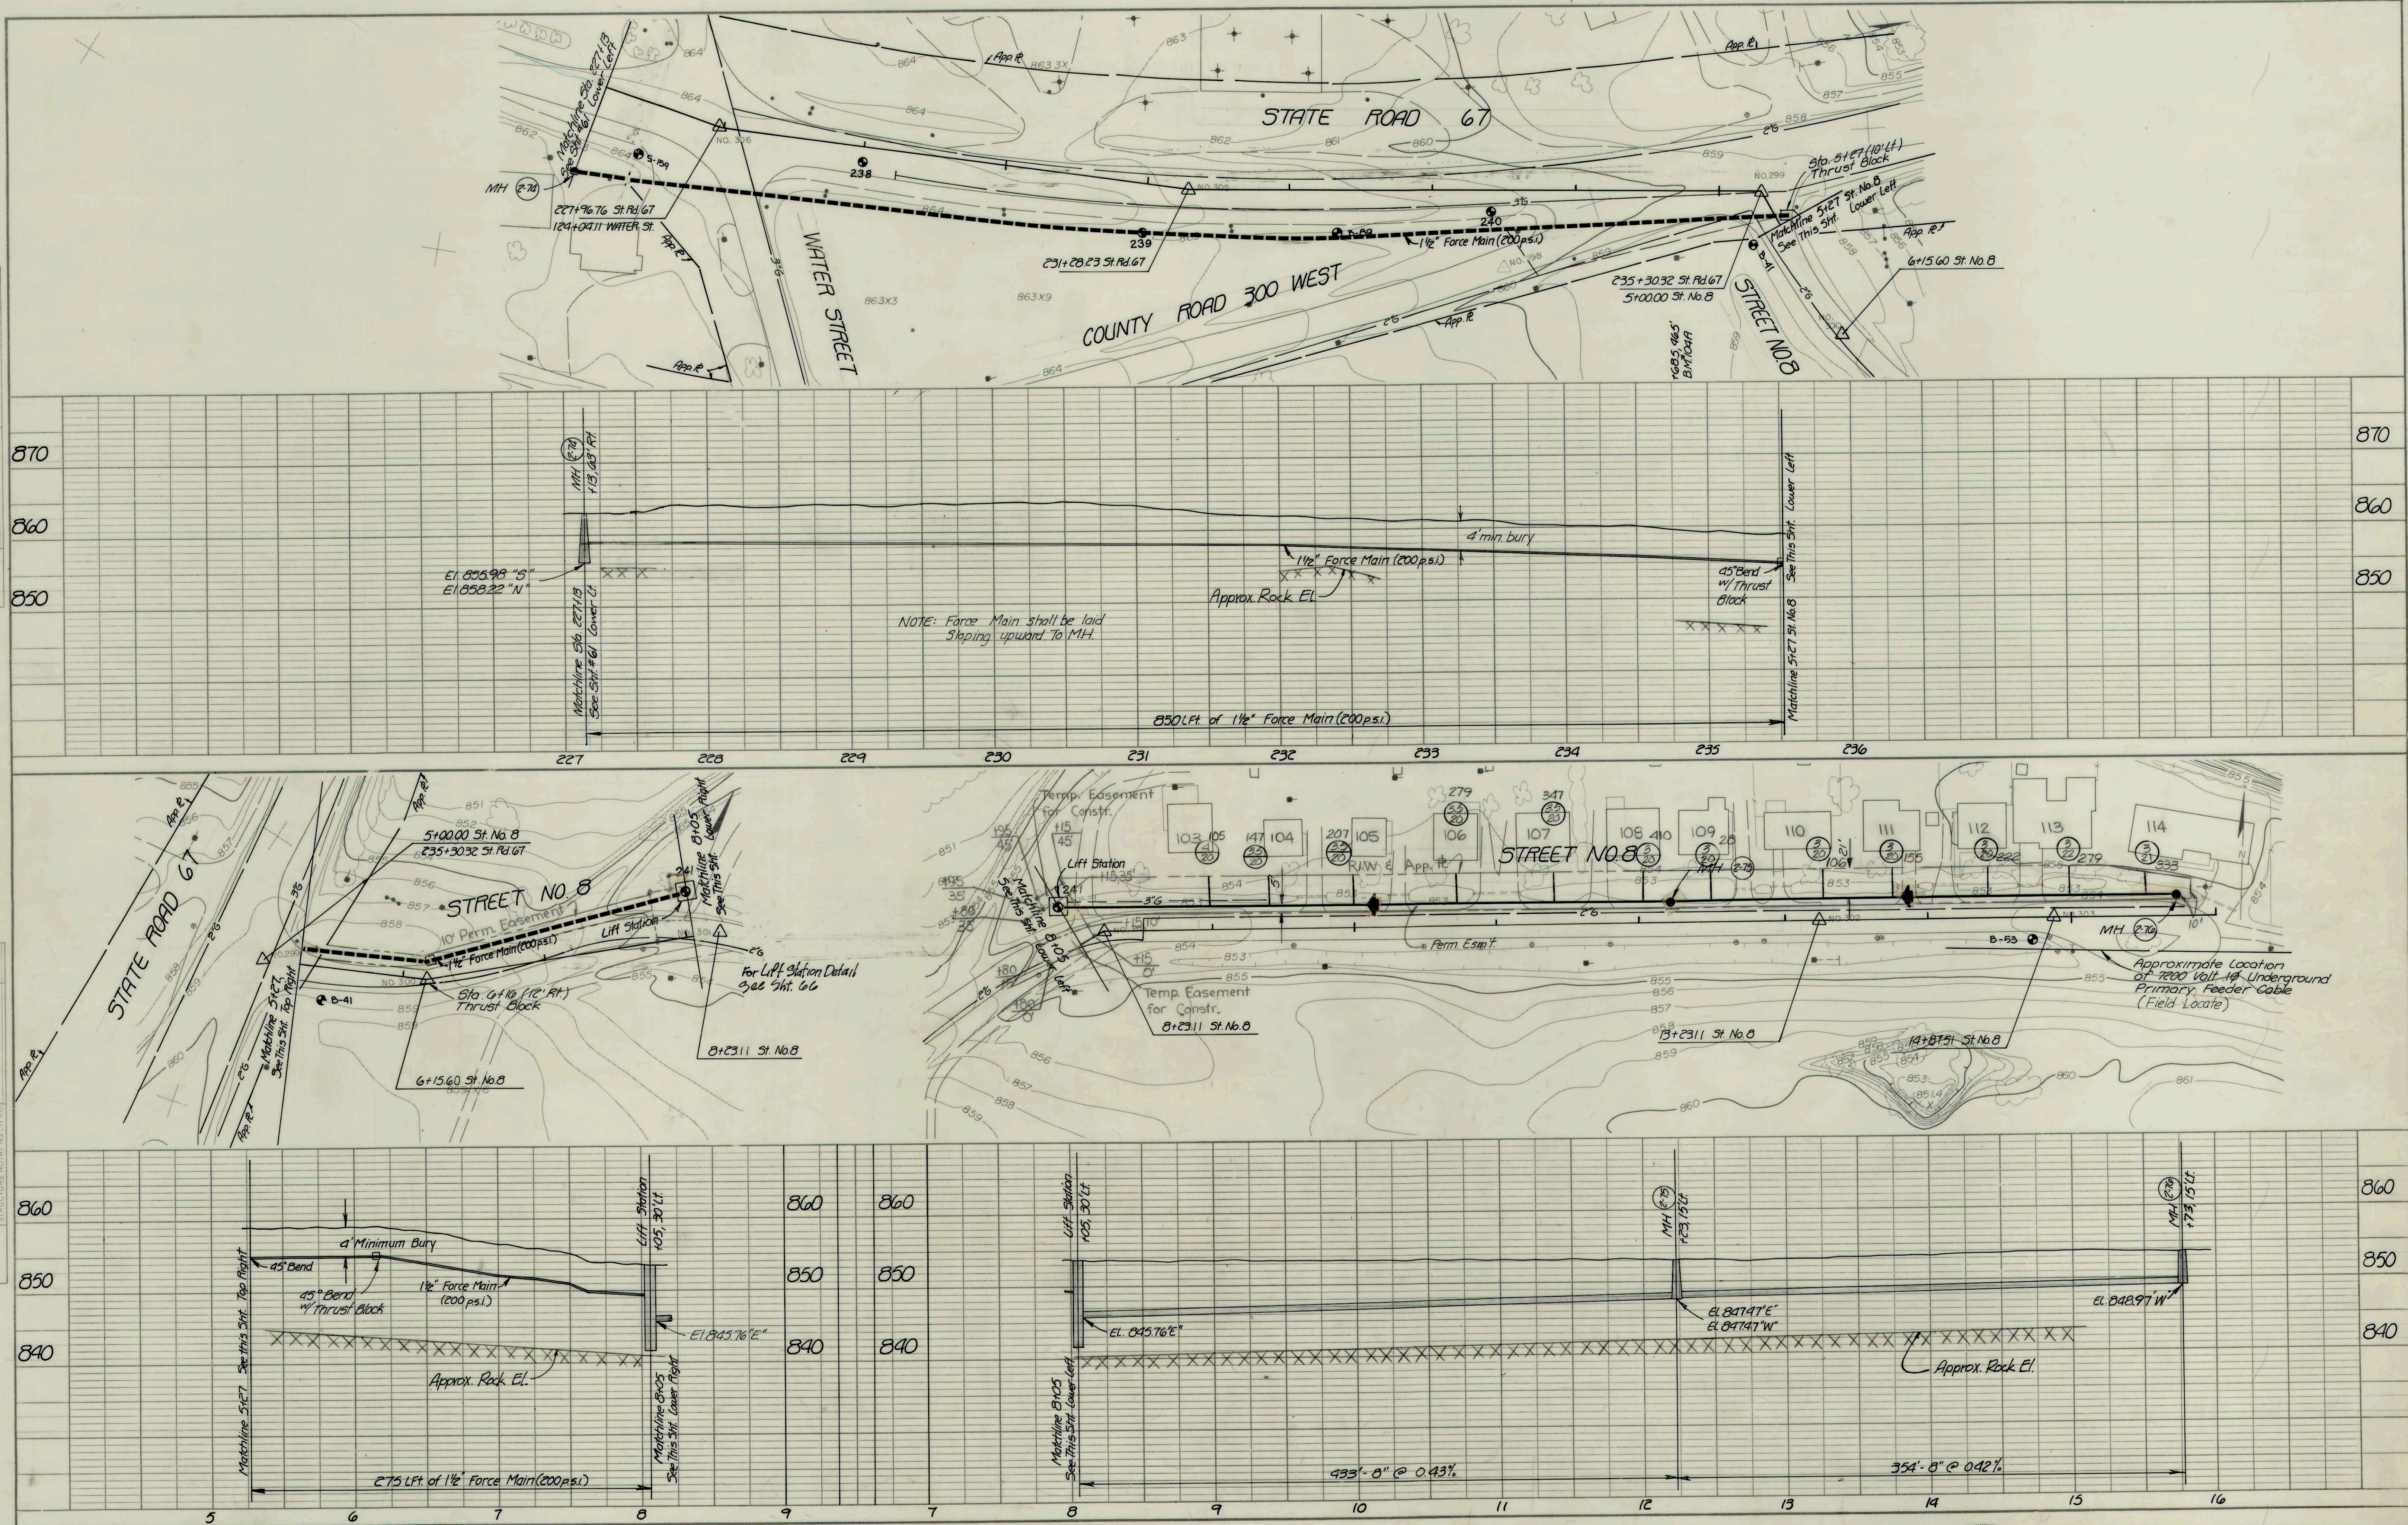

STATE ROAD 67/ STREET NO. 8
 FALL CREEK R.W.D. PLAN & PROFILE SHEET
 HORIZ. 1"=50'
 VERT. 1"=10'
 BEAM, LONGEST & NEFF, INC.
 CONSULTING ENGINEERS
 INDIANAPOLIS, INDIANA
 62