
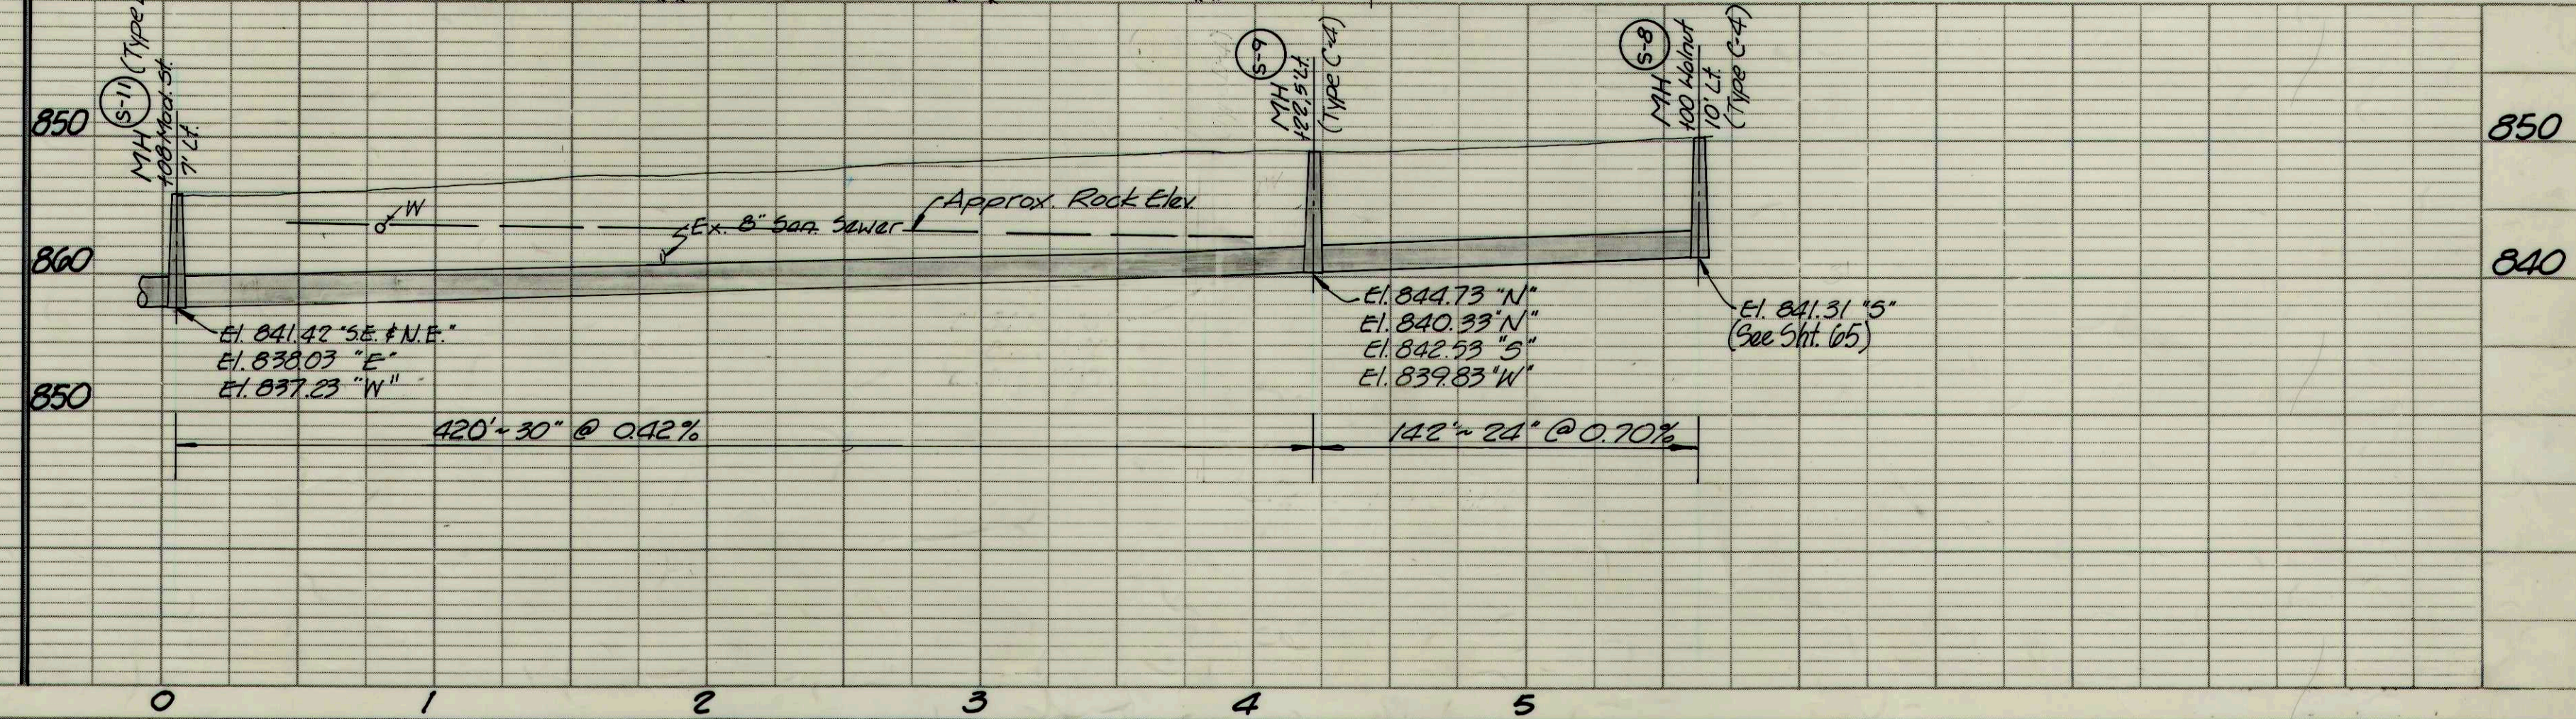
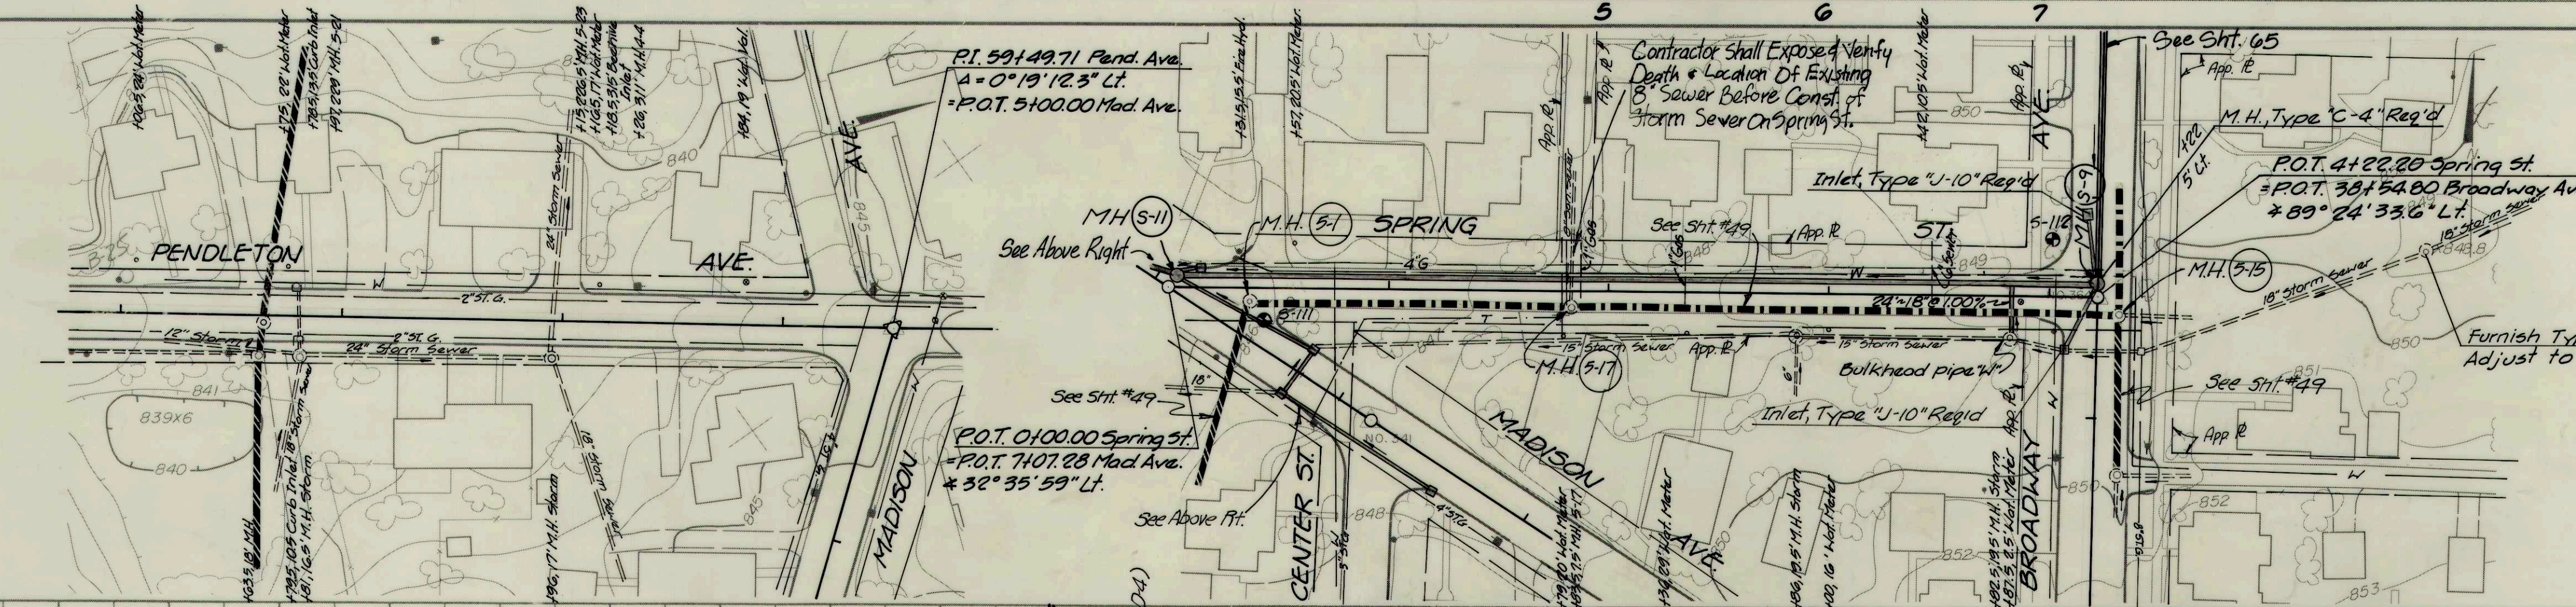
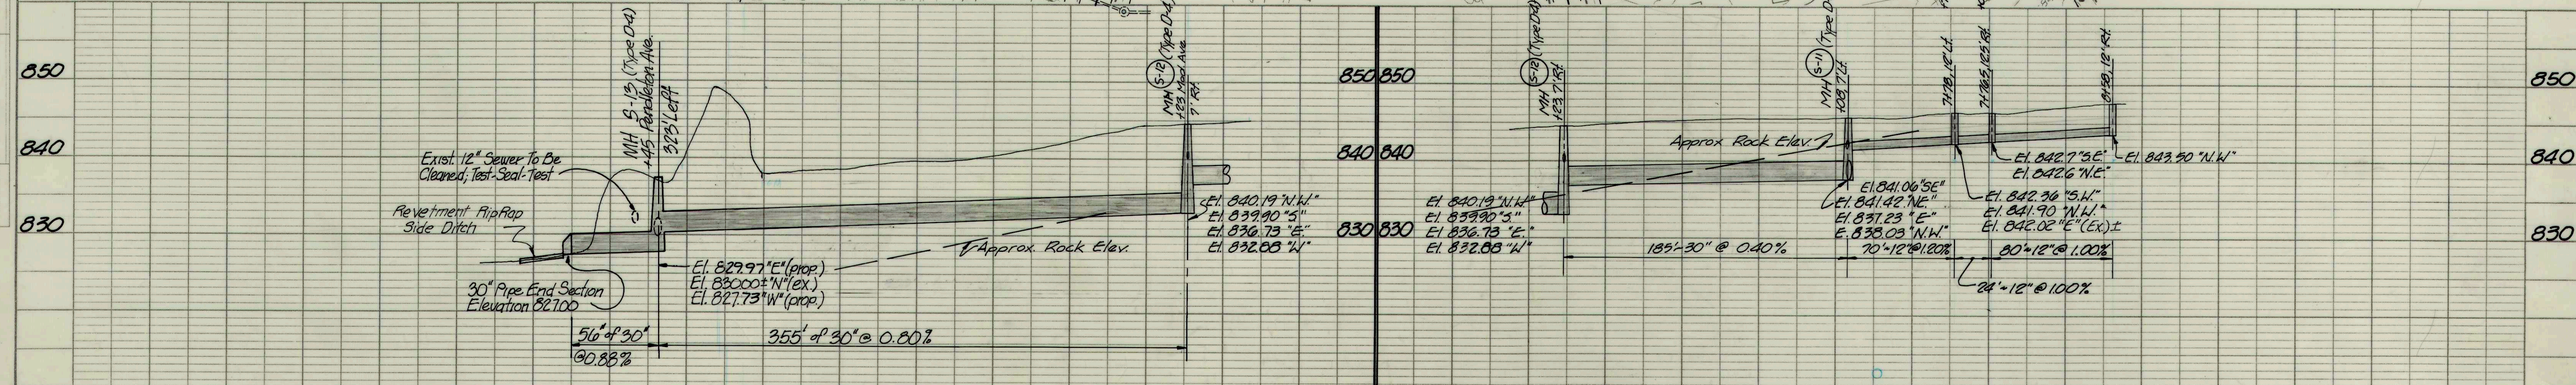
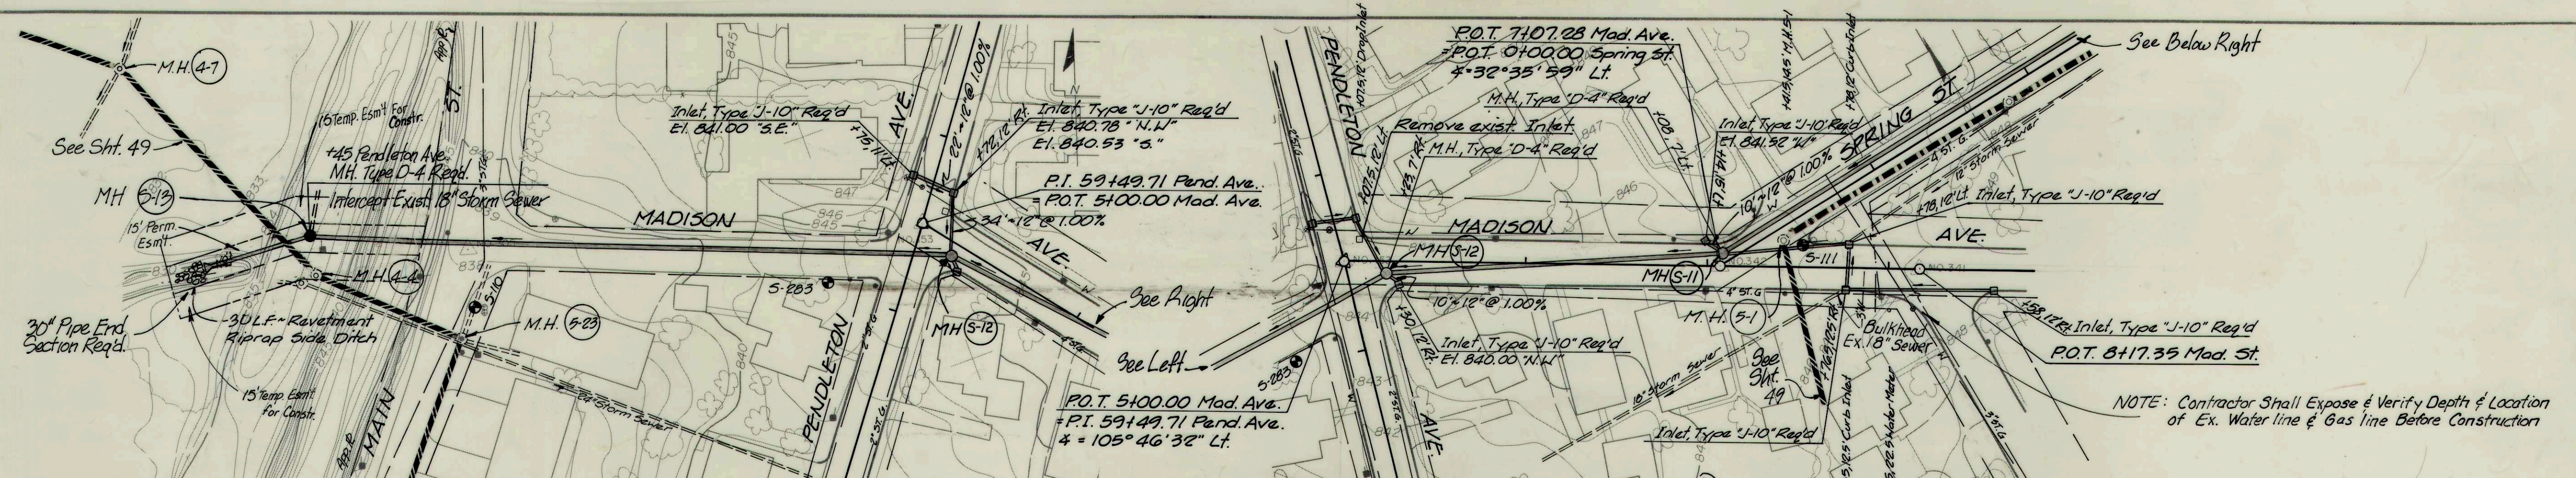



PLAN  
 SURVEYED  
 PLOTTED  
 NOTE BOOK  
 ALIGNMENT CHECKED  
 BY  
 NO.

PROFILE  
 SURVEYED  
 PLOTTED  
 NOTE BOOK  
 B. & S. NOTED  
 STRUCTURE NOTATIONS CHECKED  
 BY  
 NO.

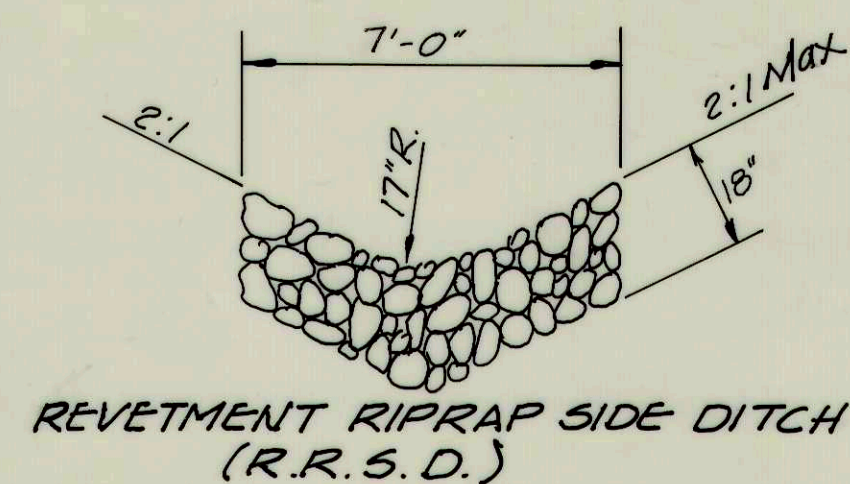

VOID

RECORD DRAWING

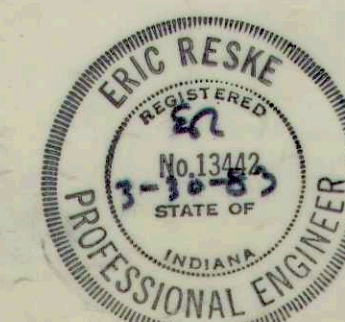

MADISON AVE / PENDLETON AVE.  
 SPRING STREET  
 FALL CREEK R.W.D. PLAN & PROFILE SHEET  
 HORIZ. 1"=50'  
 VERT. 1"=10'  
 BEAM, LONGEST & NEFF, INC.  
 CONSULTING ENGINEERS  
 INDIANAPOLIS, INDIANA  
 64