


PLAN	DATE	BY
	SUPERVISOR	
	PLOTTED	
	NOTE BOOK GRADES CHECKED BY: M. J. NOTES NO.	

PROFILE	DATE	BY
	SUPERVISOR	
	PLOTTED	
	NOTE BOOK GRADES CHECKED BY: M. J. NOTES NO.	



RECORD DRAWING

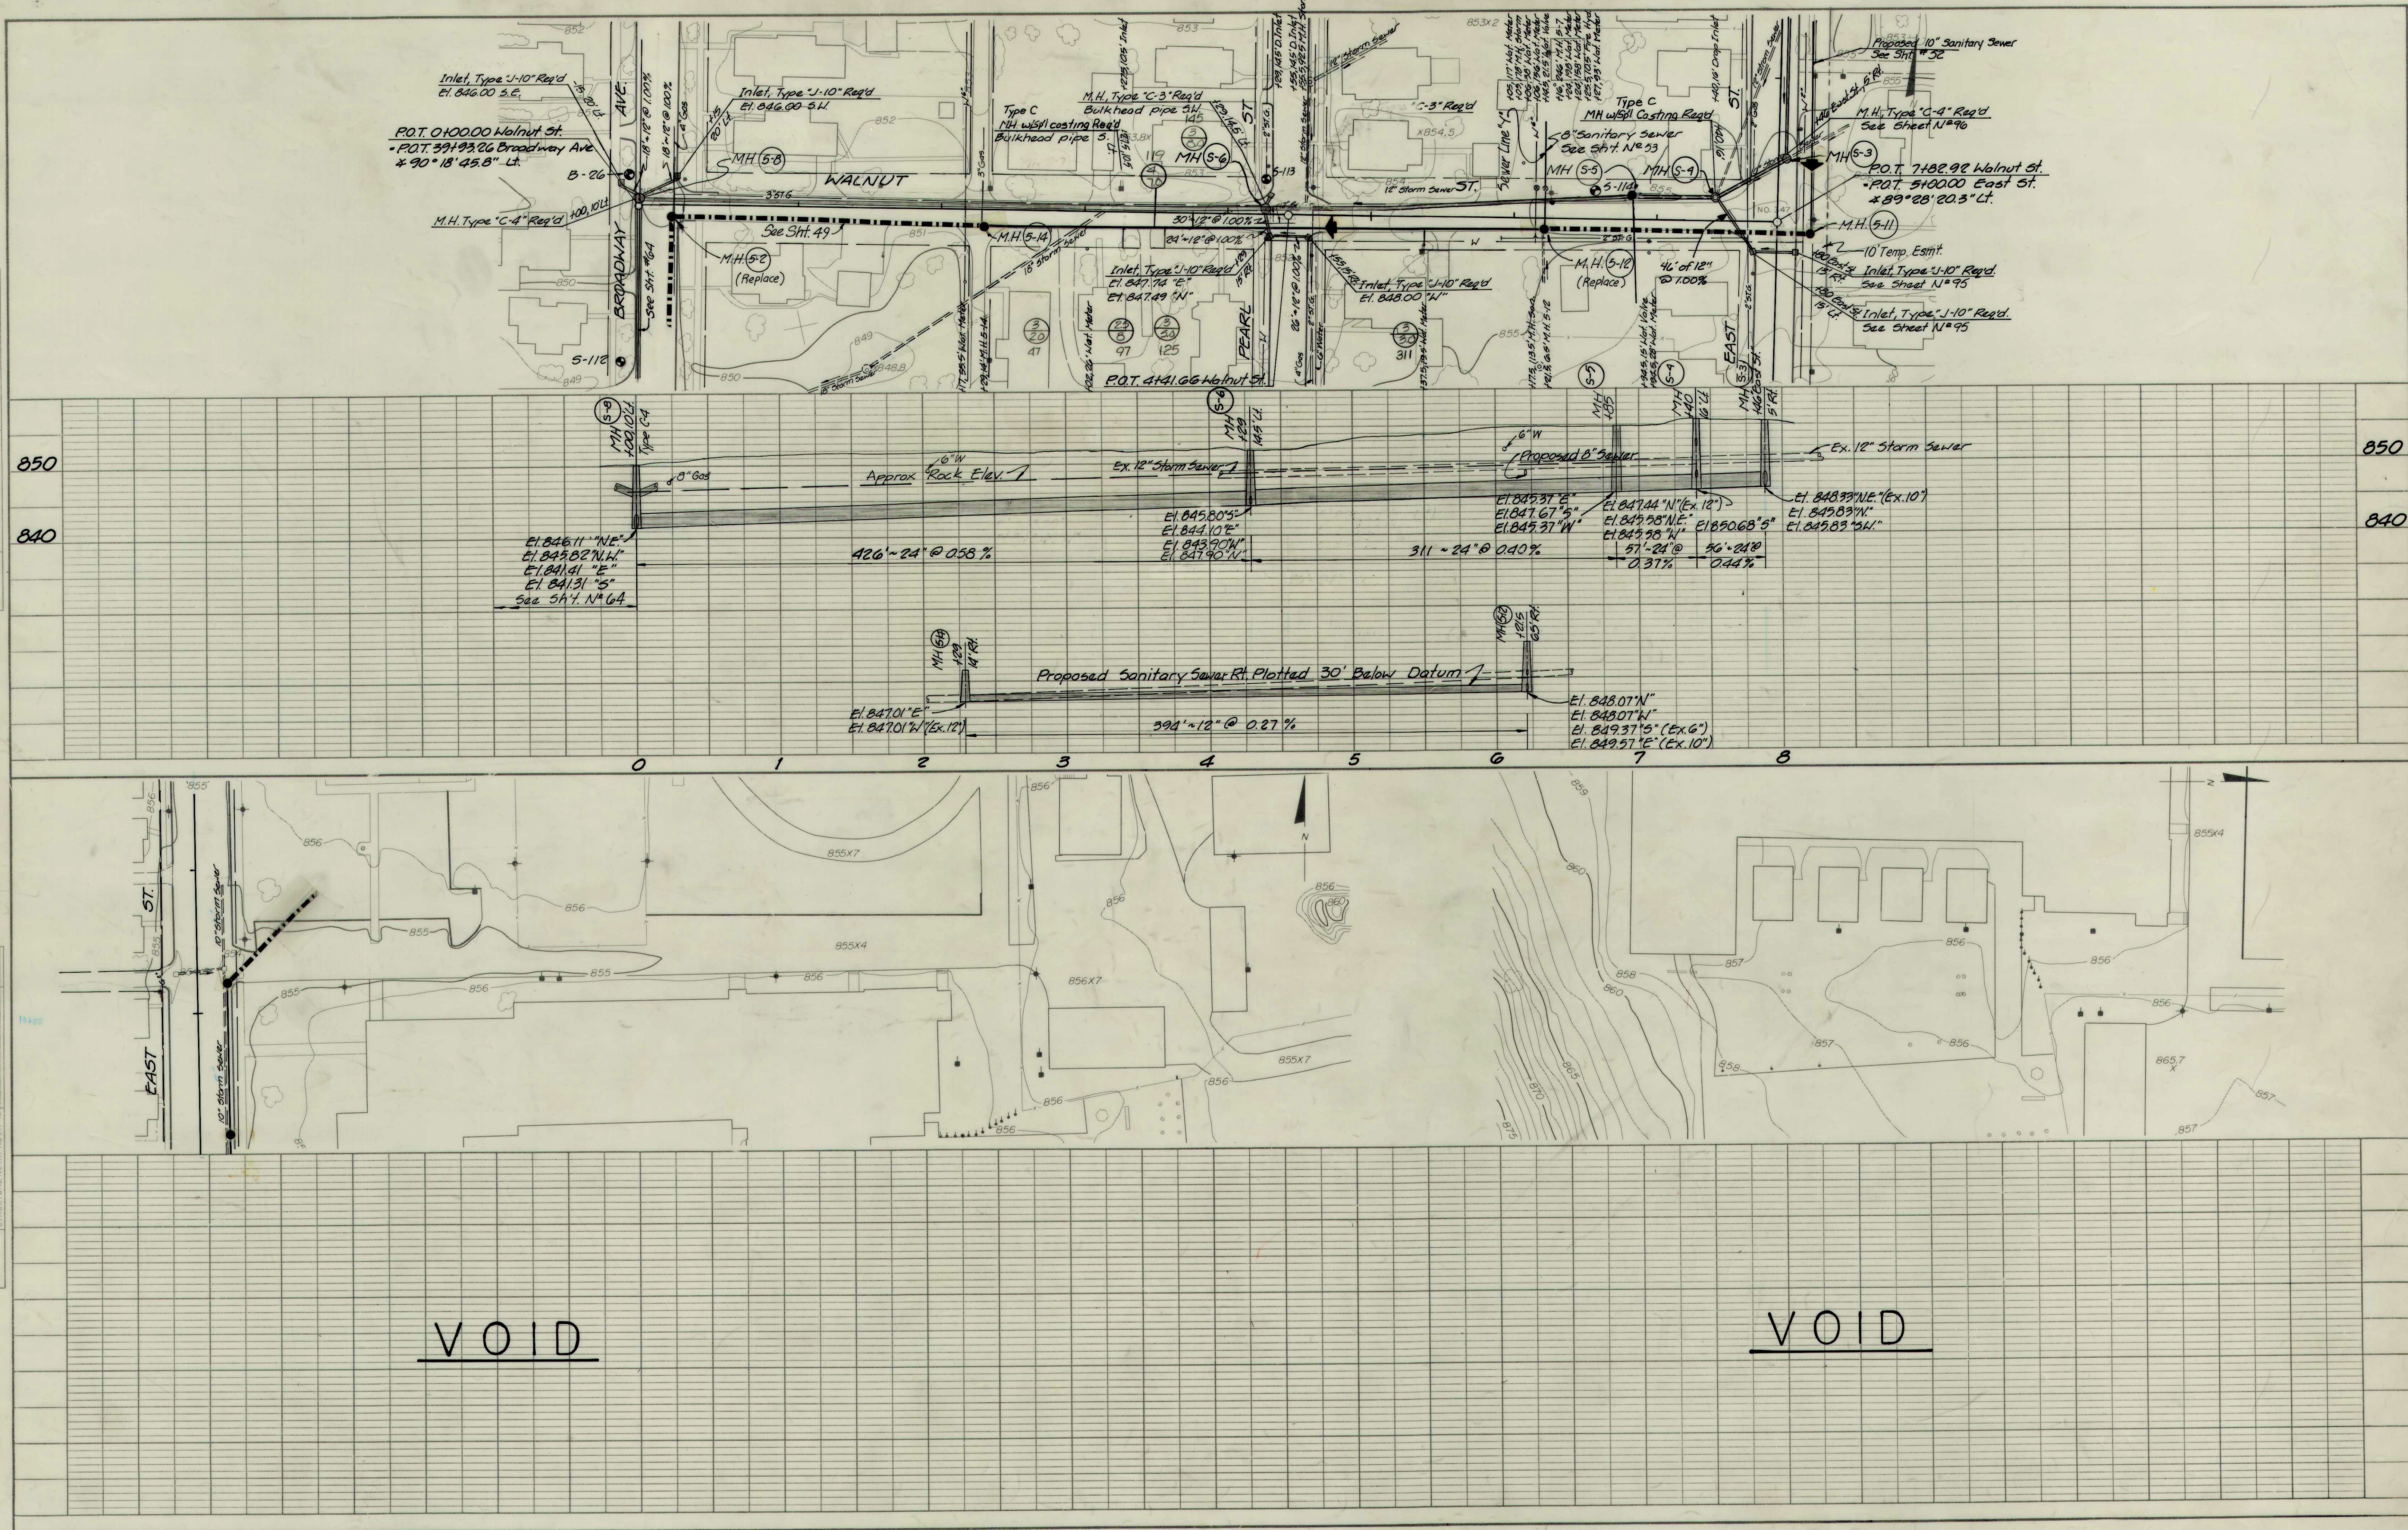

WALNUT STREET	
FALL CREEK R.W.D. PLAN & PROFILE SHEET	
HORIZ. 1"=50'	BEAM, LONGEST & NEFF, INC.
VERT. 1"=10'	CONSULTING ENGINEERS
	INDIANAPOLIS, INDIANA