




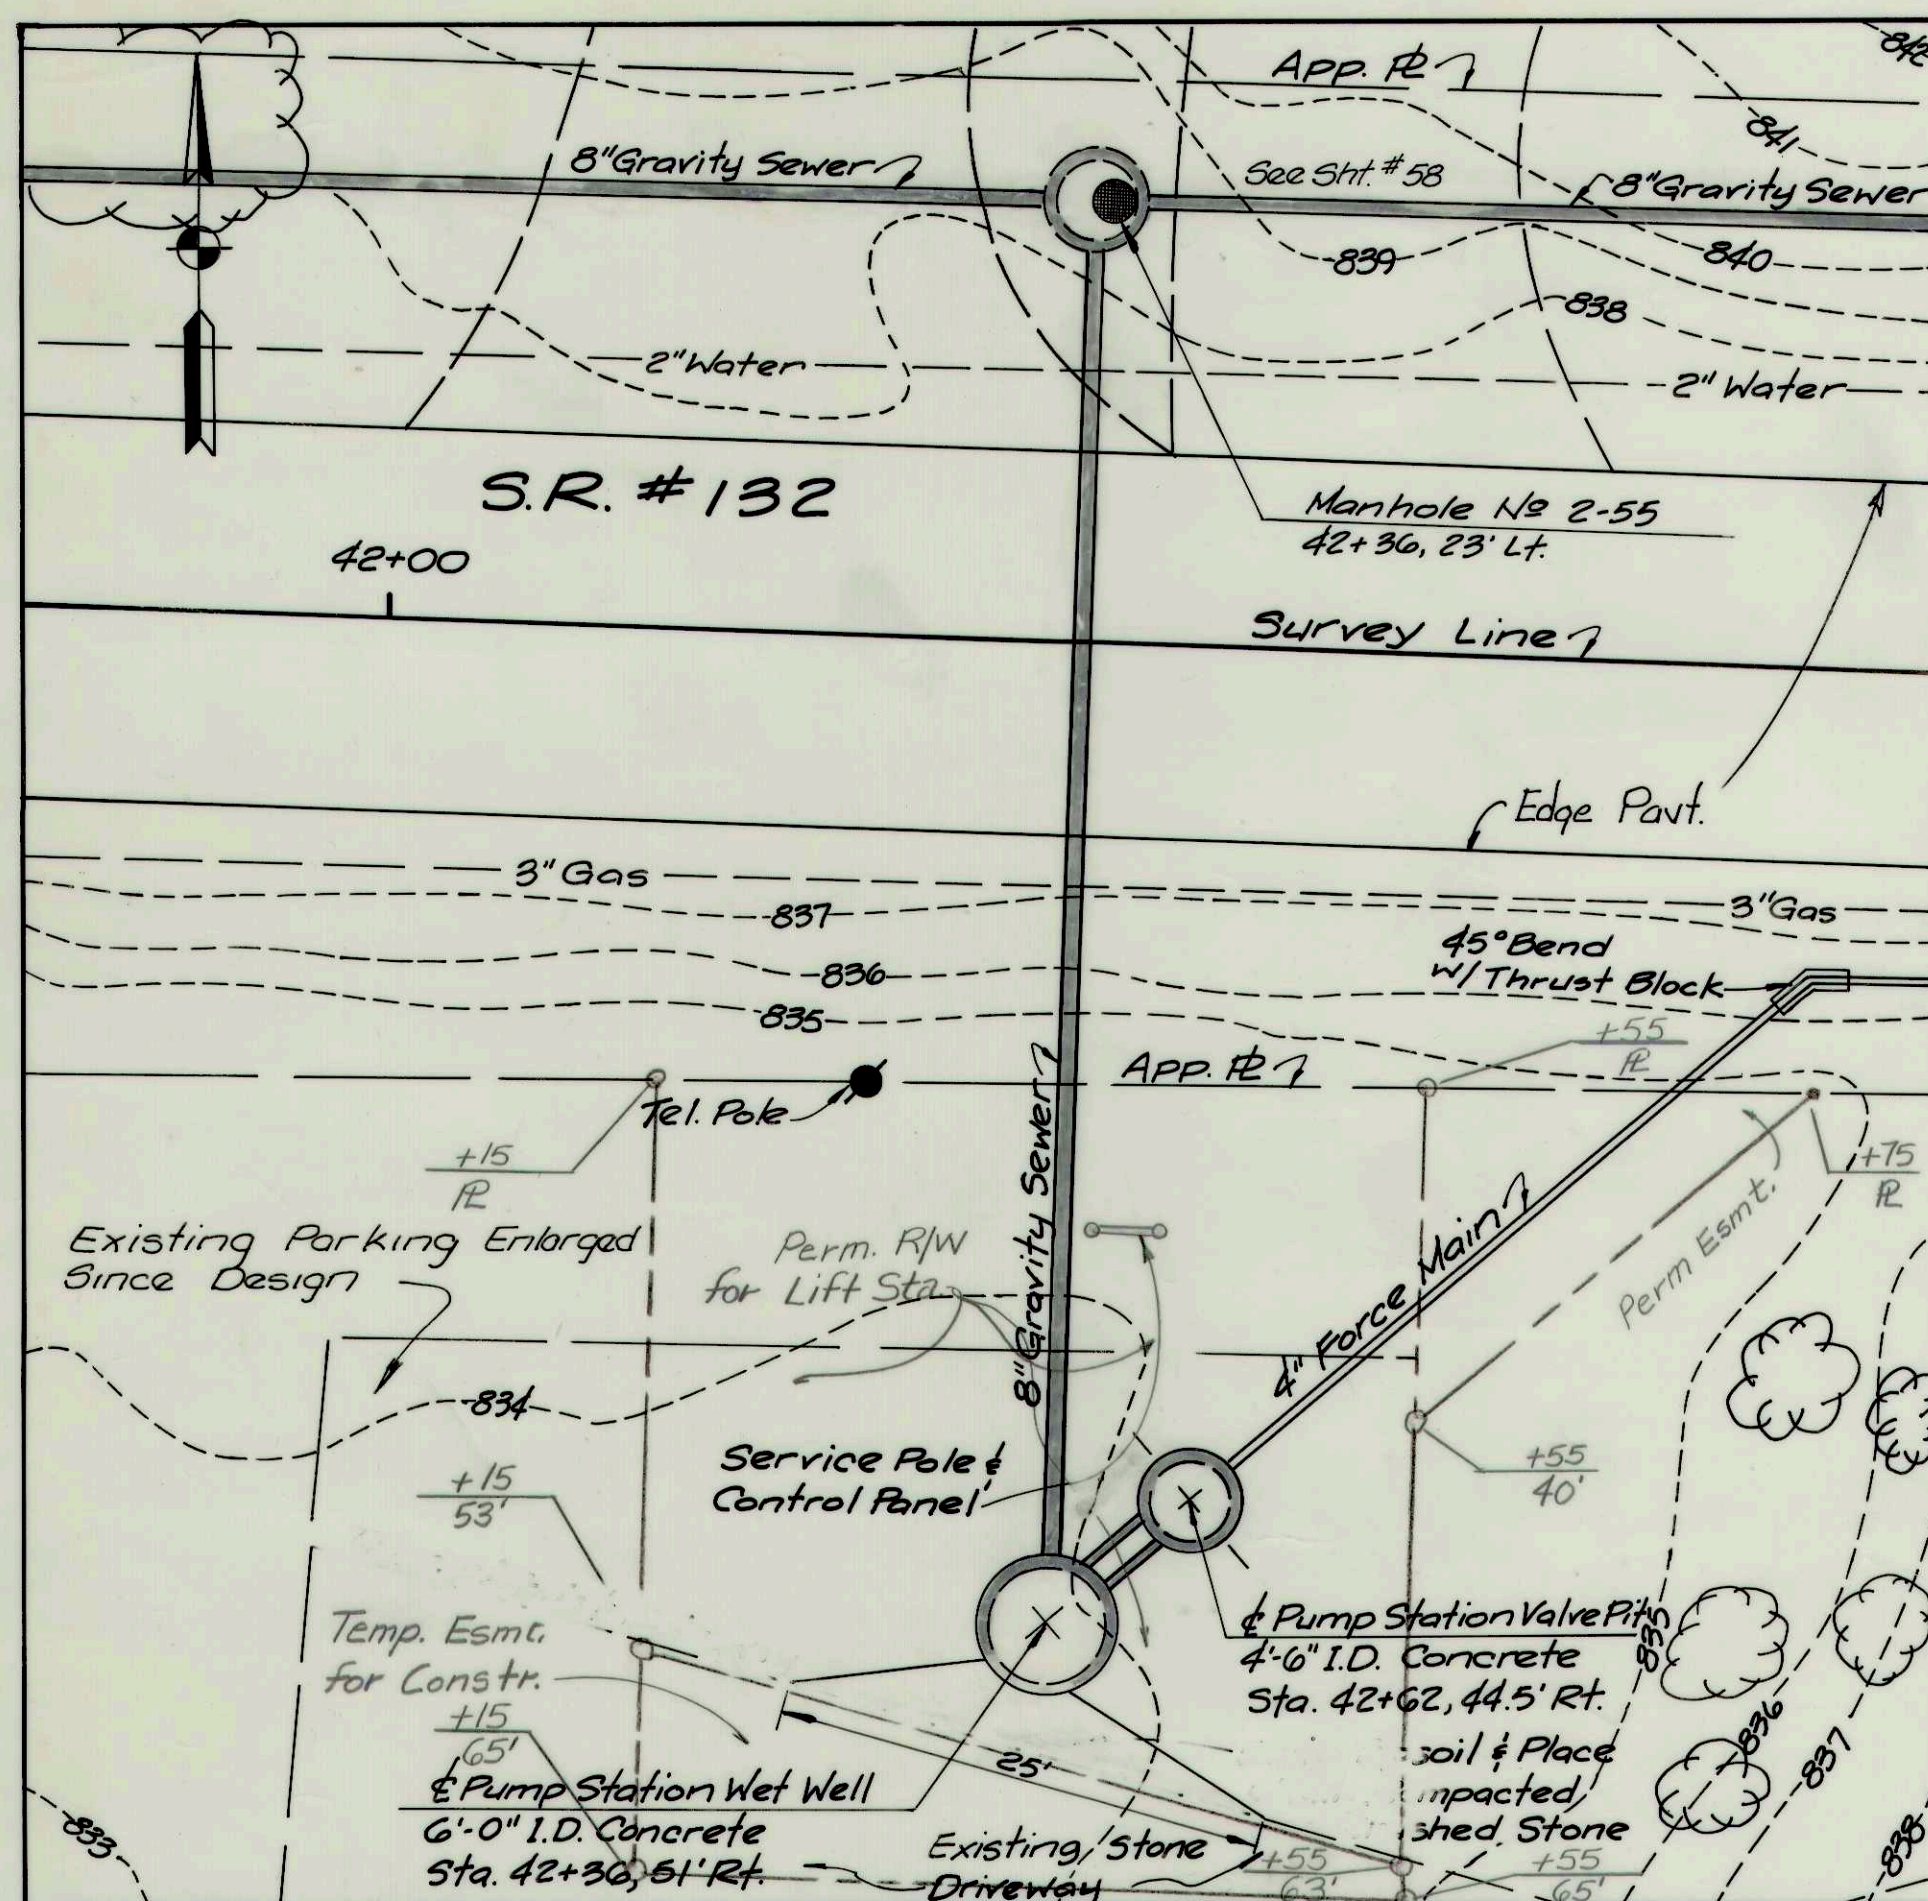


STATE ROAD 132 L.S.

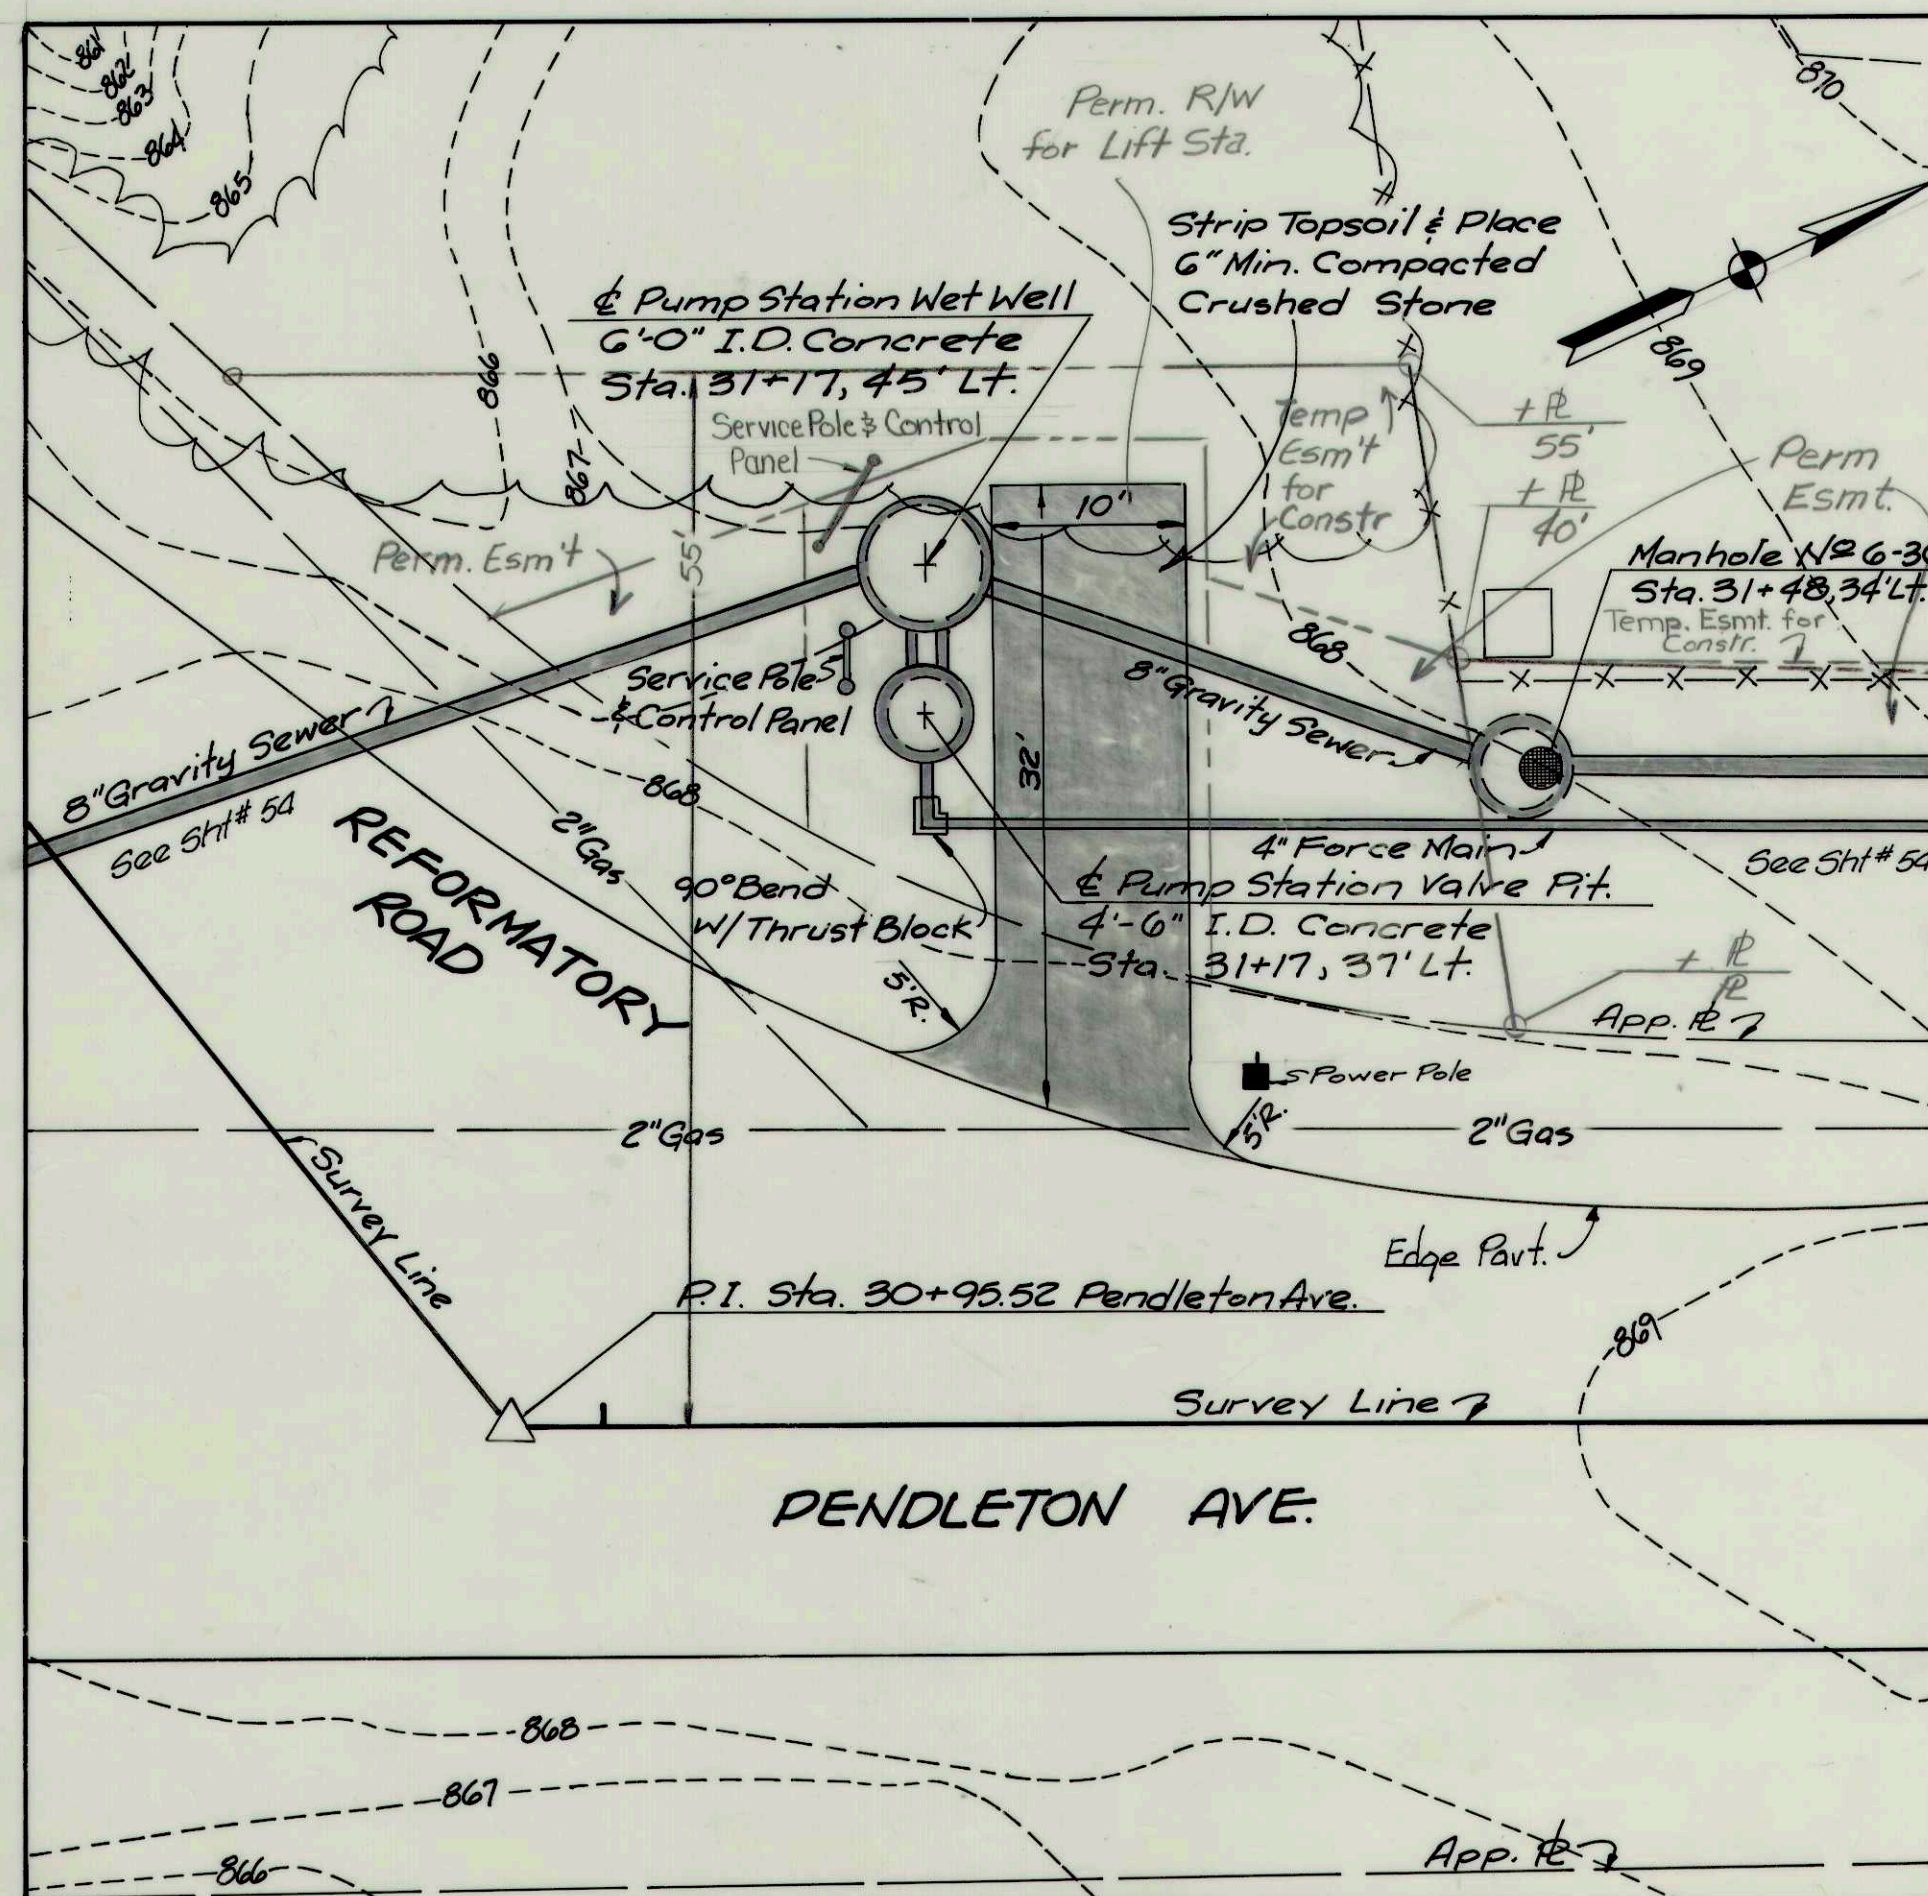


S. PENDLETON AVE. L.S.

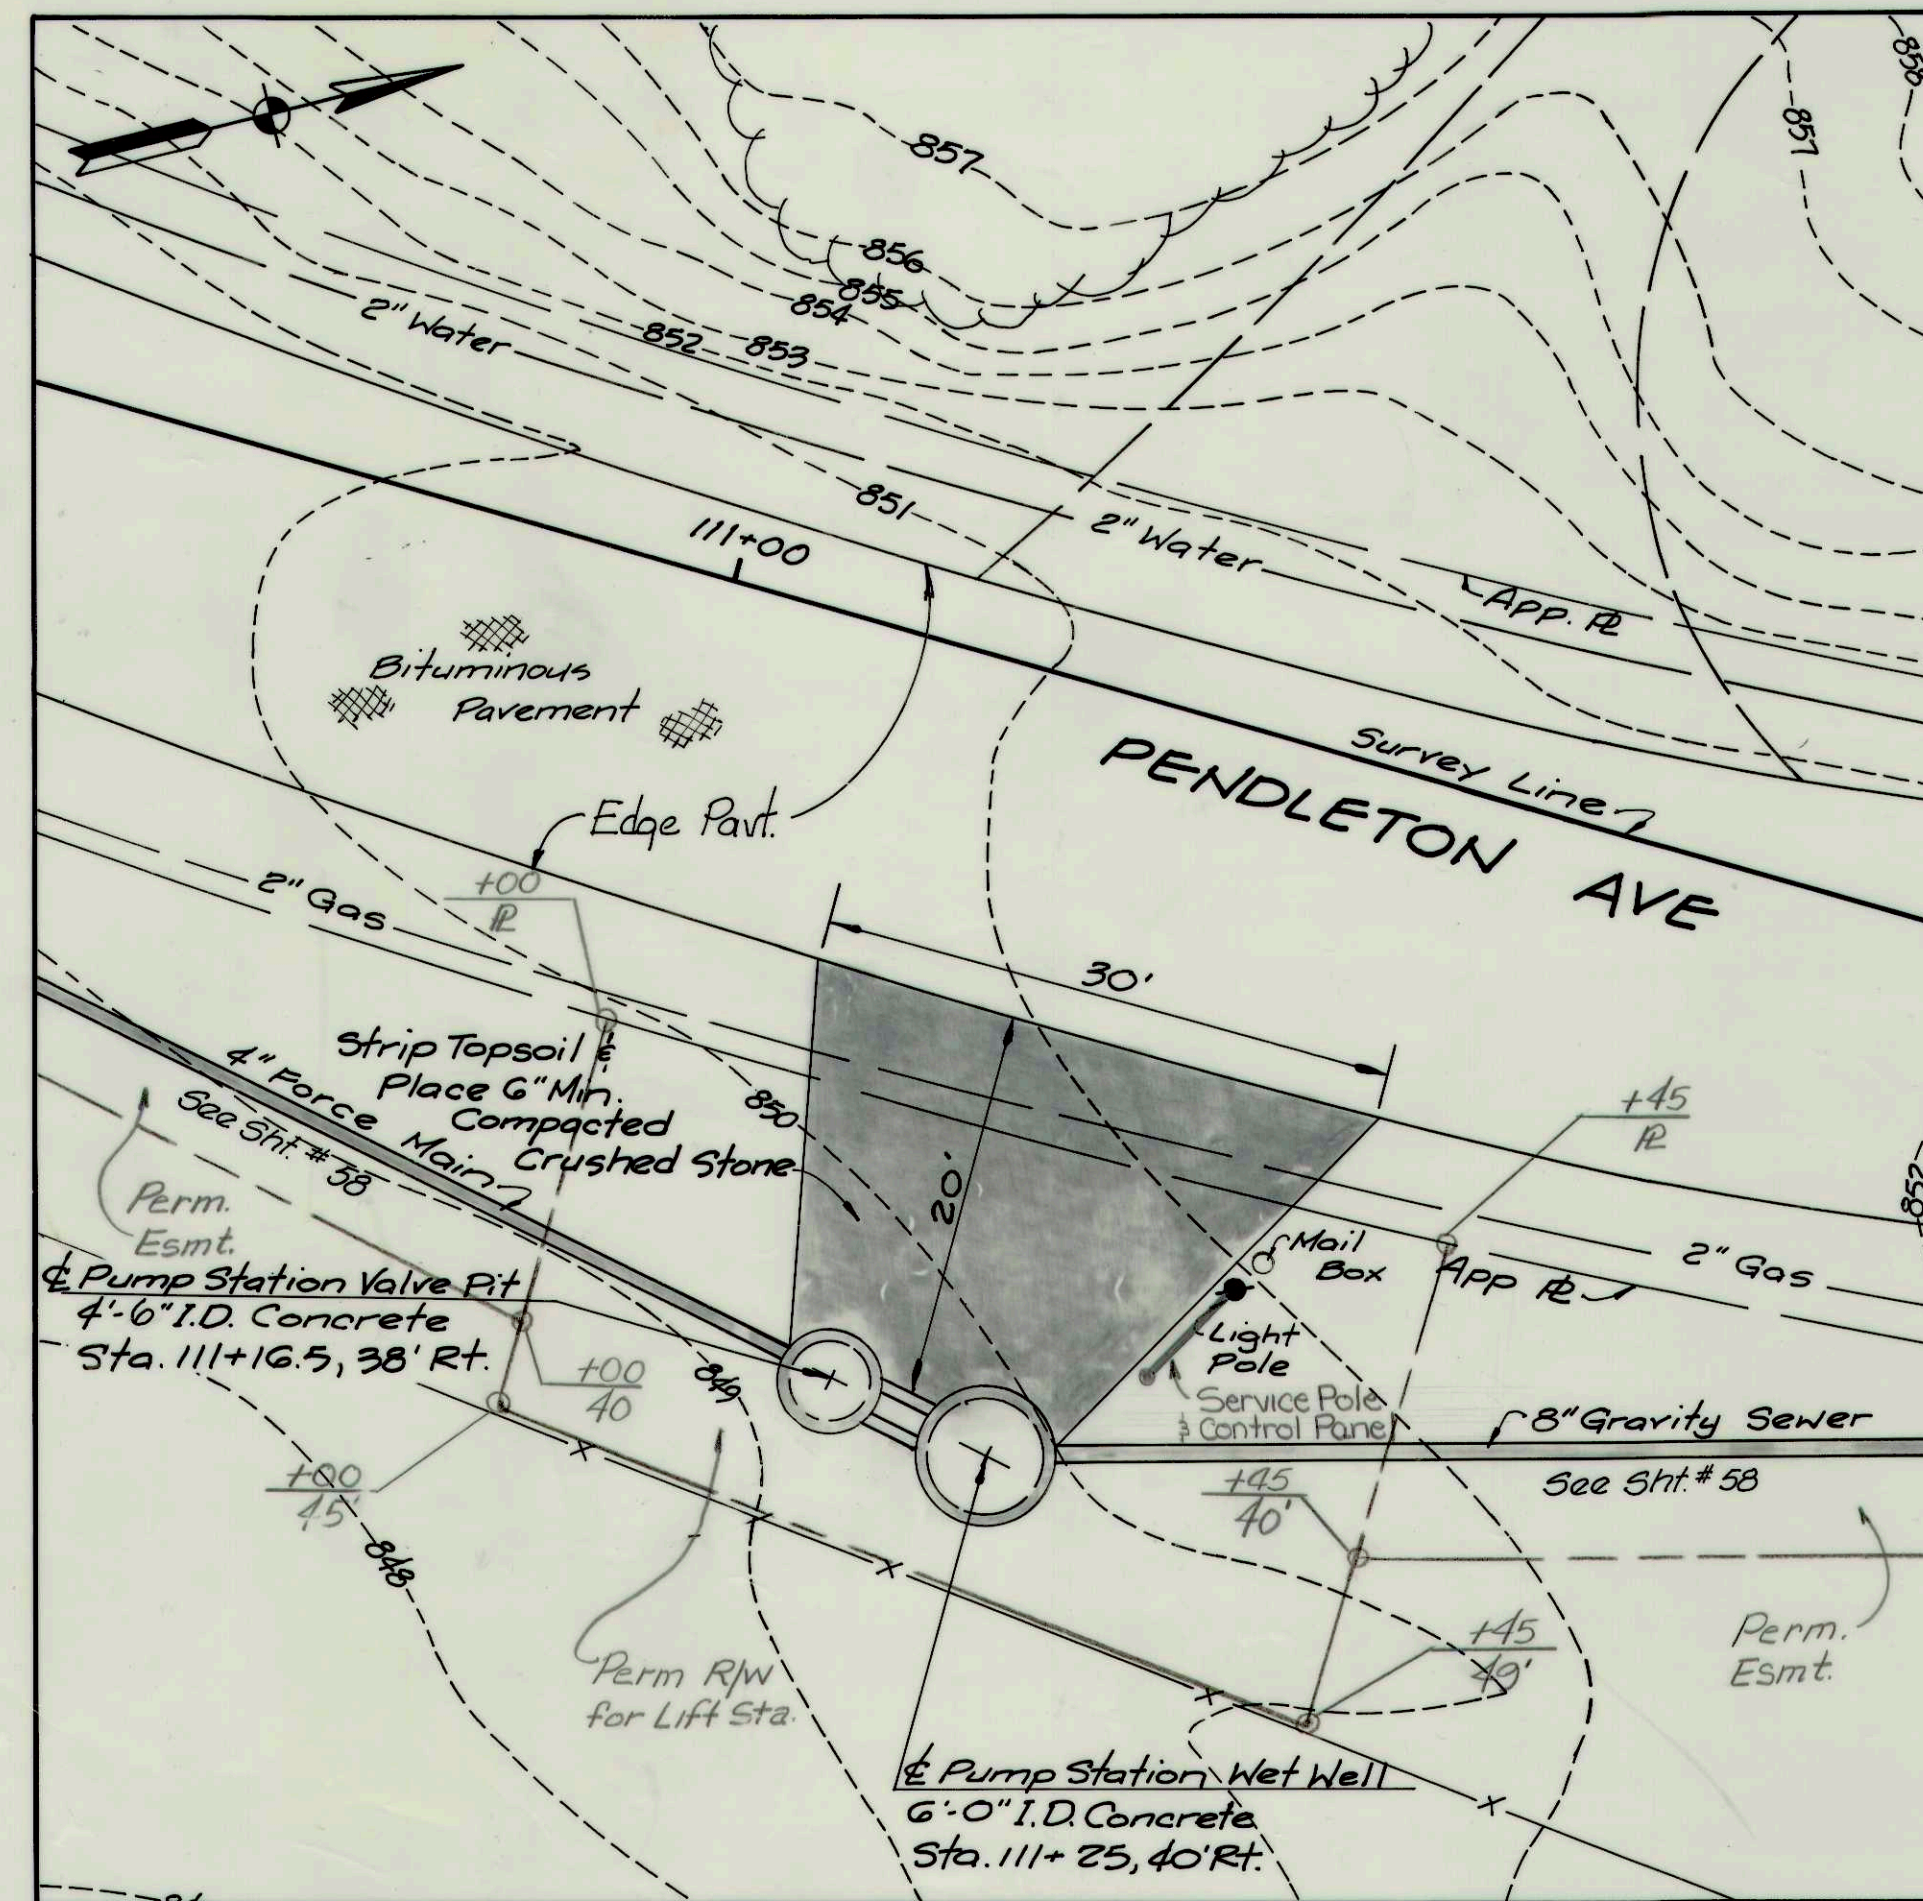


N. PENDLETON AVE. L.S.

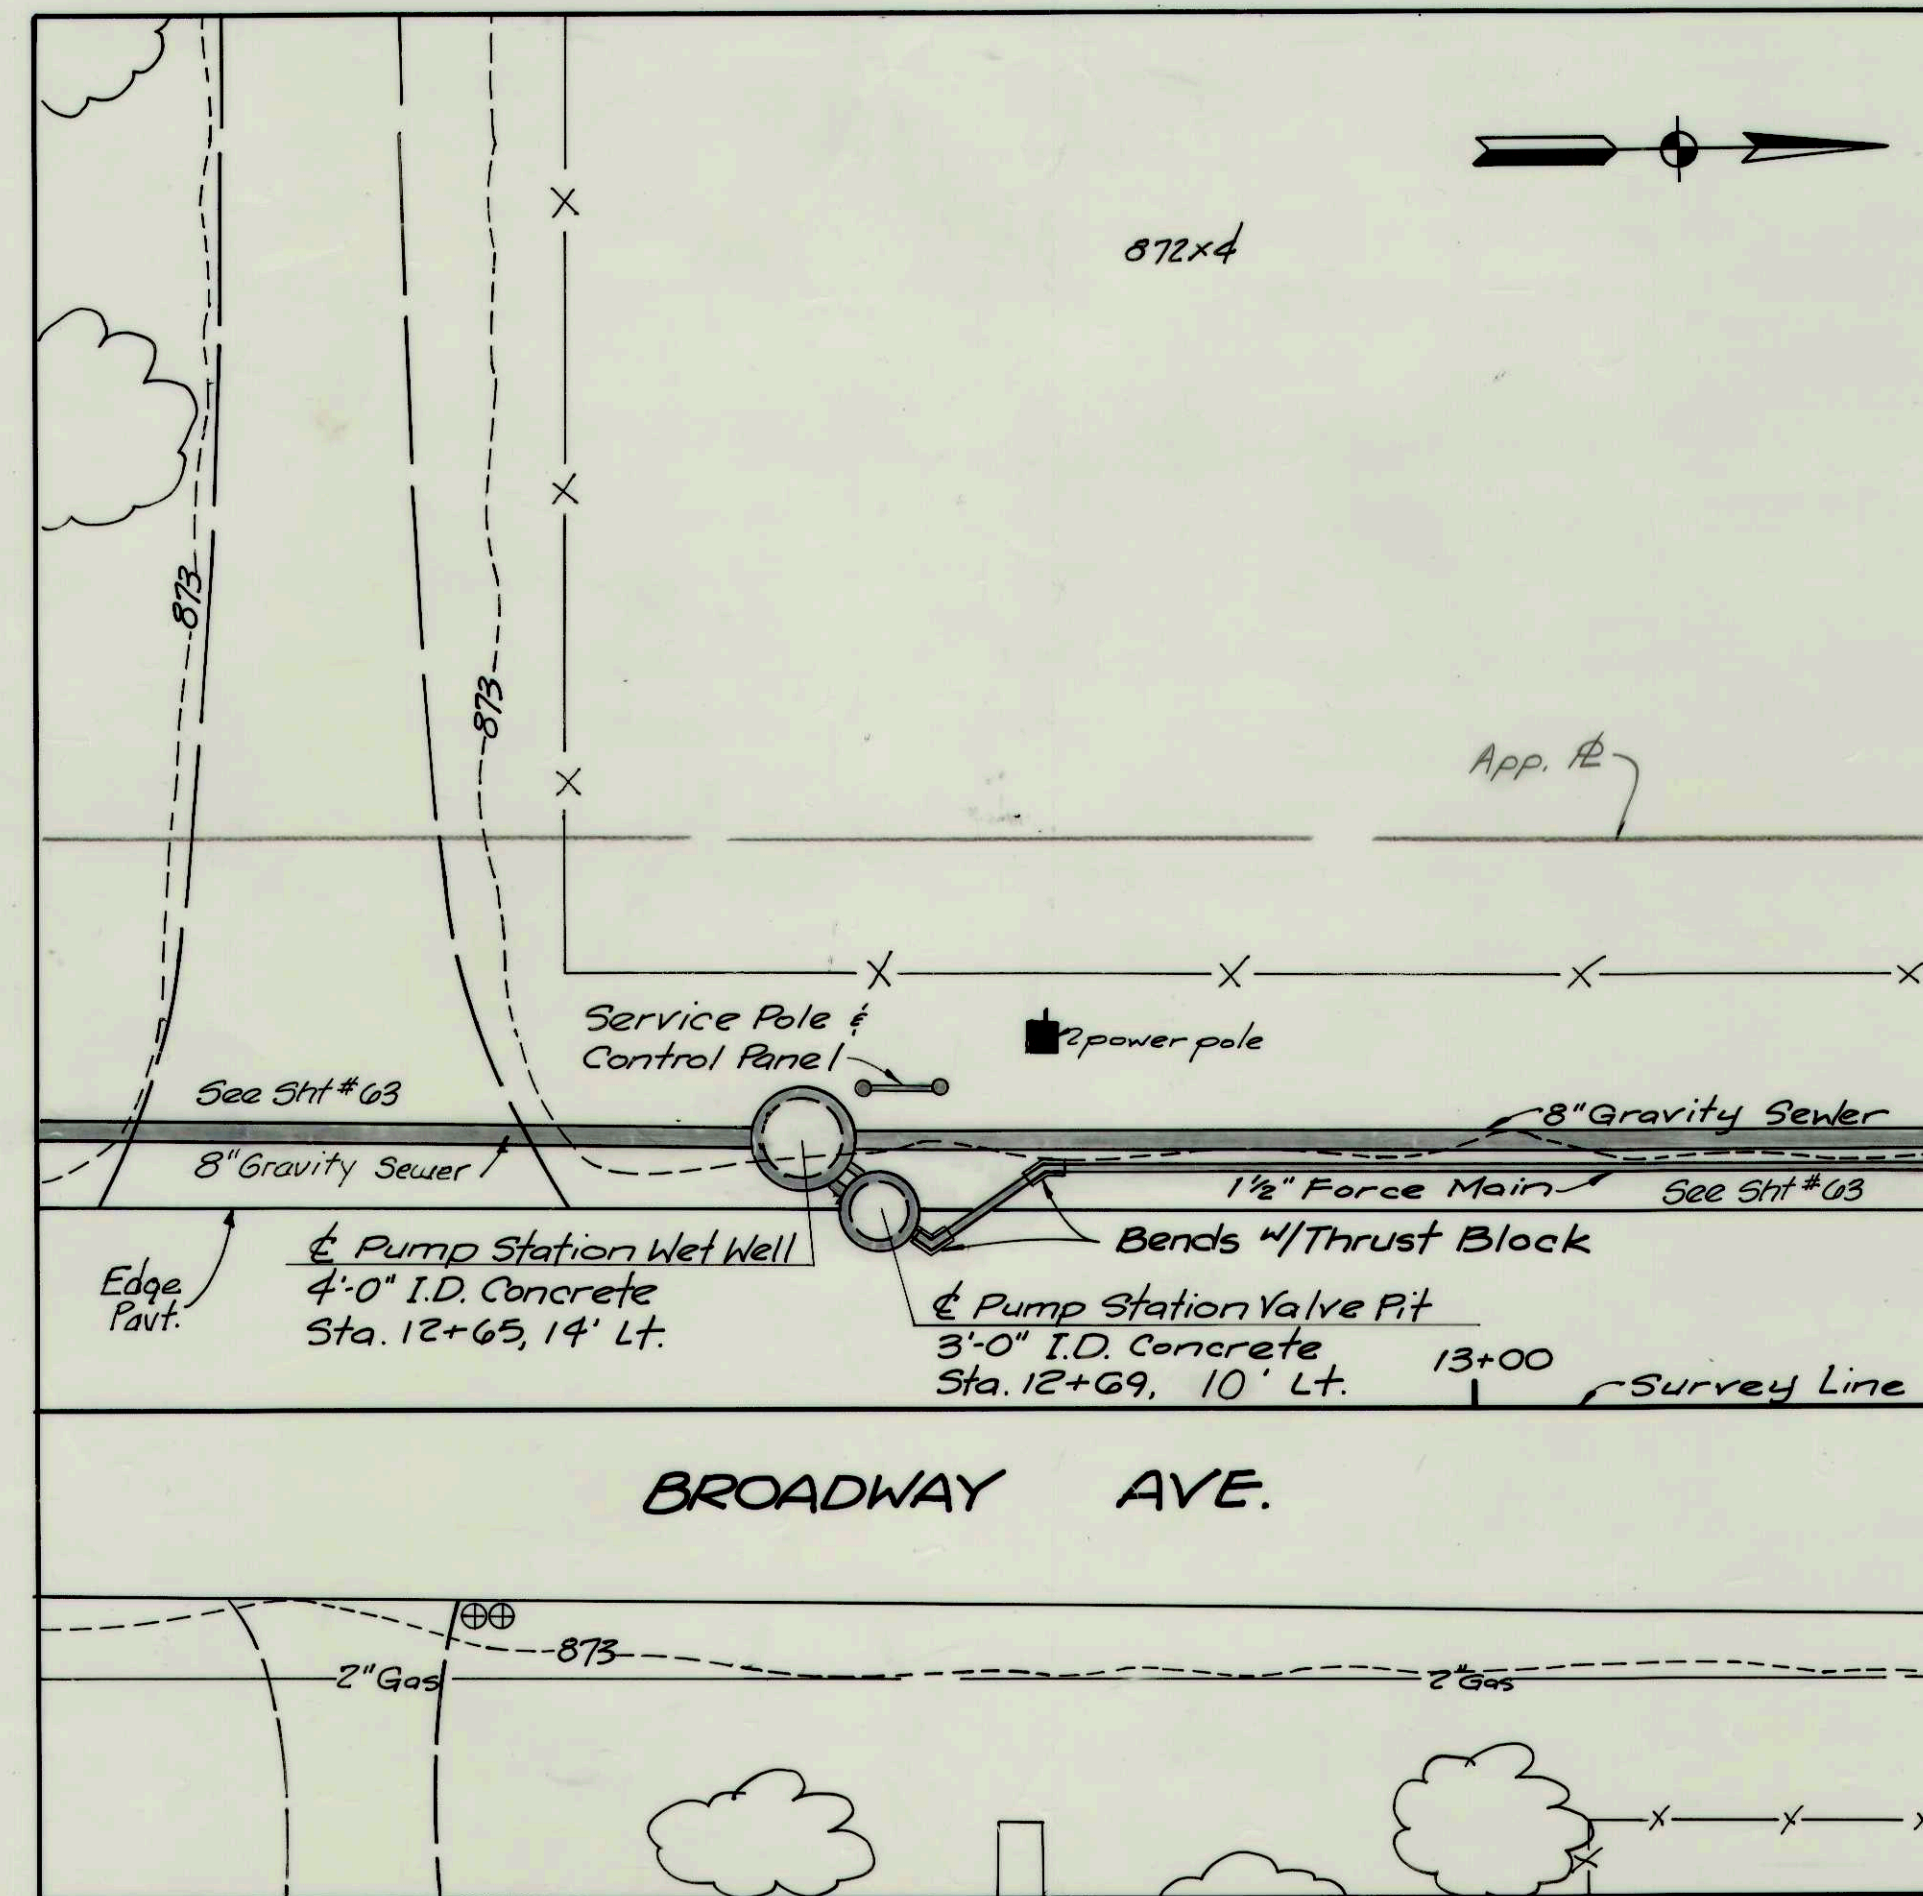

S. BROADWAY AVE. L.S.

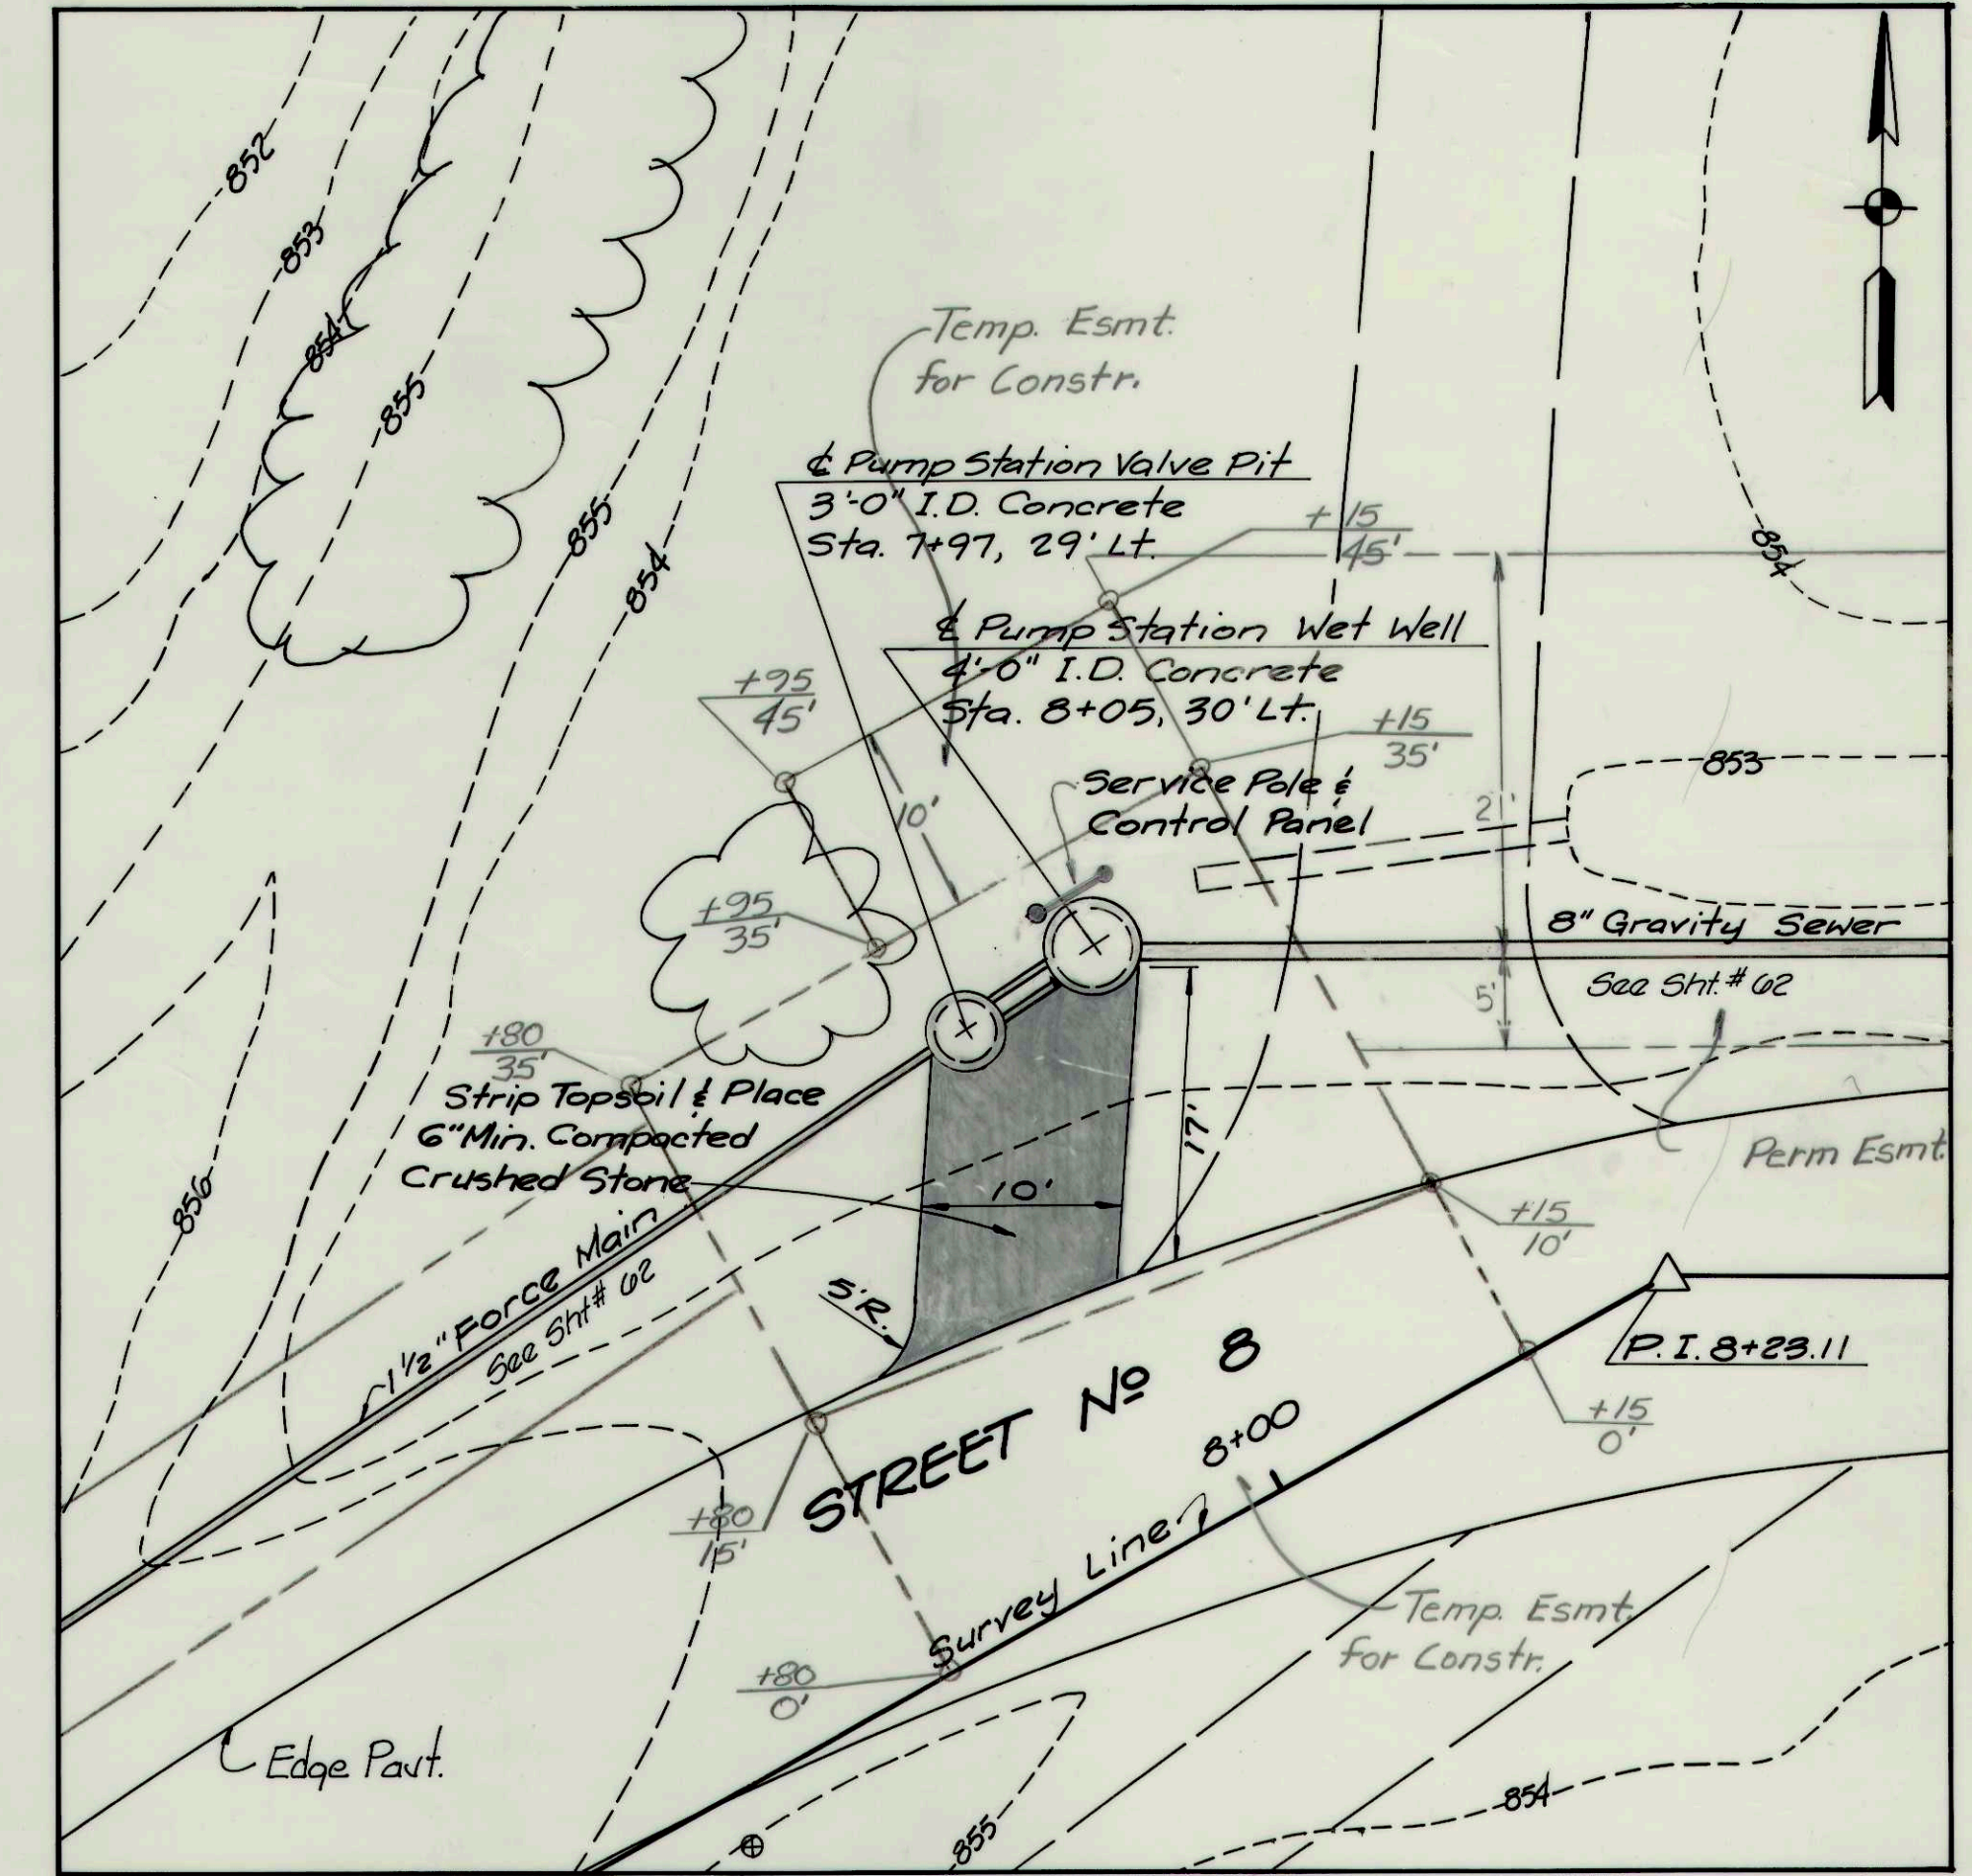


MERCERS ADD. L.S.

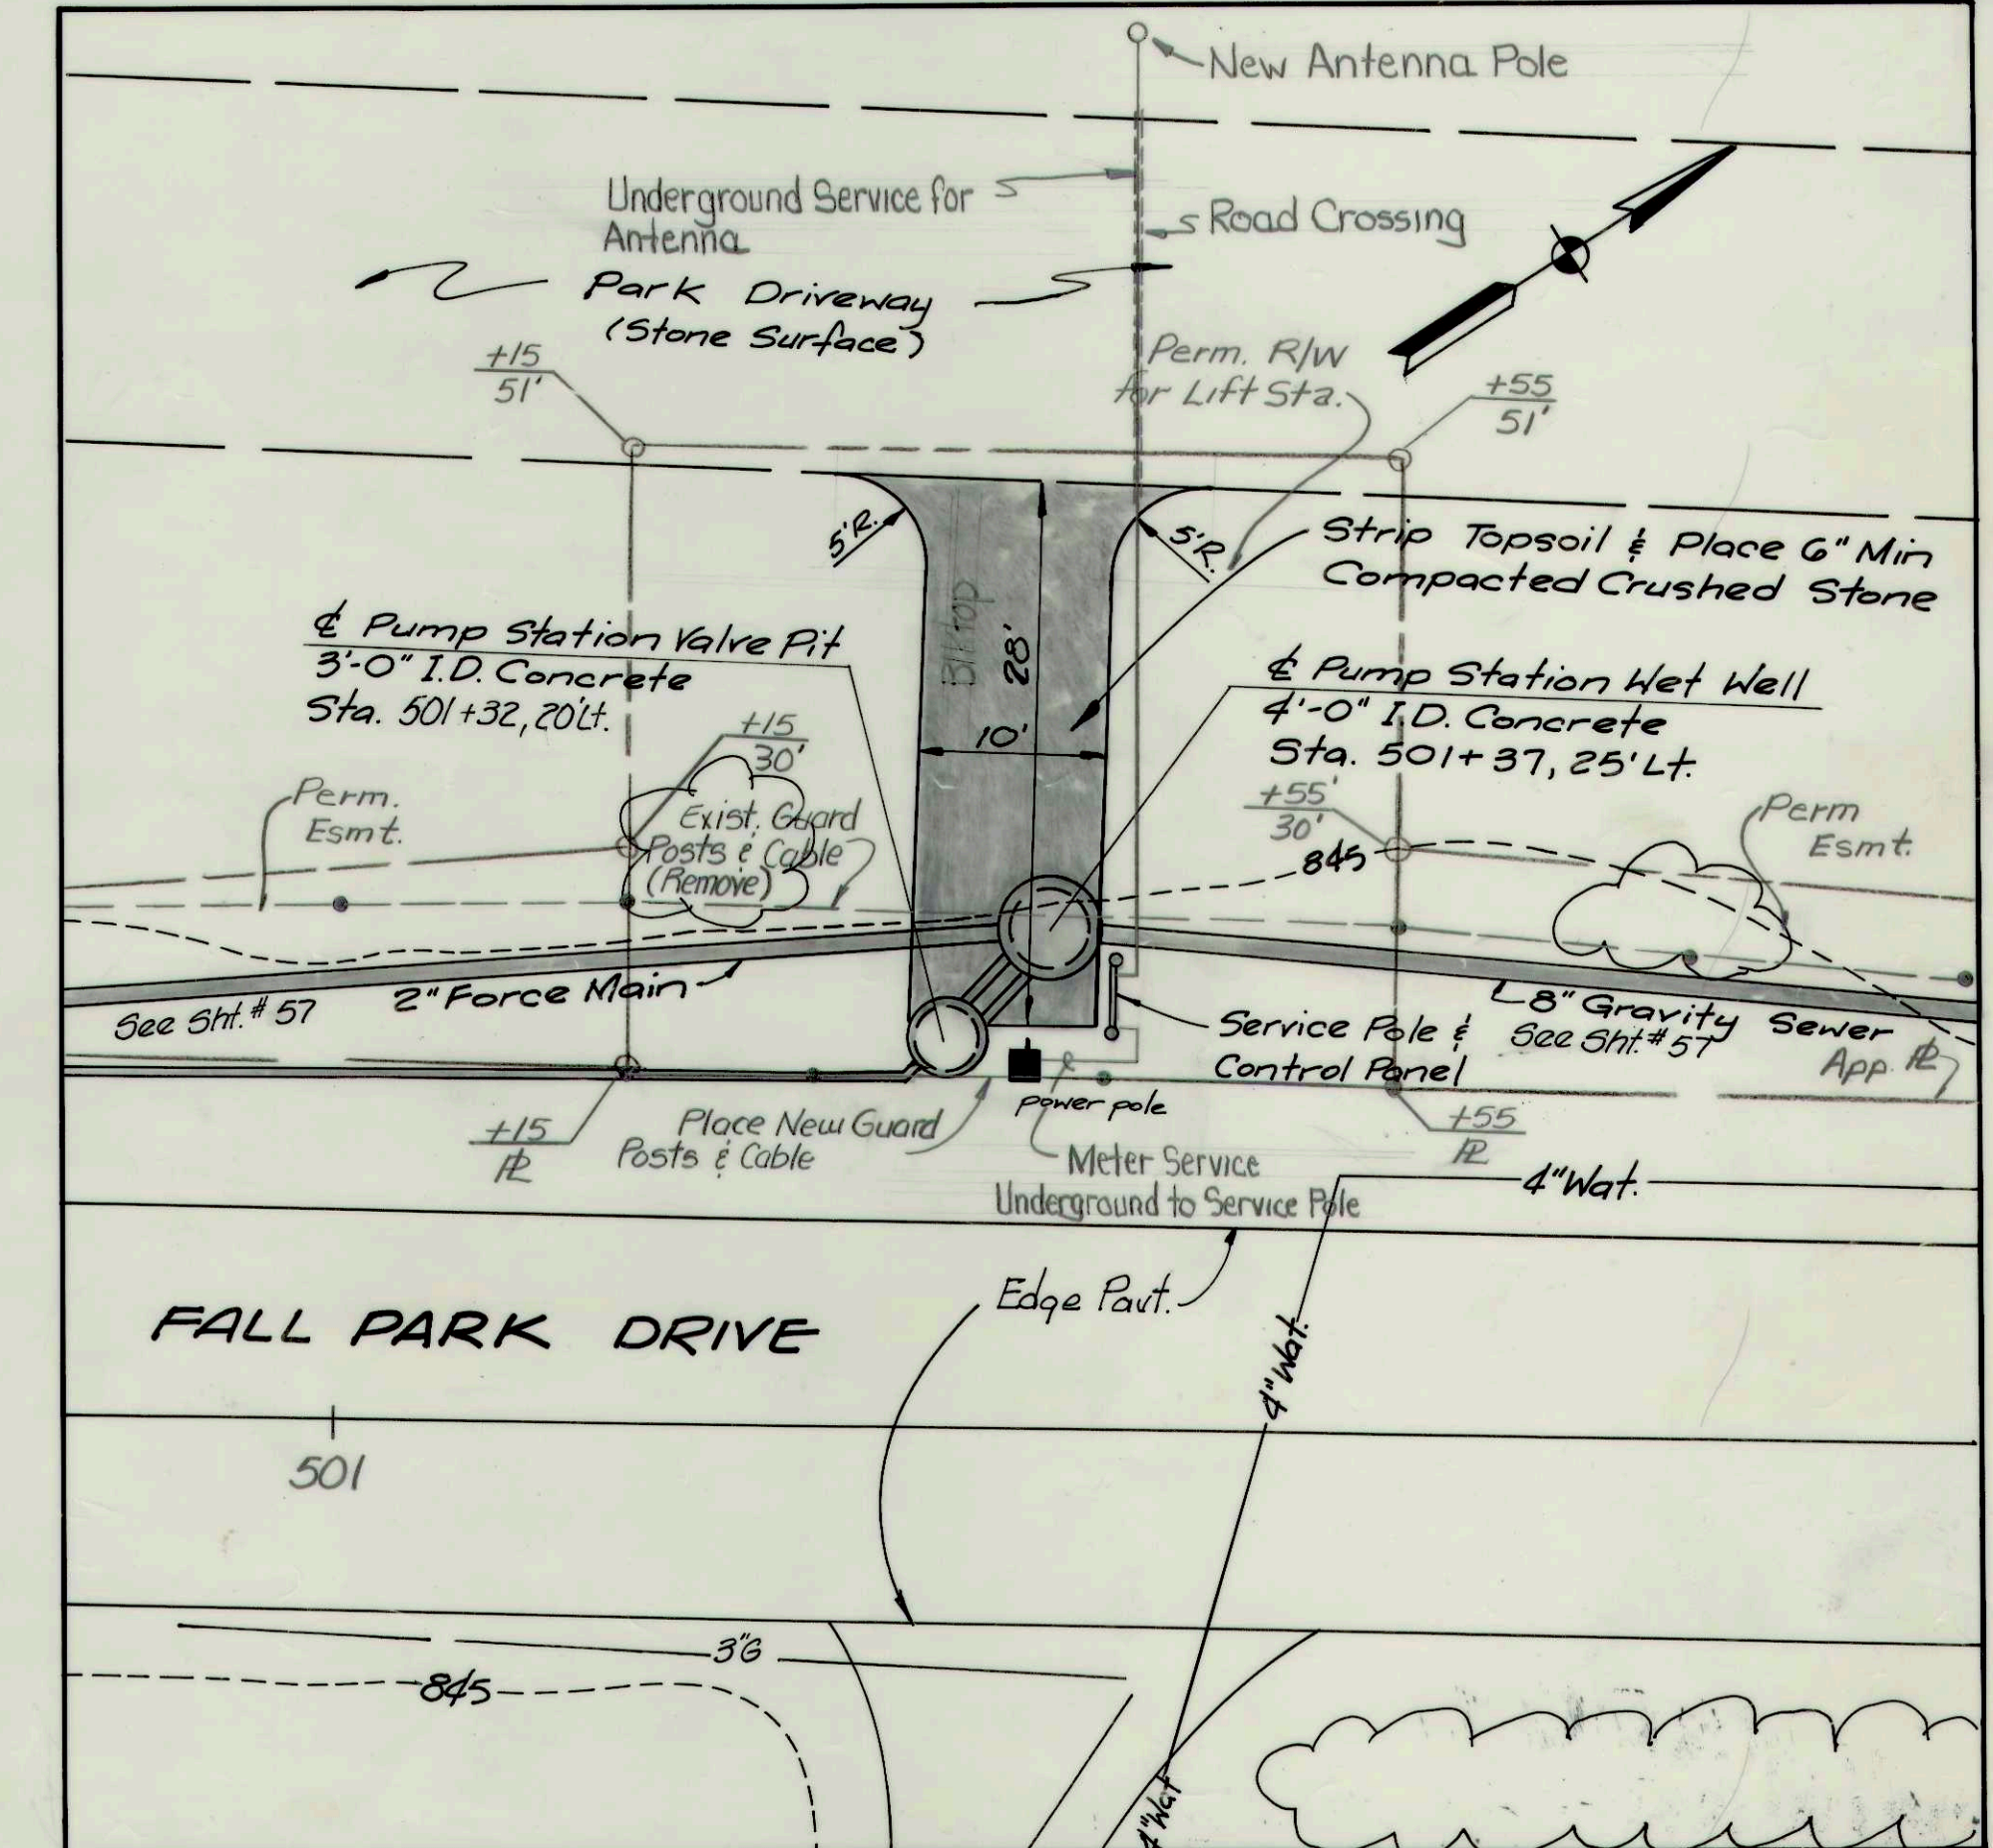

FALL PARK DRIVE L.S.

REVISED 3-19-84
CHANGED ESMT. AROUND
S. PENDLETON AVE. LIFT
STATION

RECORD DRAWING

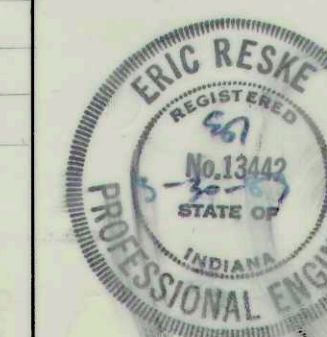

LIFT STATION LAYOUTS

Scale: 1"=10'	FALL CREEK R.W.D.	Sheet
Drawn By: VMS.	BEAM, LONGEST & NEFF	66
Designed By: GDL.	Consulting Engineers	
Certified By: ER.	8136 Castleton Road	
	Indianapolis, IN 46250	