




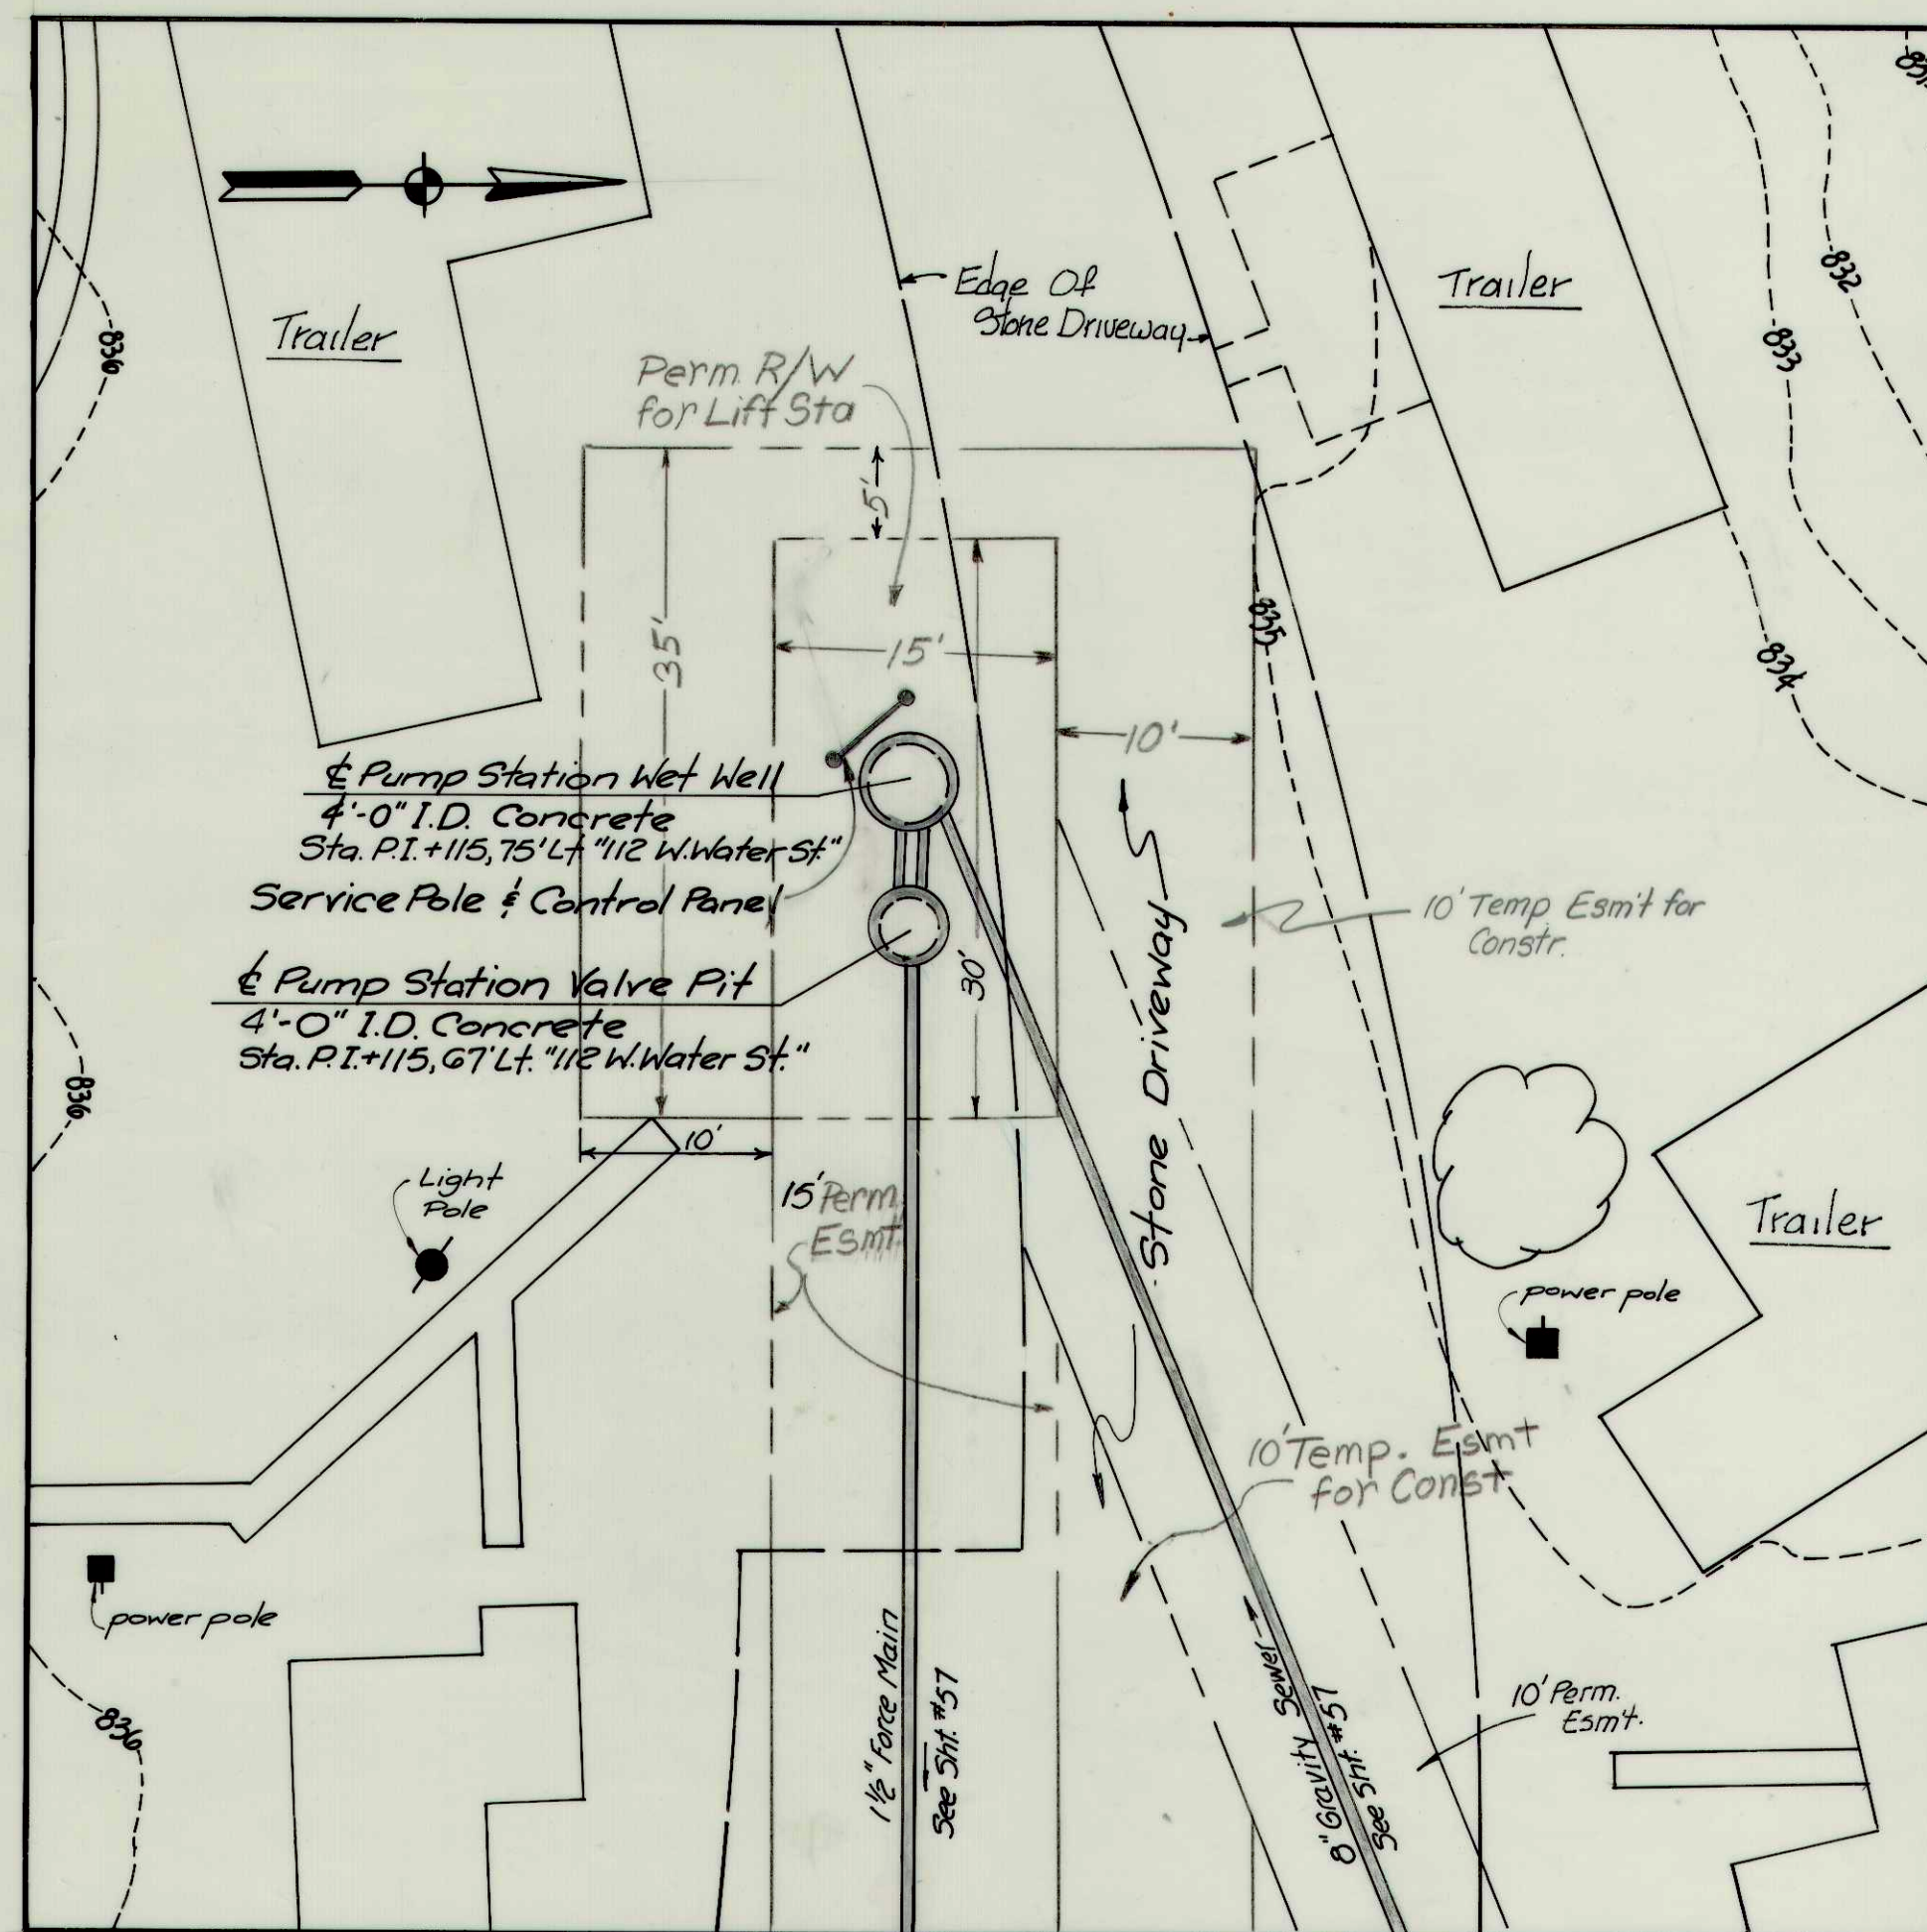



112 W. WATER ST. L.S.

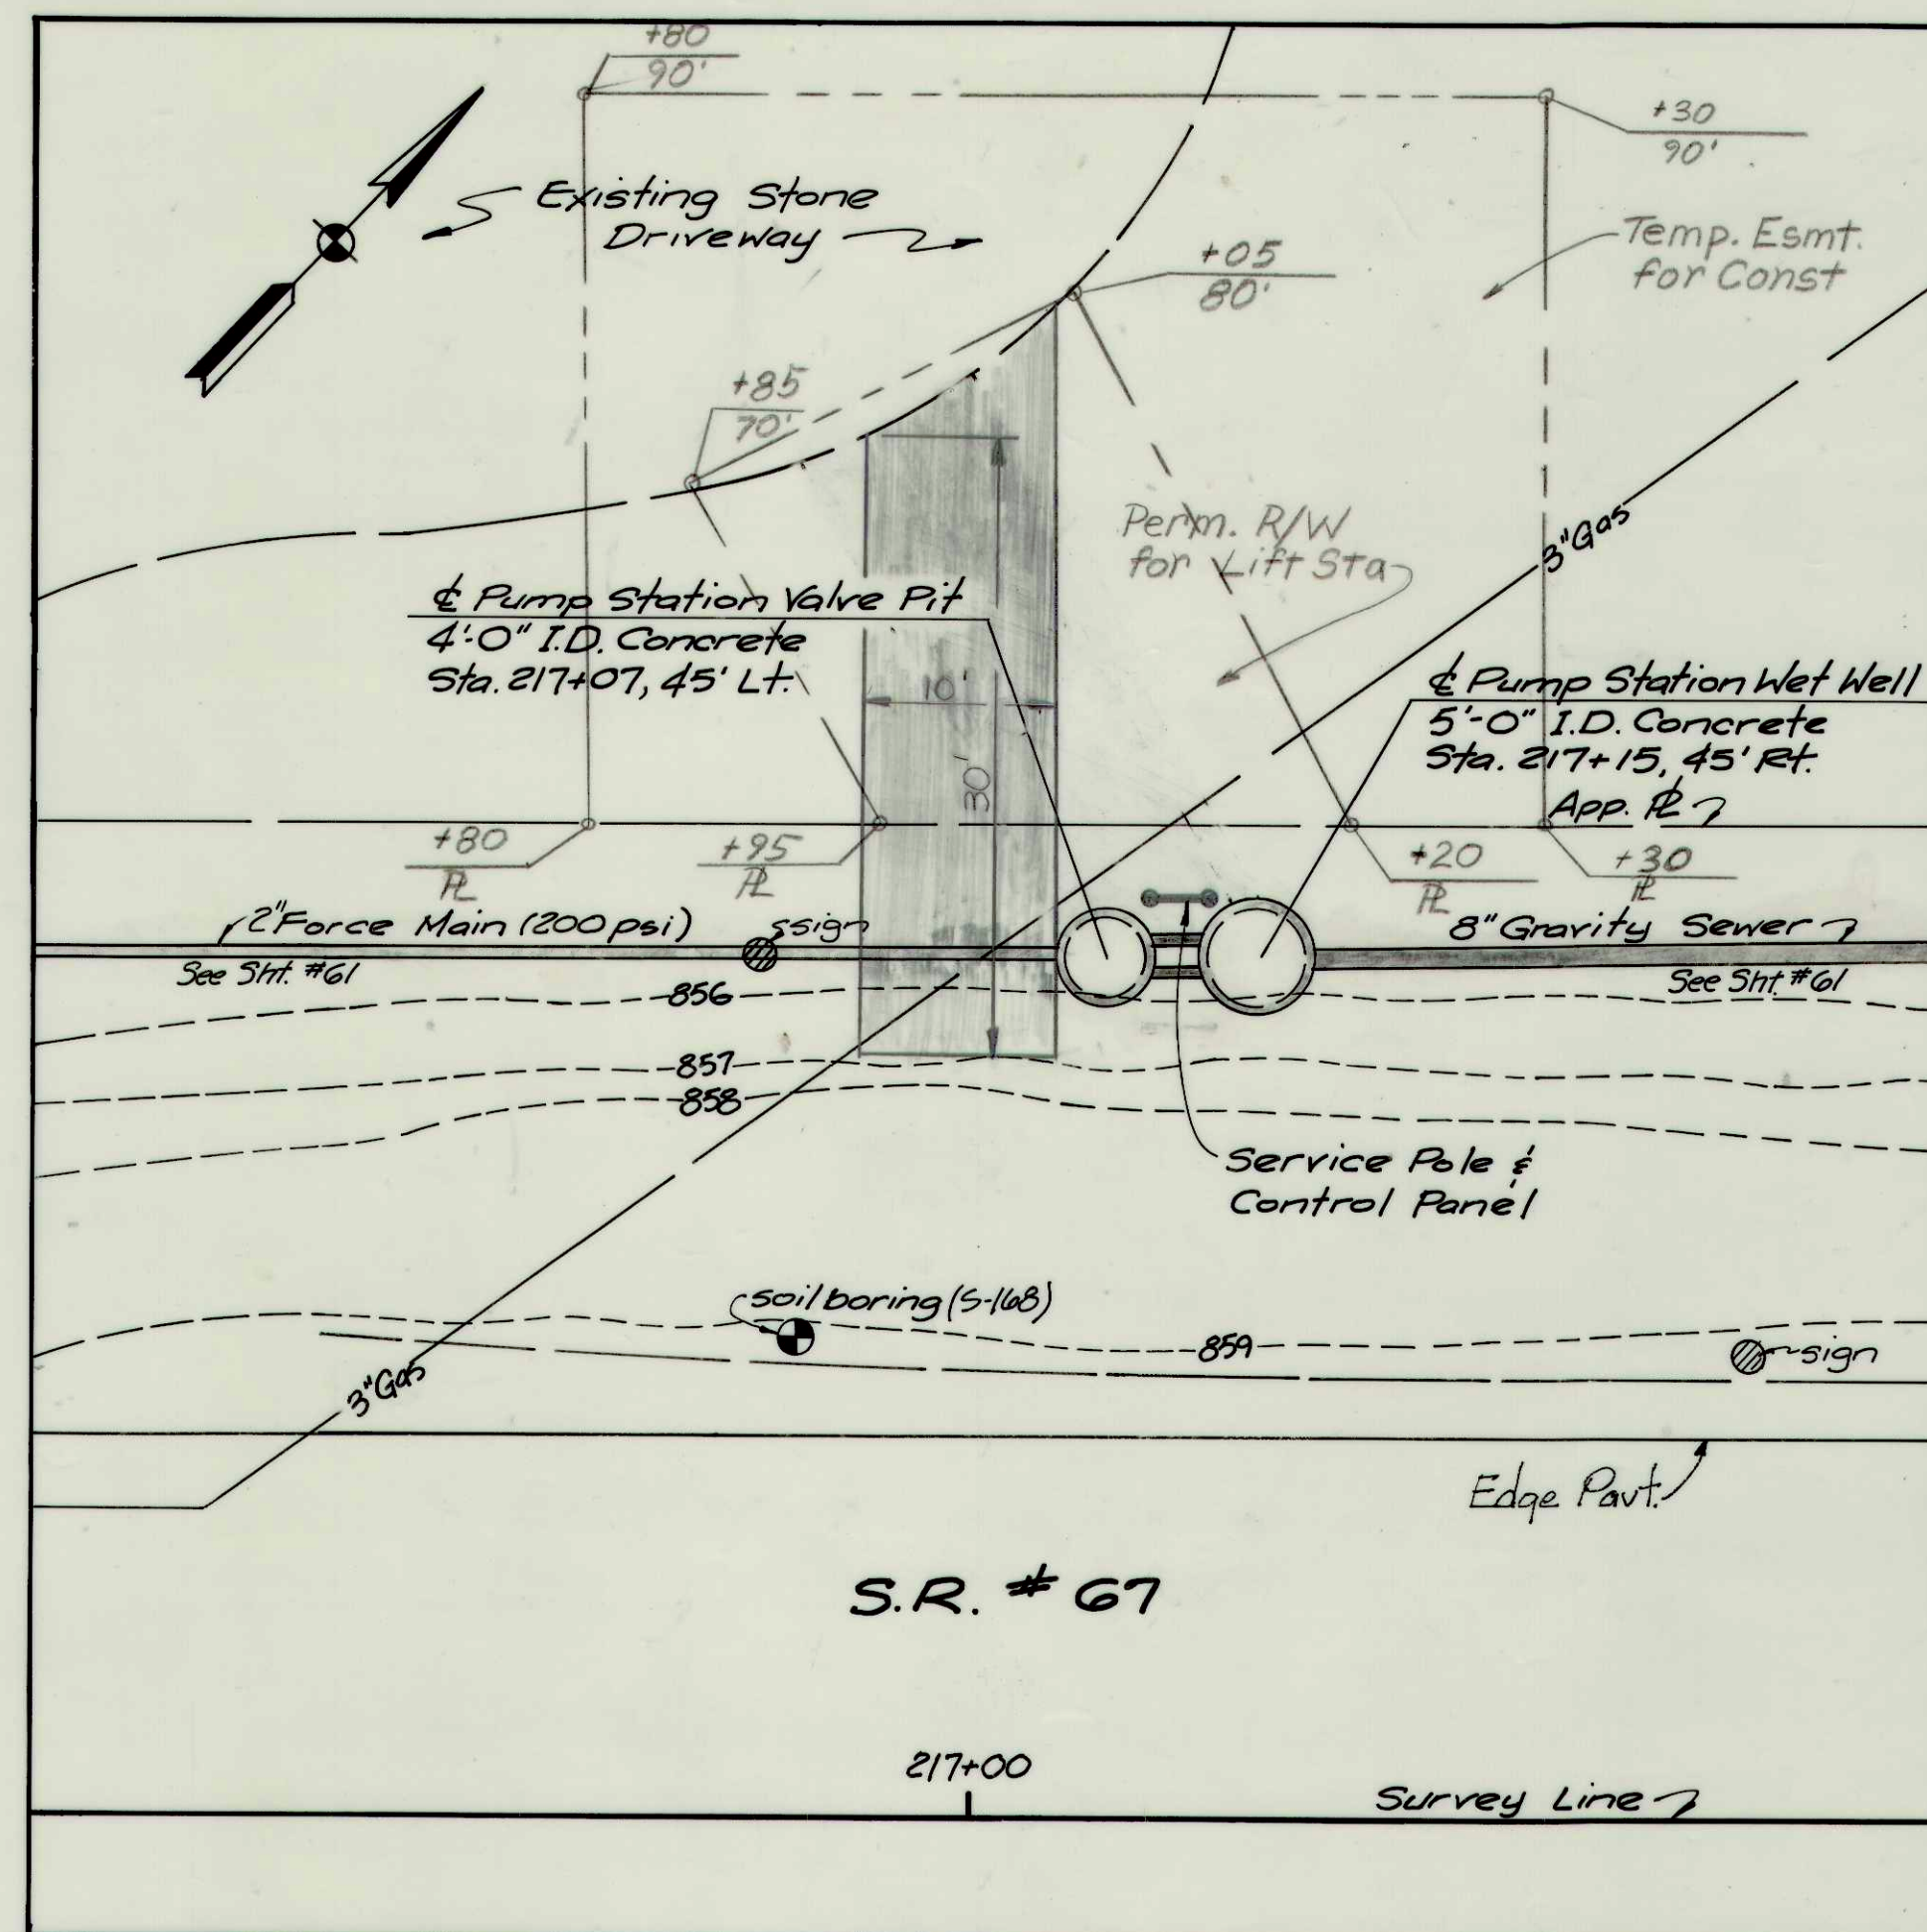

S.R. #67 L.S.

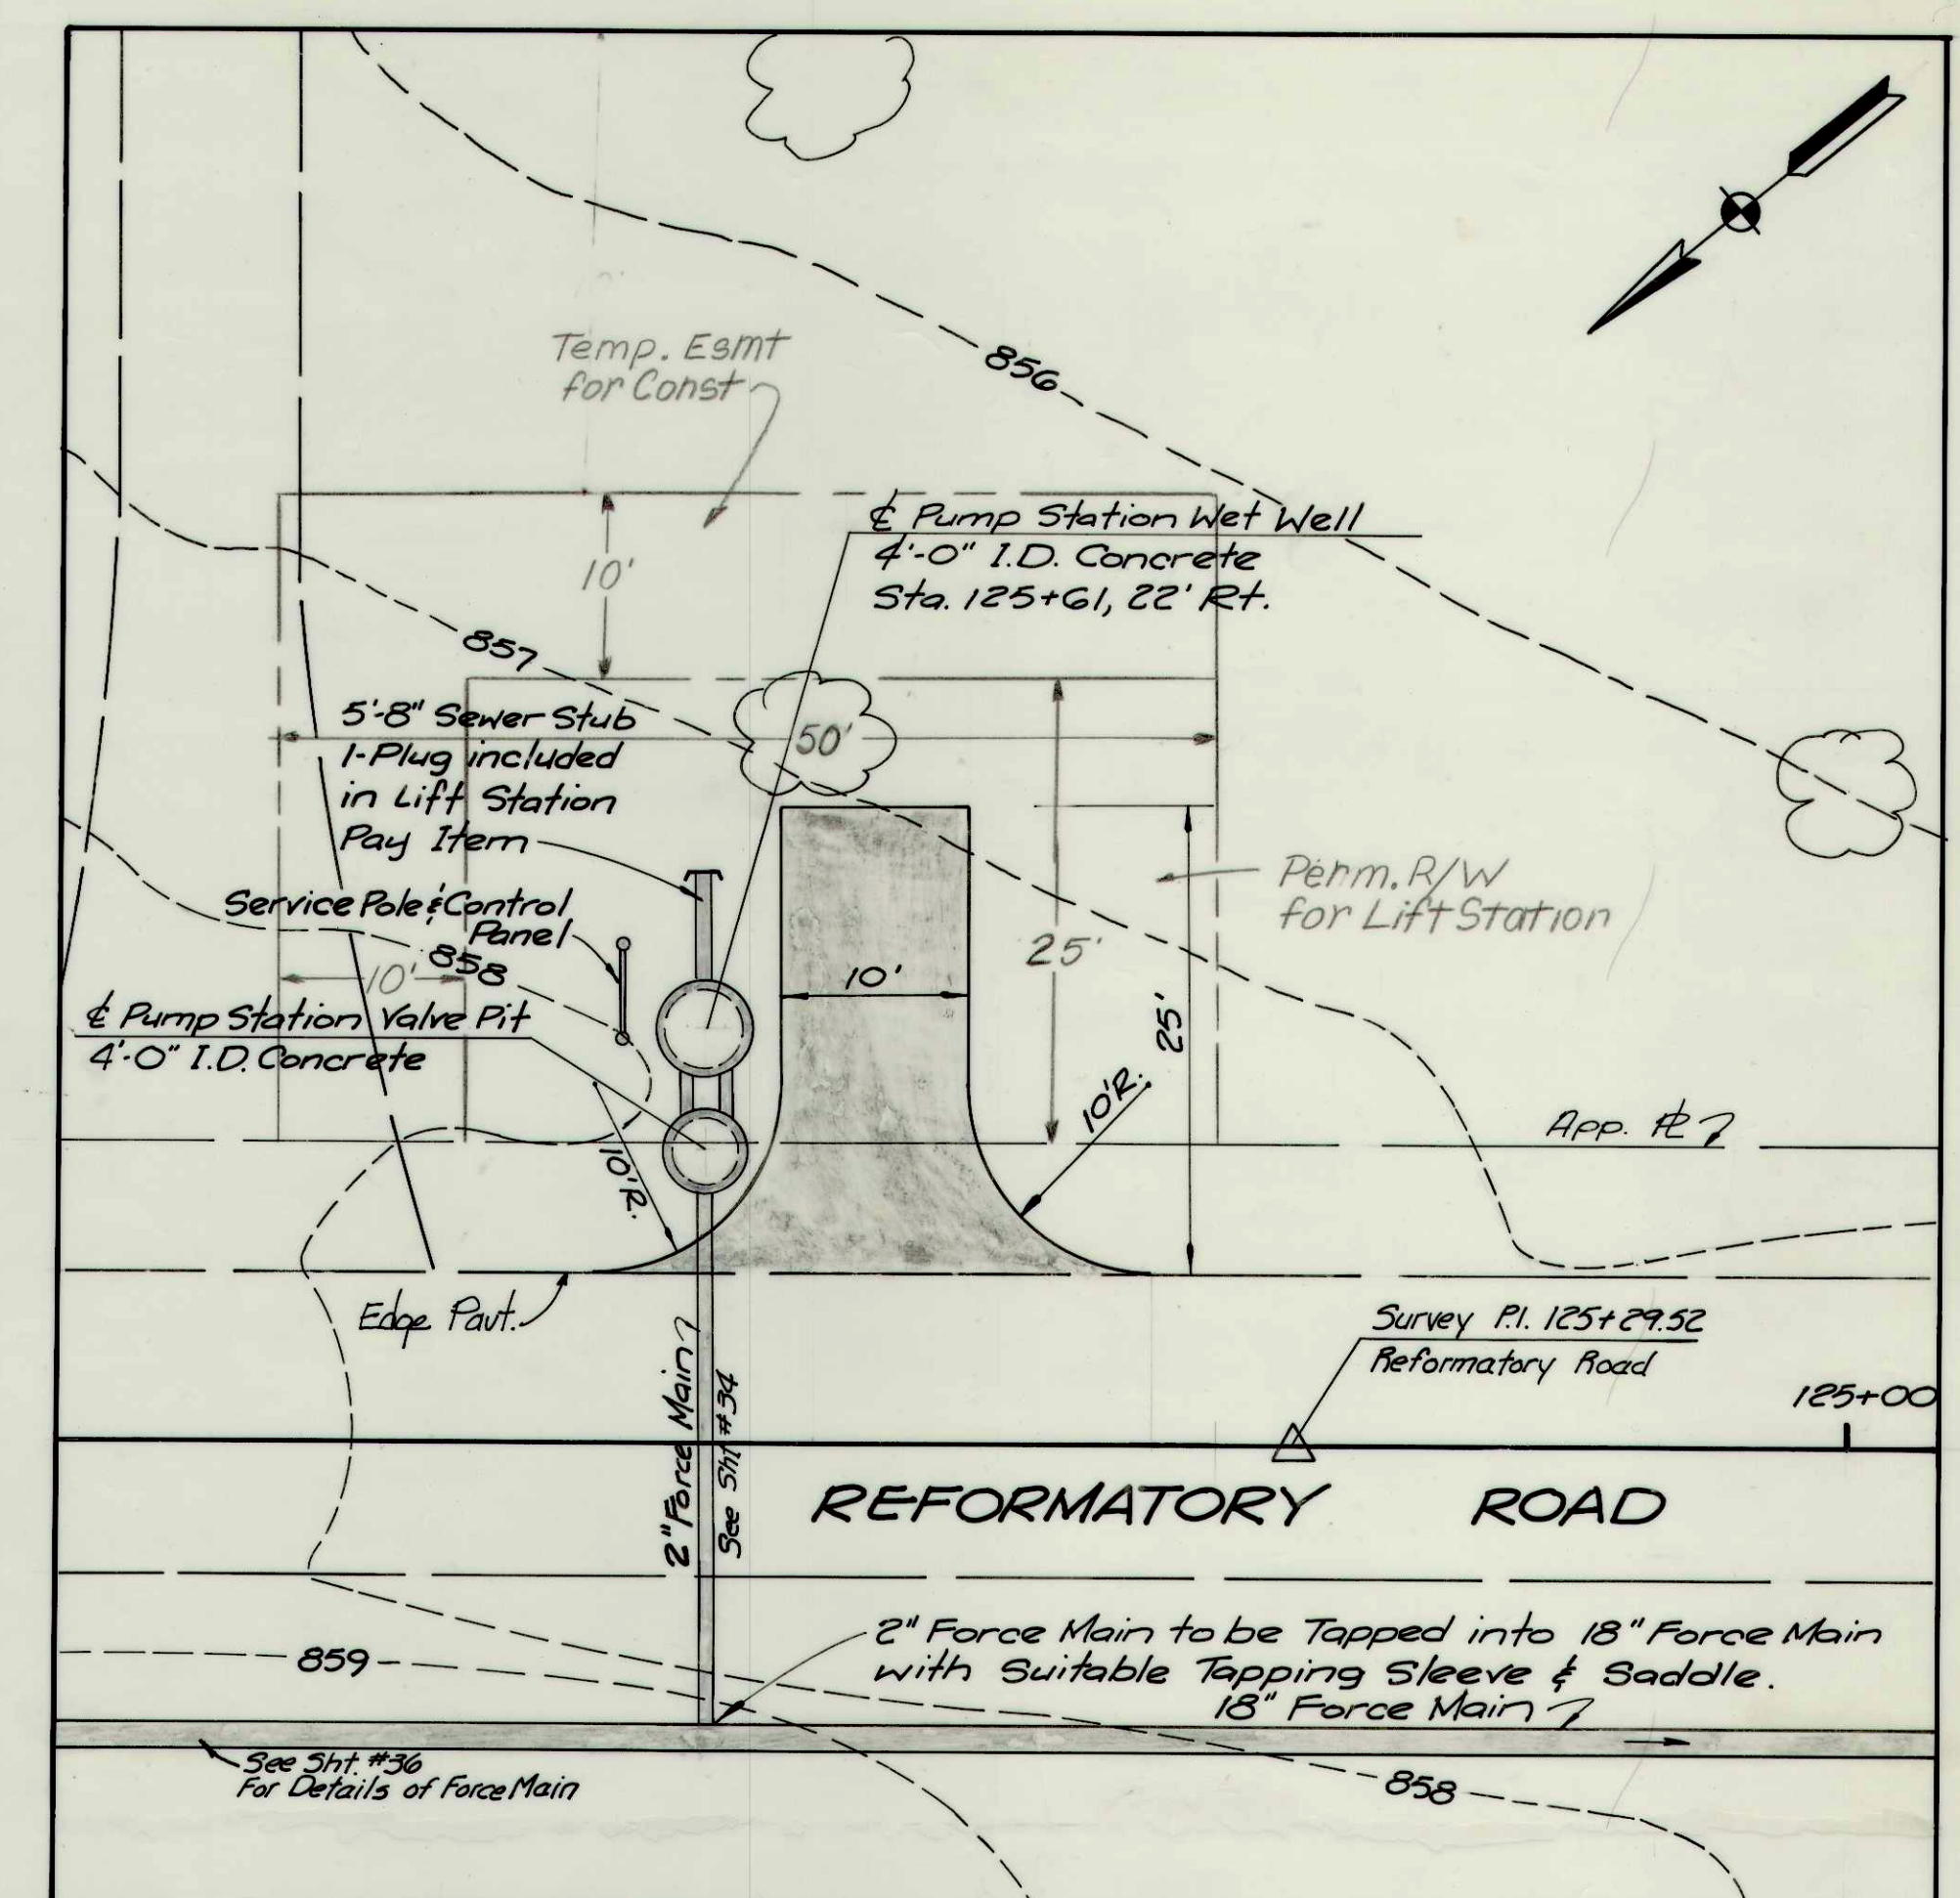

N.E. - M.H.P. L.S.

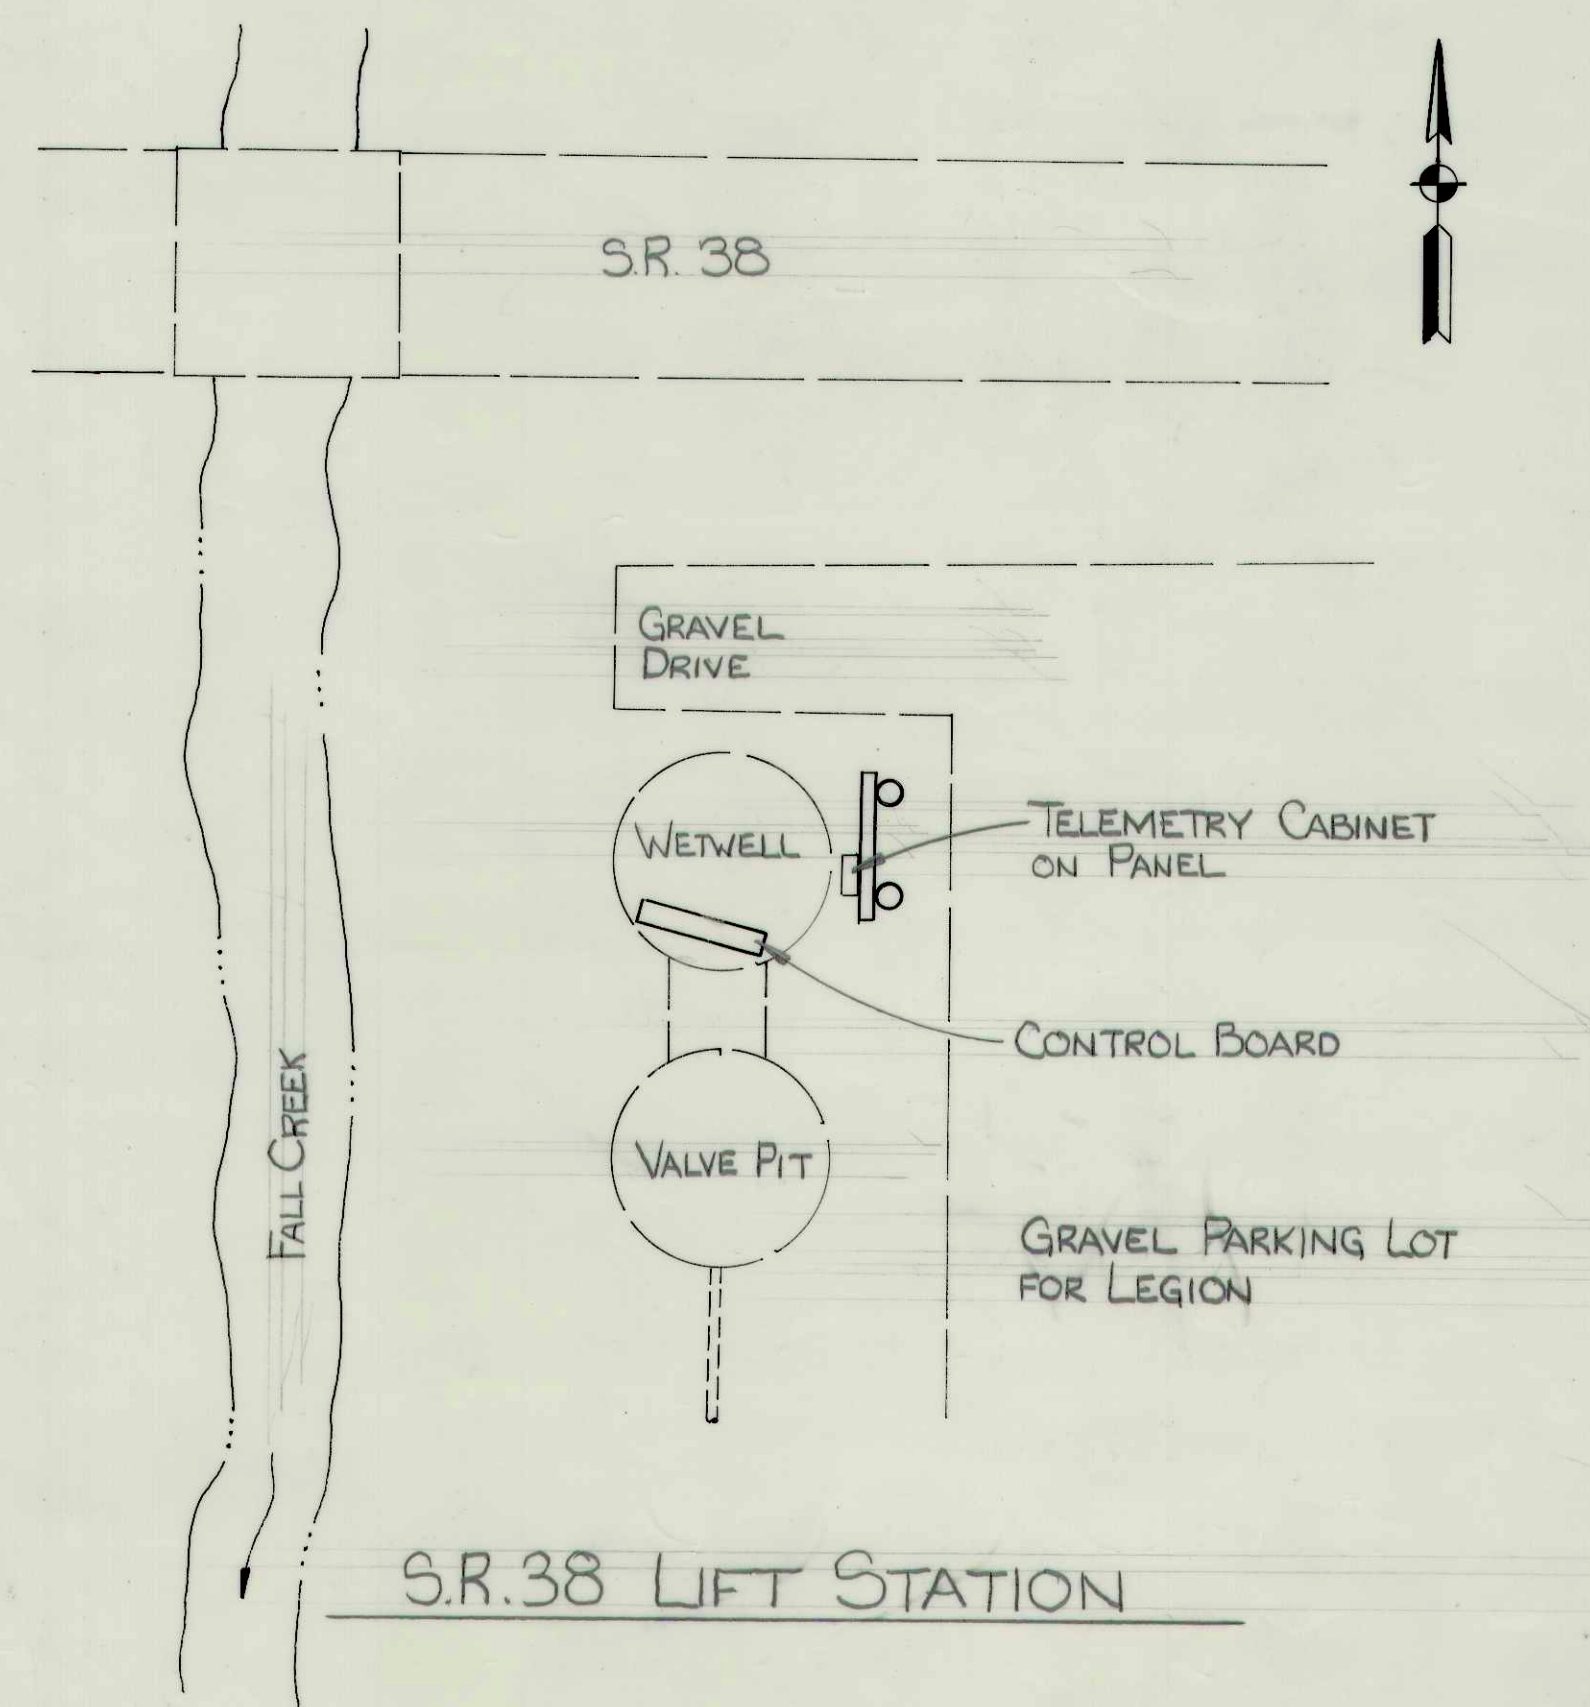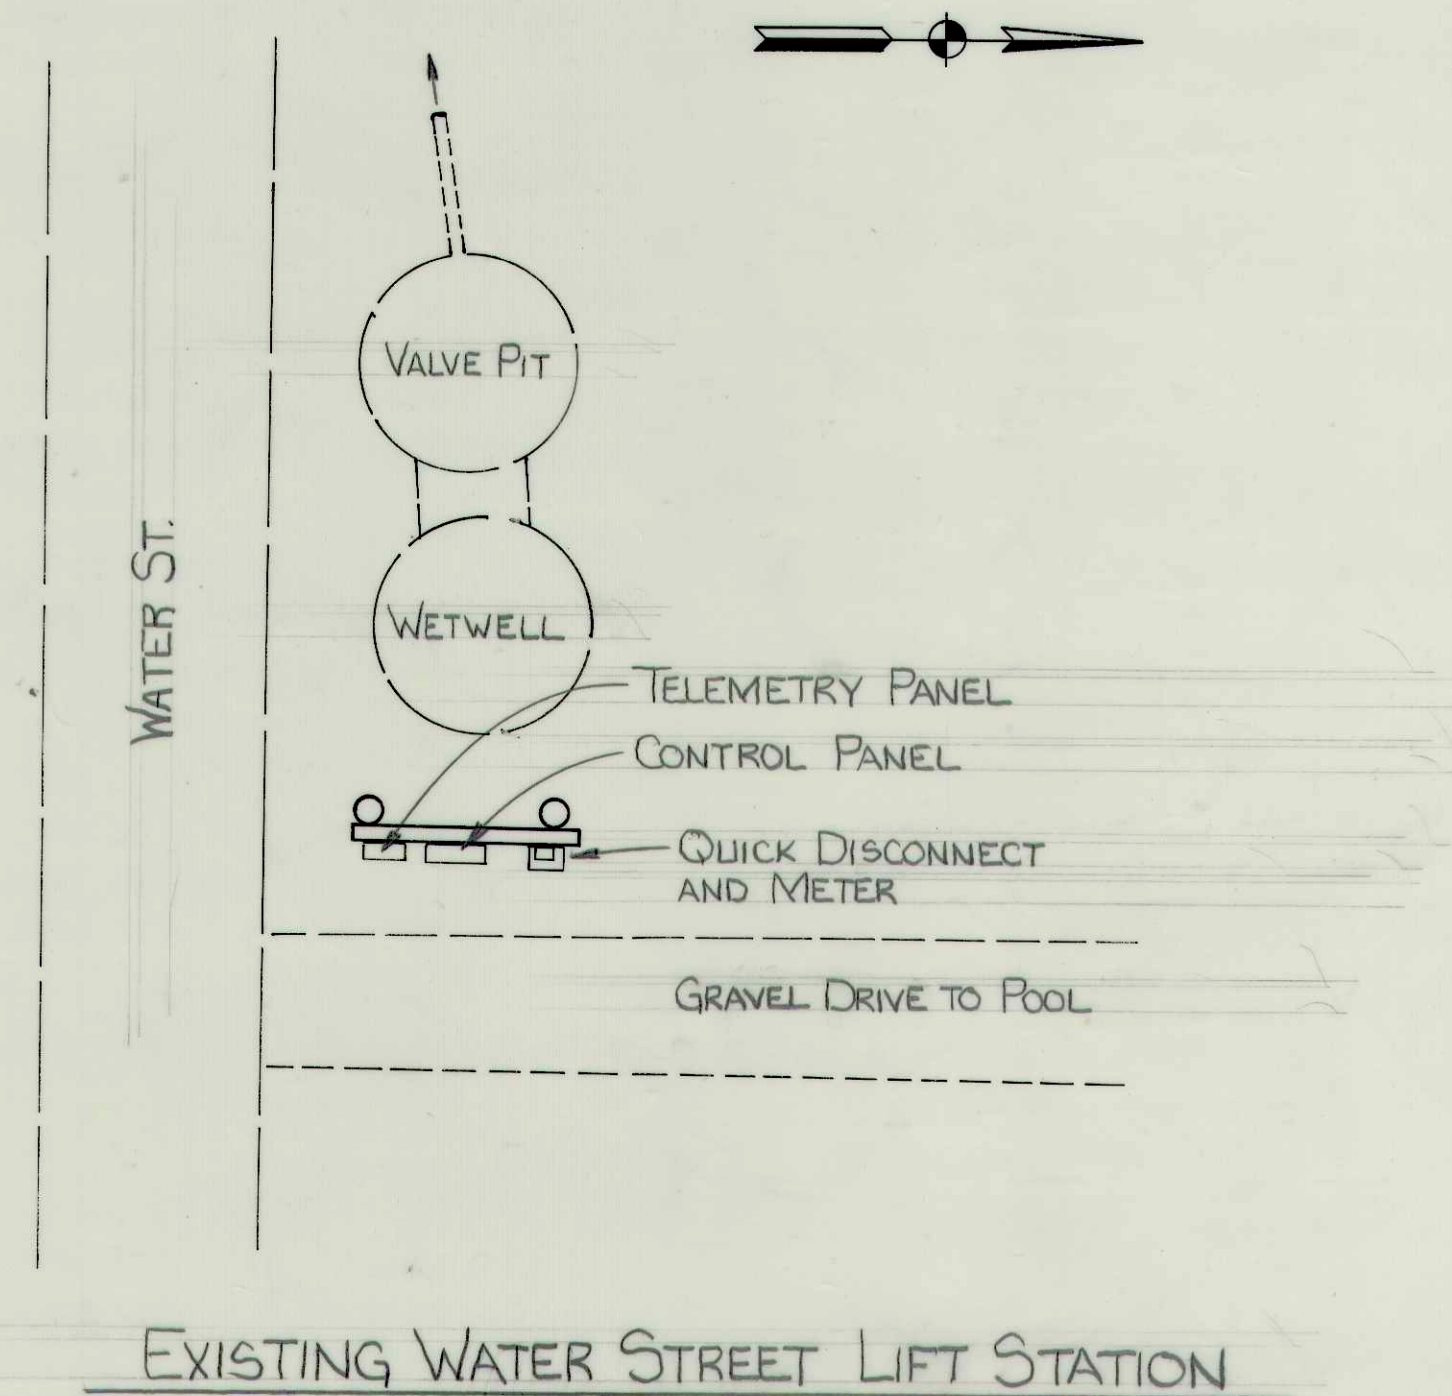

RECORD DRAWING

LIFT STATION LAYOUTS		
Scale: 1"=10'	FALL CREEK R.W.D.	Sheet
Drawn By: VMS.	BEAM, LONGEST & NEFF Consulting Engineers 8136 Castleton Road Indianapolis In. 46250	67
Designed By: GOL SE		
Certified By: E.R.		