
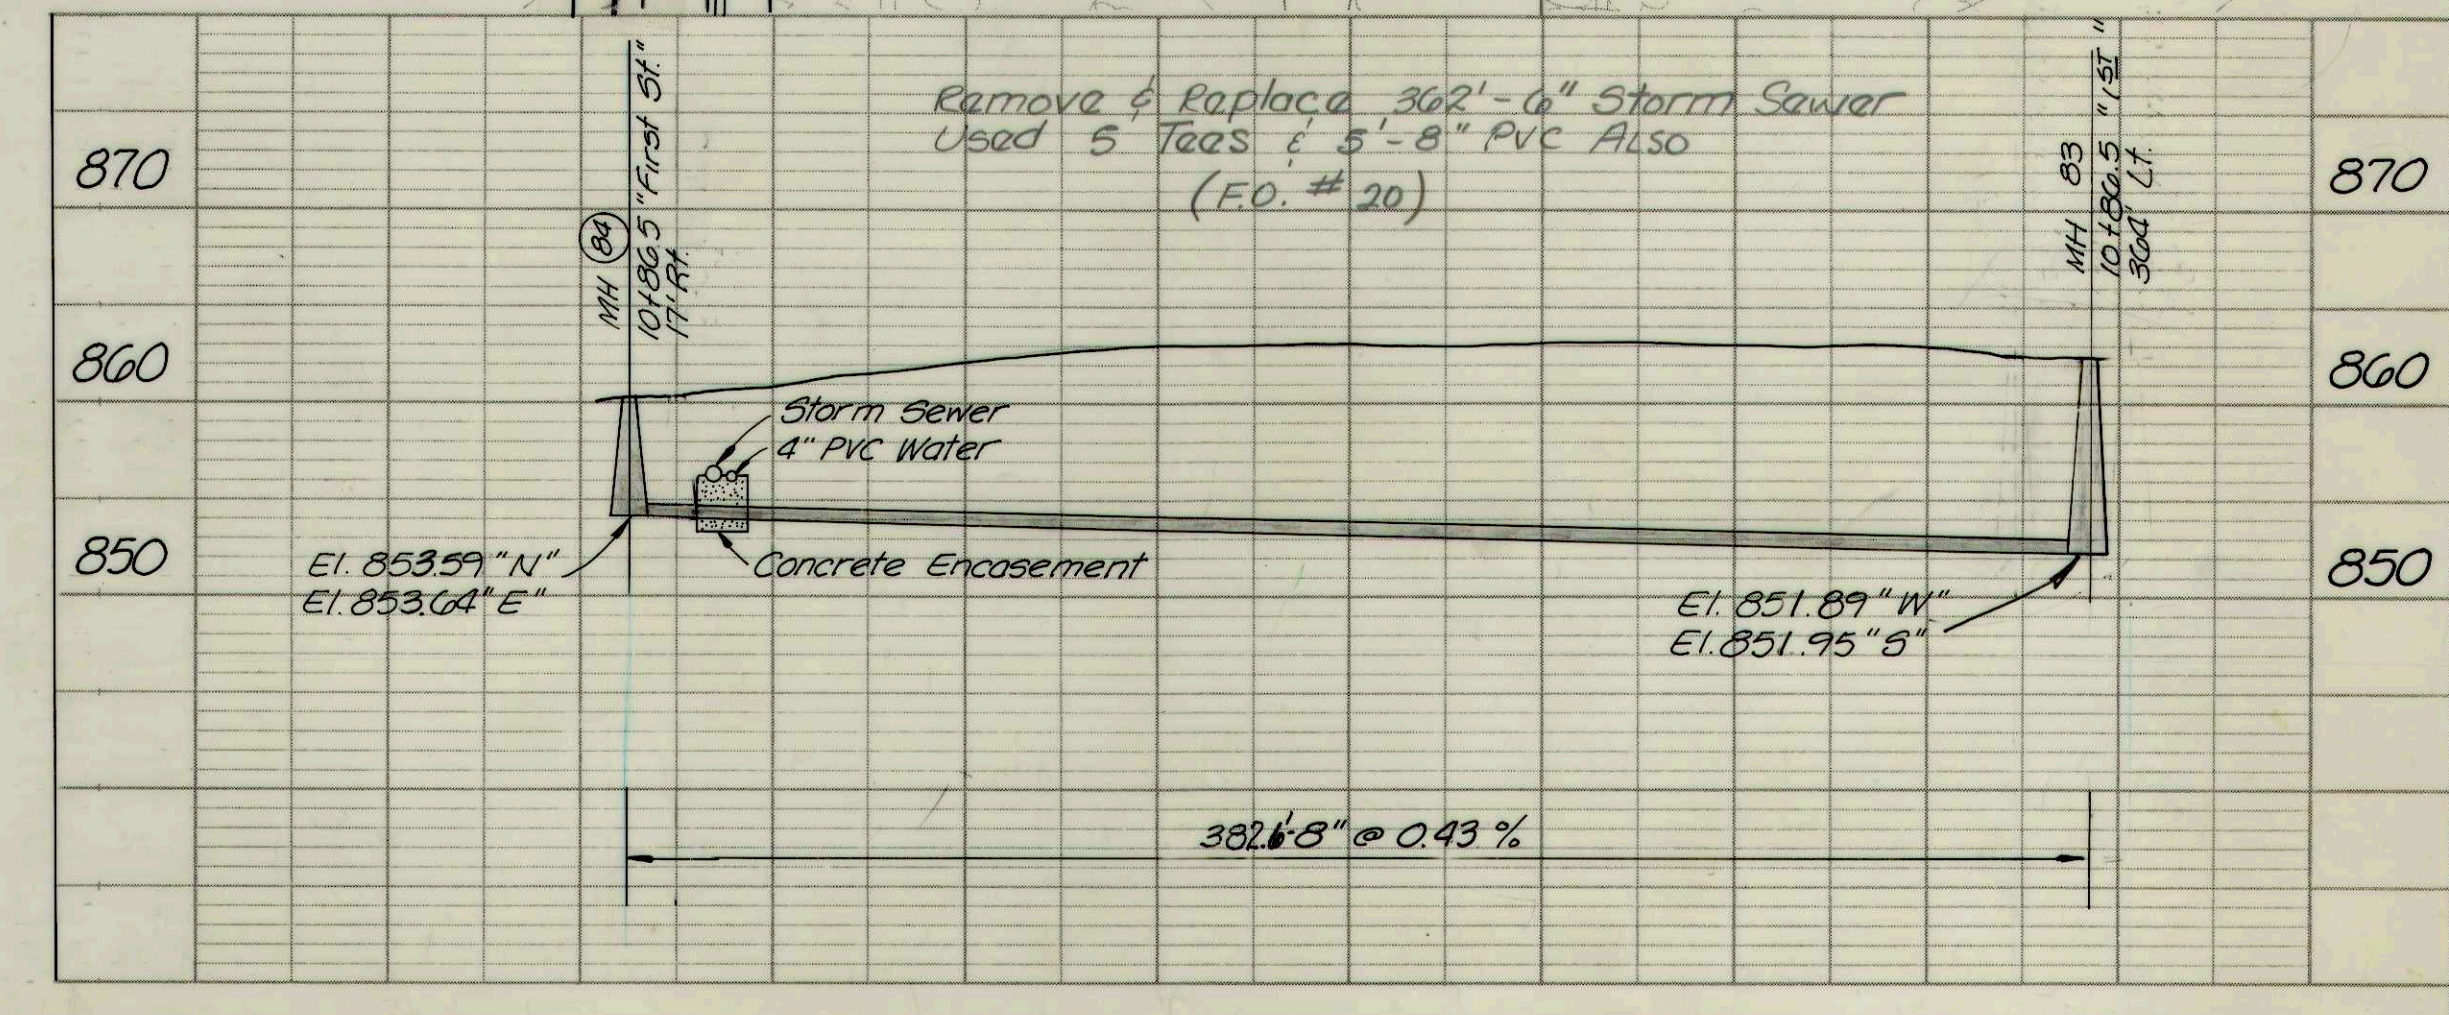
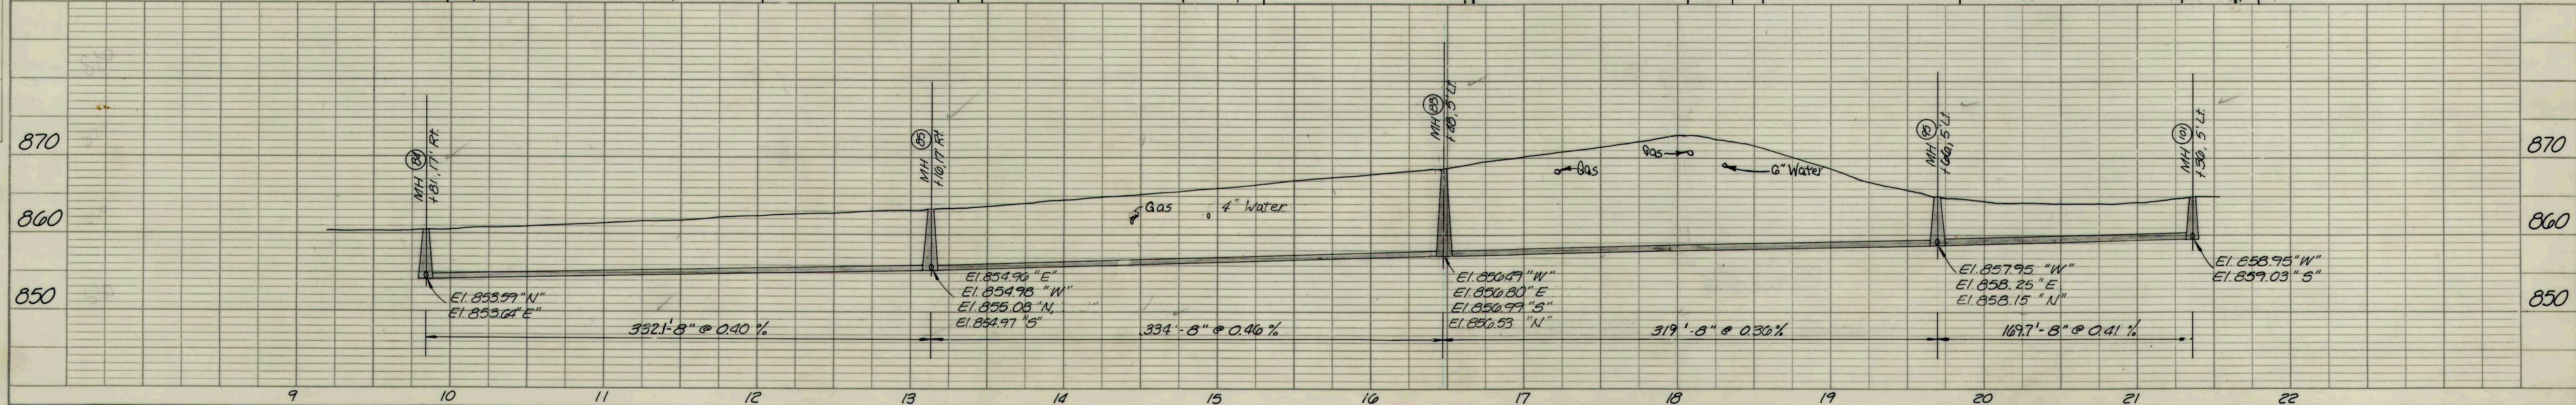


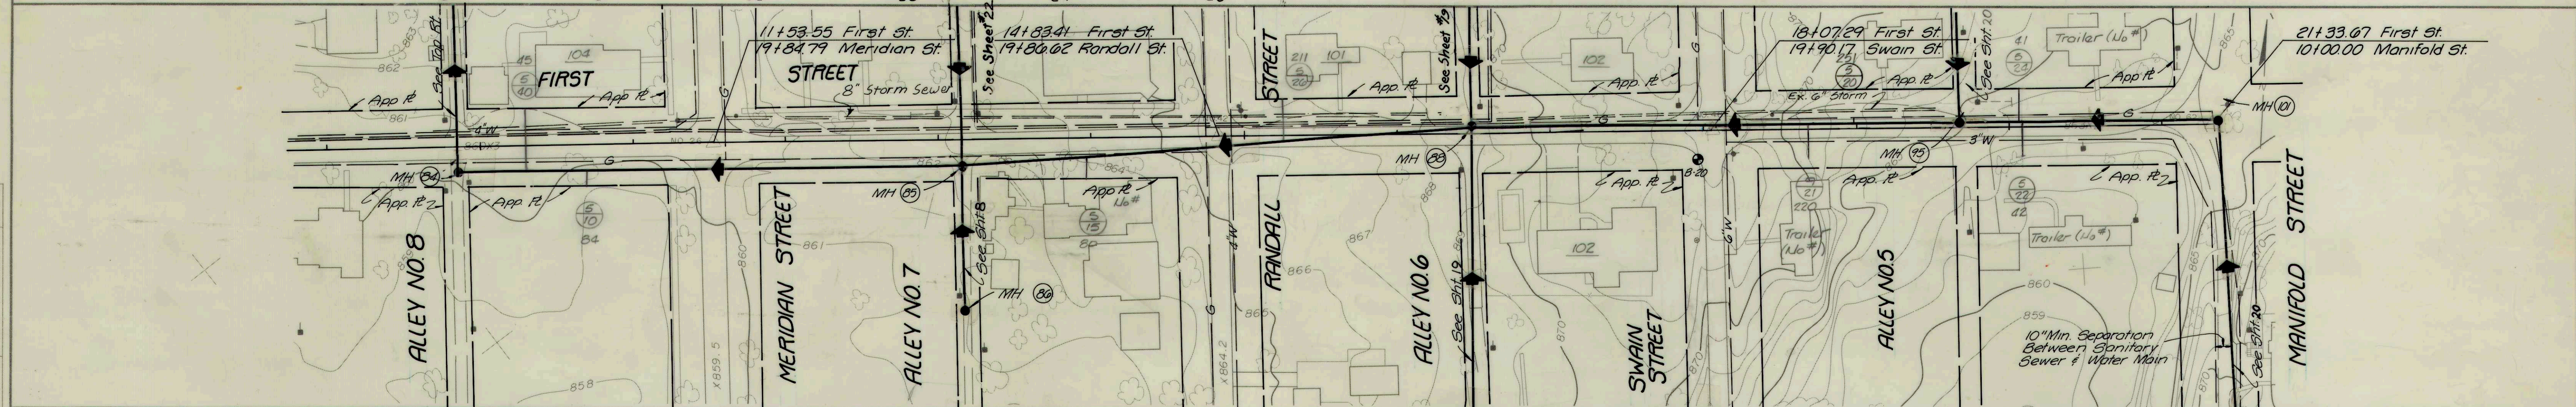

ERIC RESKE
REGISTERED
No. 13442
3-30-83
STATE OF
INDIANA
PROFESSIONAL ENGINEER

<i>ALFONTE ST. ALLEY #8</i> <i>FIRST ST.</i>		
FALL CREEK R.W.D. PLAN & PROFILE		SHEET
HORIZ. 1"=50'	BEAM, LONGEST & NEFF, INC. CONSULTING ENGINEERS INDIANAPOLIS, INDIANA	7
VERT. 1"=10'		