




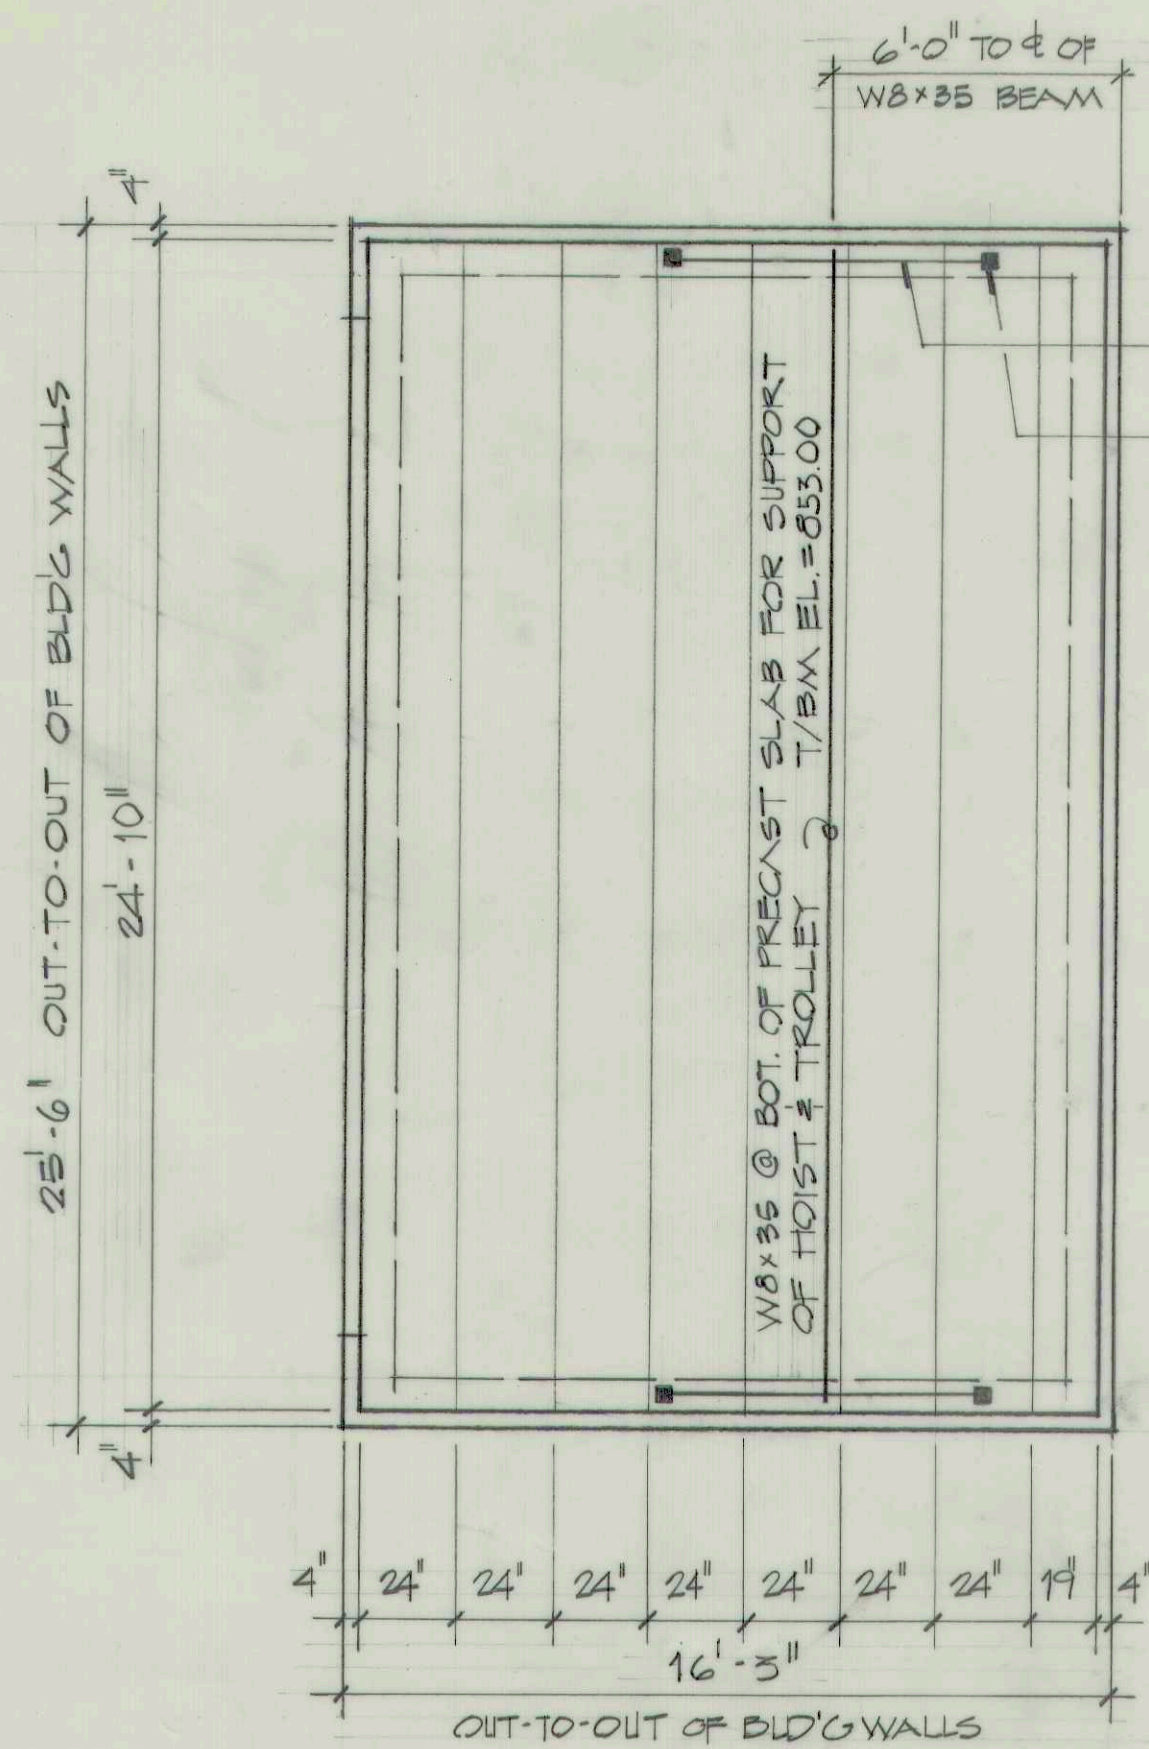


ROOF FRAMING PLAN
SCALE: 1/4" = 1'-0"

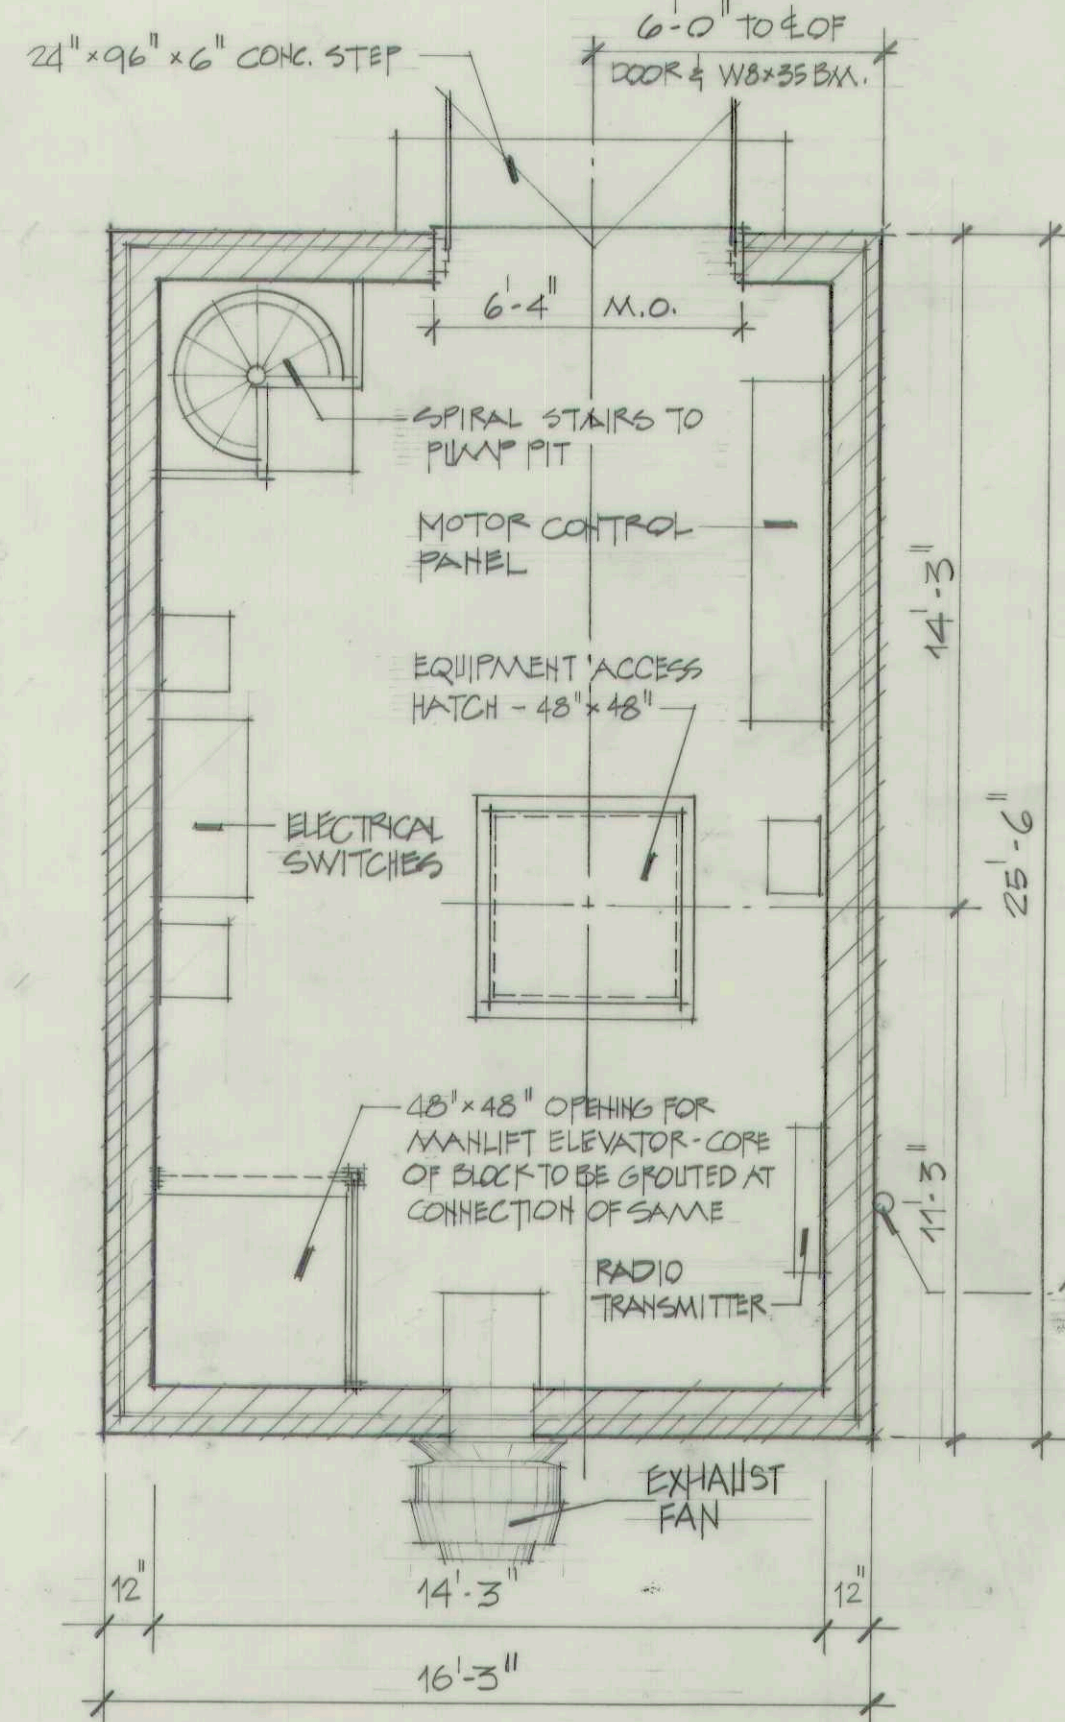


FLOOR PLAN
SCALE: 1/4" = 1'-0"

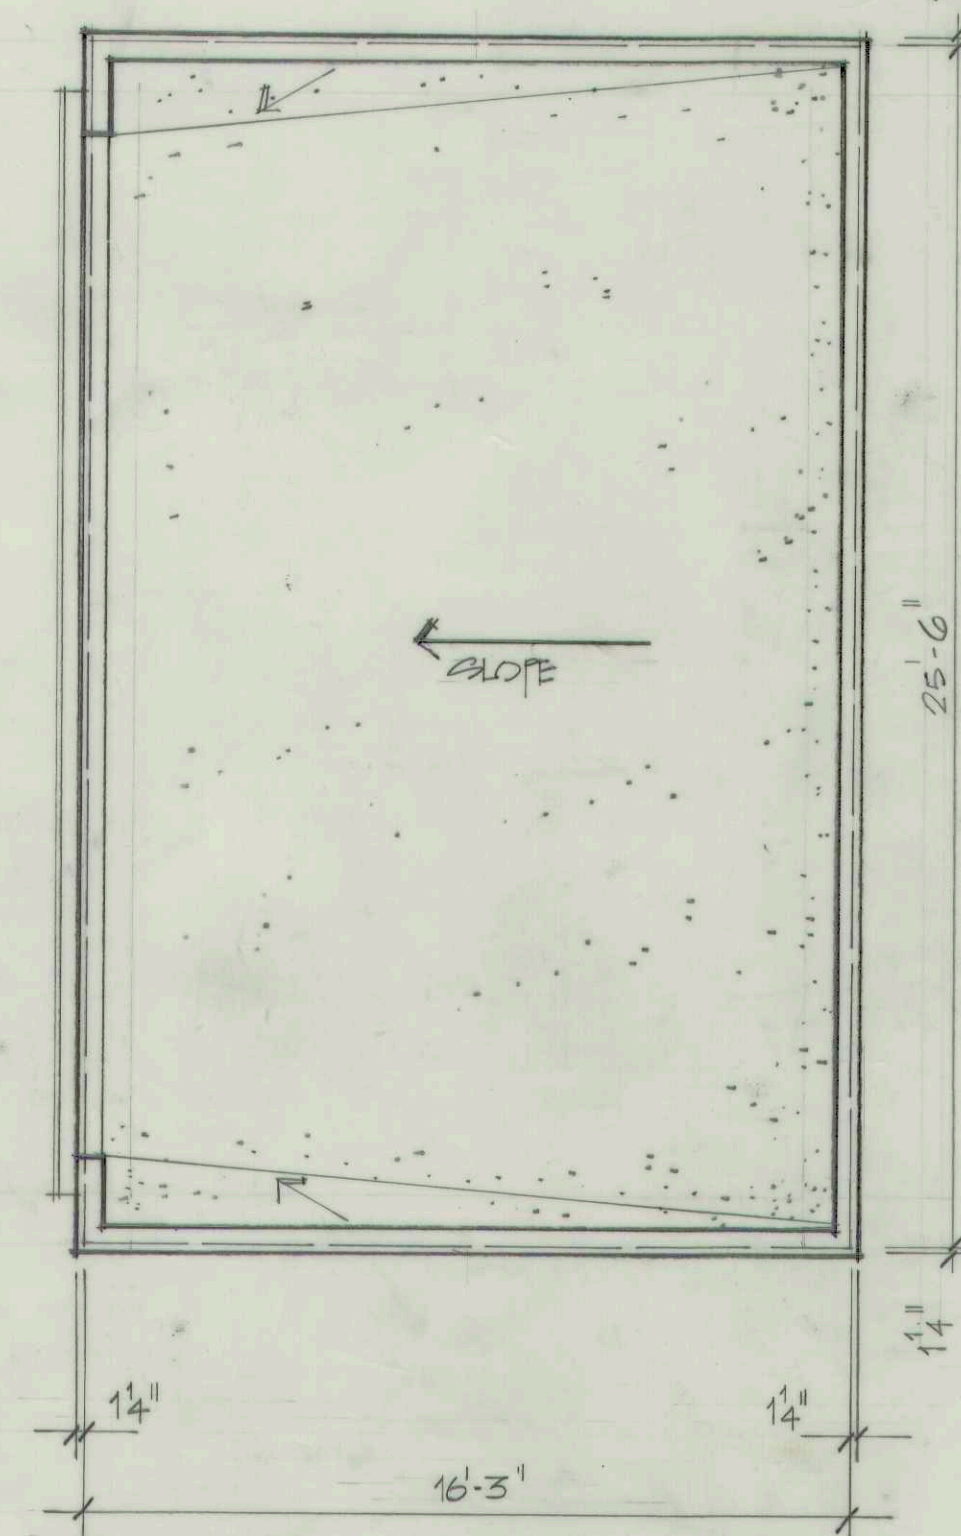


ROOF PLAN
SCALE: 1/4" = 1'-0"

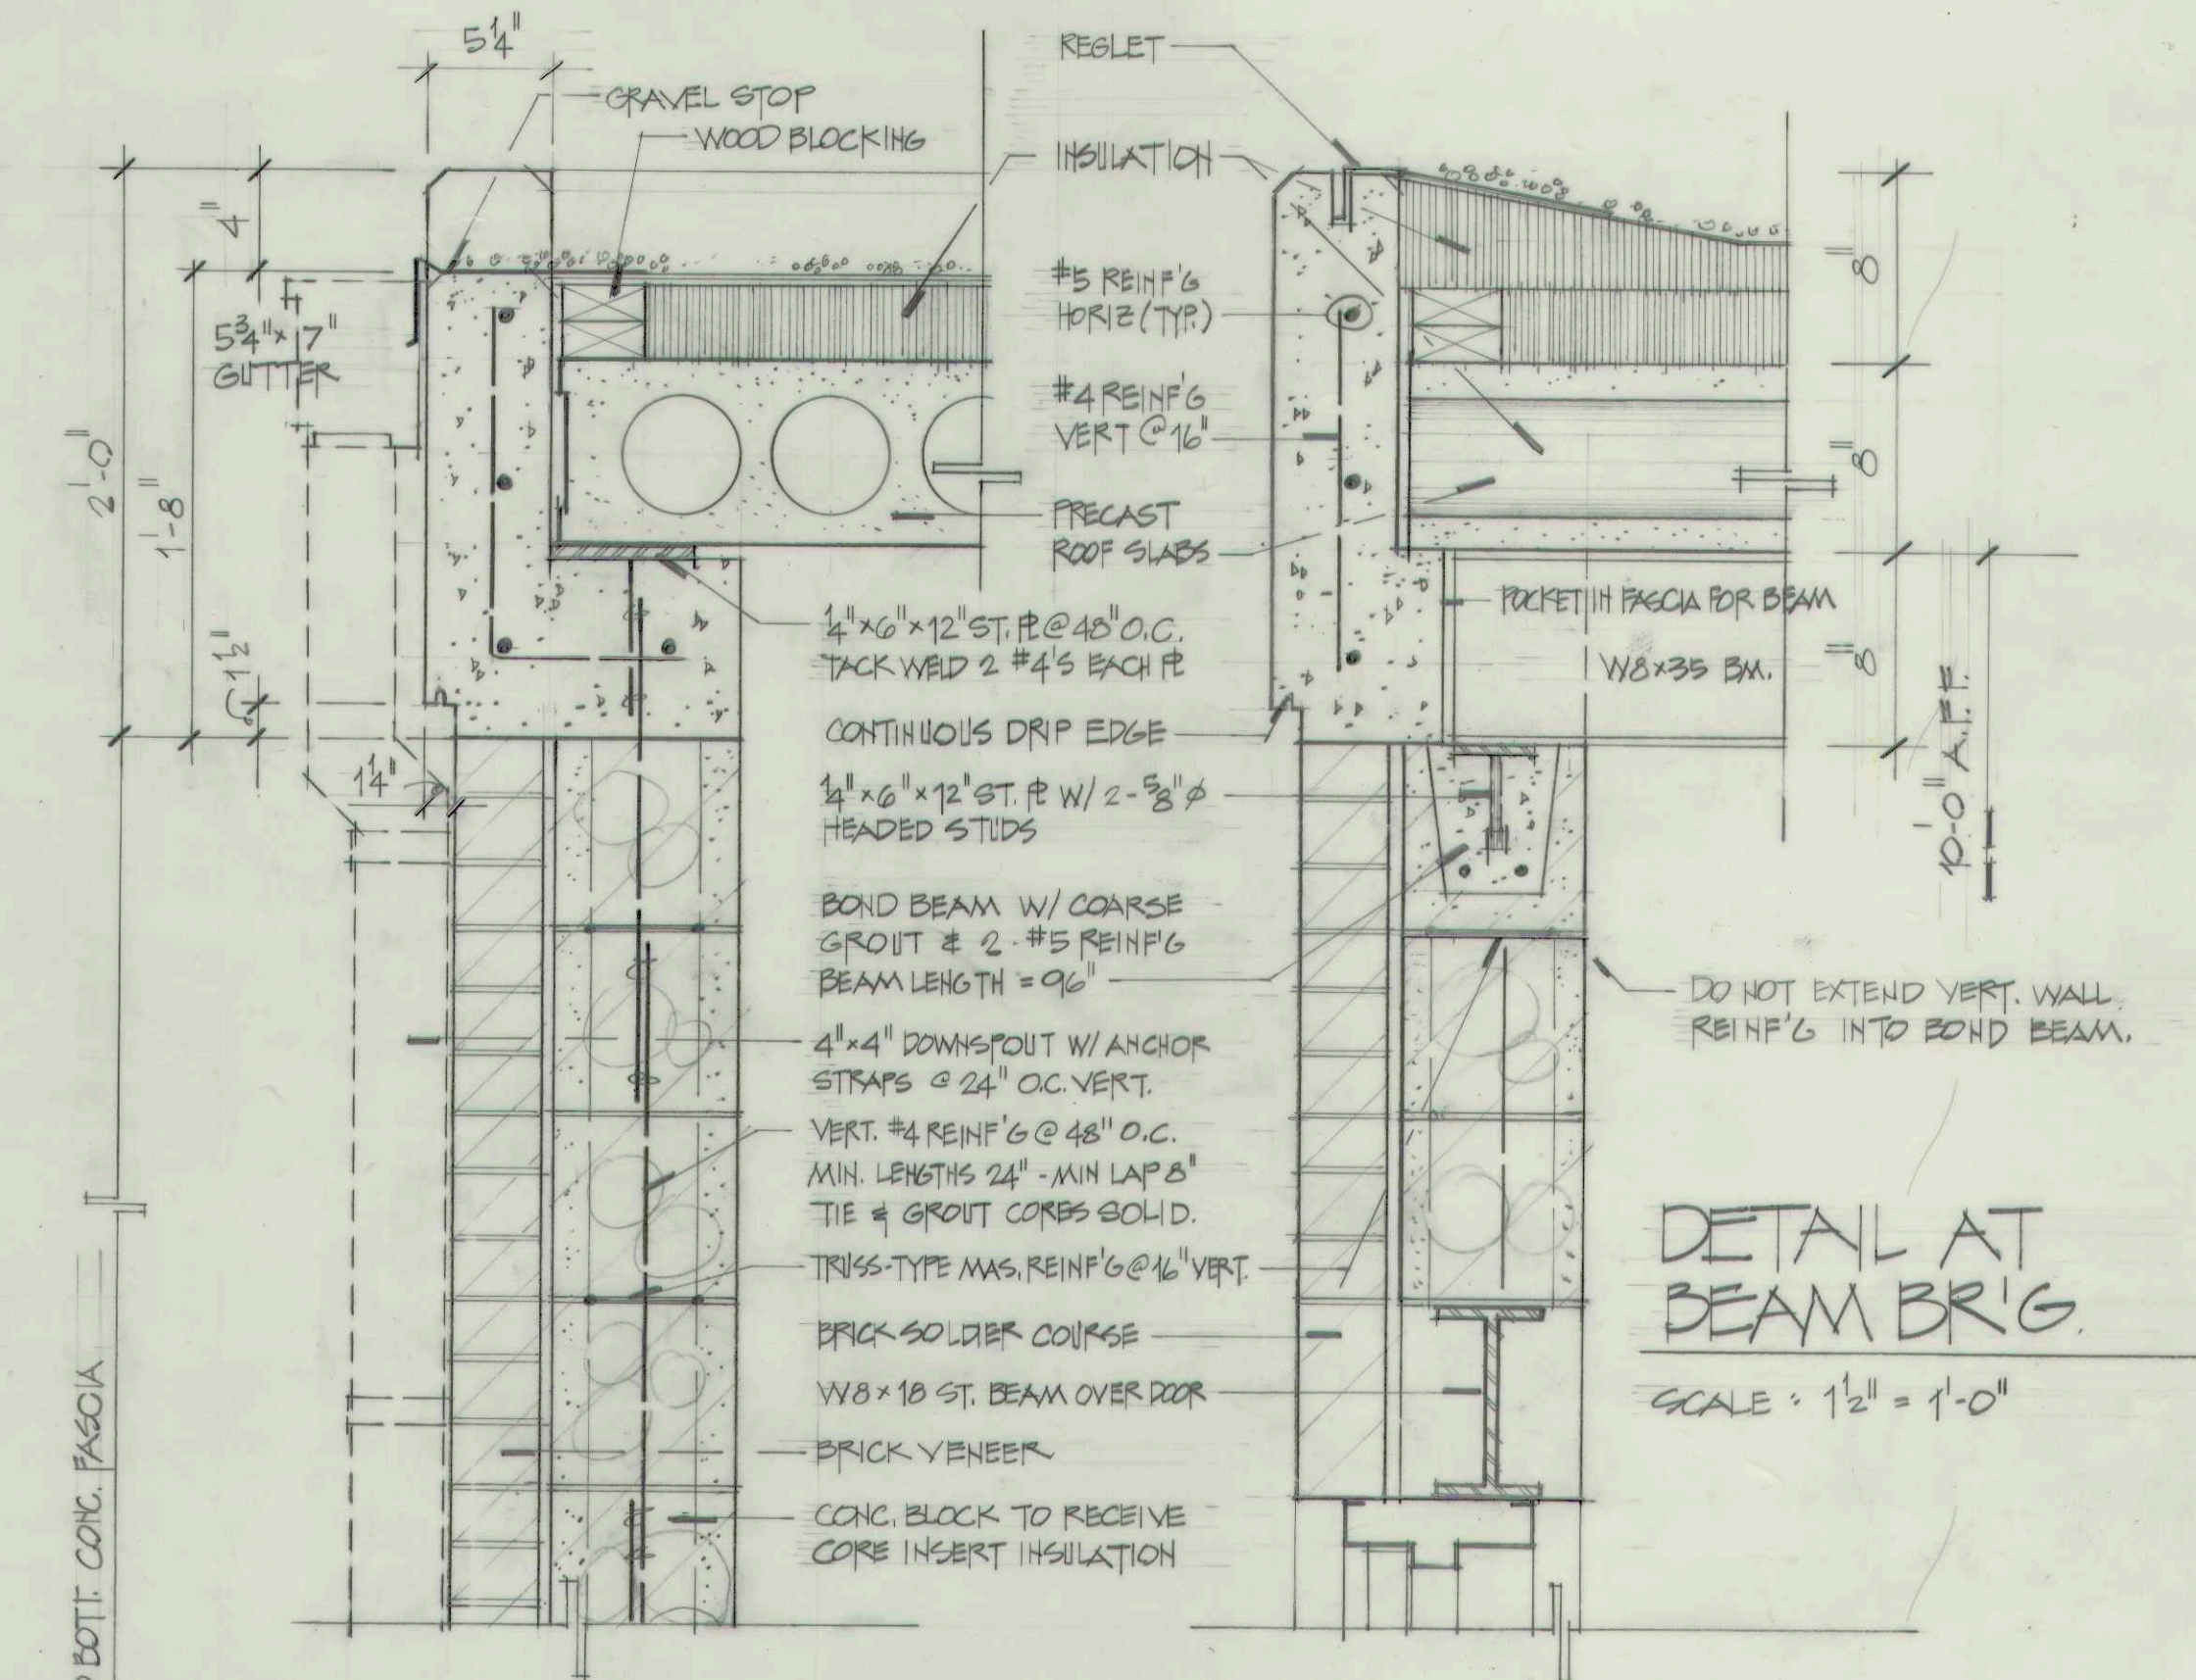


DETAIL AT BEAM BRG
SCALE: 1/2" = 1'-0"

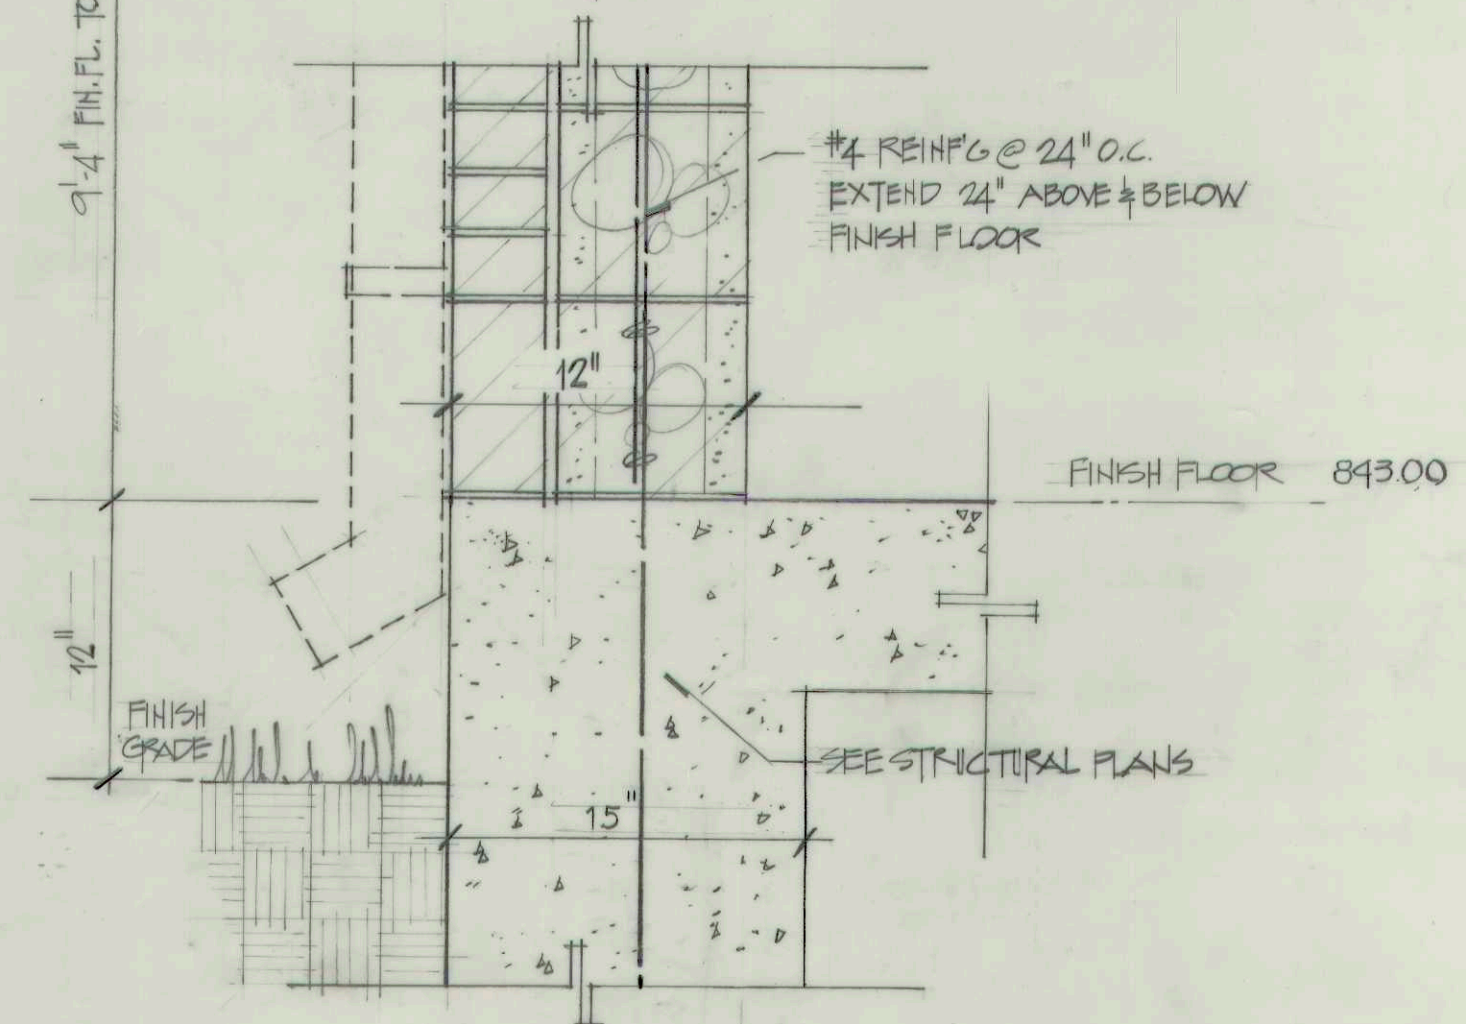


TYPICAL SECTION
SCALE: 1/2" = 1'-0"

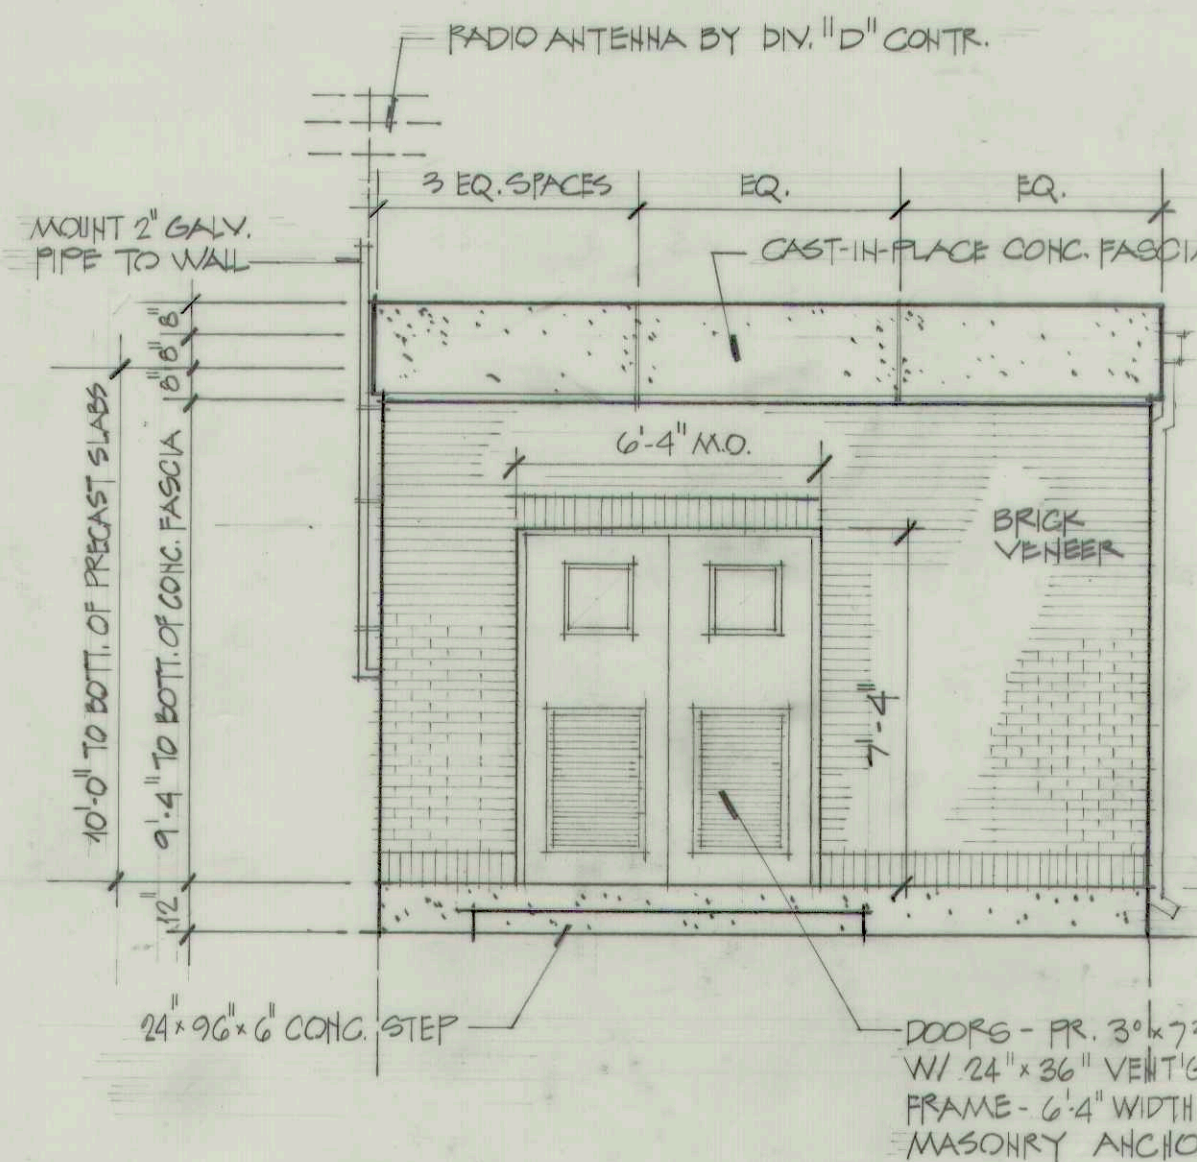

NORTH ELEVATION
SCALE: 1/4" = 1'-0"
SOUTH ELEV. SIMILAR

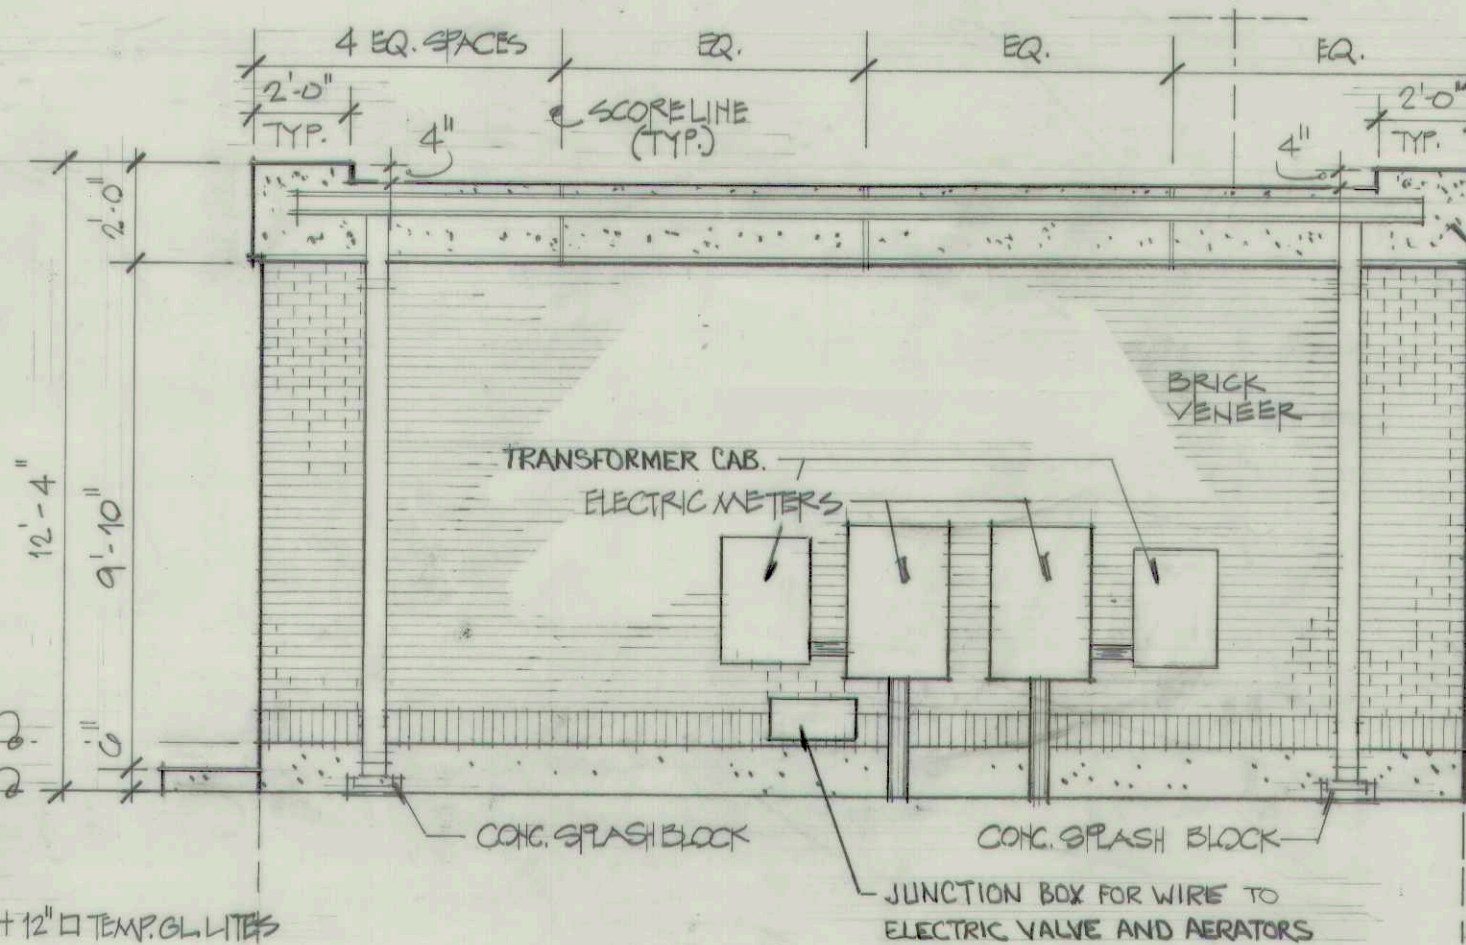


WEST ELEVATION
SCALE: 1/4" = 1'-0"

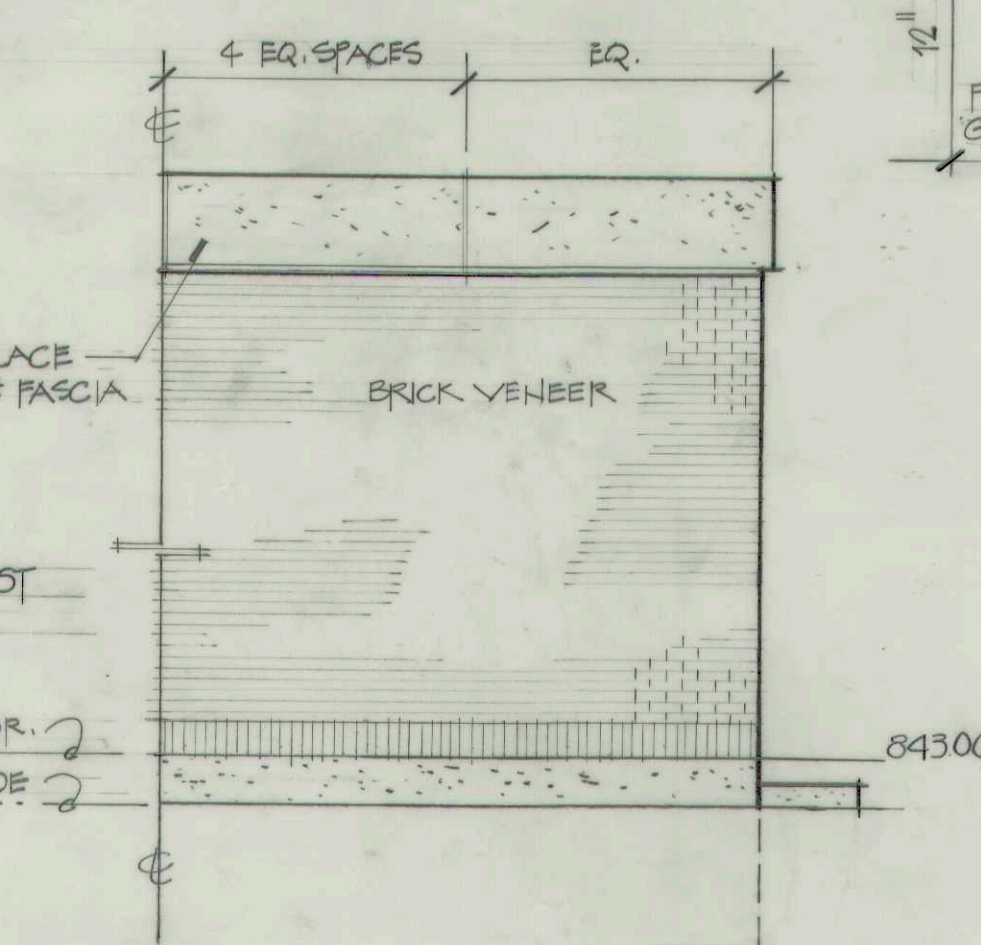

PARTIAL EAST ELEVATION
SCALE: 1/4" = 1'-0"

INTERIOR FINISH NOTE = EXPOSED CONC. SLAB CEILING TO BE PAINTED. WALLS TO BE PAINTED. FLOORS TO BE EXPOSED CONC. W/ SEALER. NO BASE MOLDING IS REQ'D.

RECORD DRAWING

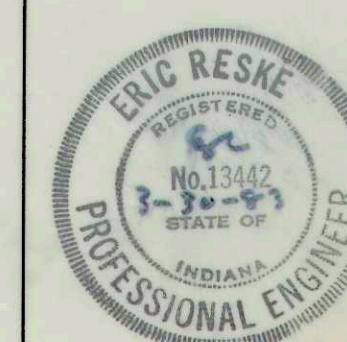

REFORMATORY LIFT STATION BUILDING		
Scale: AS NOTED	FALL CREEK R.W.D.	Sheet
Drawn By: DMW	BEAM, LONGEST & NEFF	70
Designed By: LP	Consulting Engineers	
Certified By: ER	8136 Castleton Road Indianapolis, IN 46250	