
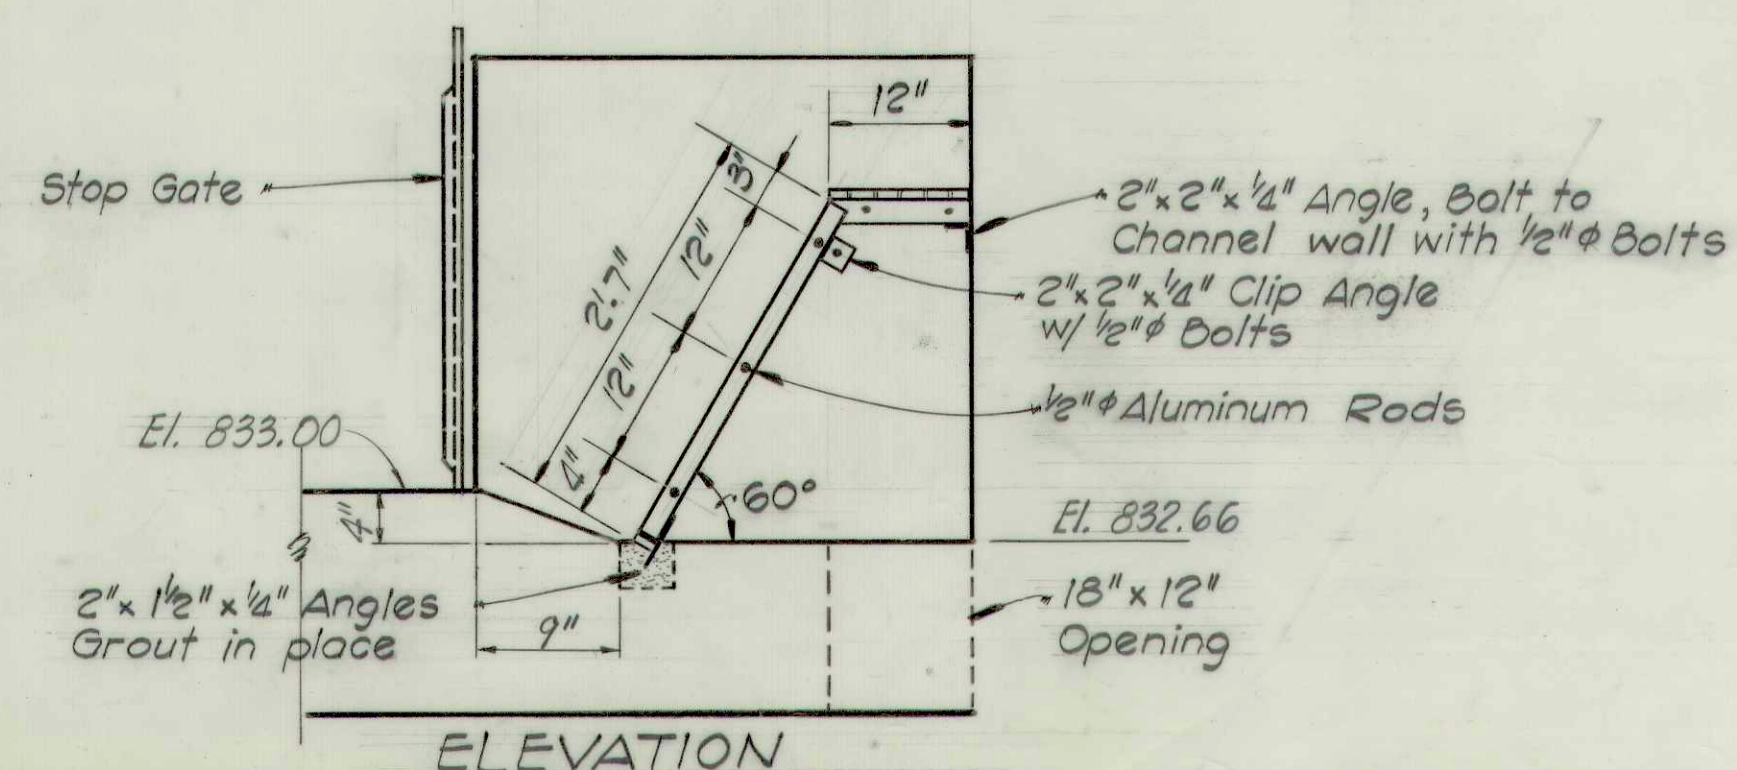
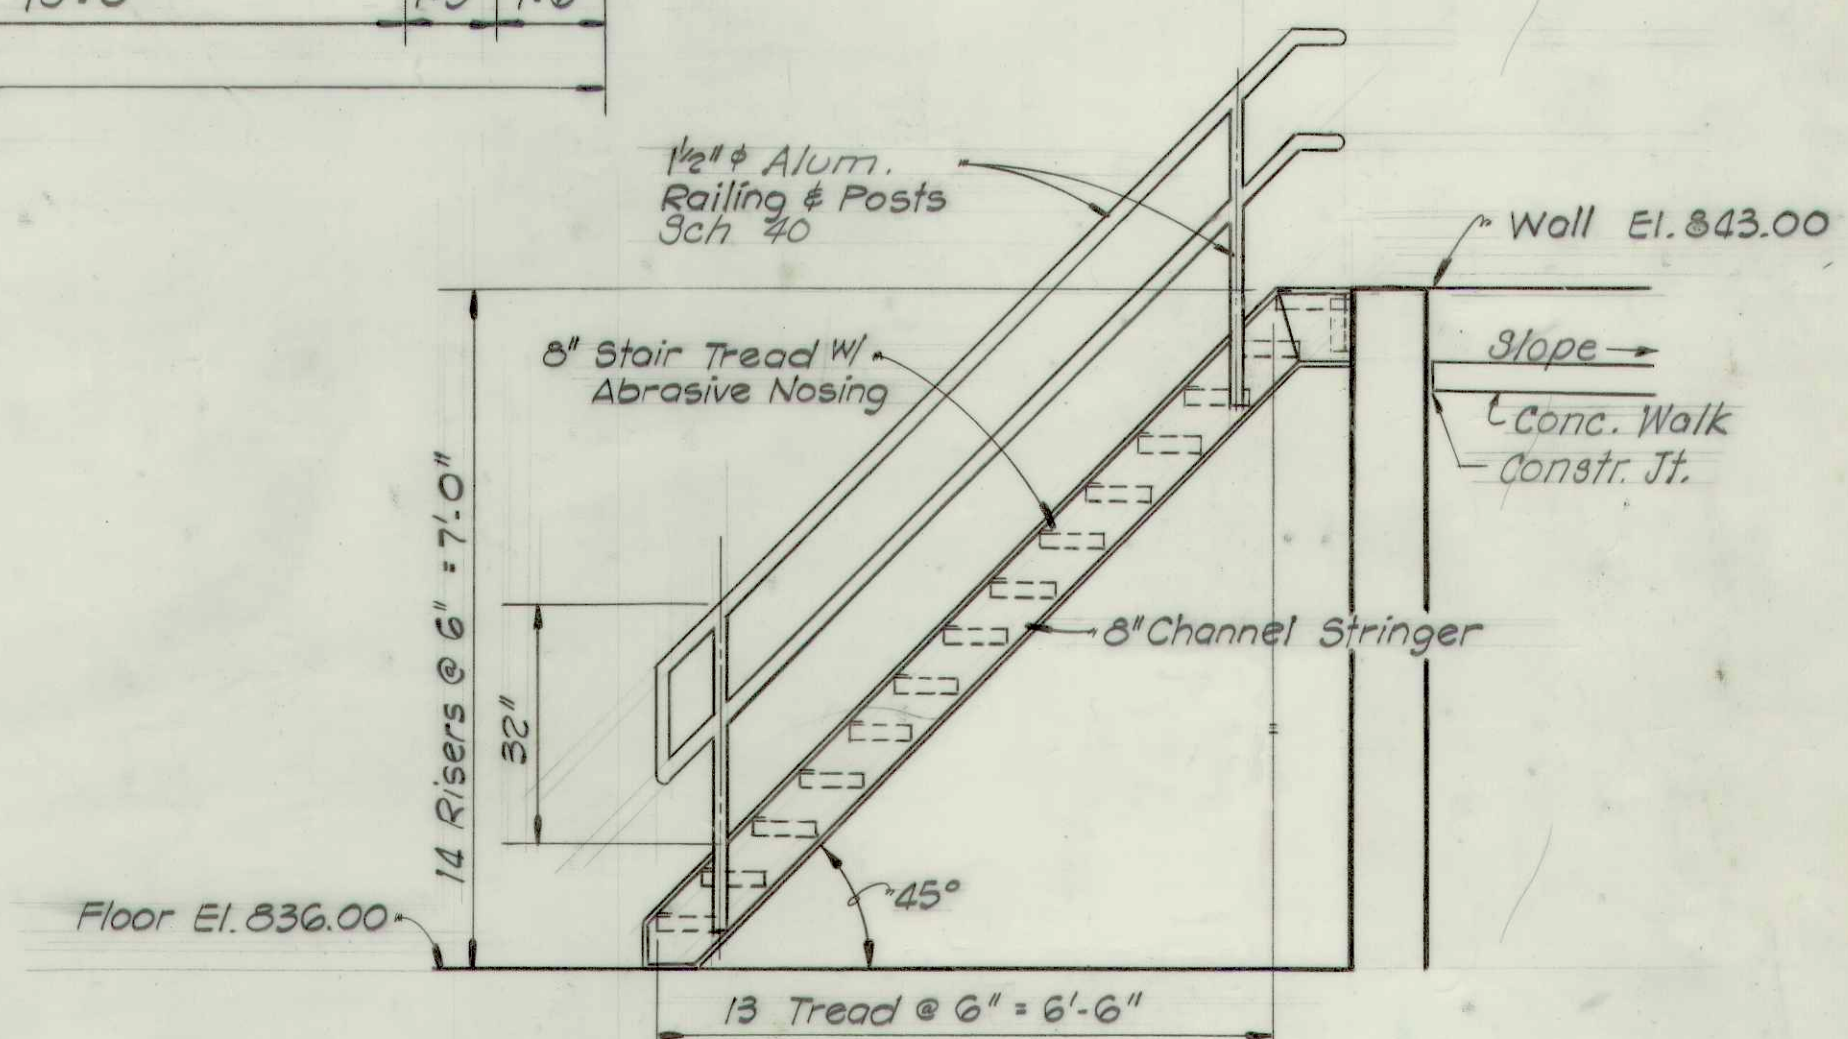
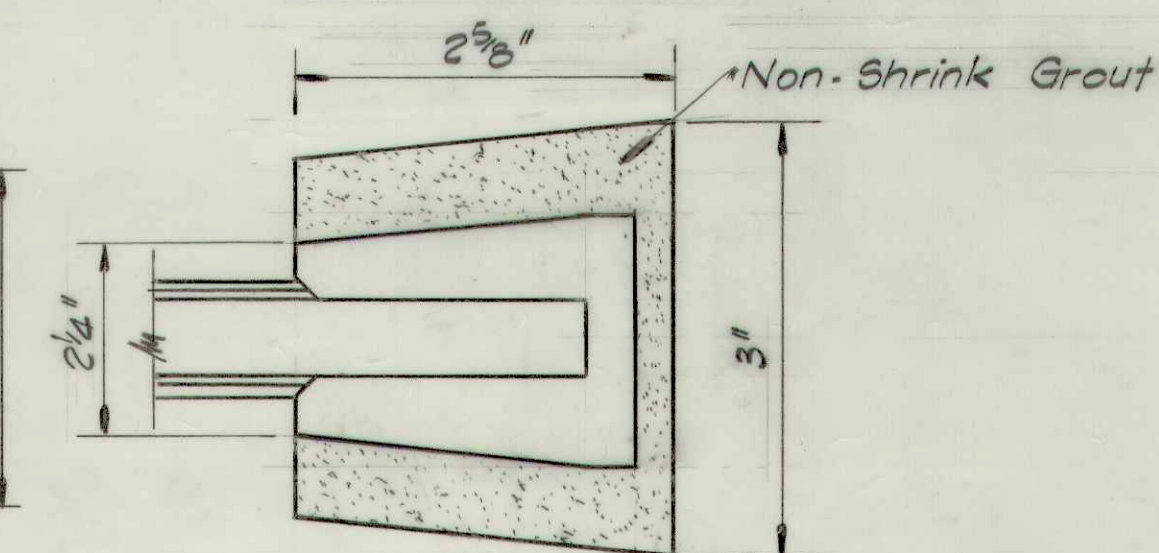
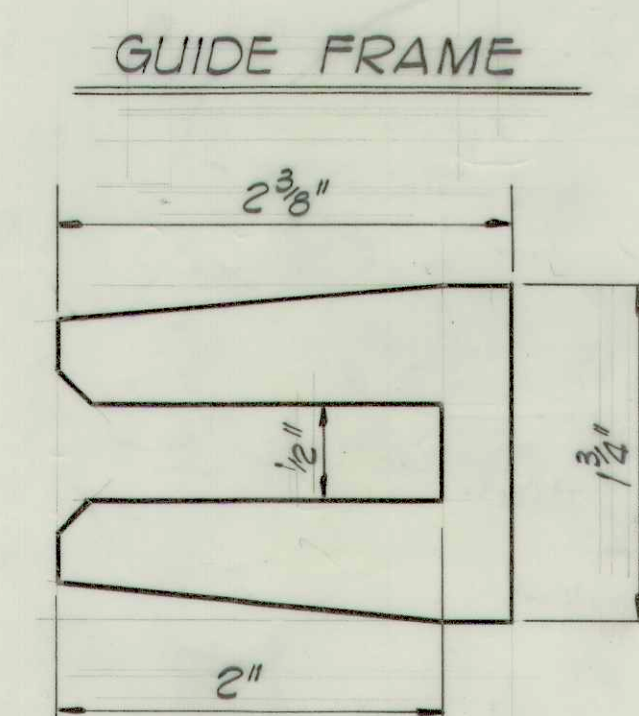
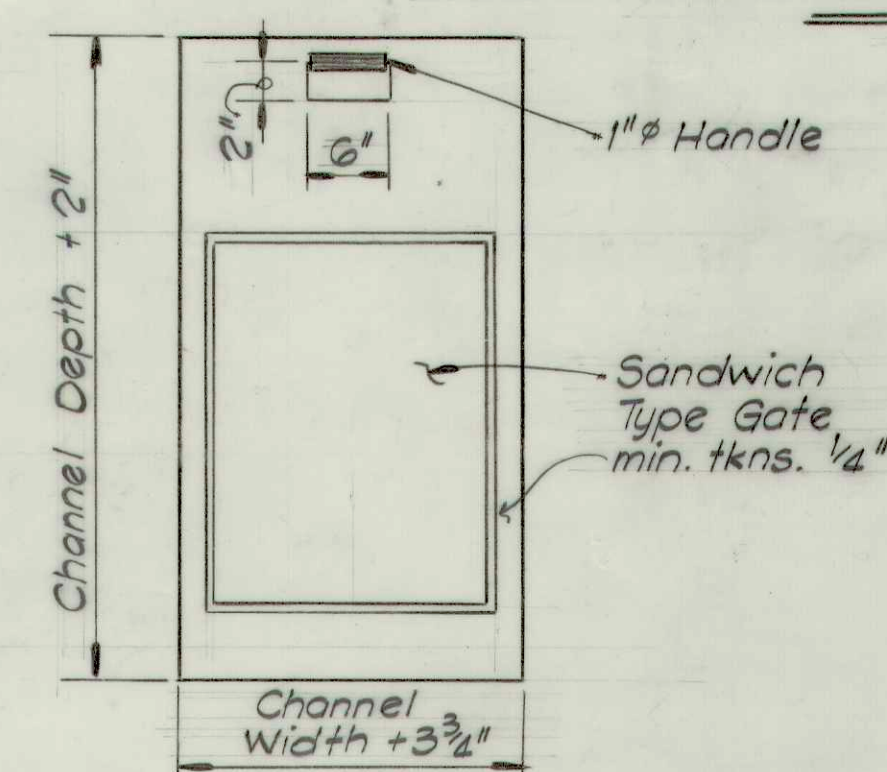
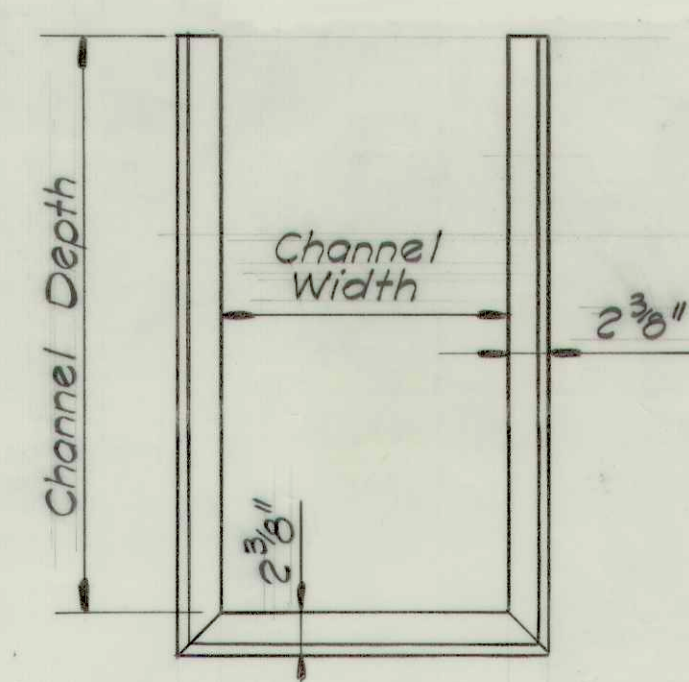
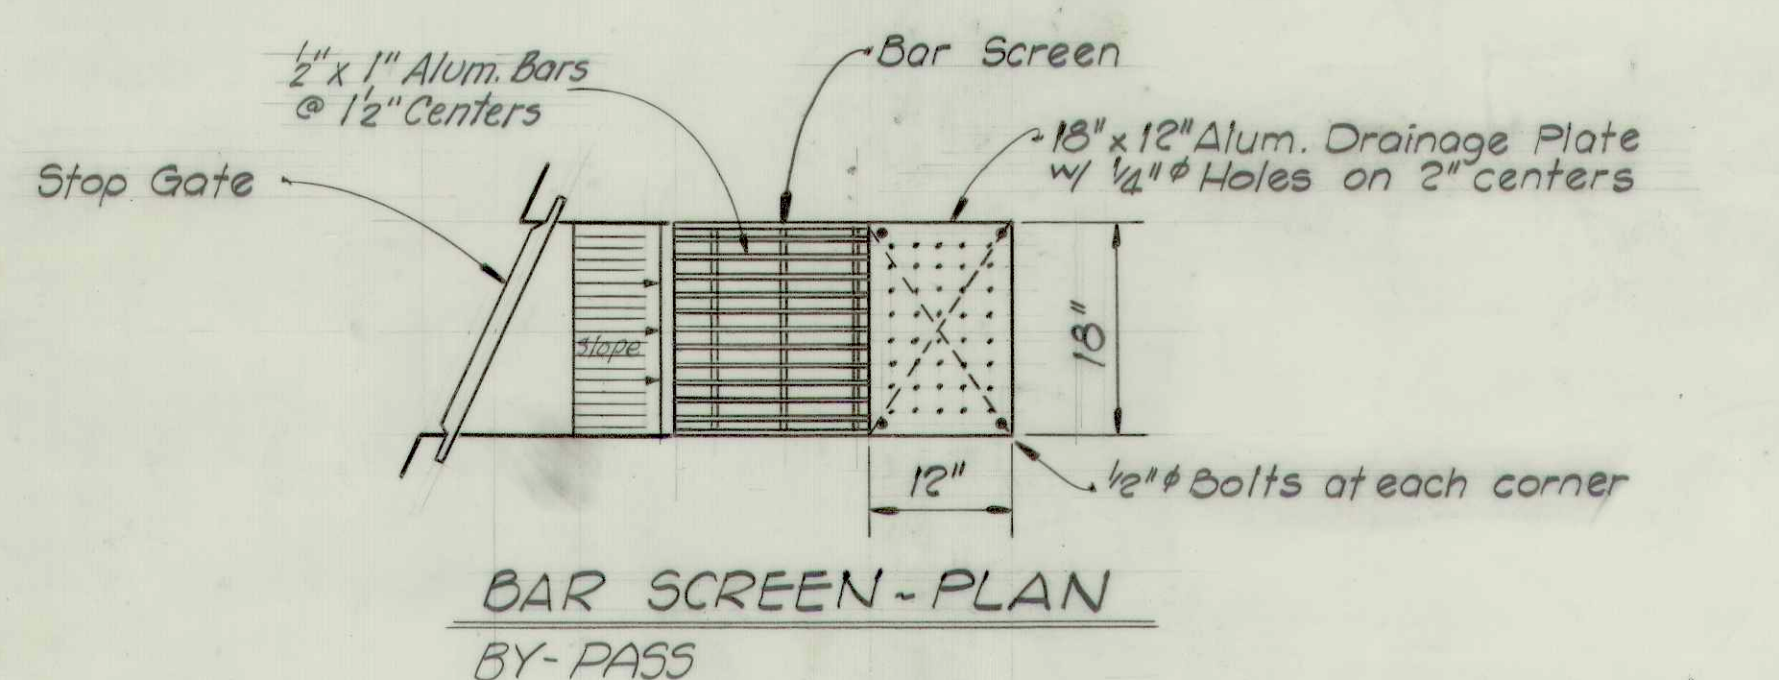
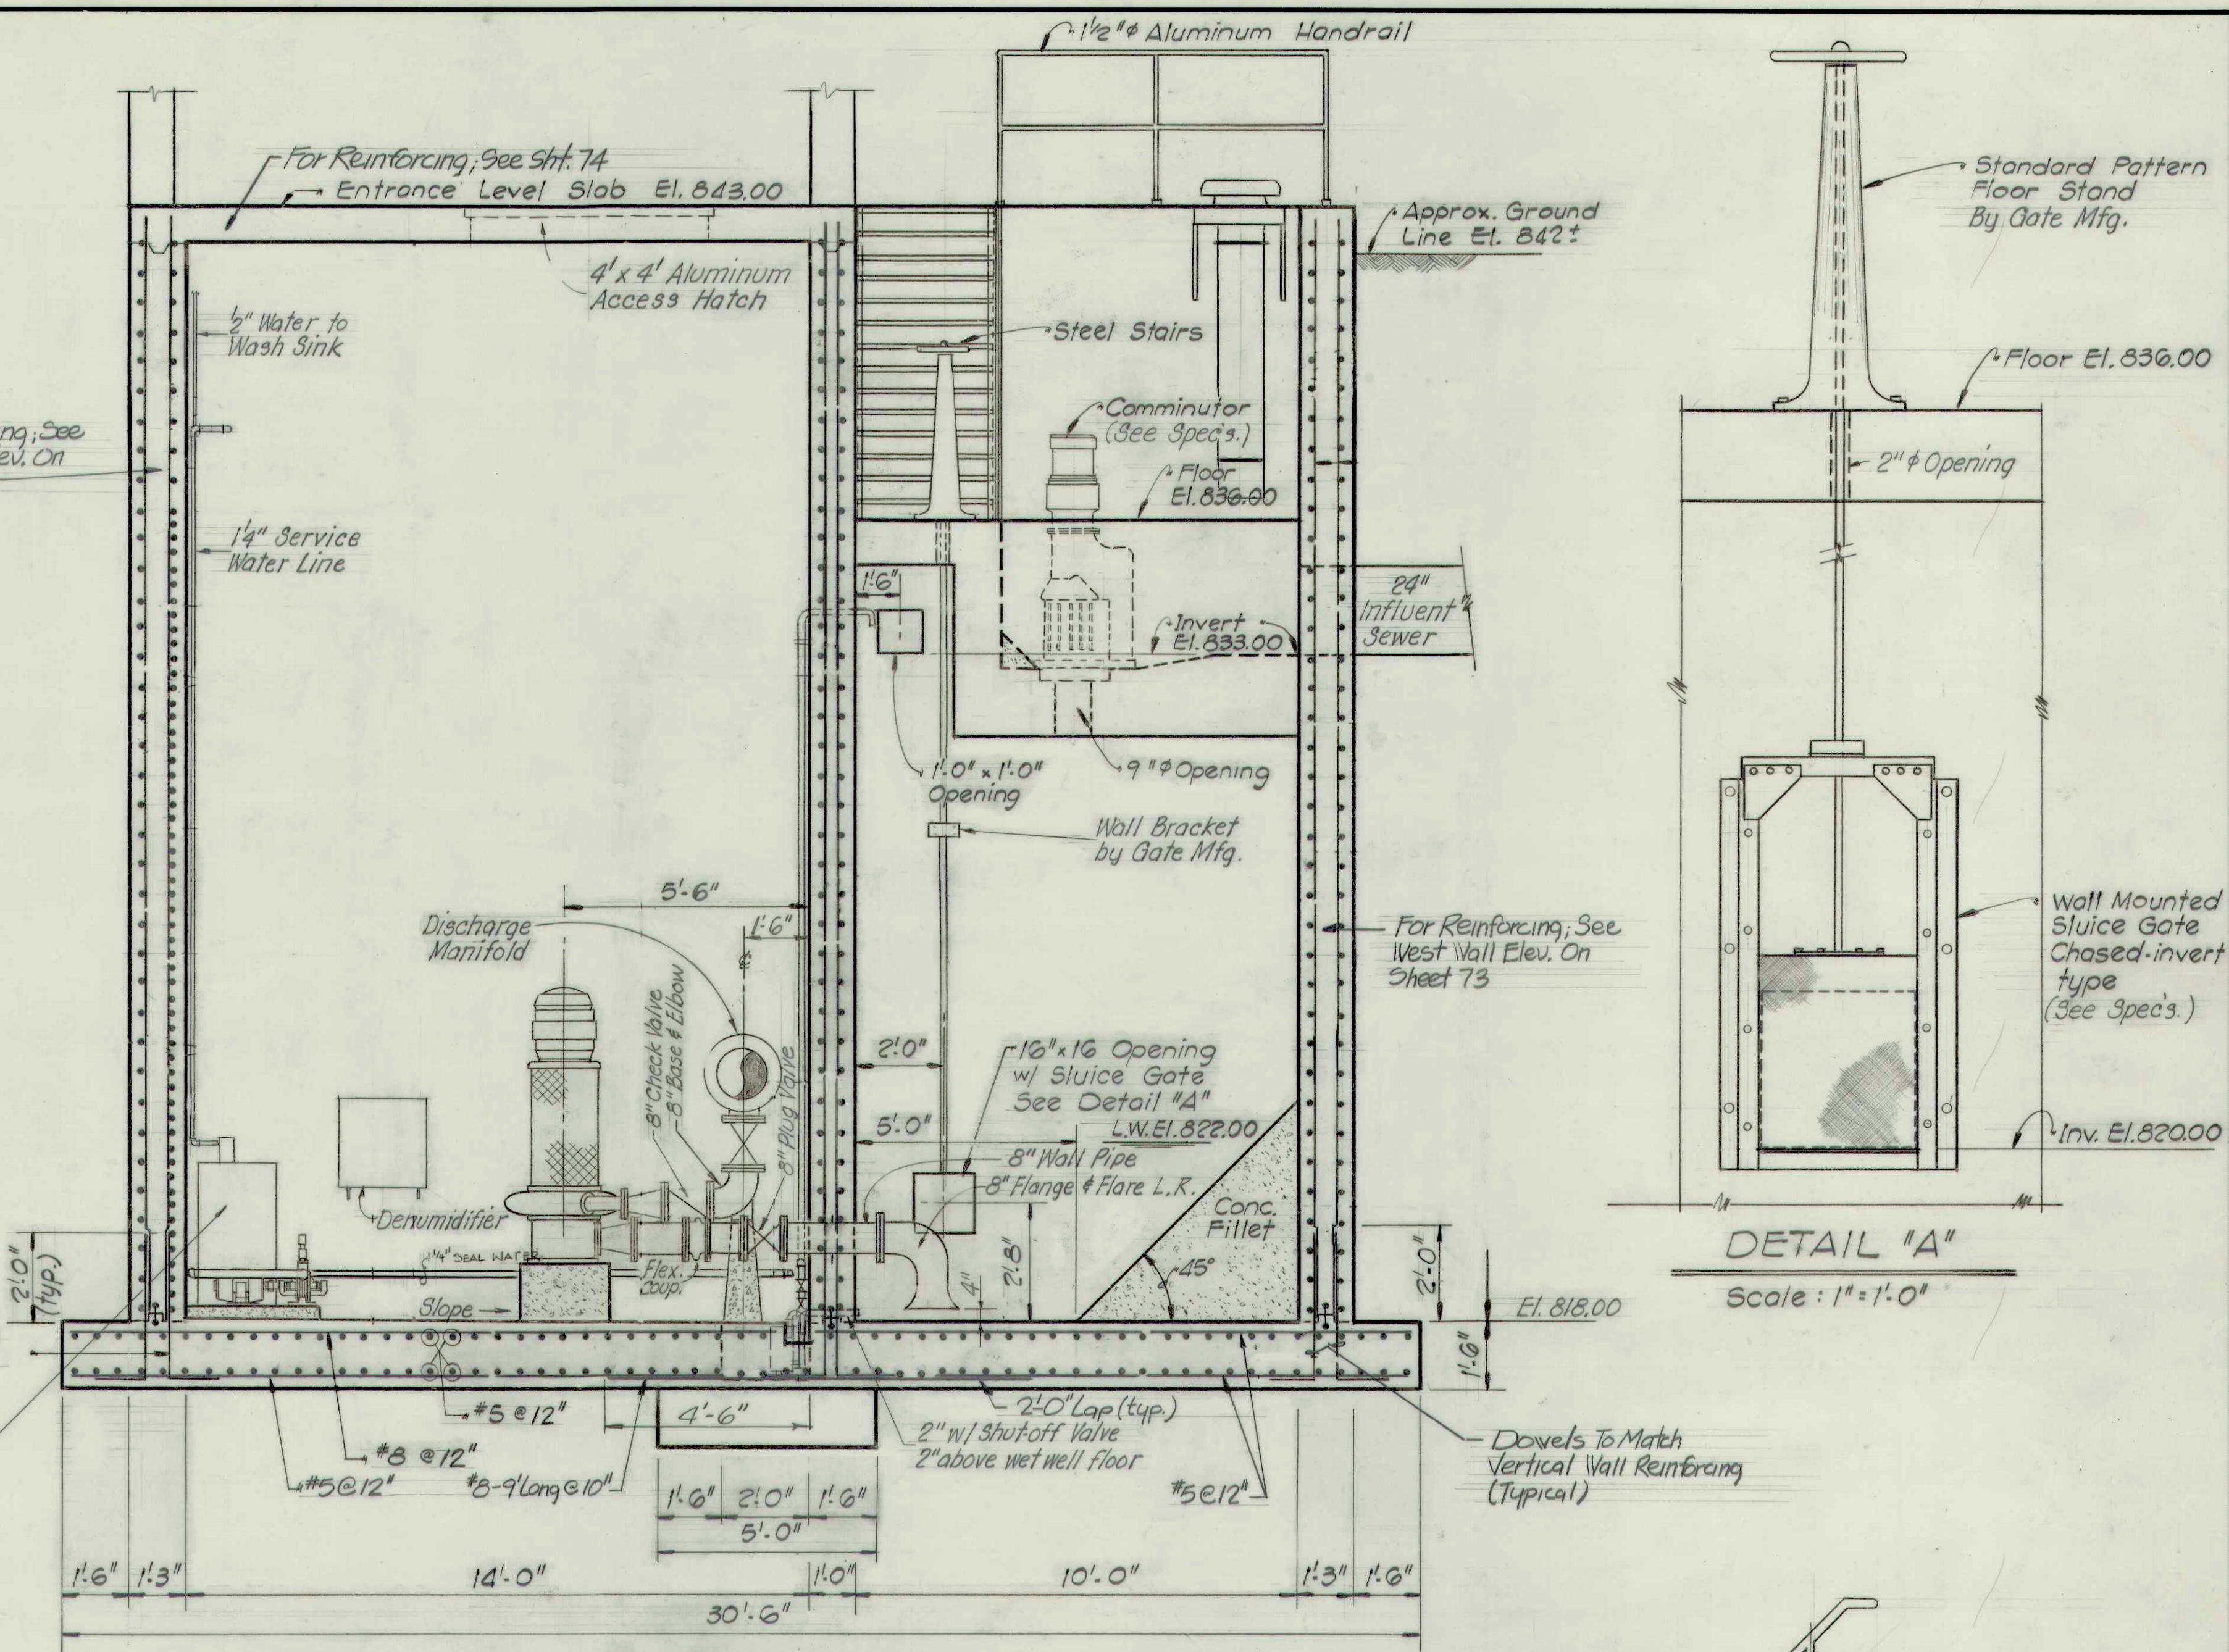


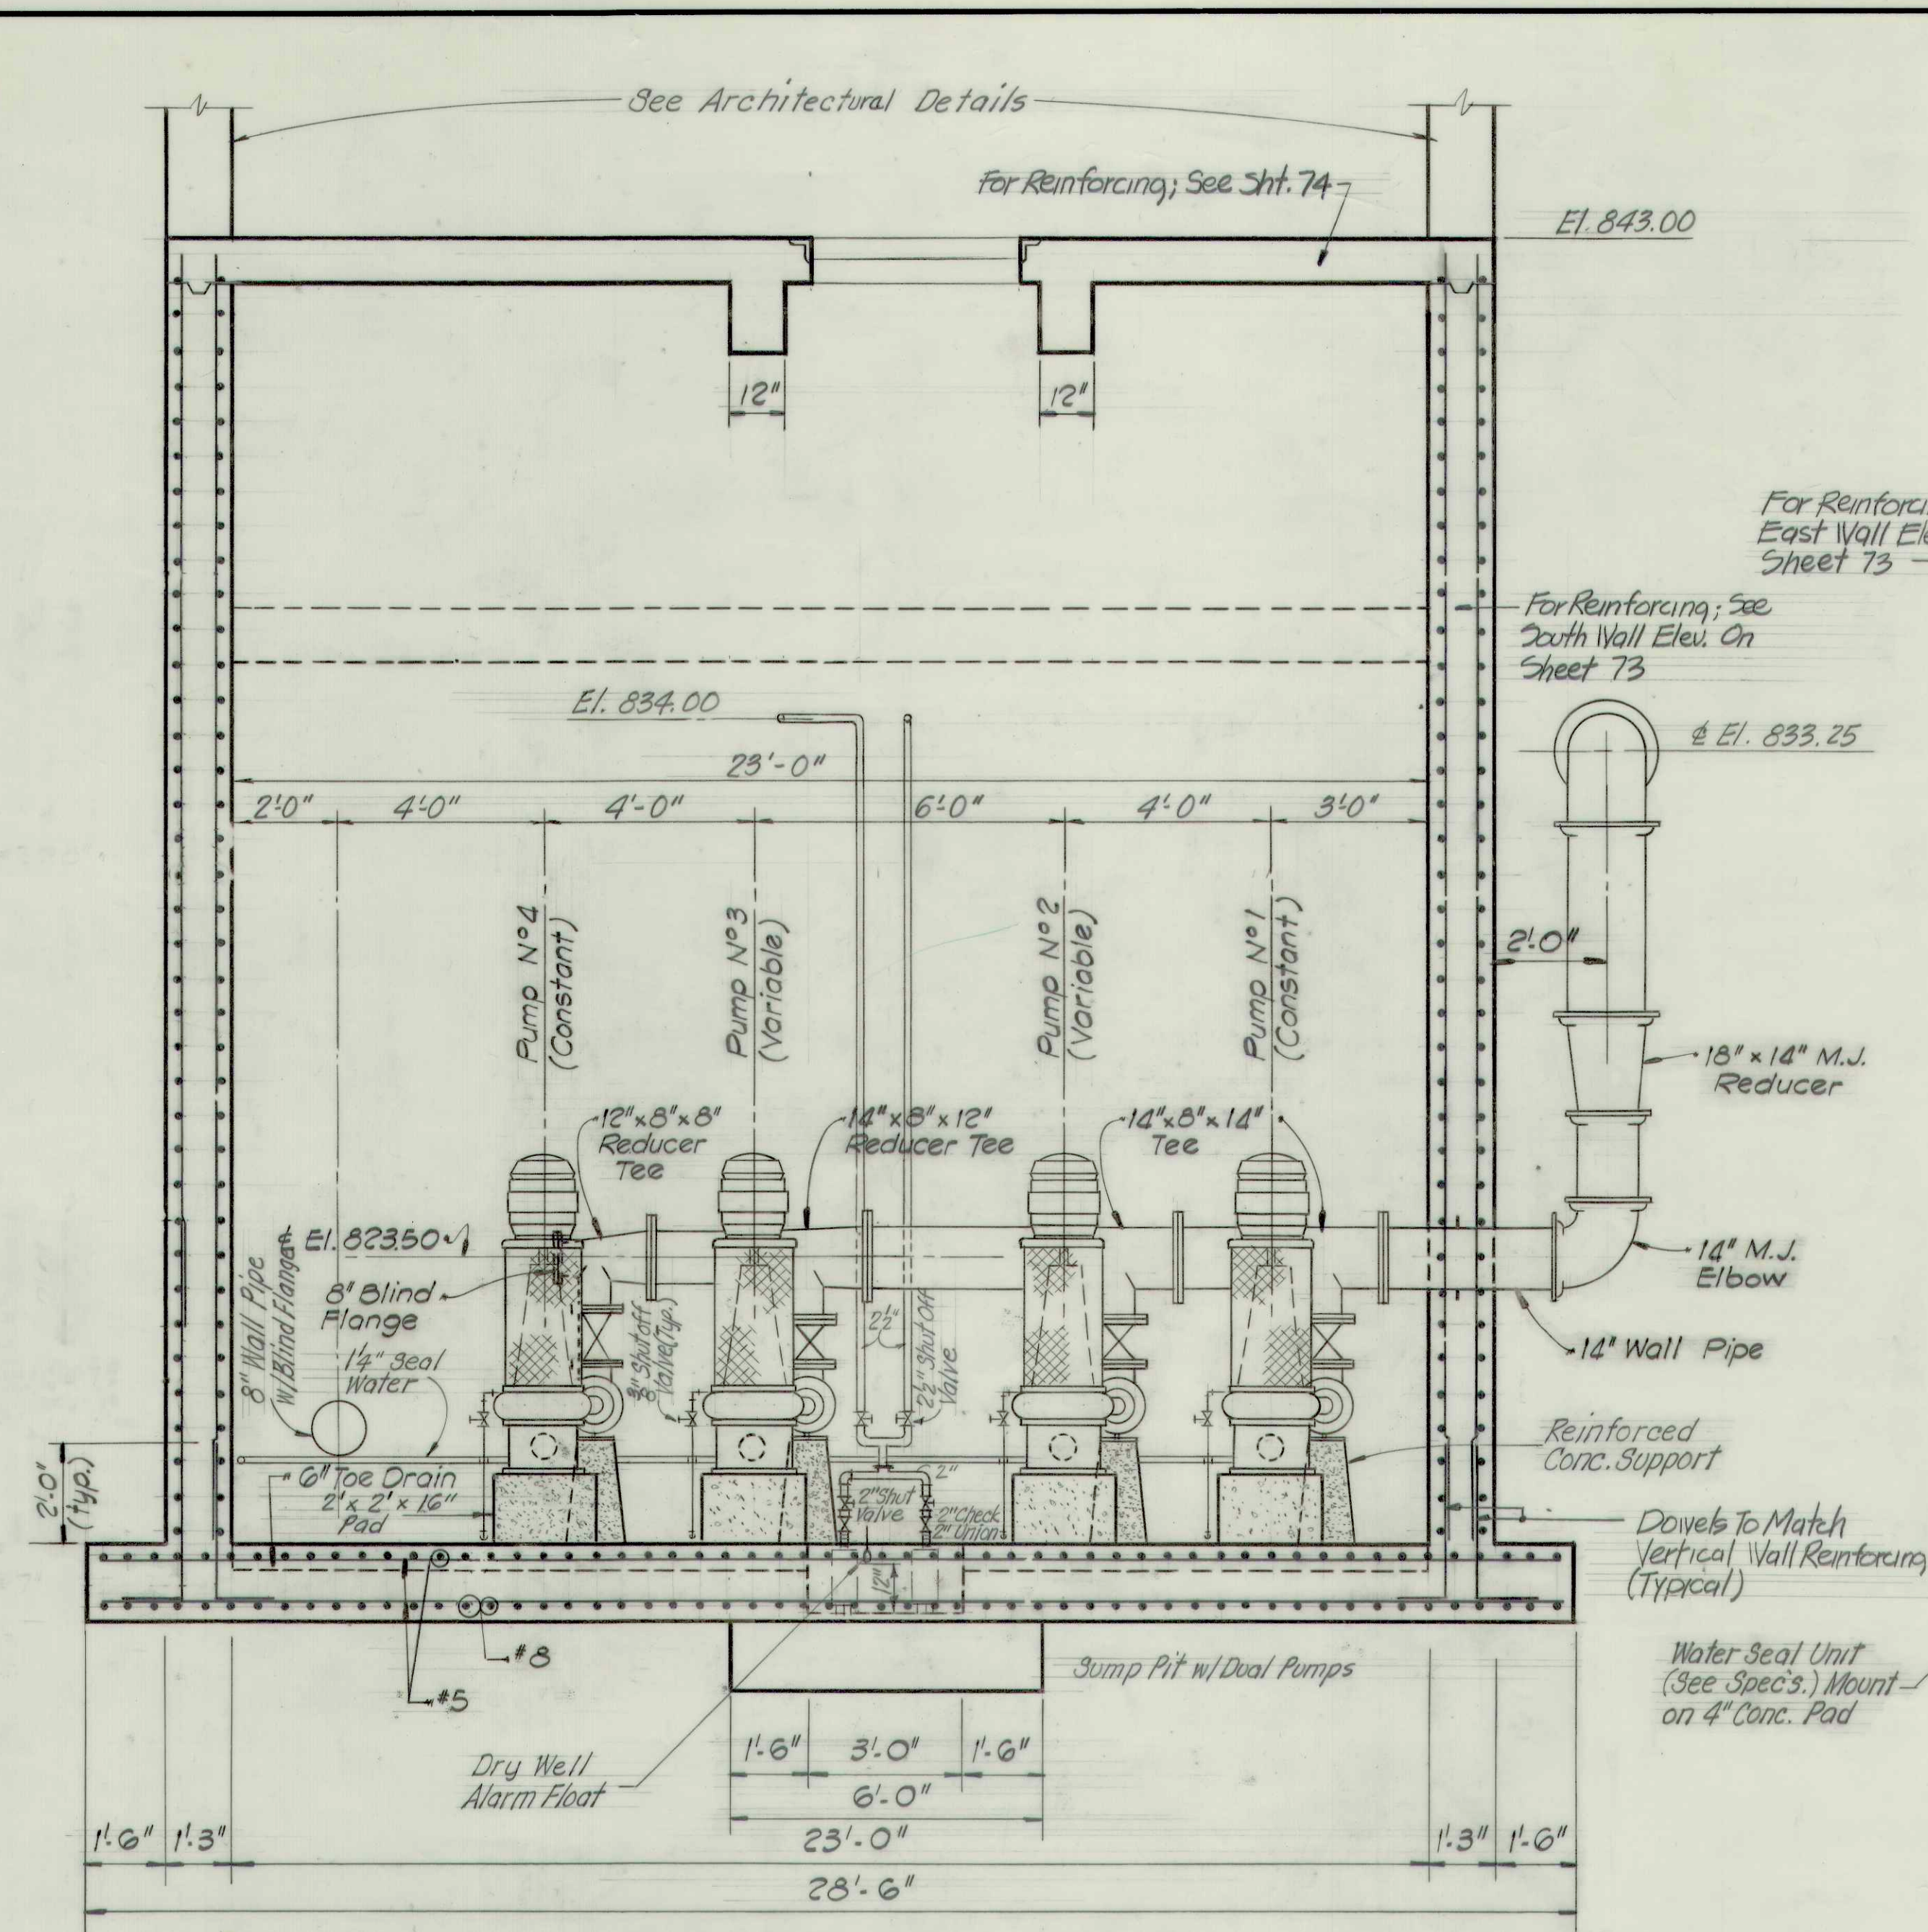

NOTE : STAIRS TO BE ANCHORED
ACCORDING TO MANUFACTURERS
RECOMMENDATIONS.

RECORD DRAWING

REFORMATORY MAIN LIFT STATION

SECTIONS & MISCELLANEOUS DETAILS

Scale: <i>As Noted</i>	FALL CREEK R.W.D.	Sheet
------------------------	-------------------	-------

Drawn By: <i>D.G.</i>	TEAM: LONGEST 3 NEFF
-----------------------	----------------------

BEAM, LONGEST & NEFF	72
Designed By: RES	

Designed By: <u>J.P.</u>	Consulting Engineers 8136 Castleton Road	12
--------------------------	---	----

BEAM LONGEST 3 NEFF

BEAM, LONGEST & NEFF 72

Consulting Engineers
8136 Castleton Road

Indianapolis In. 46250	
------------------------	--

7

72