




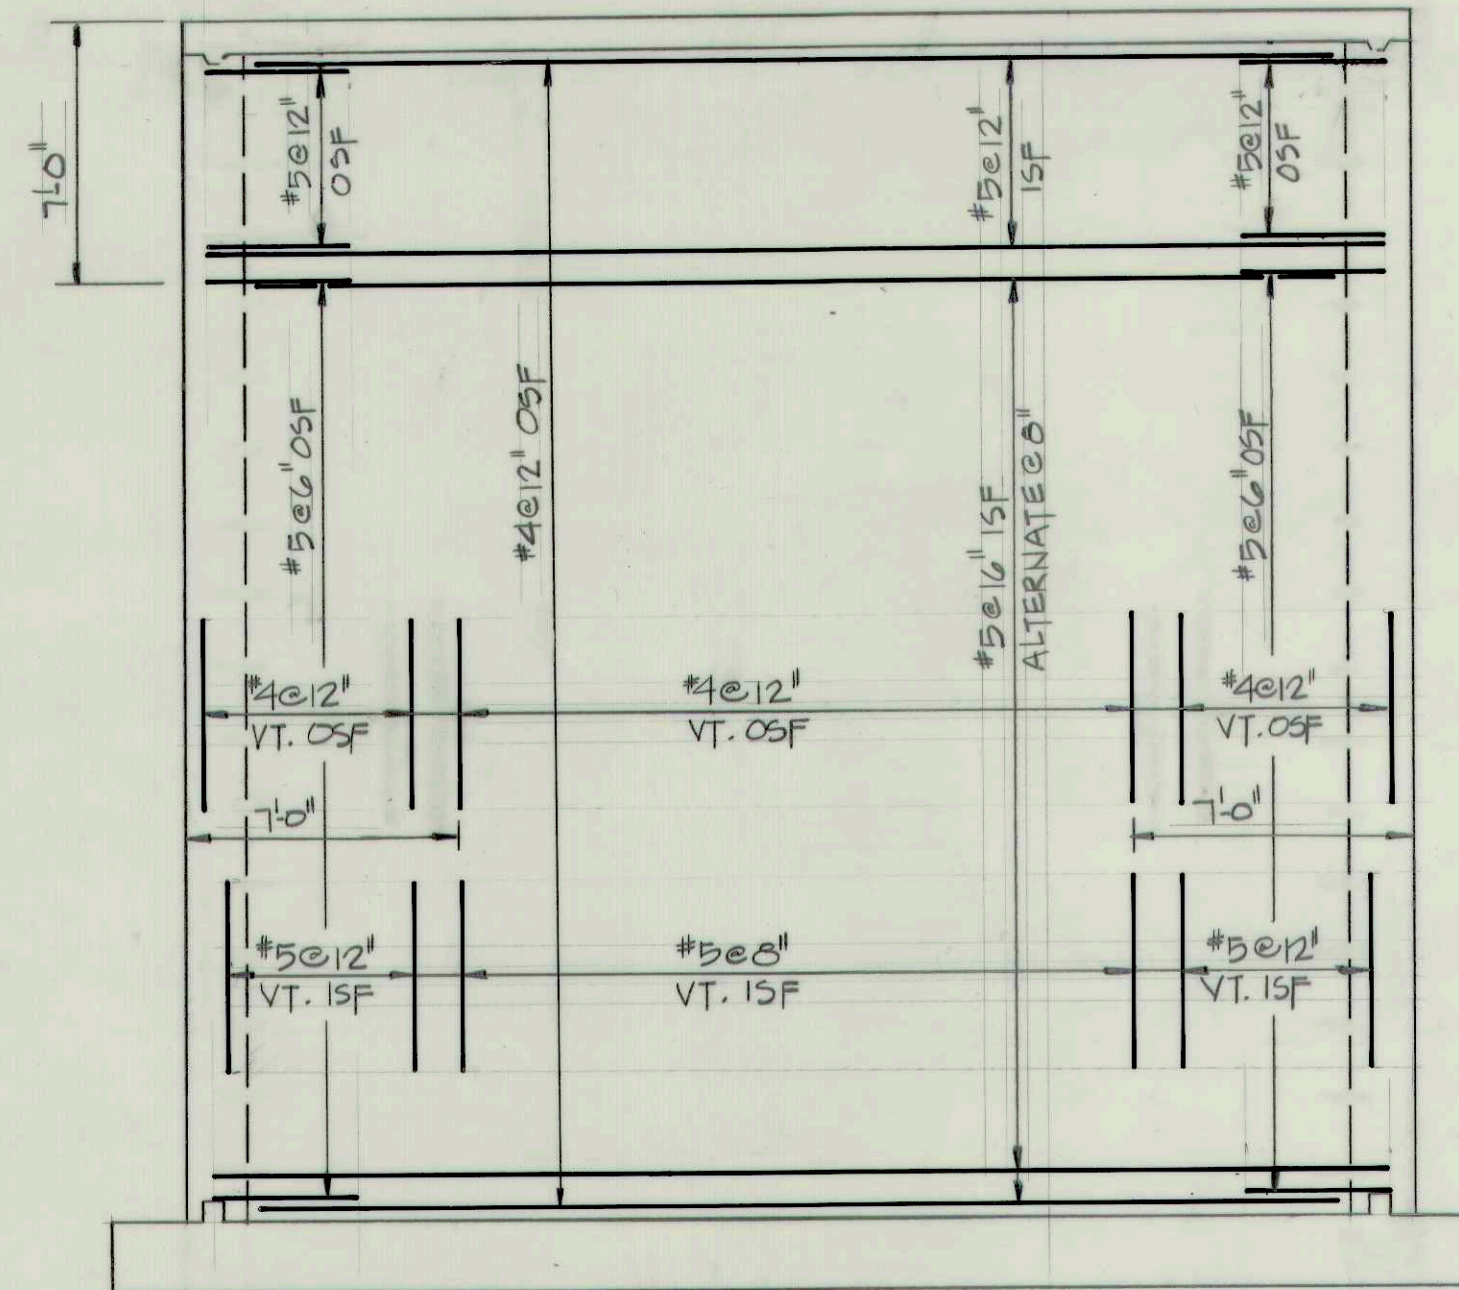


WEST WALL ELEVATION
SCALE 1/4" = 1'-0"

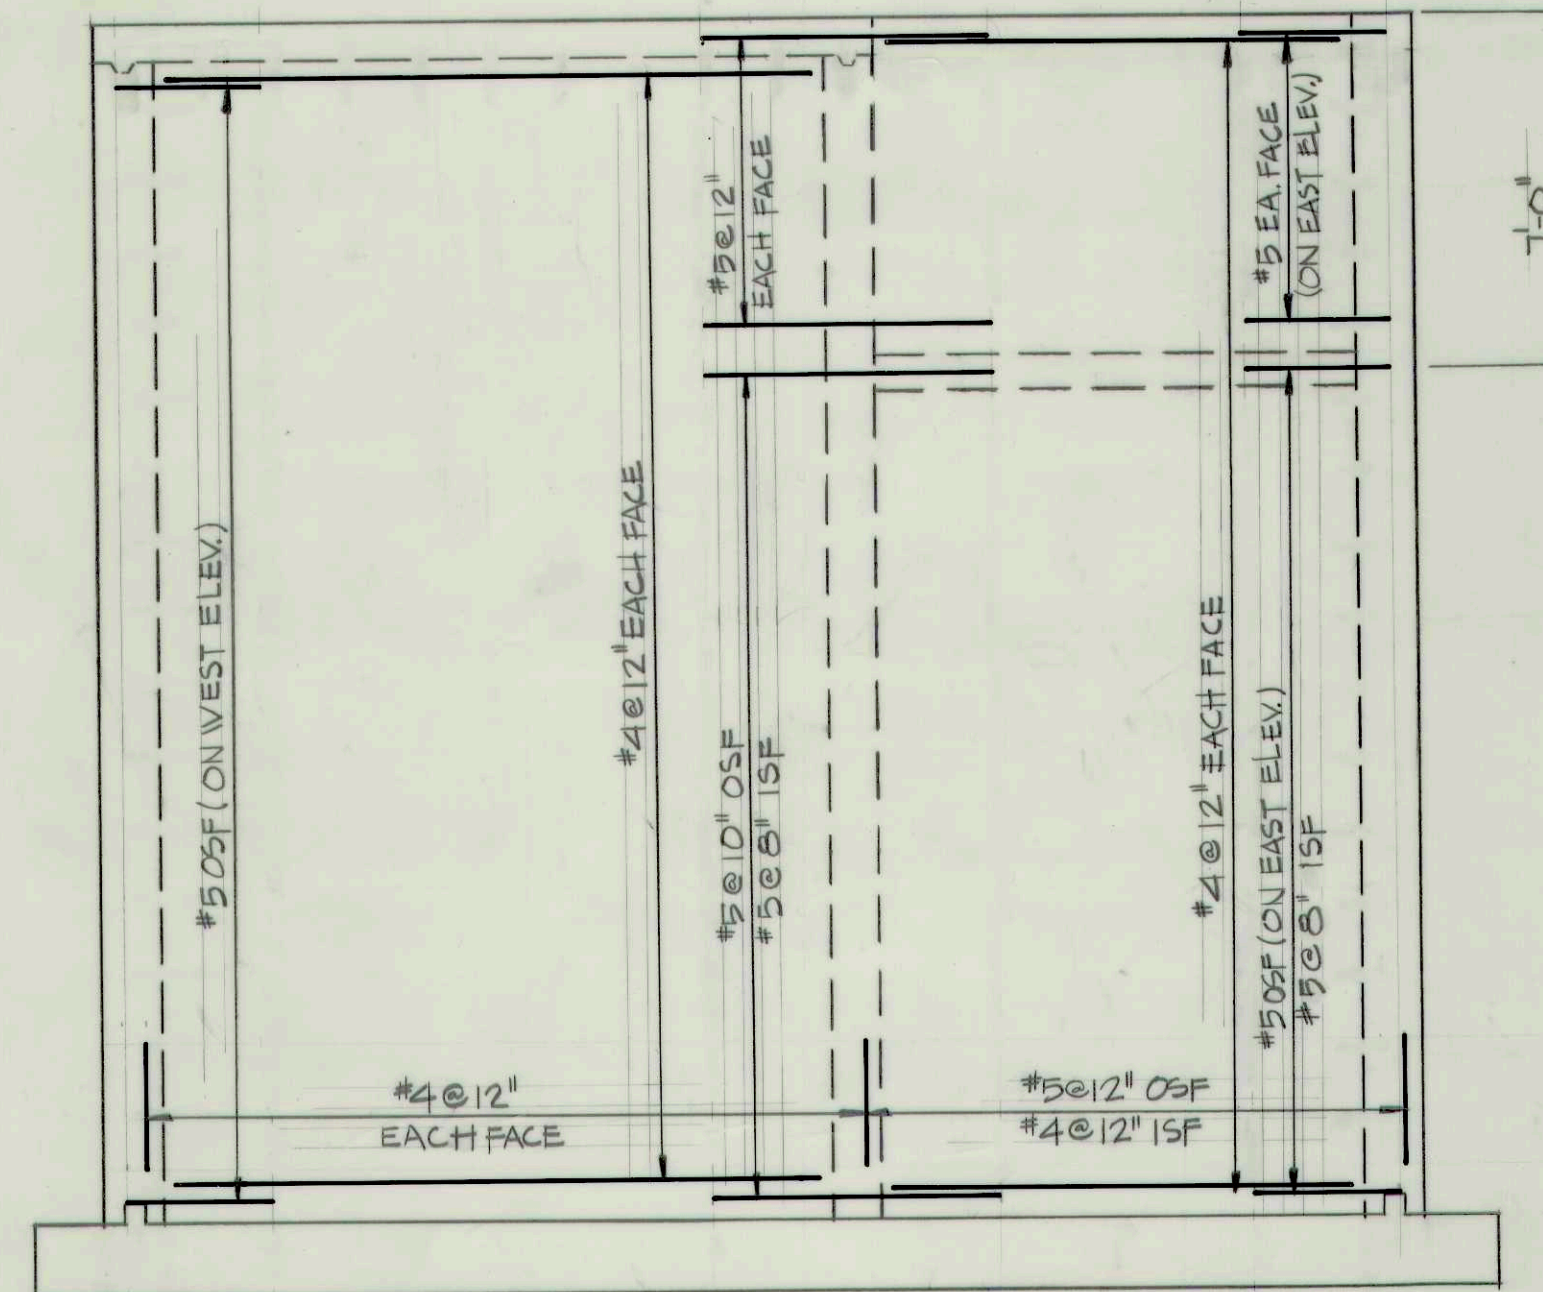


SOUTH WALL ELEVATION
SCALE 1/4" = 1'-0"

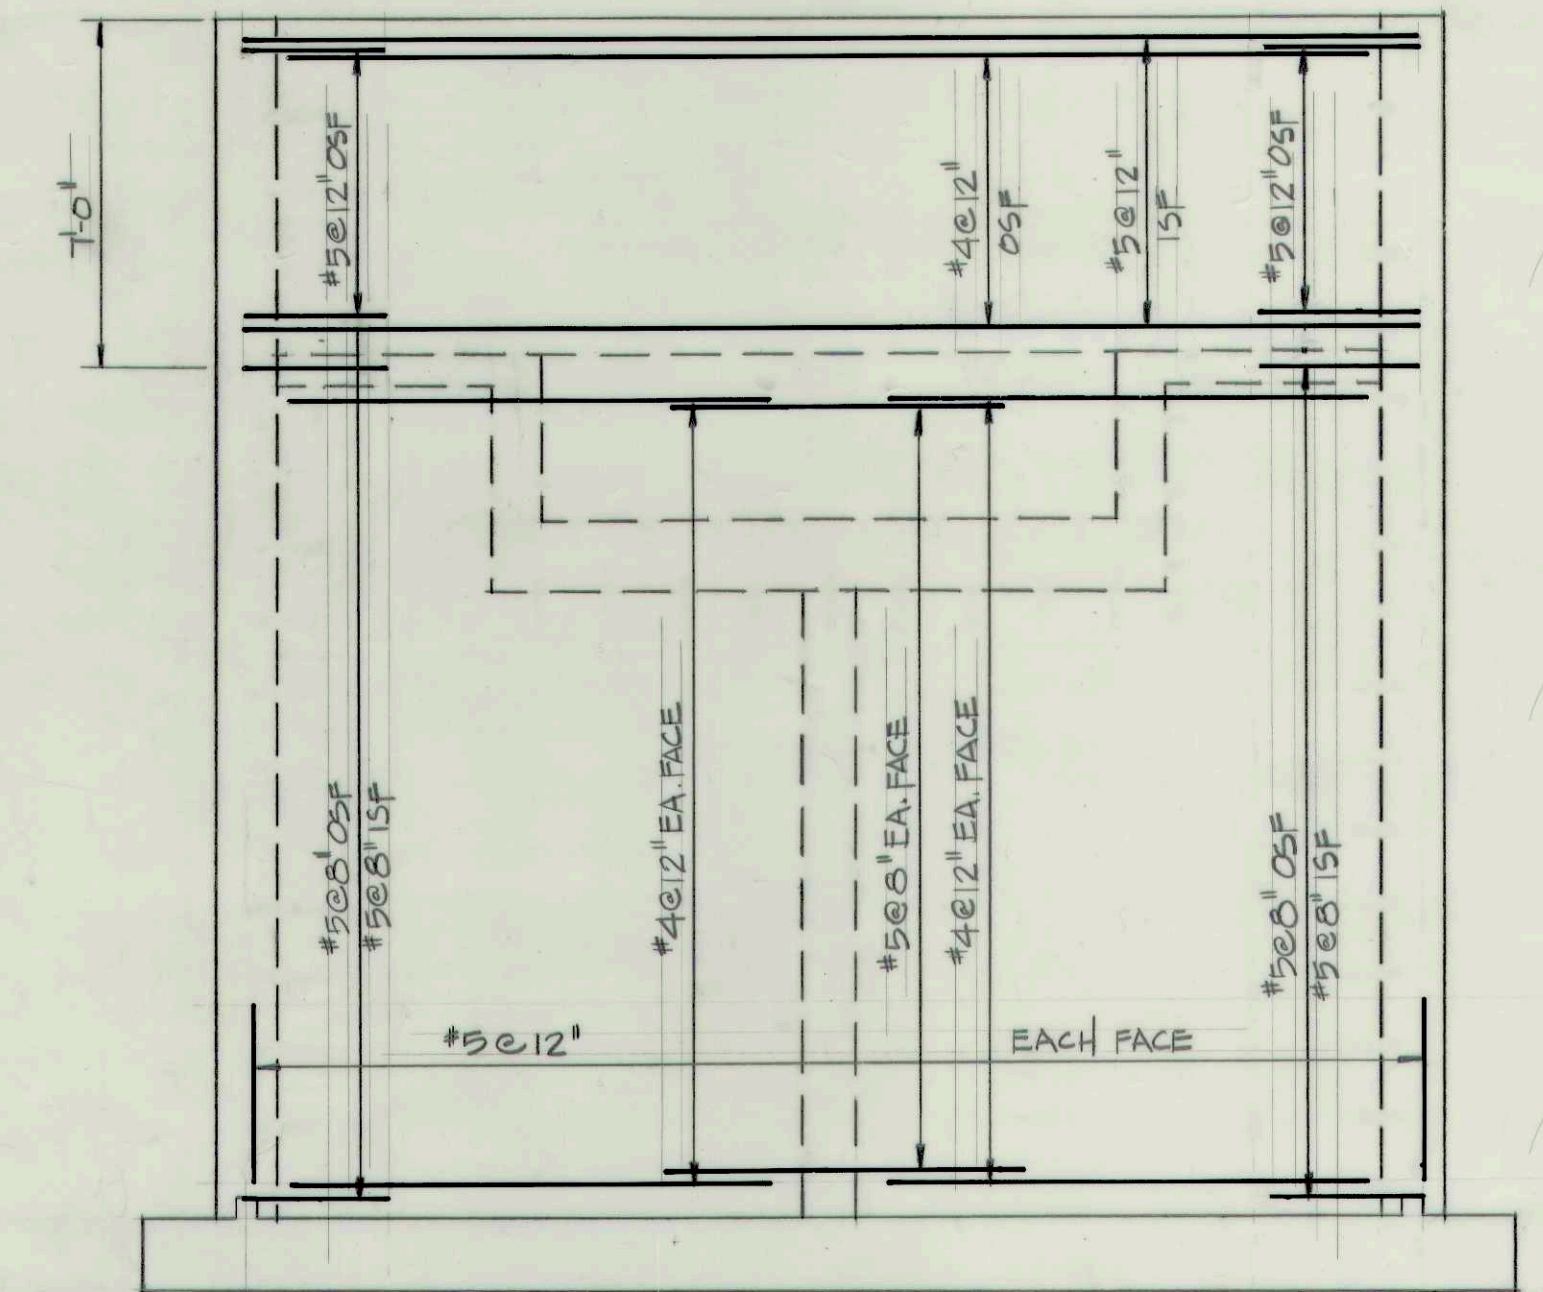


EAST WALL ELEVATION
SCALE 1/4" = 1'-0"

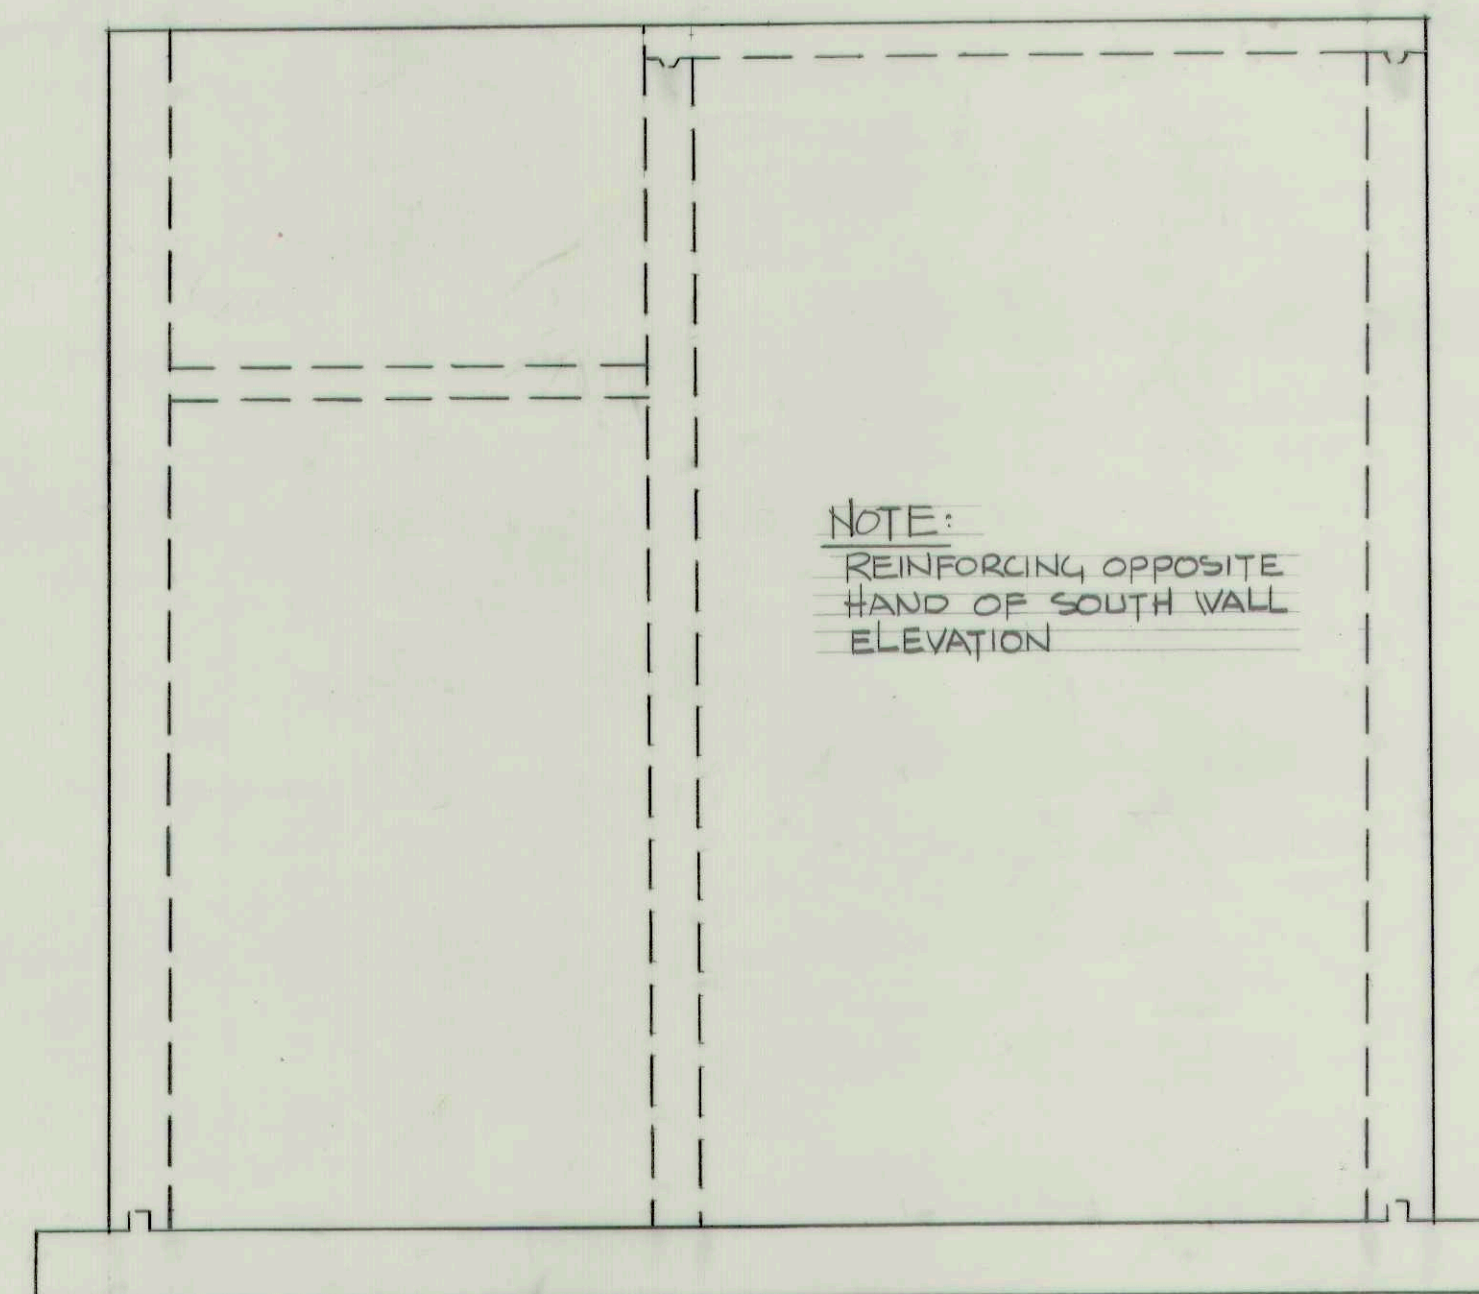


NORTH WALL ELEVATION
SCALE 1/4" = 1'-0"

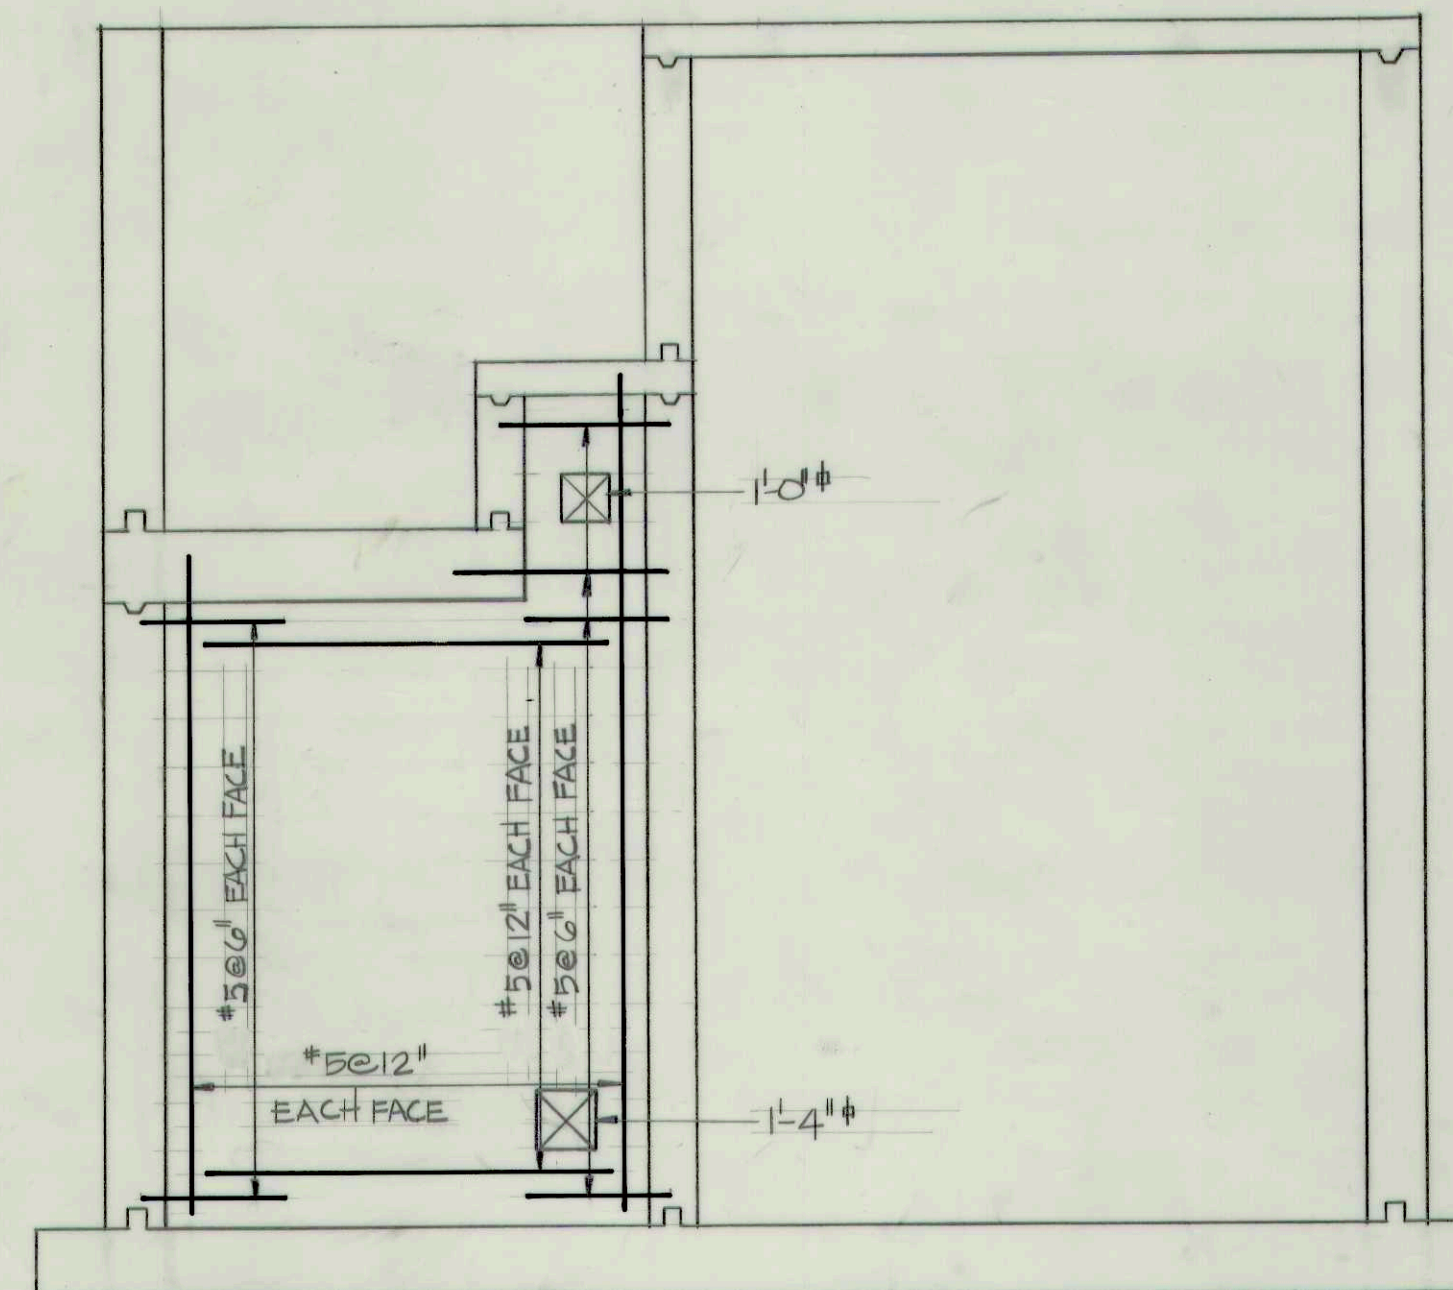

INTERIOR WALL, LOOKING SOUTH
SCALE 1/4" = 1'-0"

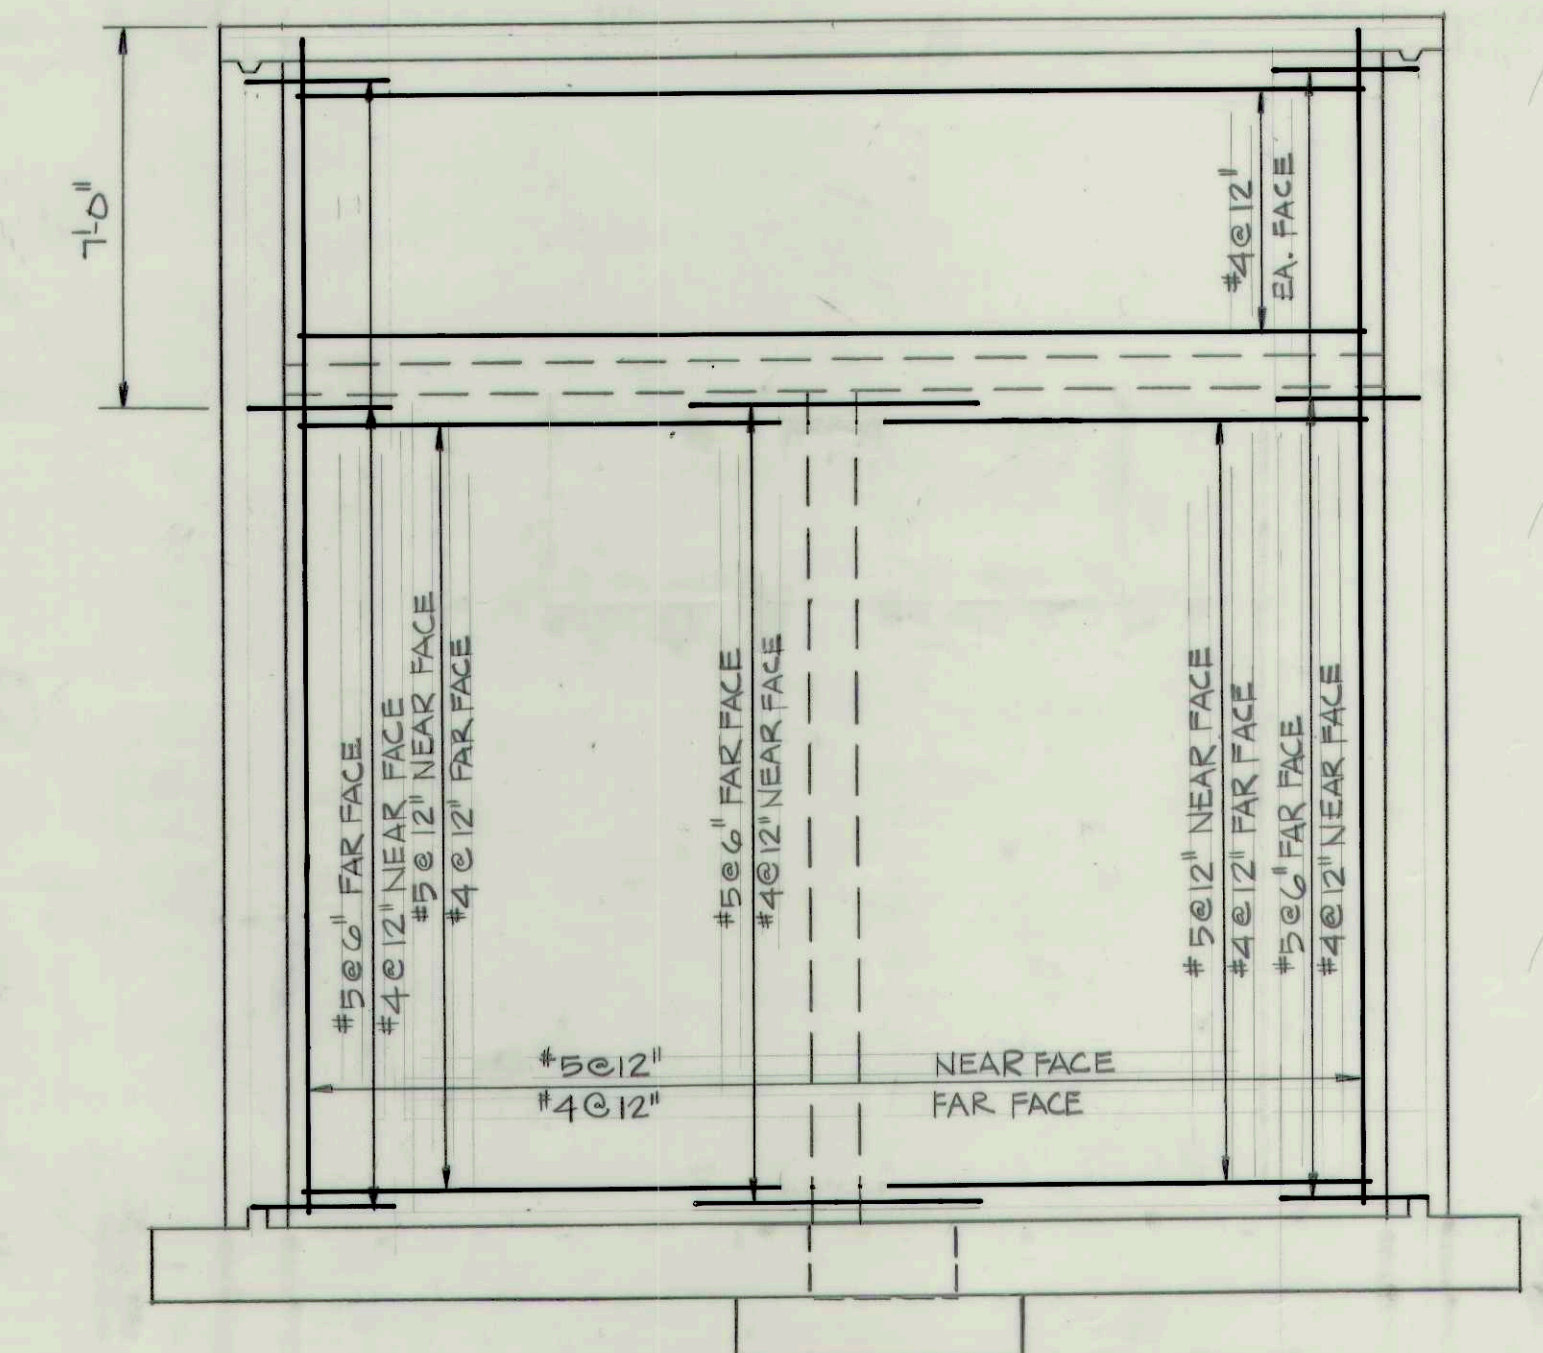

INTERIOR WALL, LOOKING EAST
SCALE 1/4" = 1'-0"

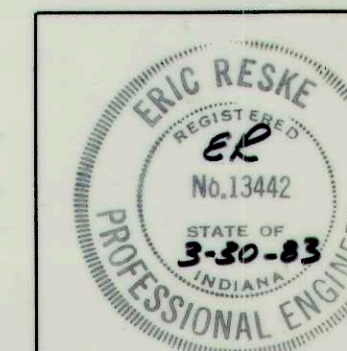

RECORD DRAWING

REFORMATORY LIFT STATION STRUCTURAL ELEVATIONS

Scale: AS NOTED	FALL CREEK R.W.D.	Sheet
Drawn By: GULLY	BEAM, LONGEST & NEFF	13
Designed By: R.W.	Consulting Engineers	
Certified By: ER	8136 Castleton Road	
	Indianapolis, IN 46250	