




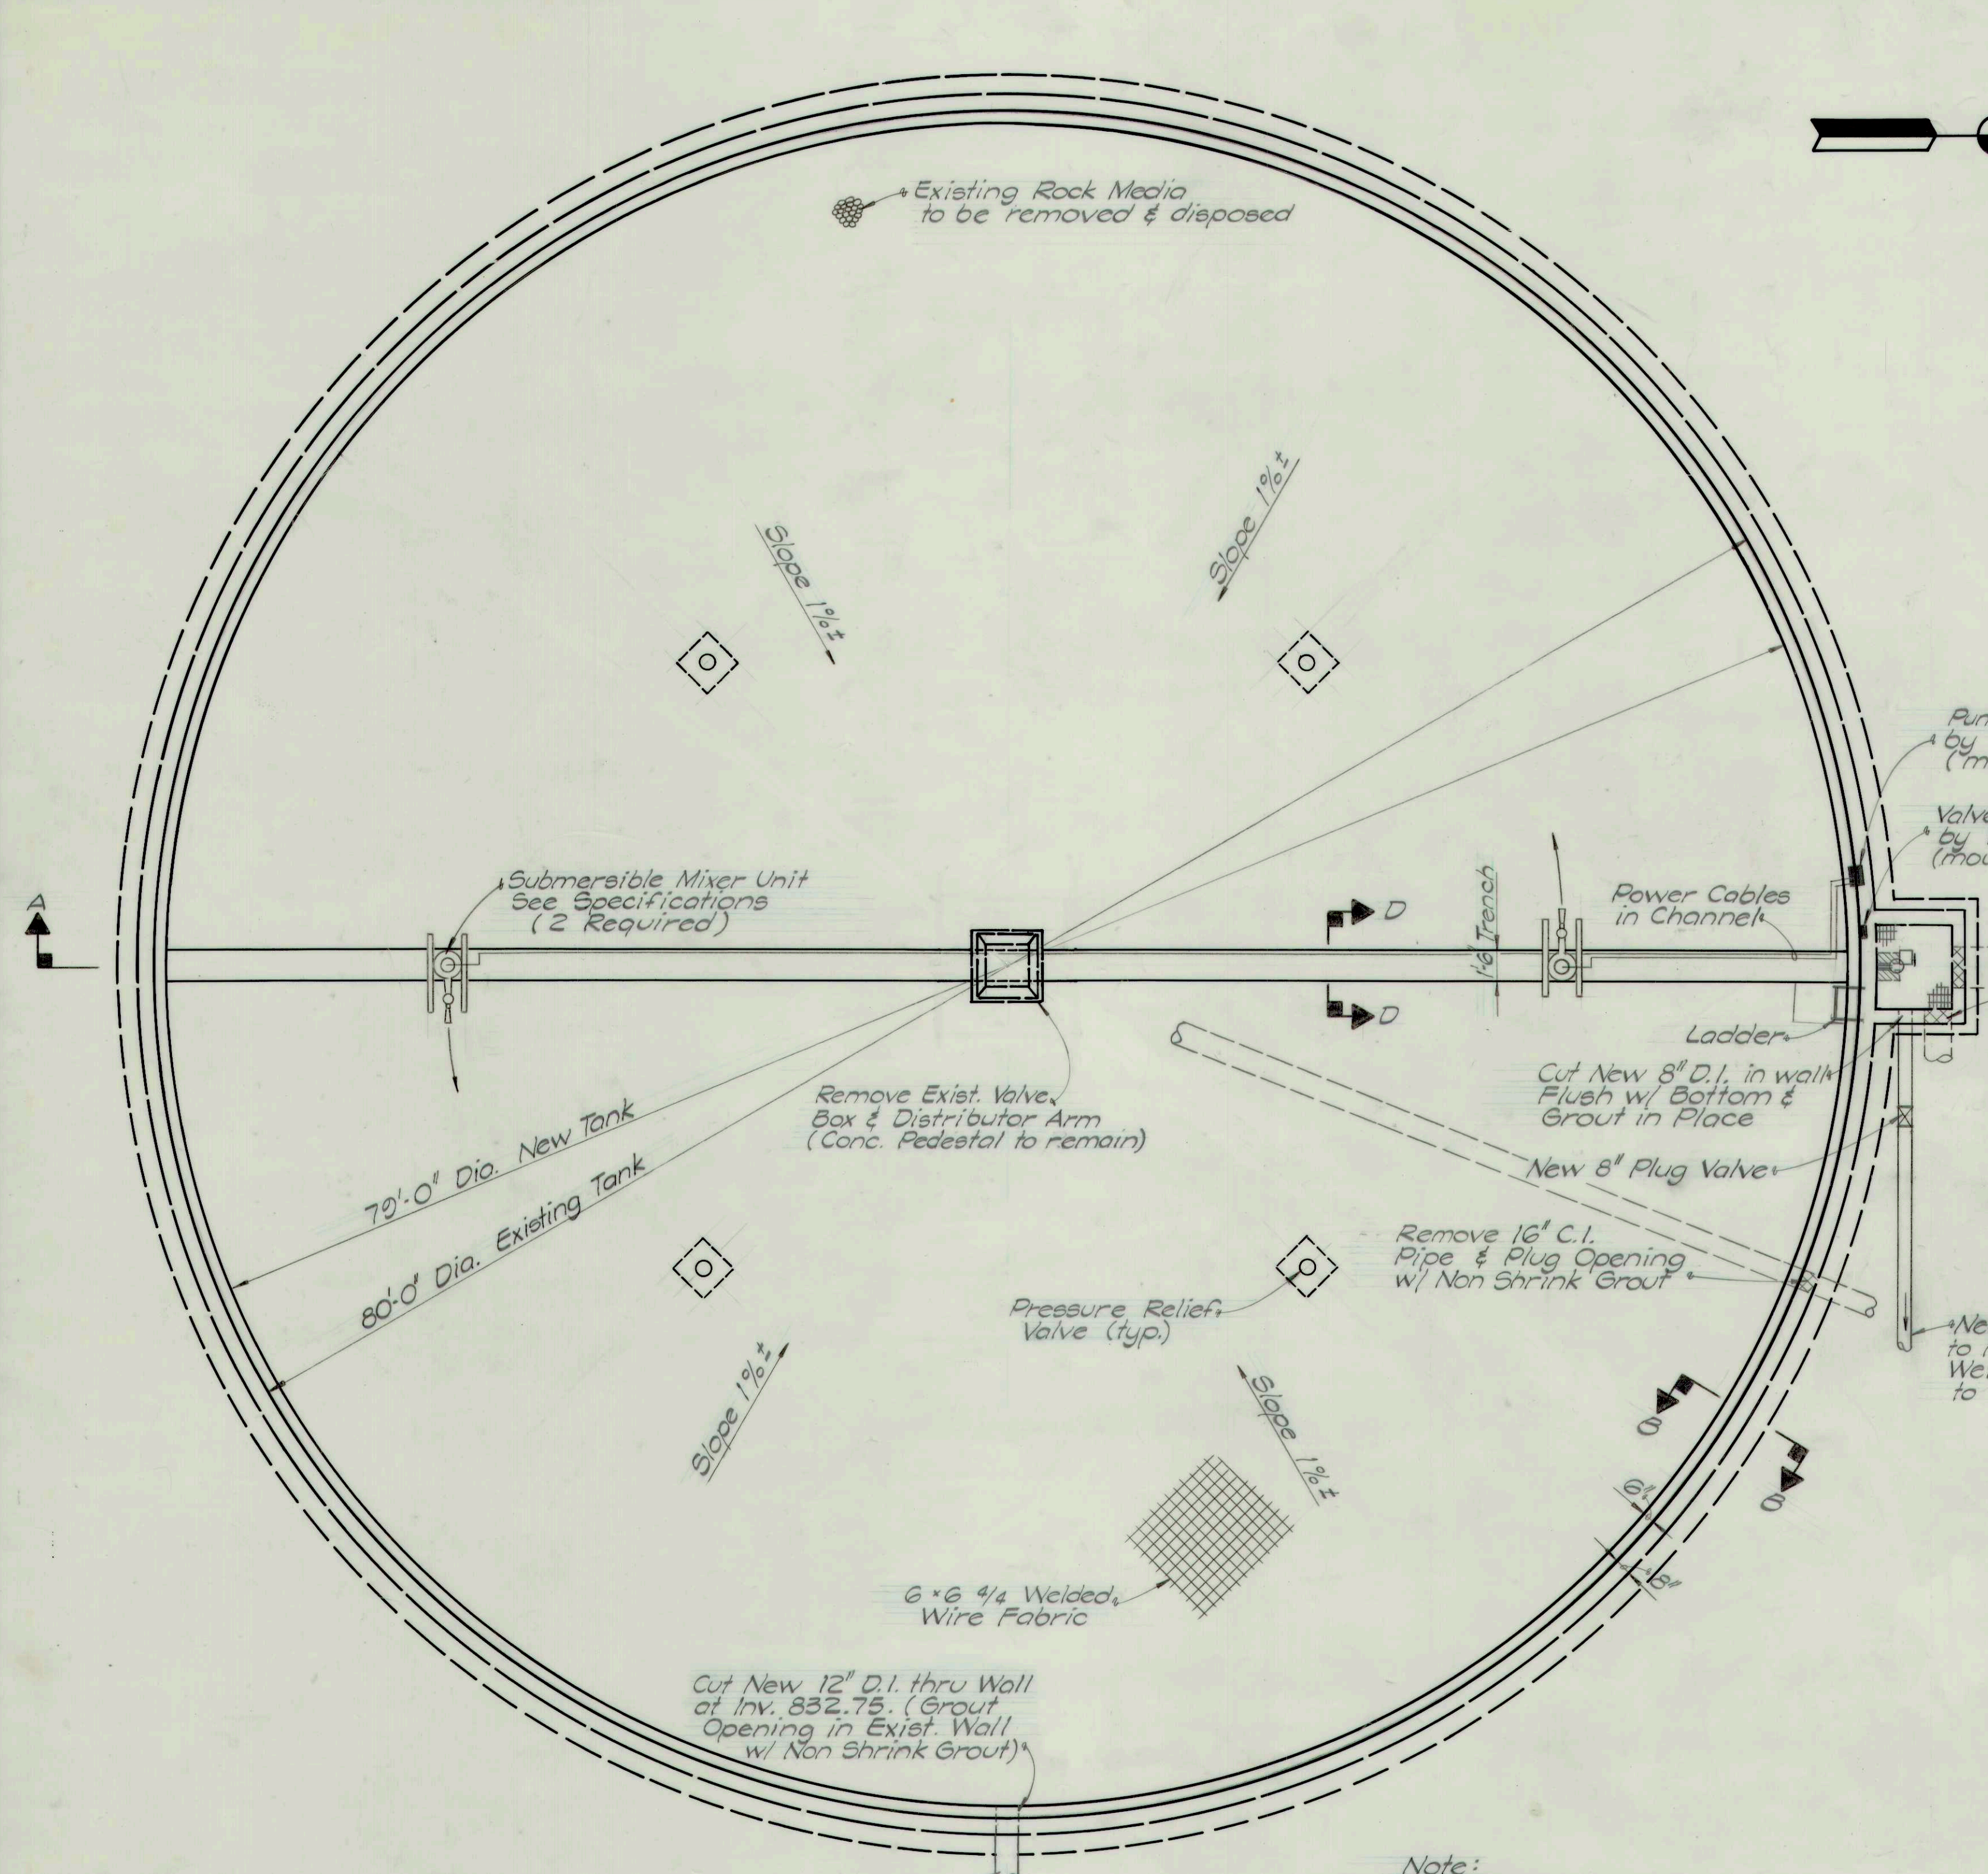


PLAN
Scale: 3/16" = 1'-0"

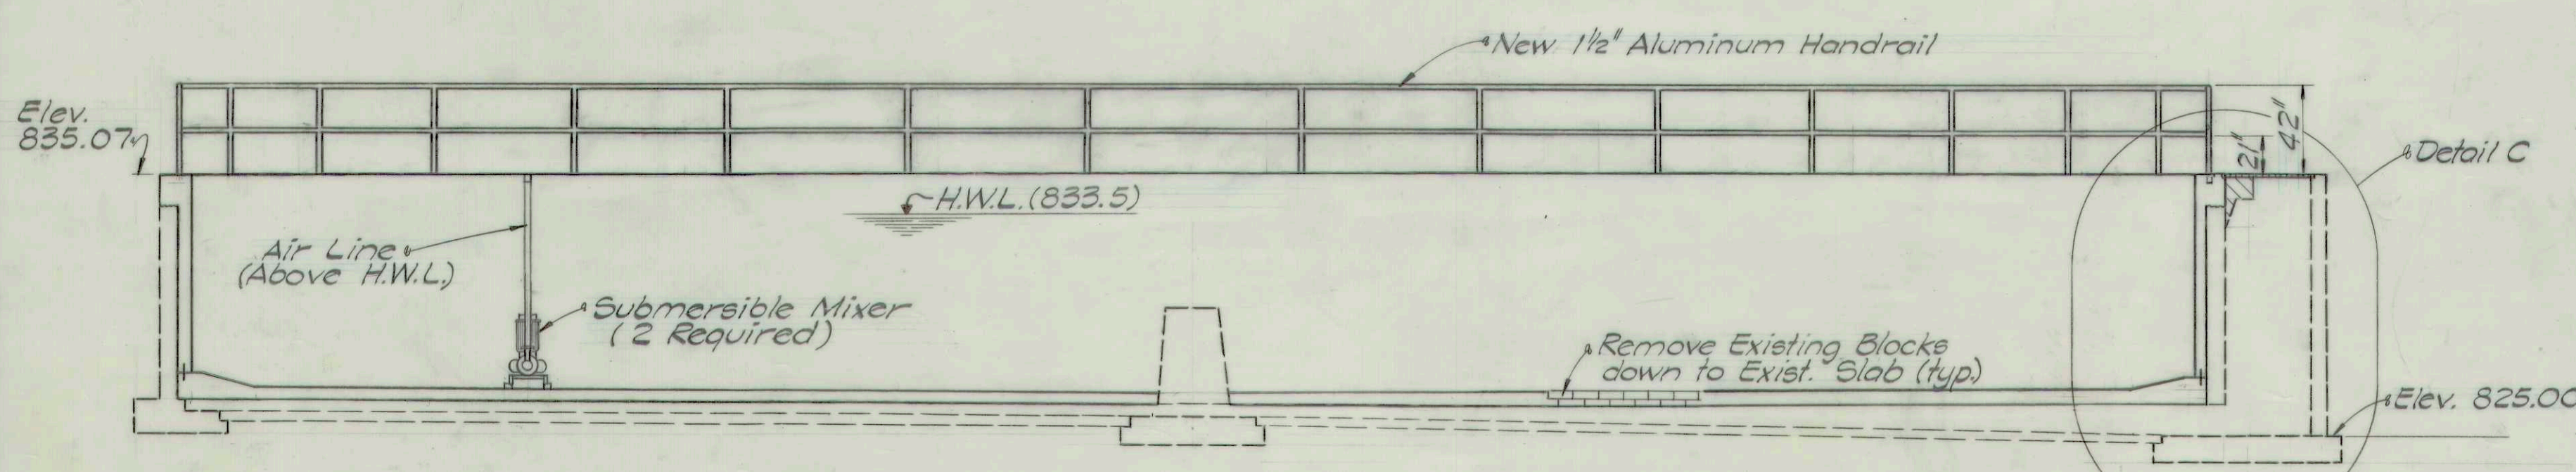


SECTION A-A
Scale: 3/16" = 1'-0"

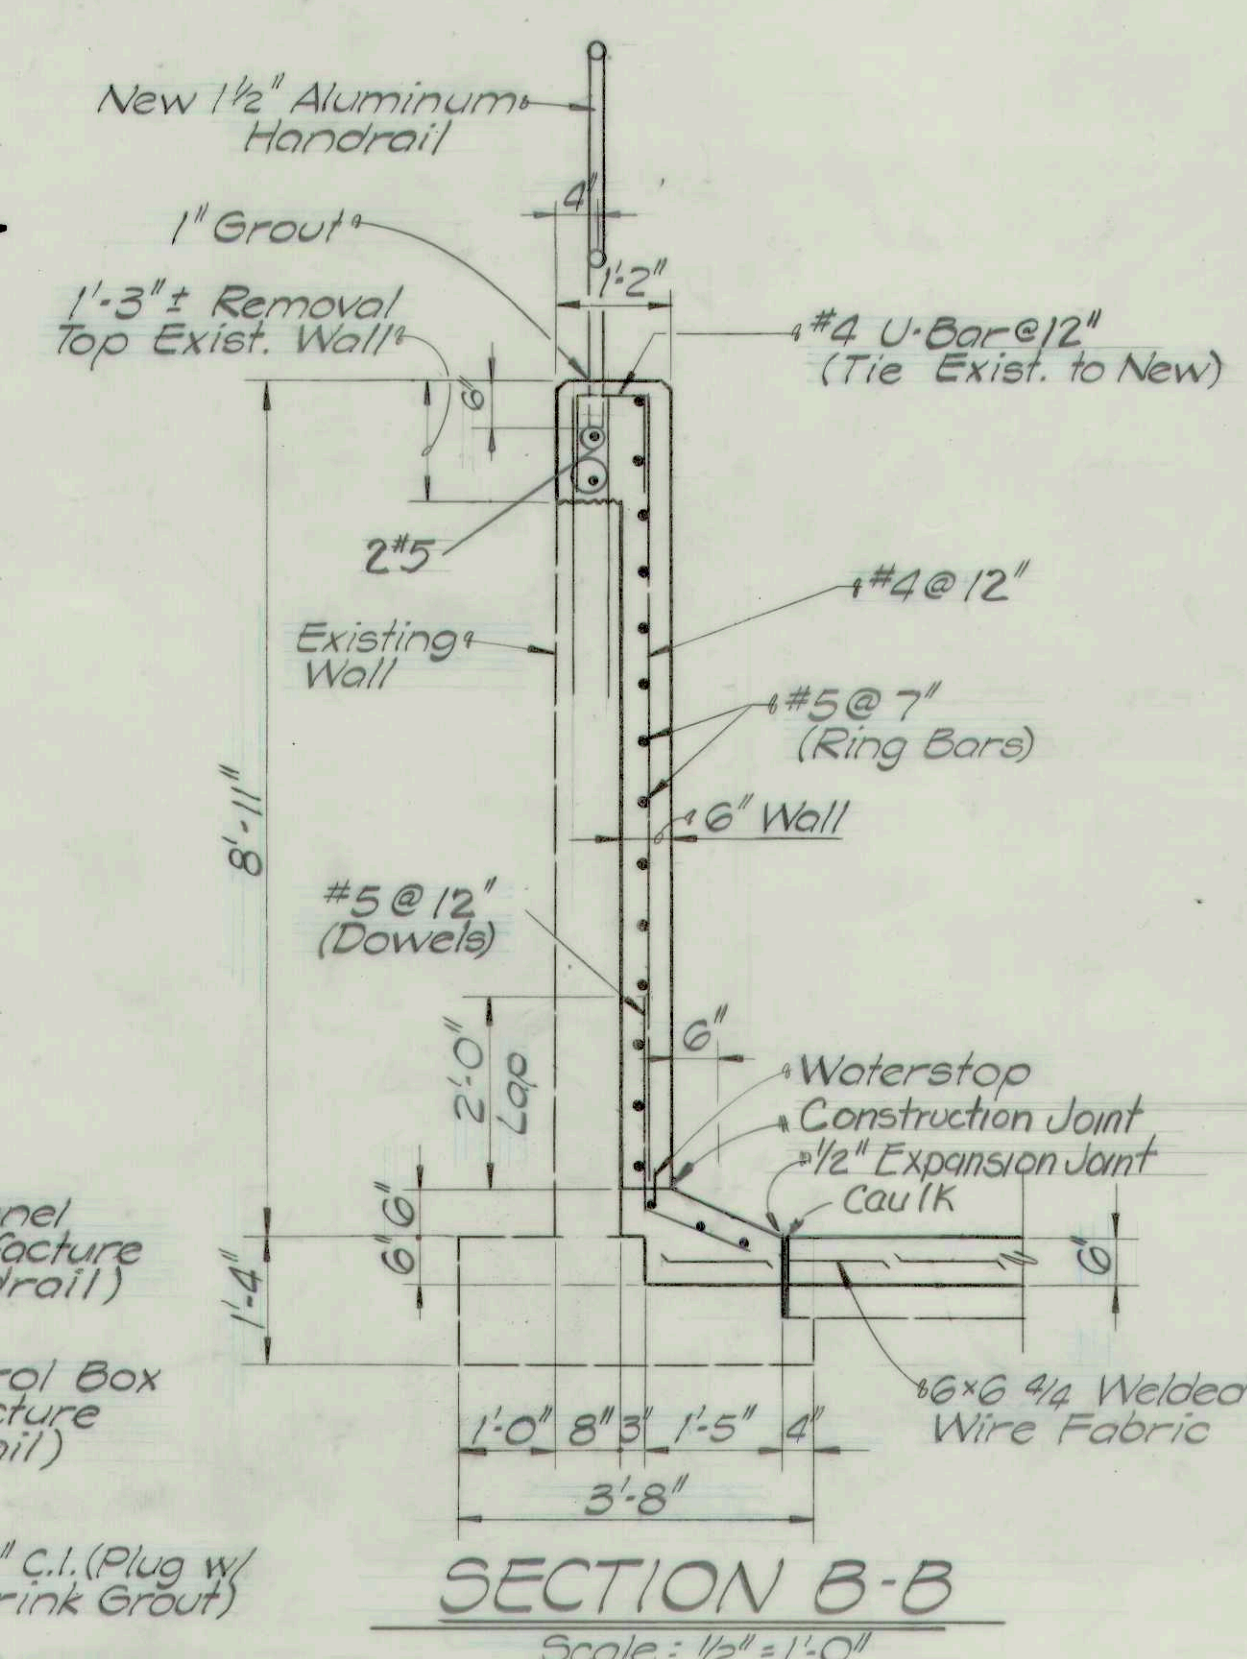


SECTION B-B
Scale: 1/2" = 1'-0"

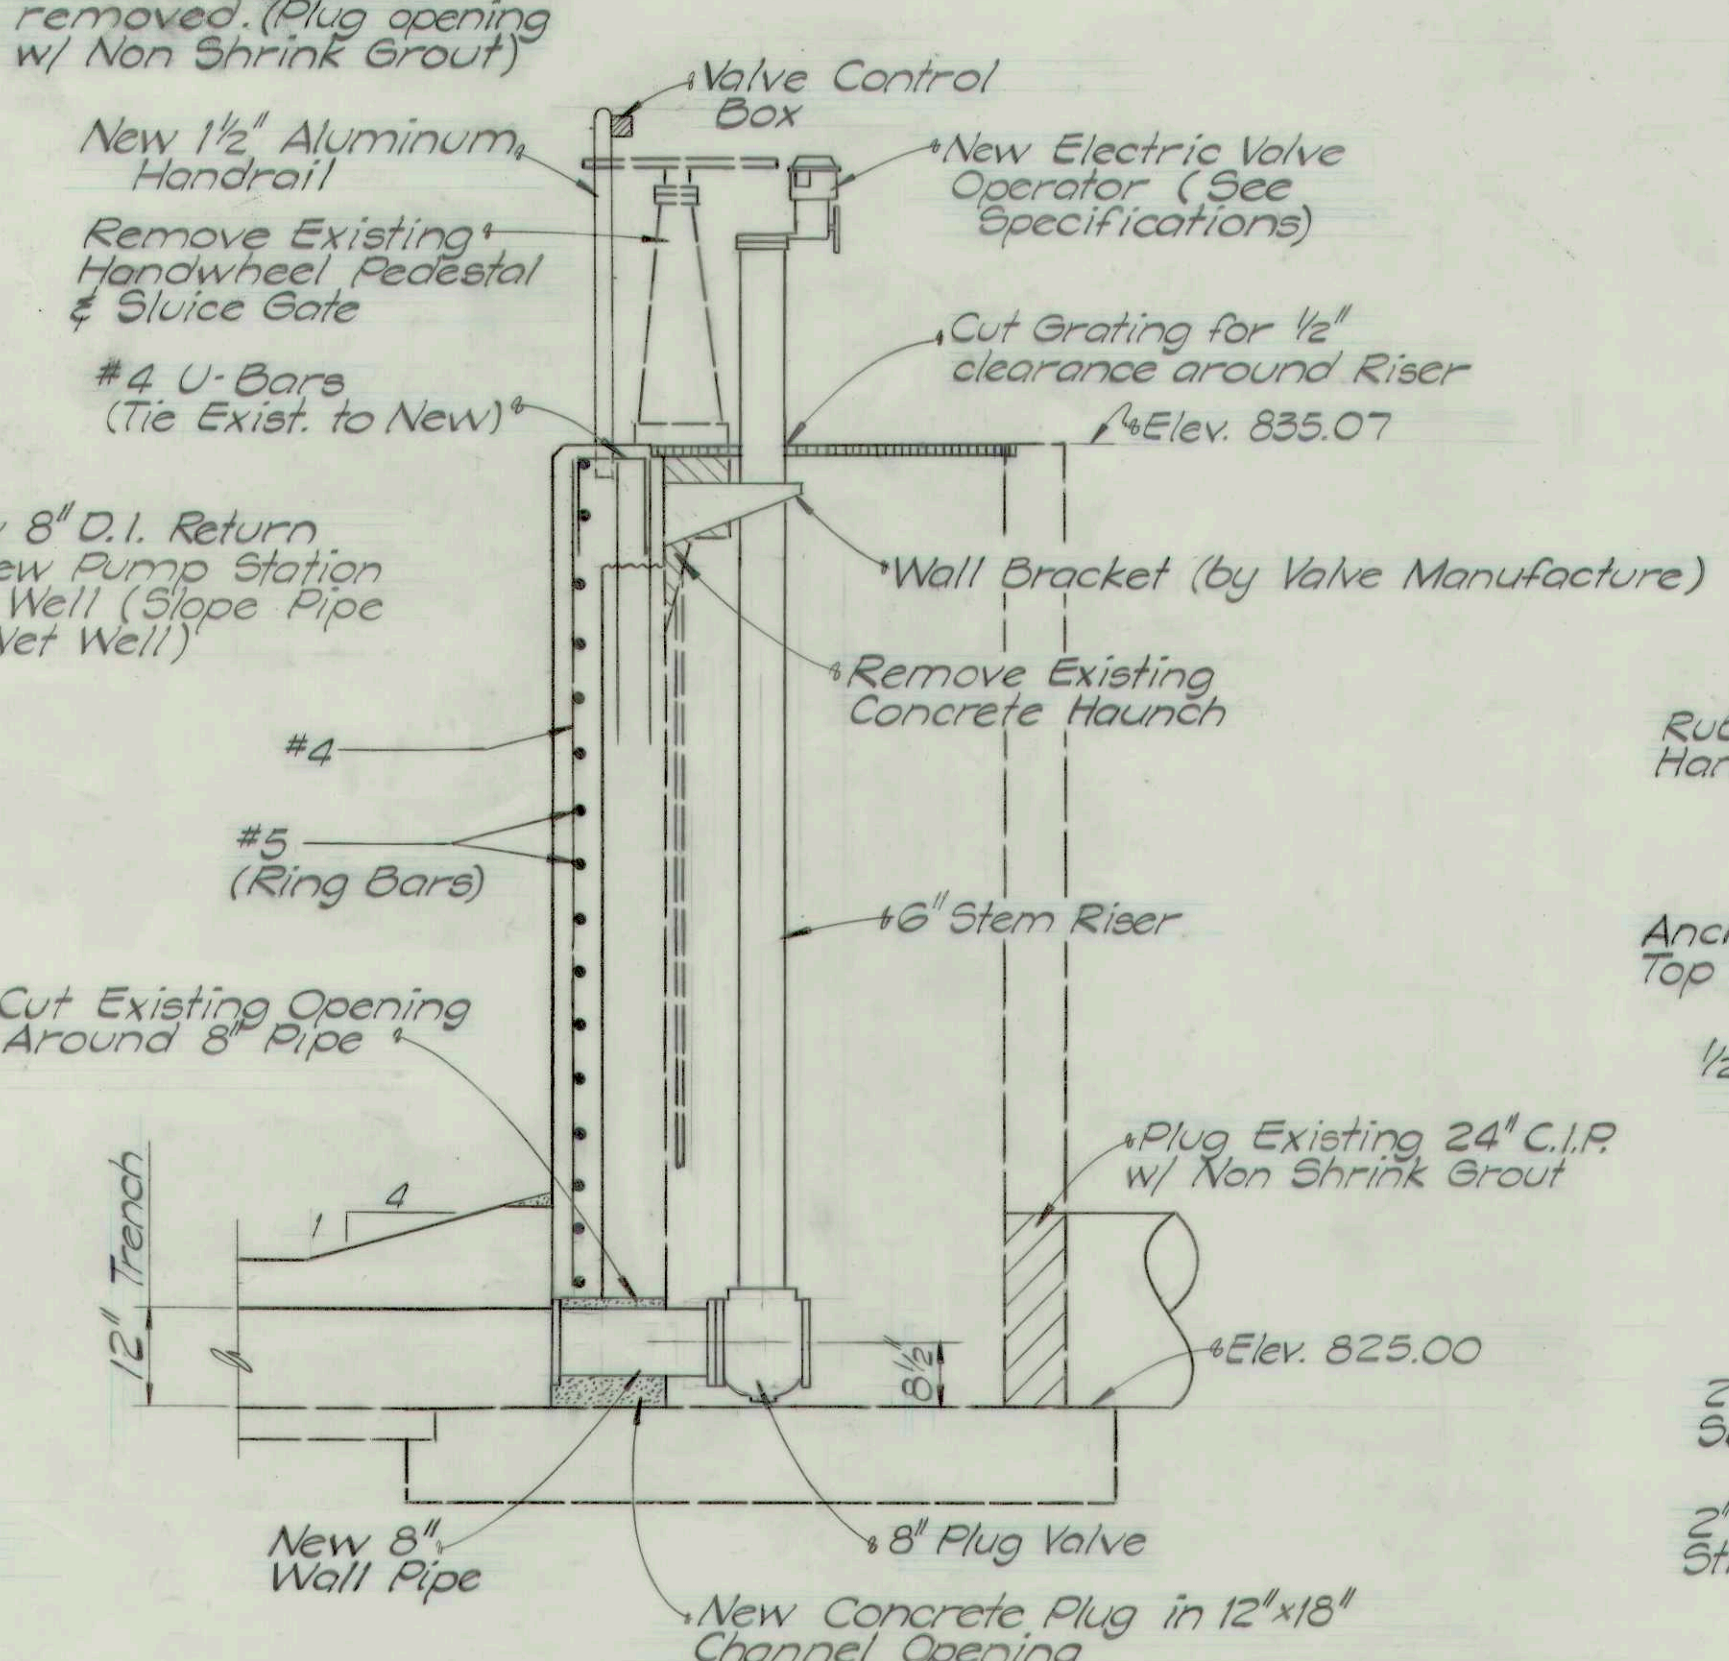


DETAIL C
Scale: 1/2" = 1'-0"

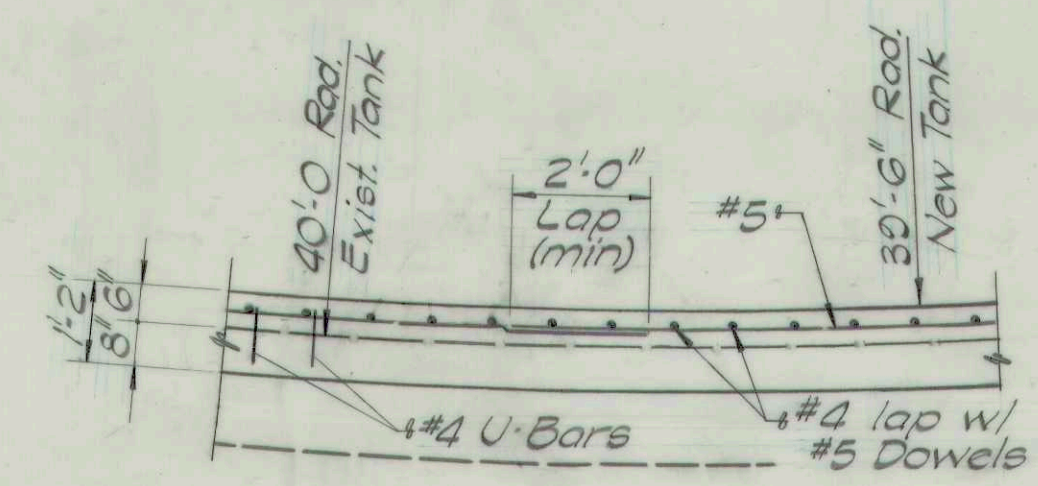


PARTIAL PLAN
Scale: 3/8" = 1'-0"

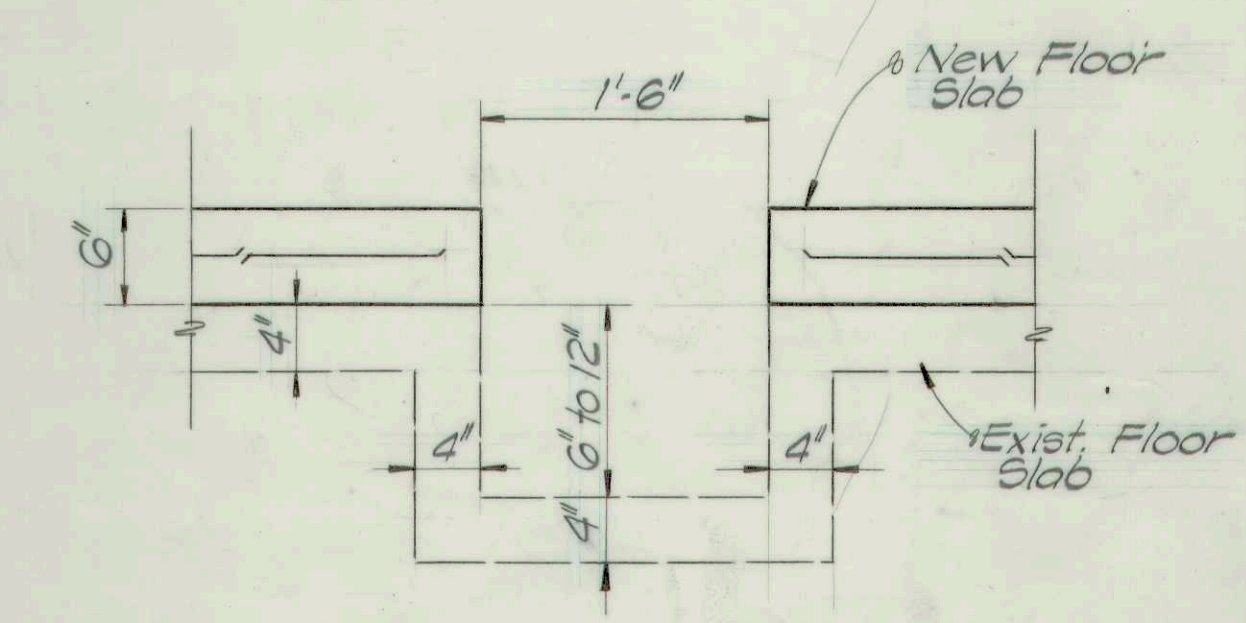

SECTION D-D
Scale: 1" = 1'-0"

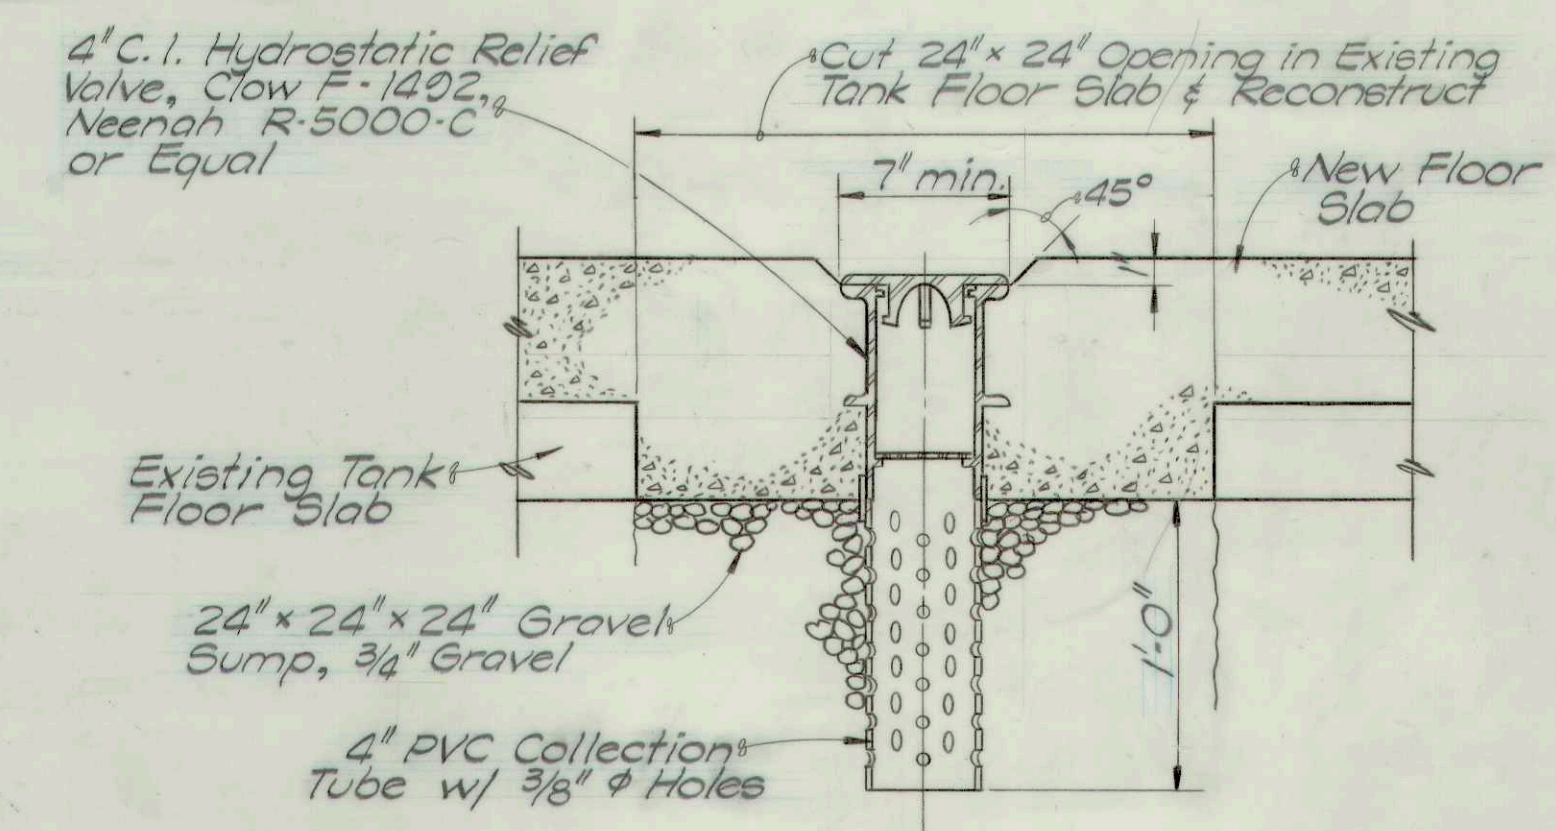

PRESSURE RELIEF VALVE DETAIL
4 Req'd.

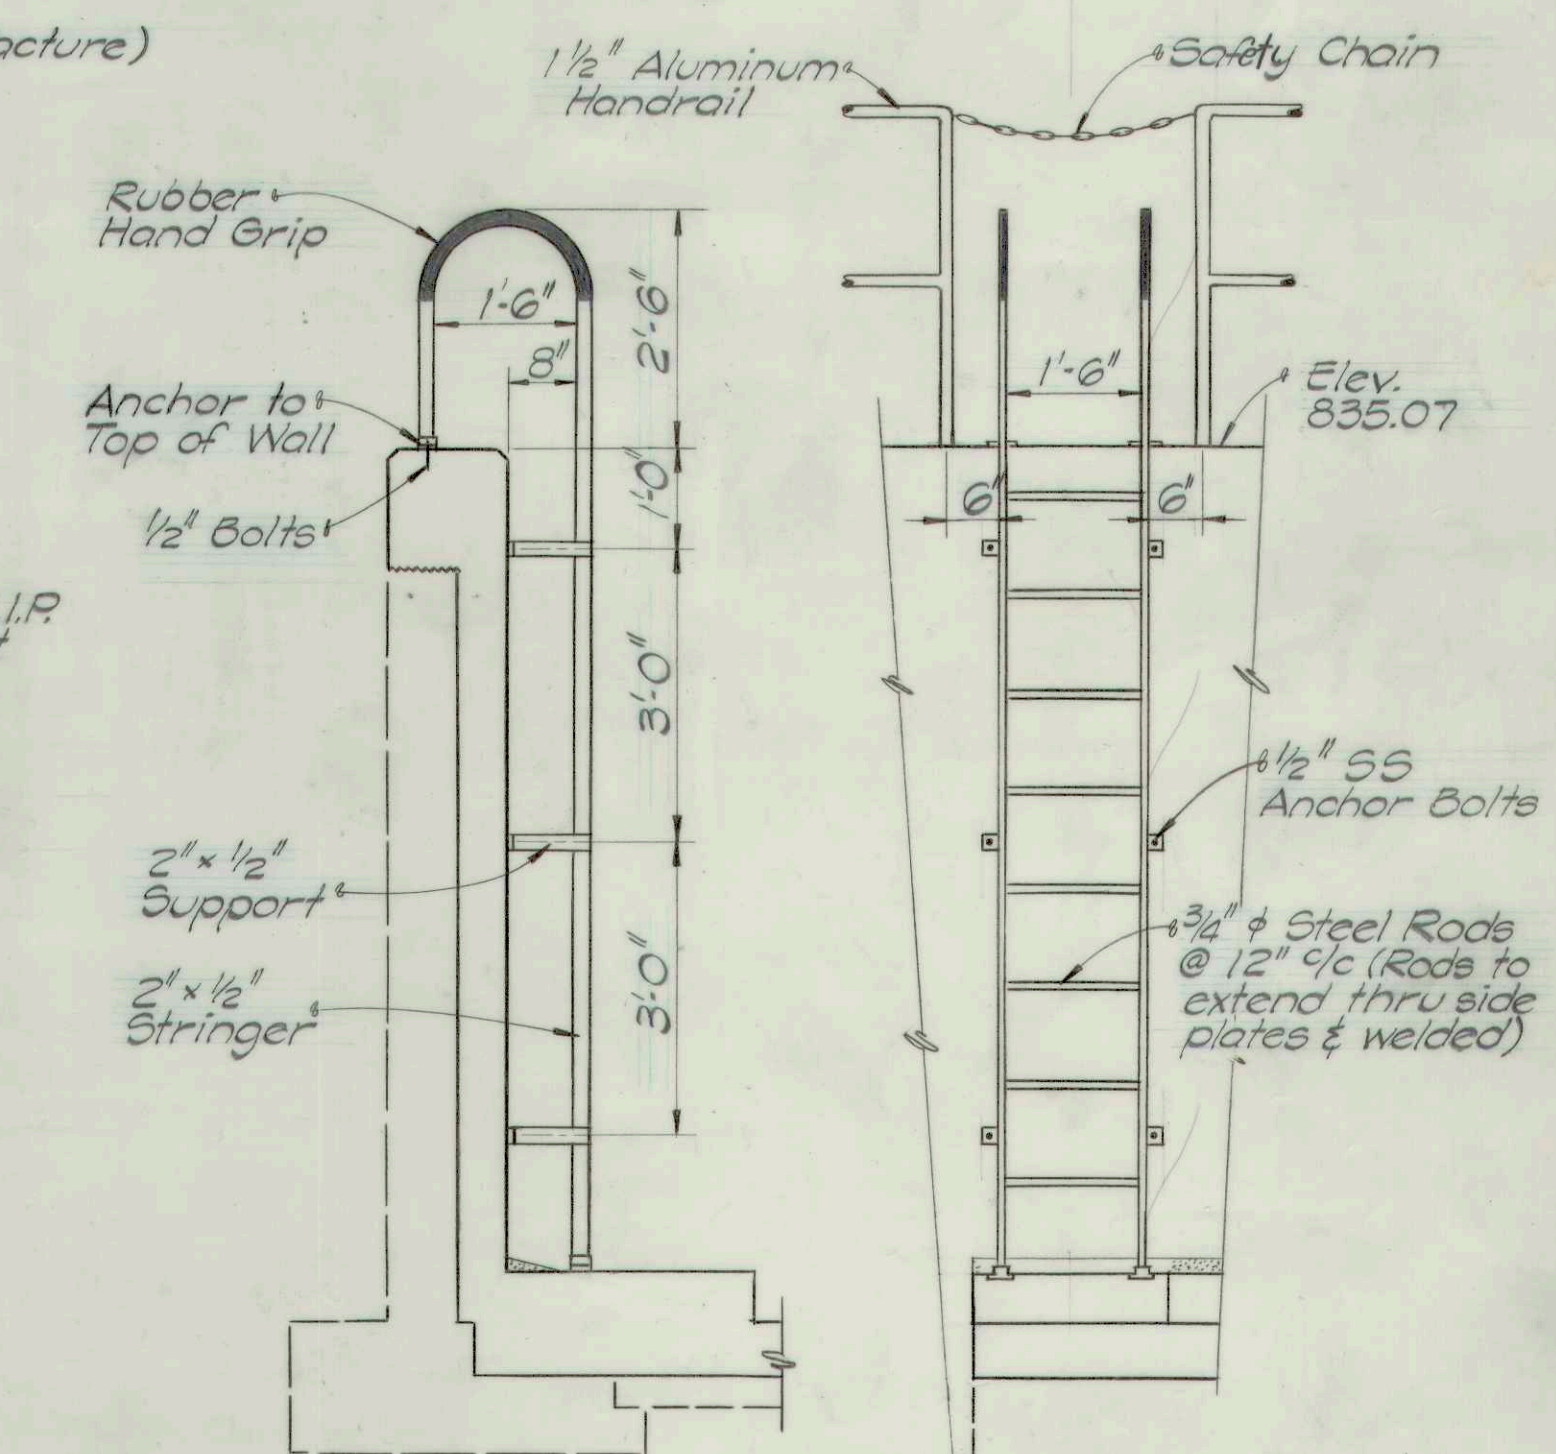

LADDER DETAILS
Scale: 1/2" = 1'-0"

RECORD DRAWING
SURGE HOLDING TANK
(EXIST. REFORMATORY TRICKLE FILTER)

Scale: As Noted	FALL CREEK R.W.D.	Sheet
Drawn By: DG	BEAM, LONGEST & NEFF	75
Designed By: RFS, J.P.	Consulting Engineers 8136 Castleton Road Indianapolis, IN 46250	
Certified By: E.R.		

