

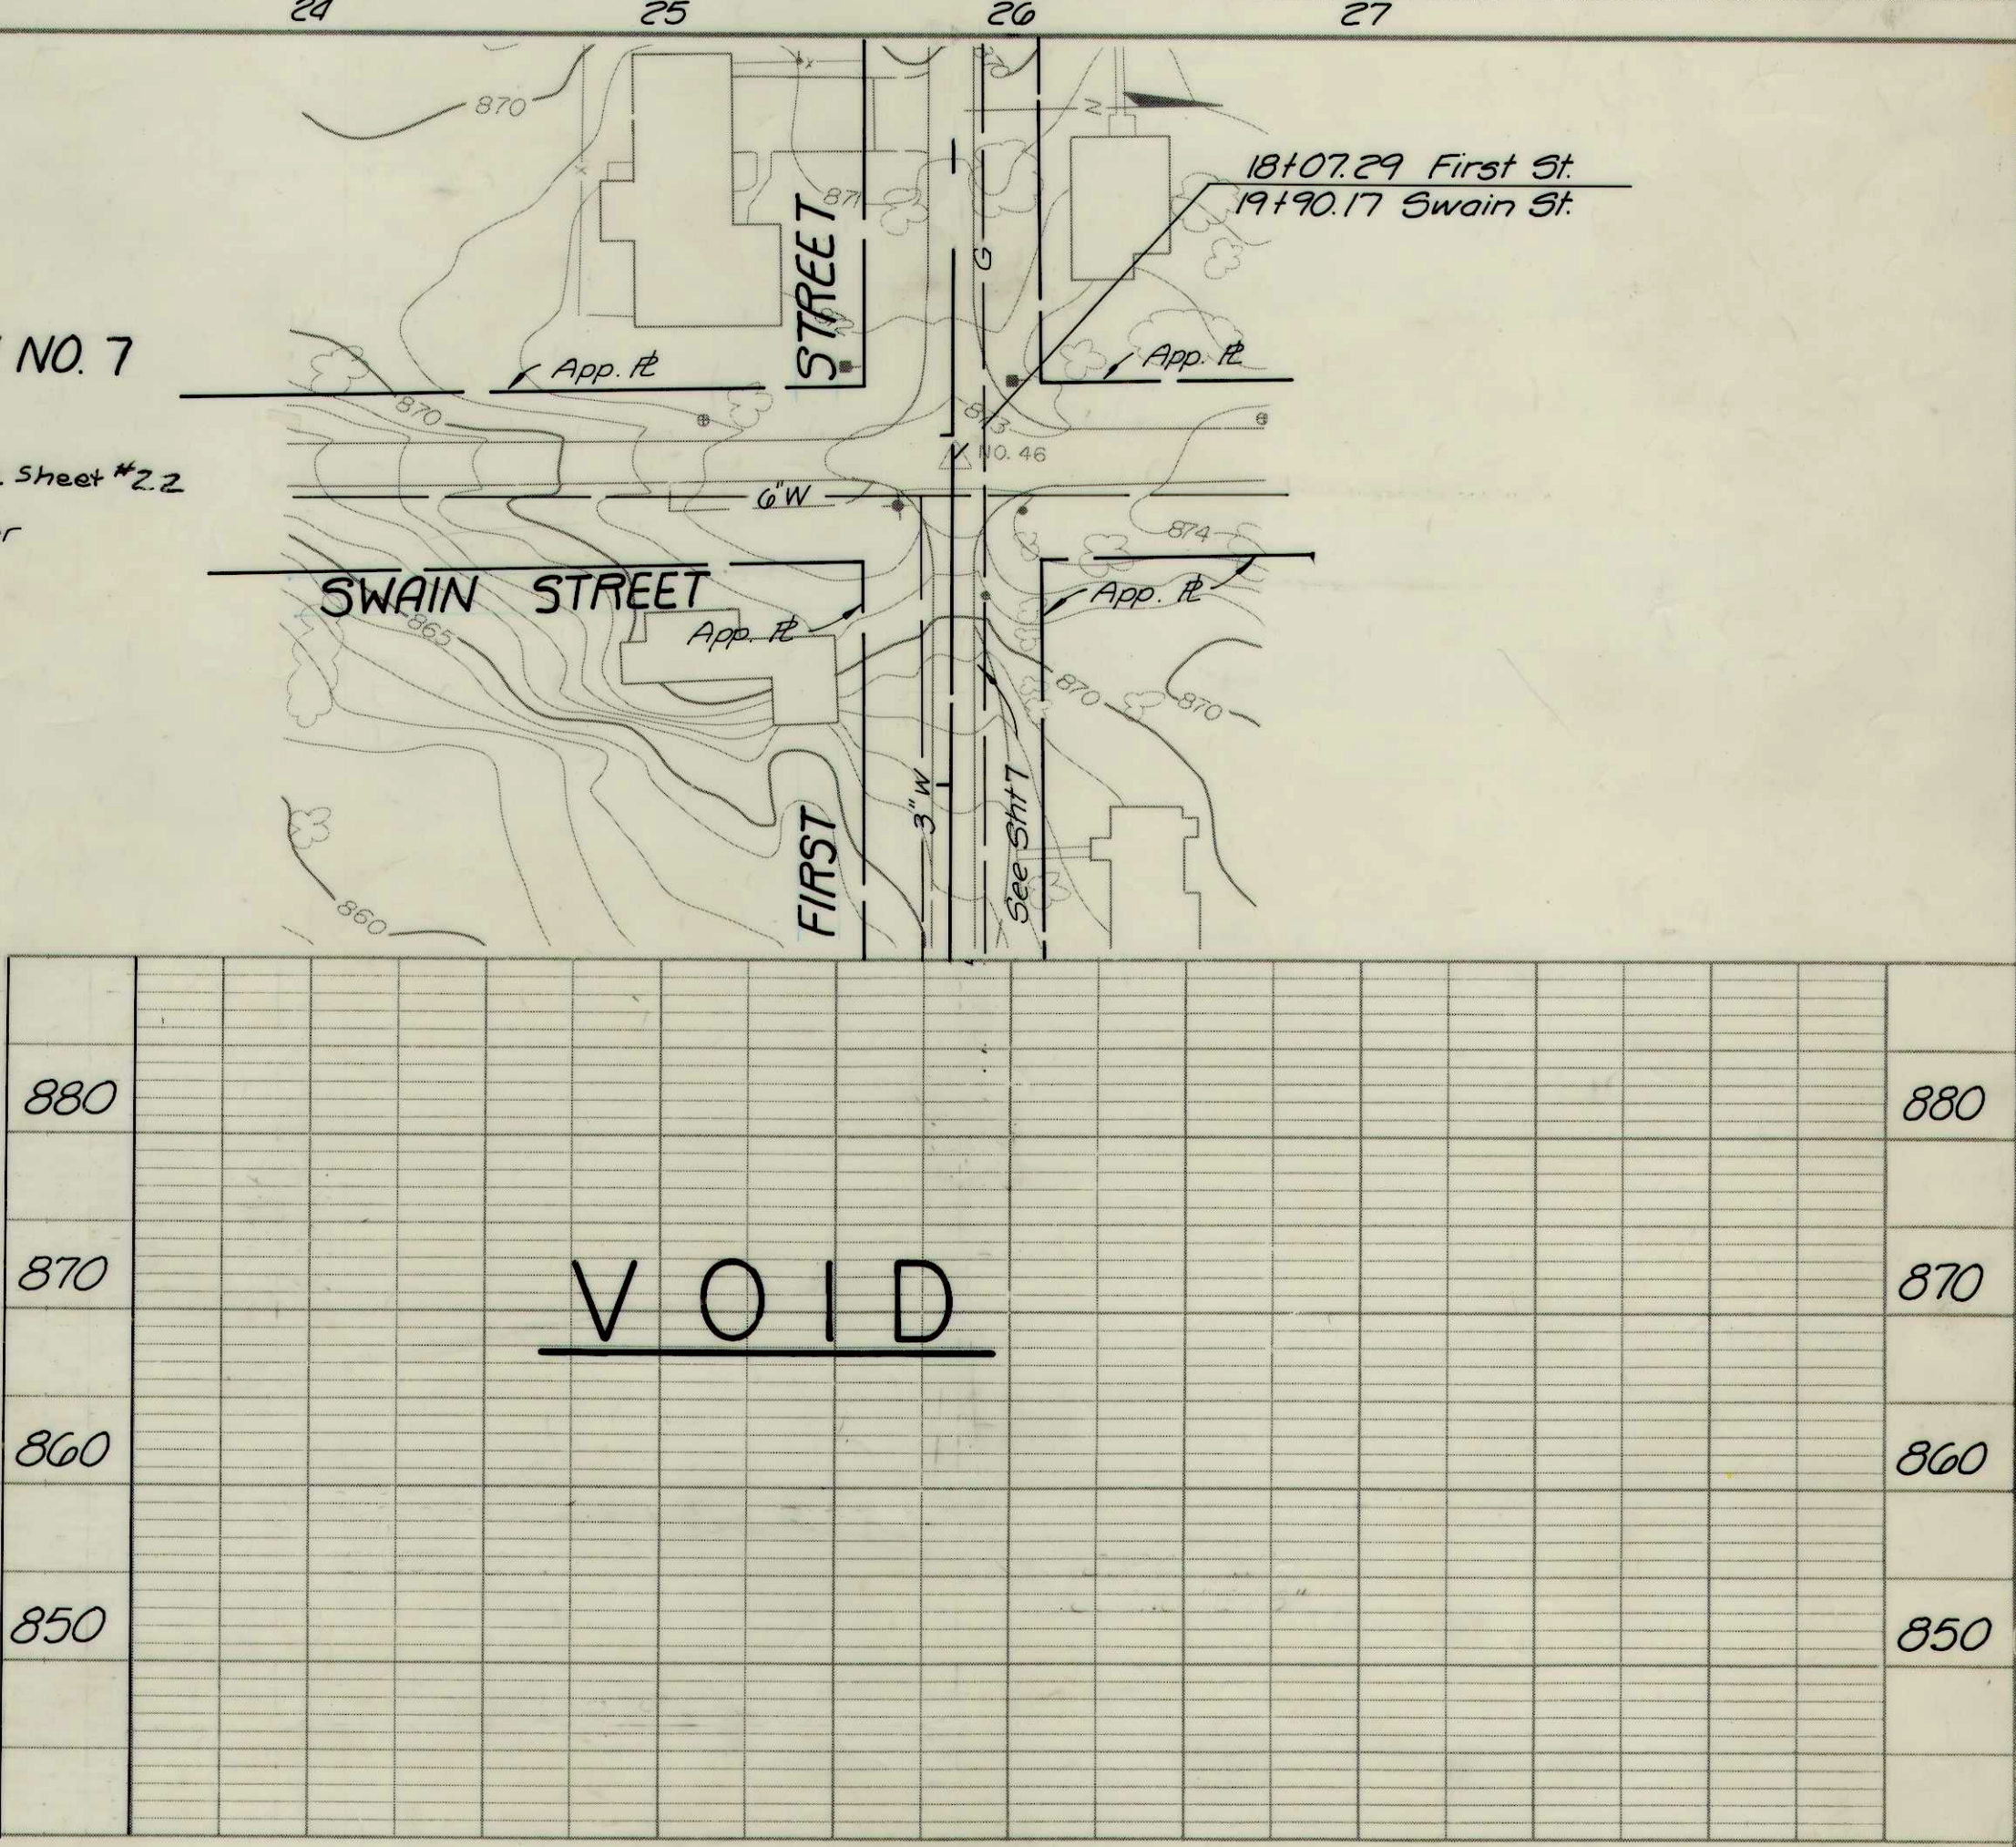
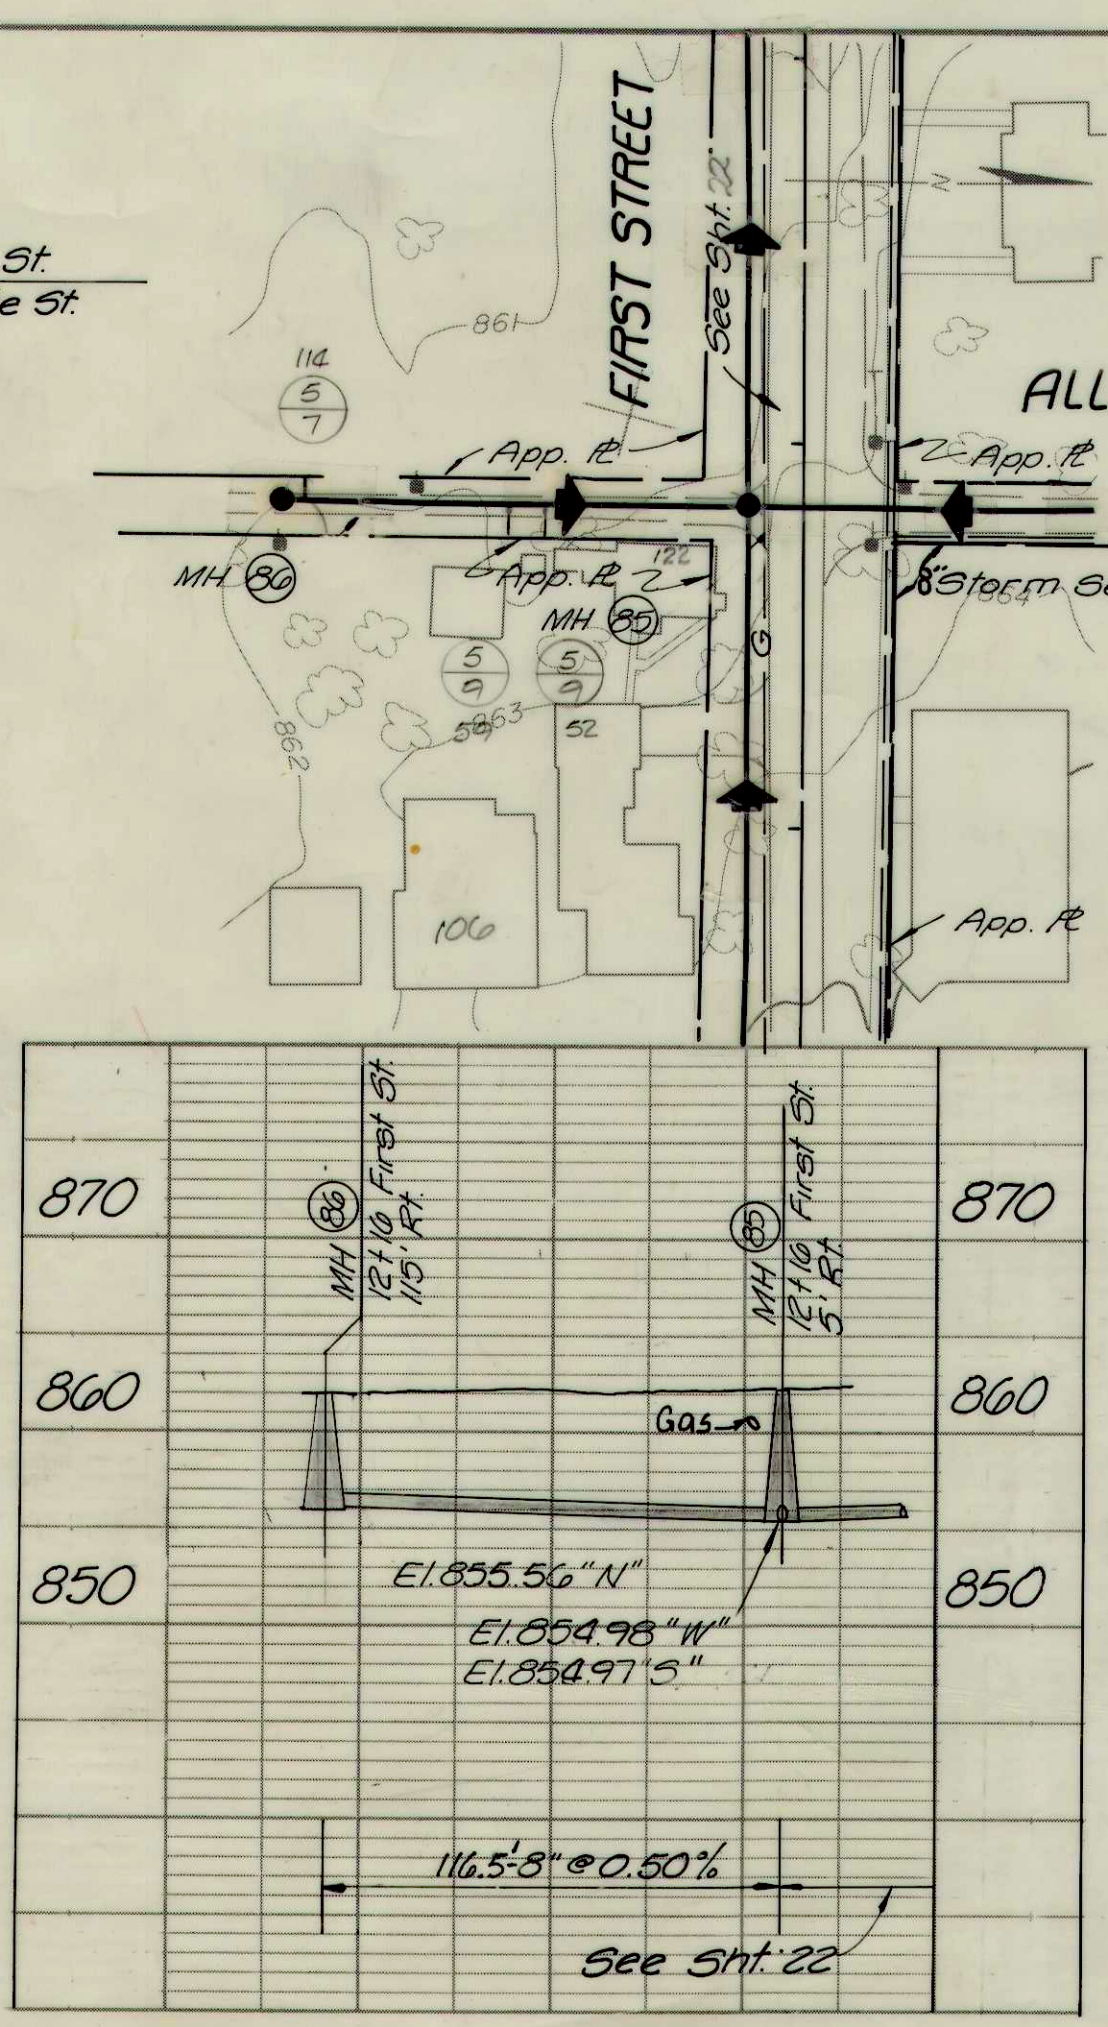
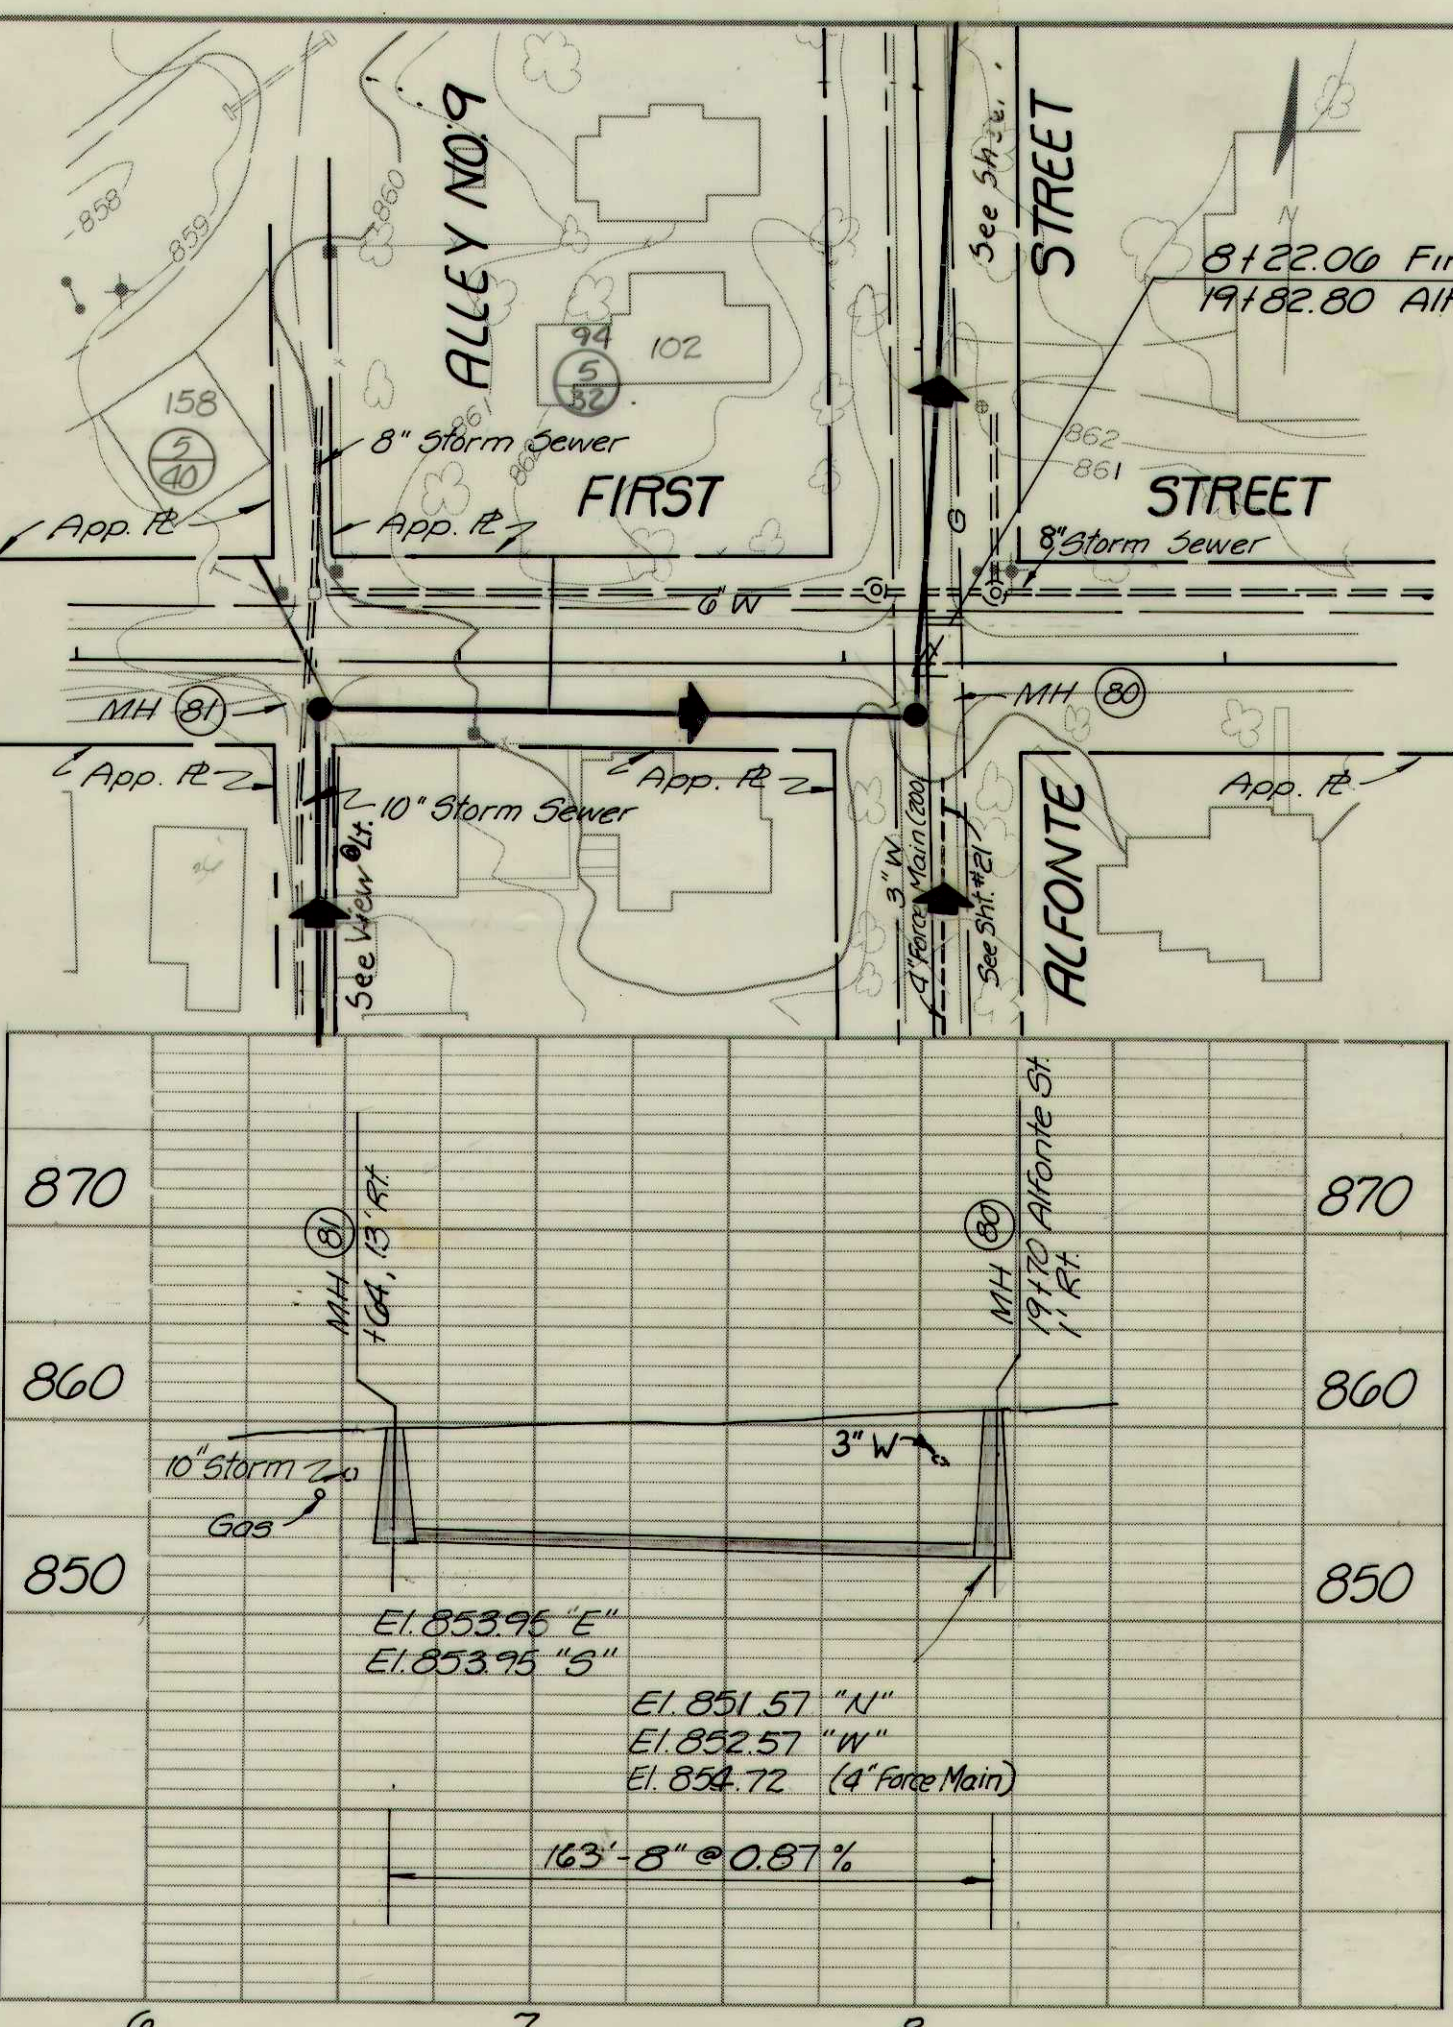
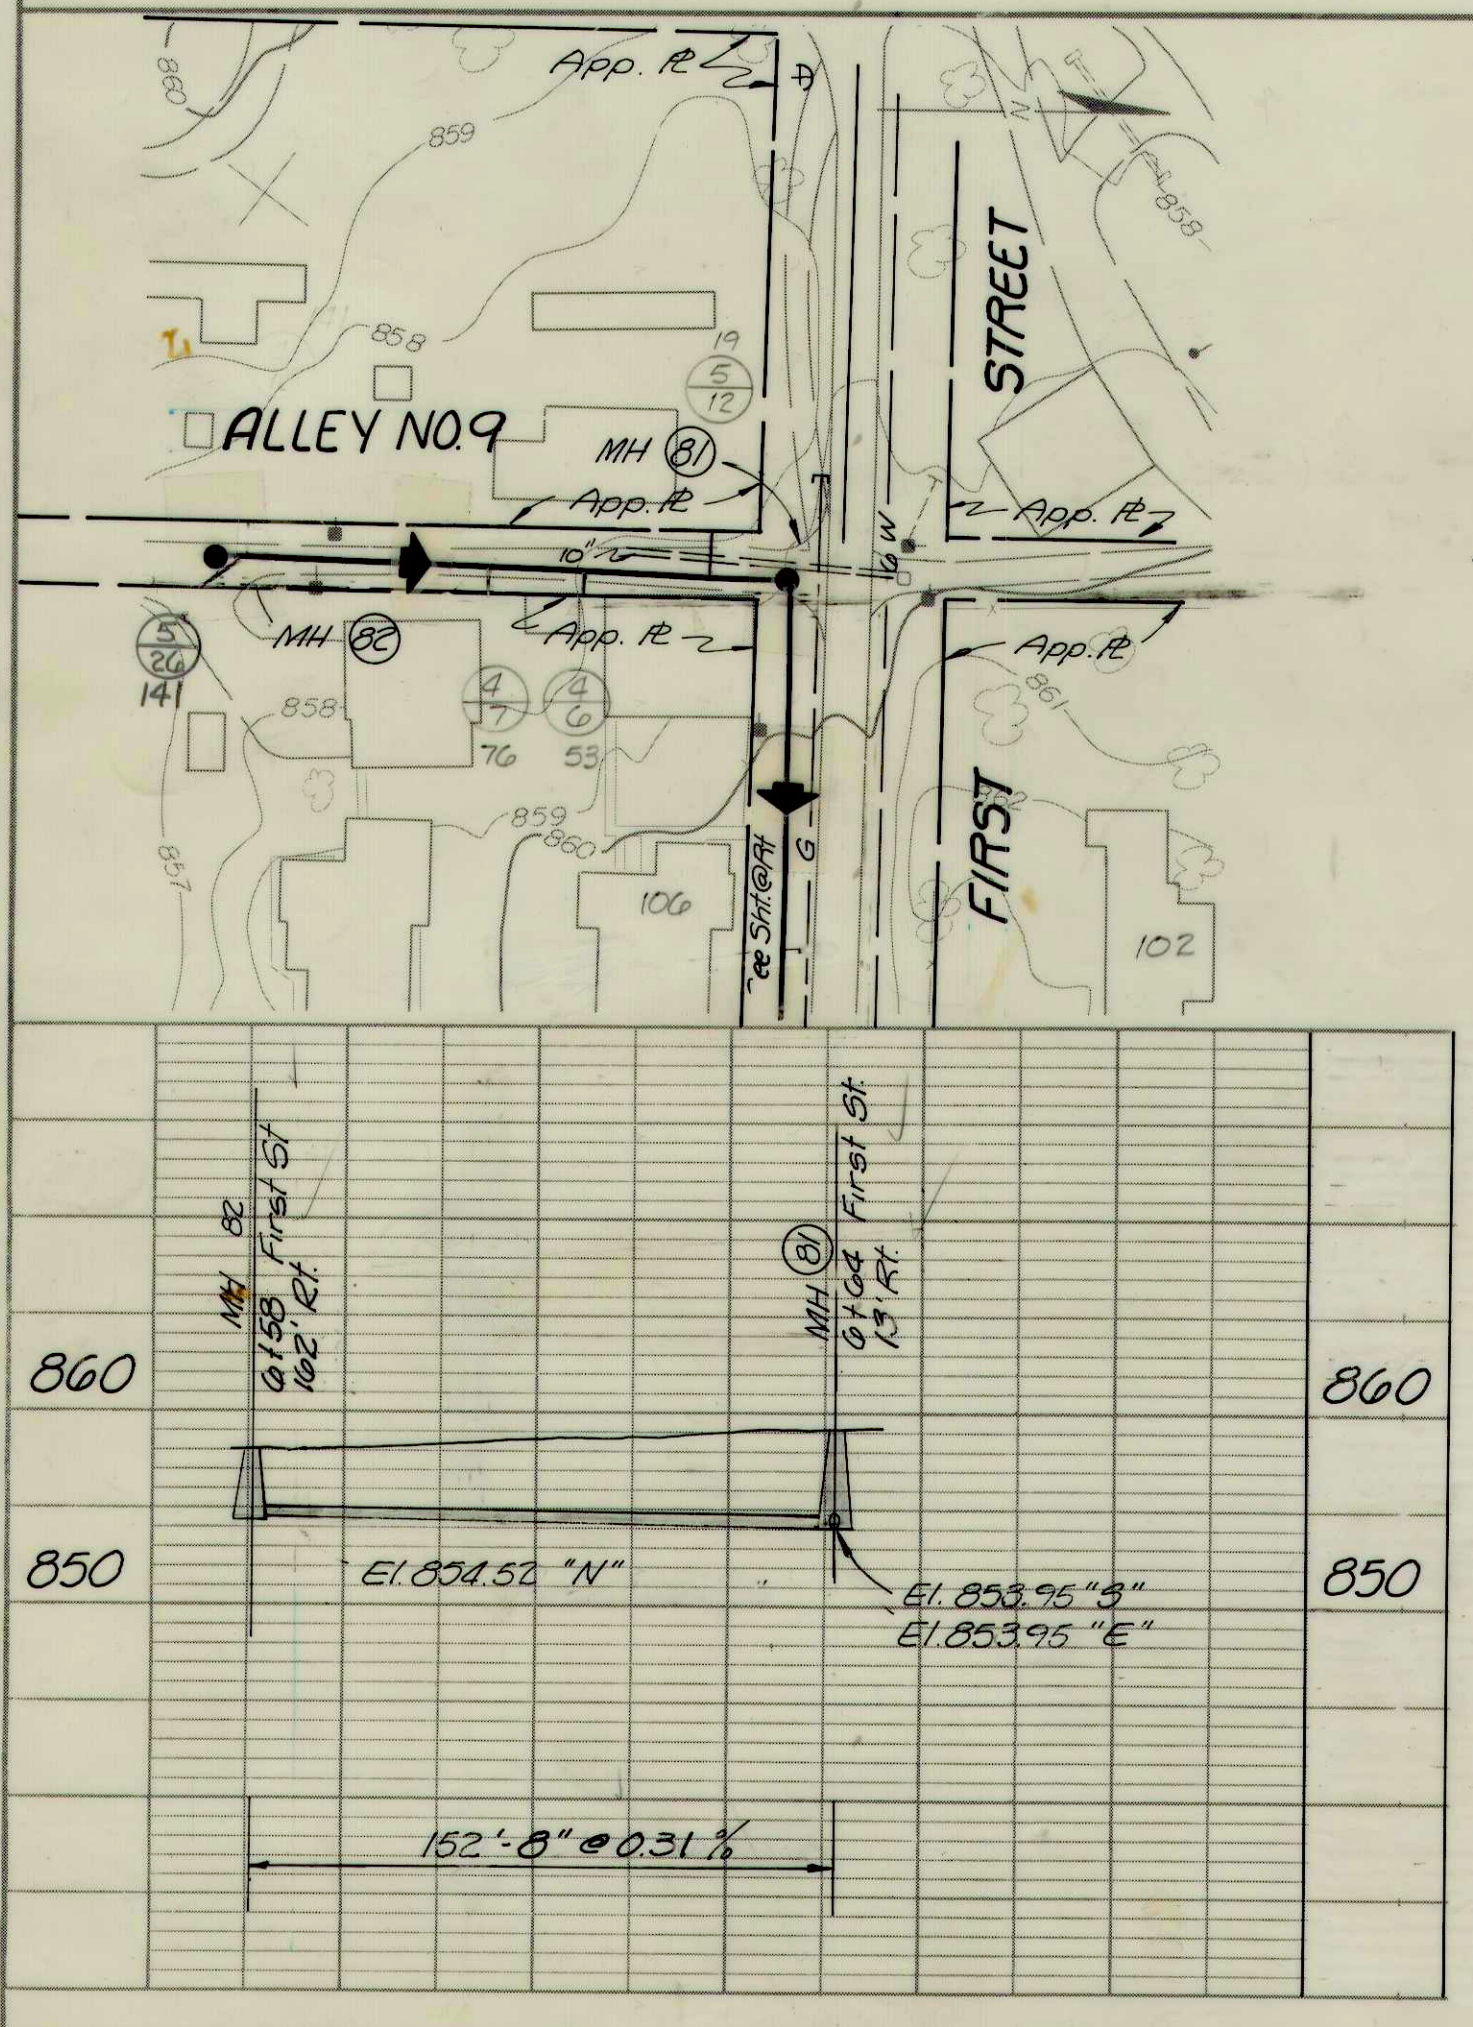
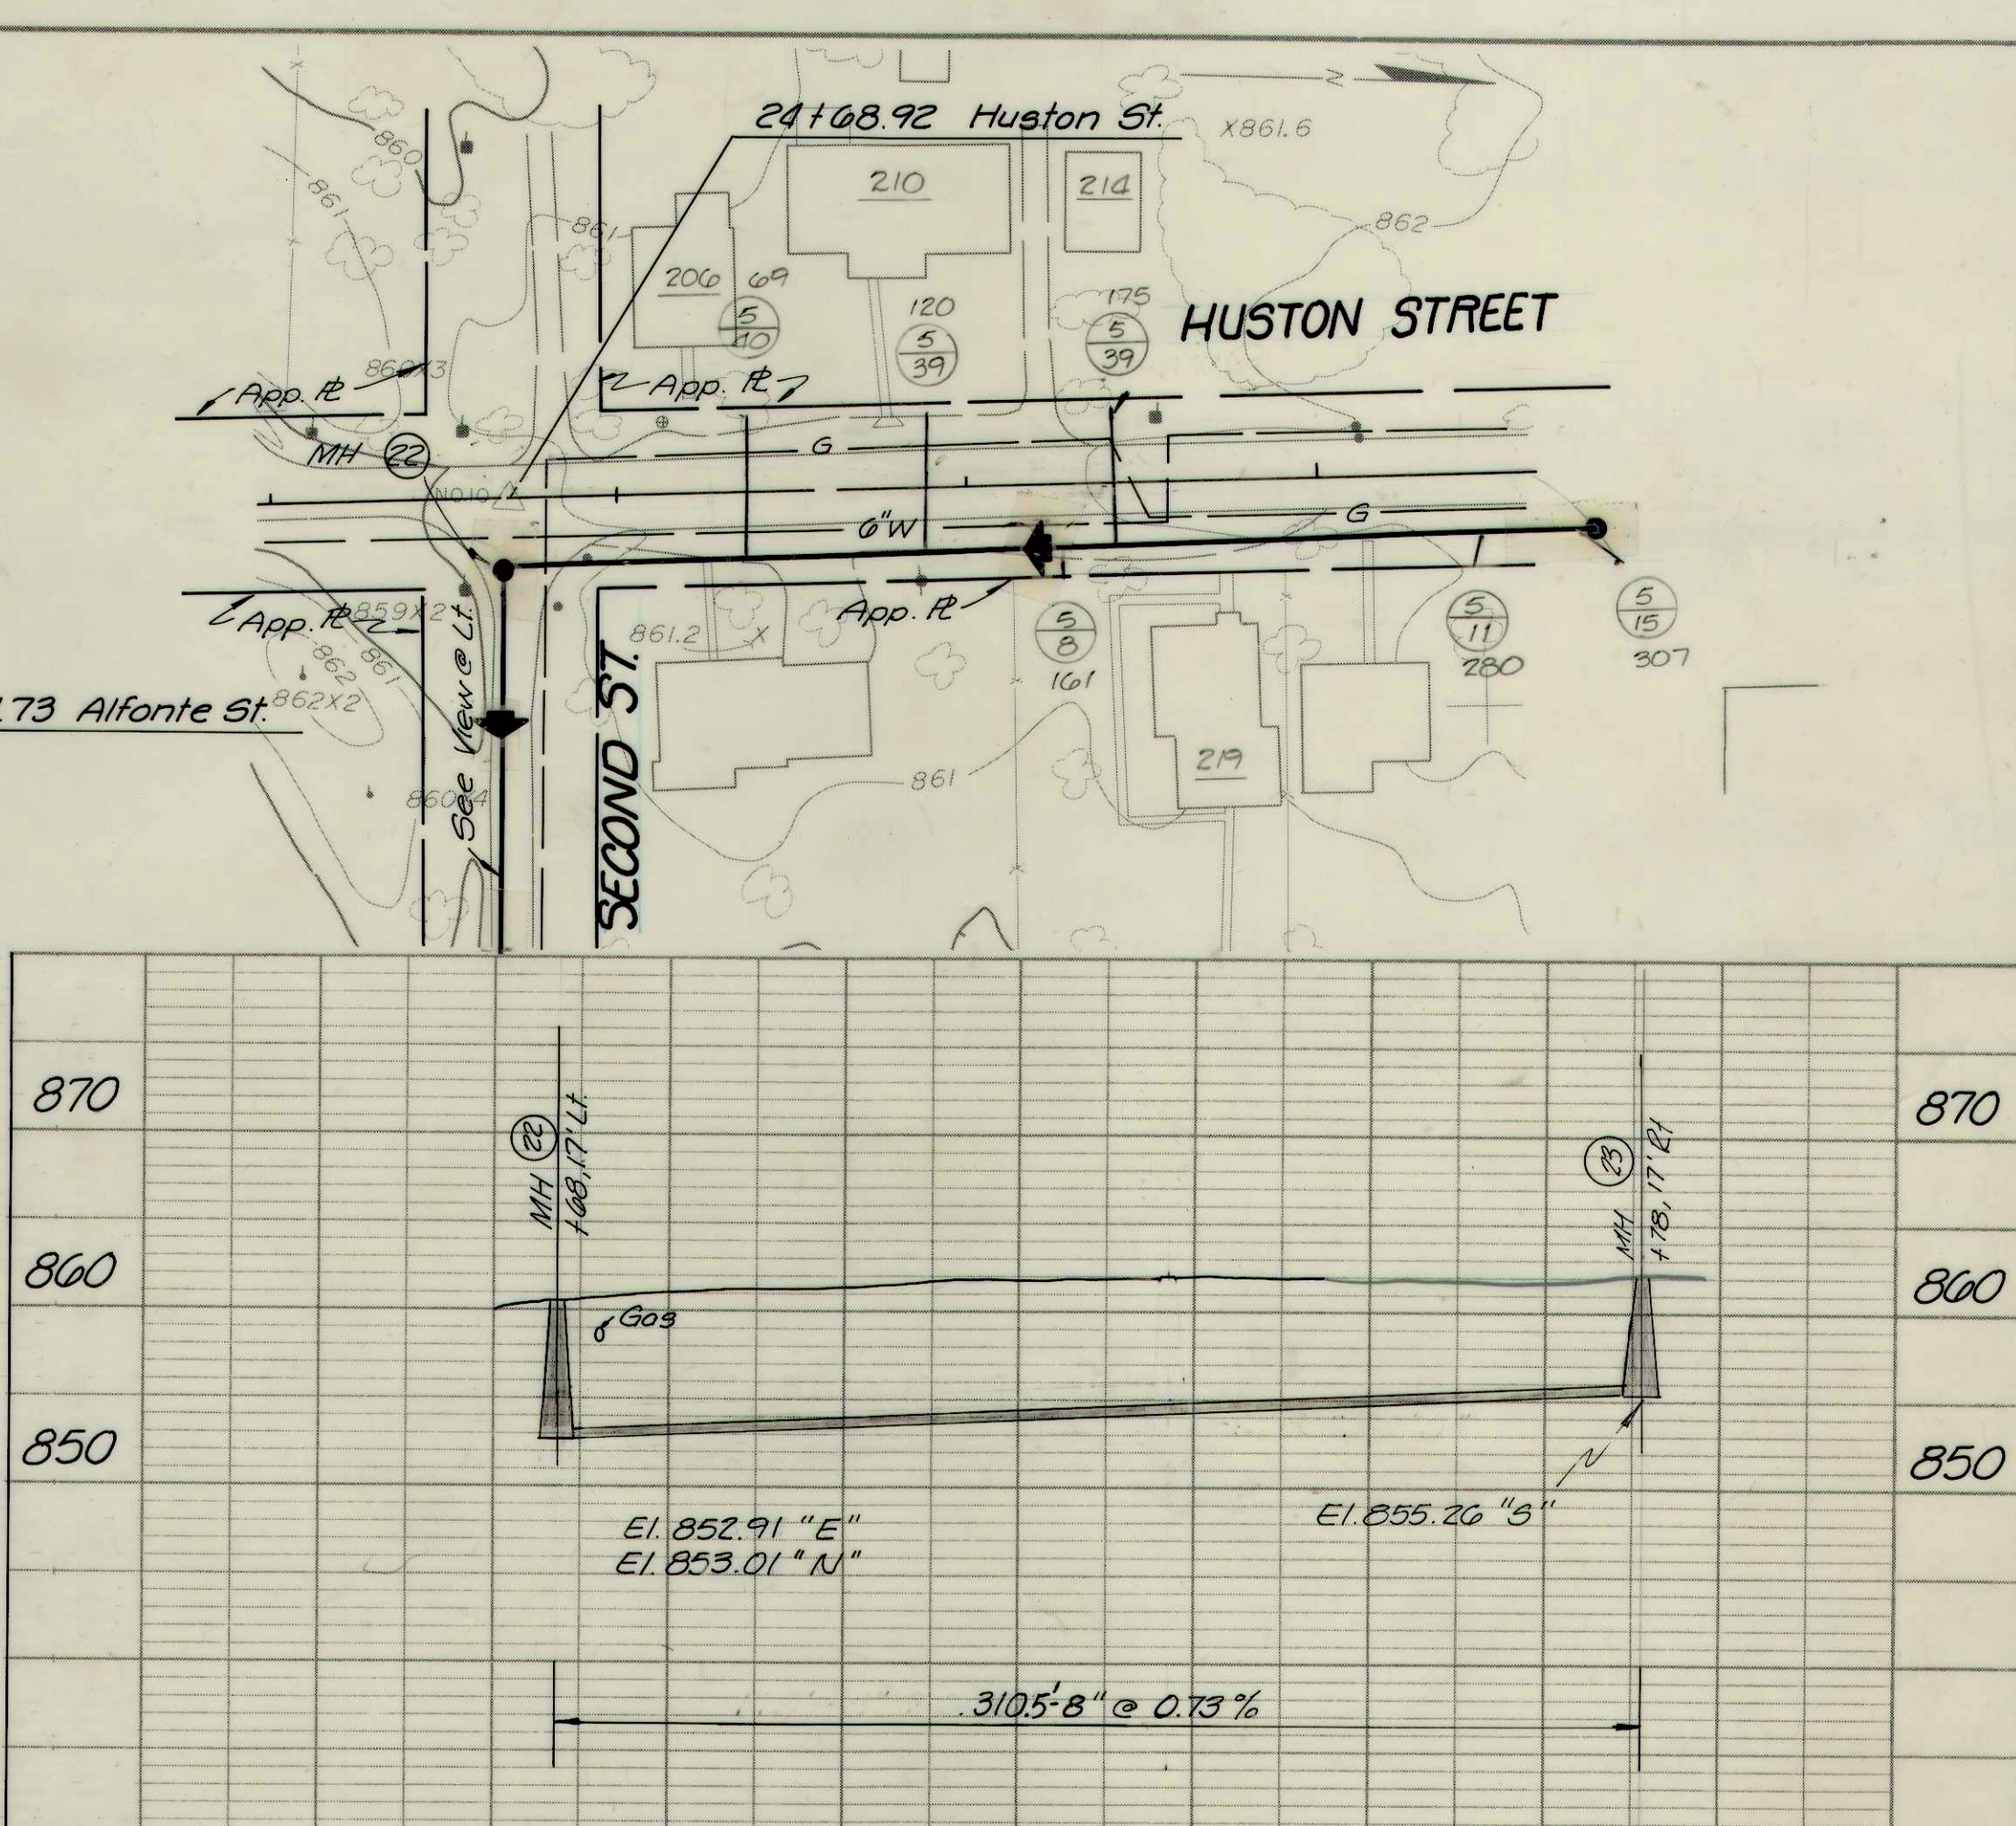


PLAN
 SURVEYED
 PLOTTED
 NOTE BOOK
 NO.

PROFILE
 SURVEYED
 GRADES CHECKED
 B.M. NOTED
 STRUCTURE NOTATIONS SHOWN
 NO.

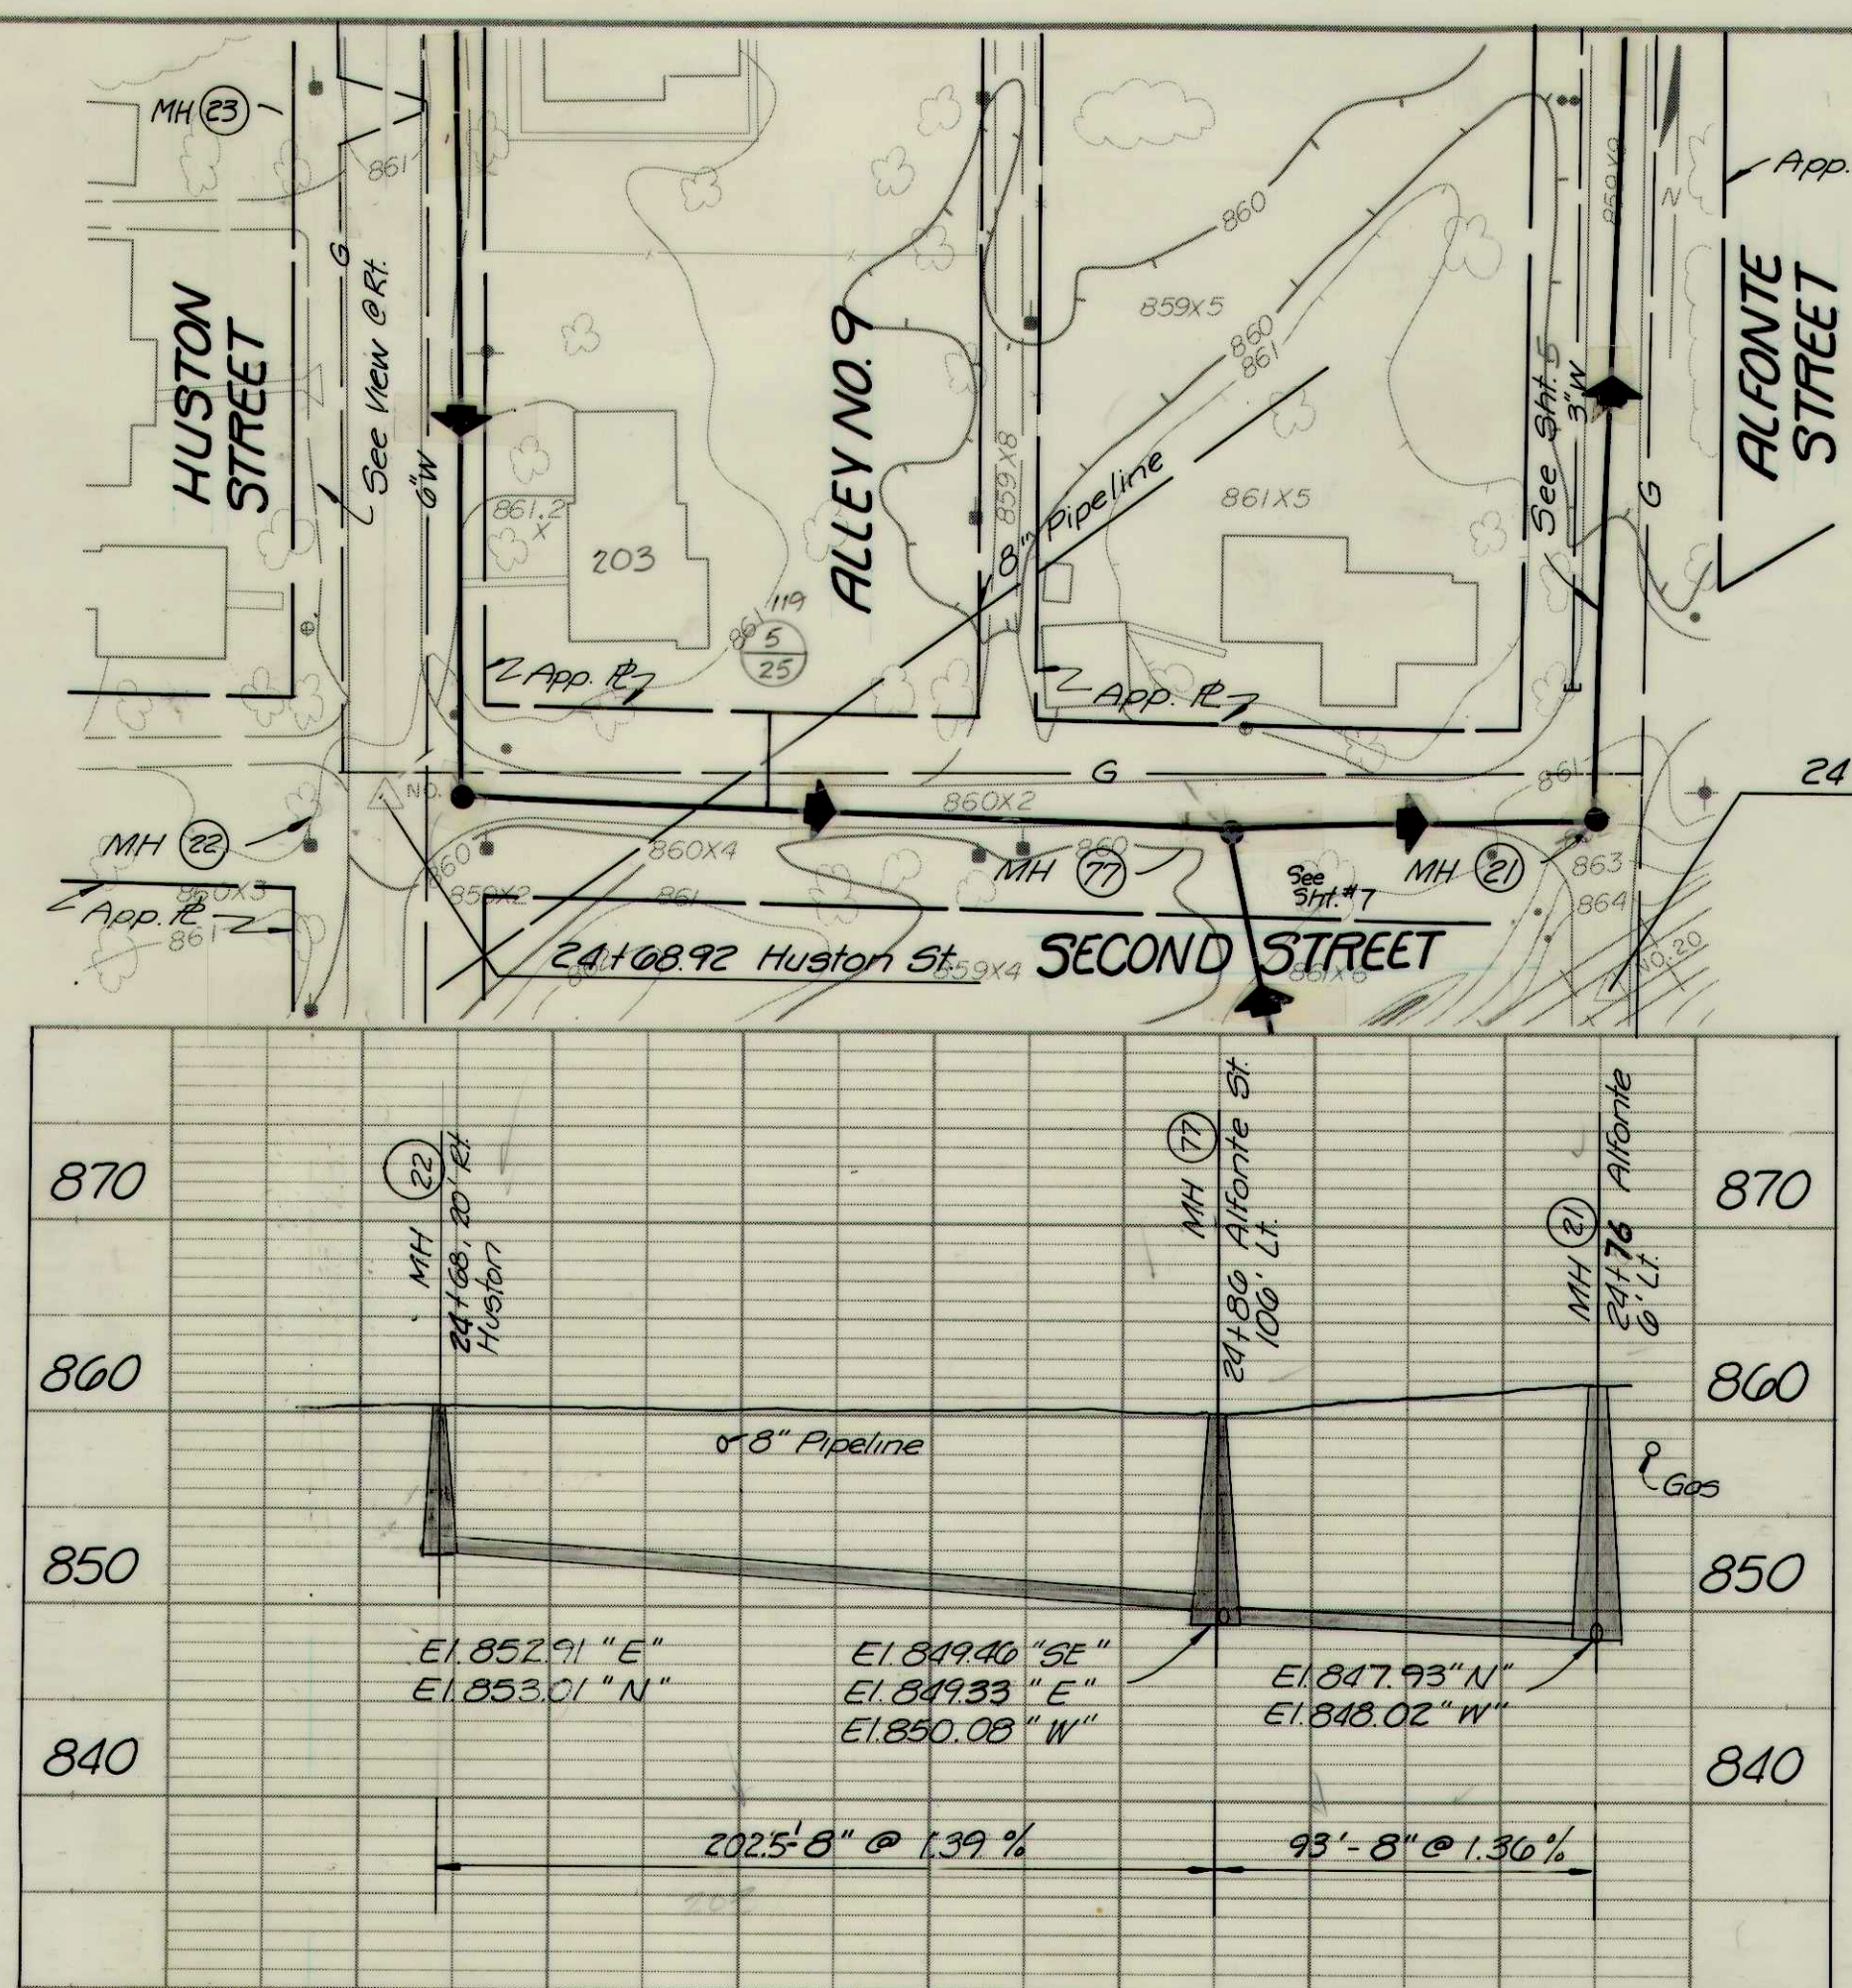

RECORD DRAWING

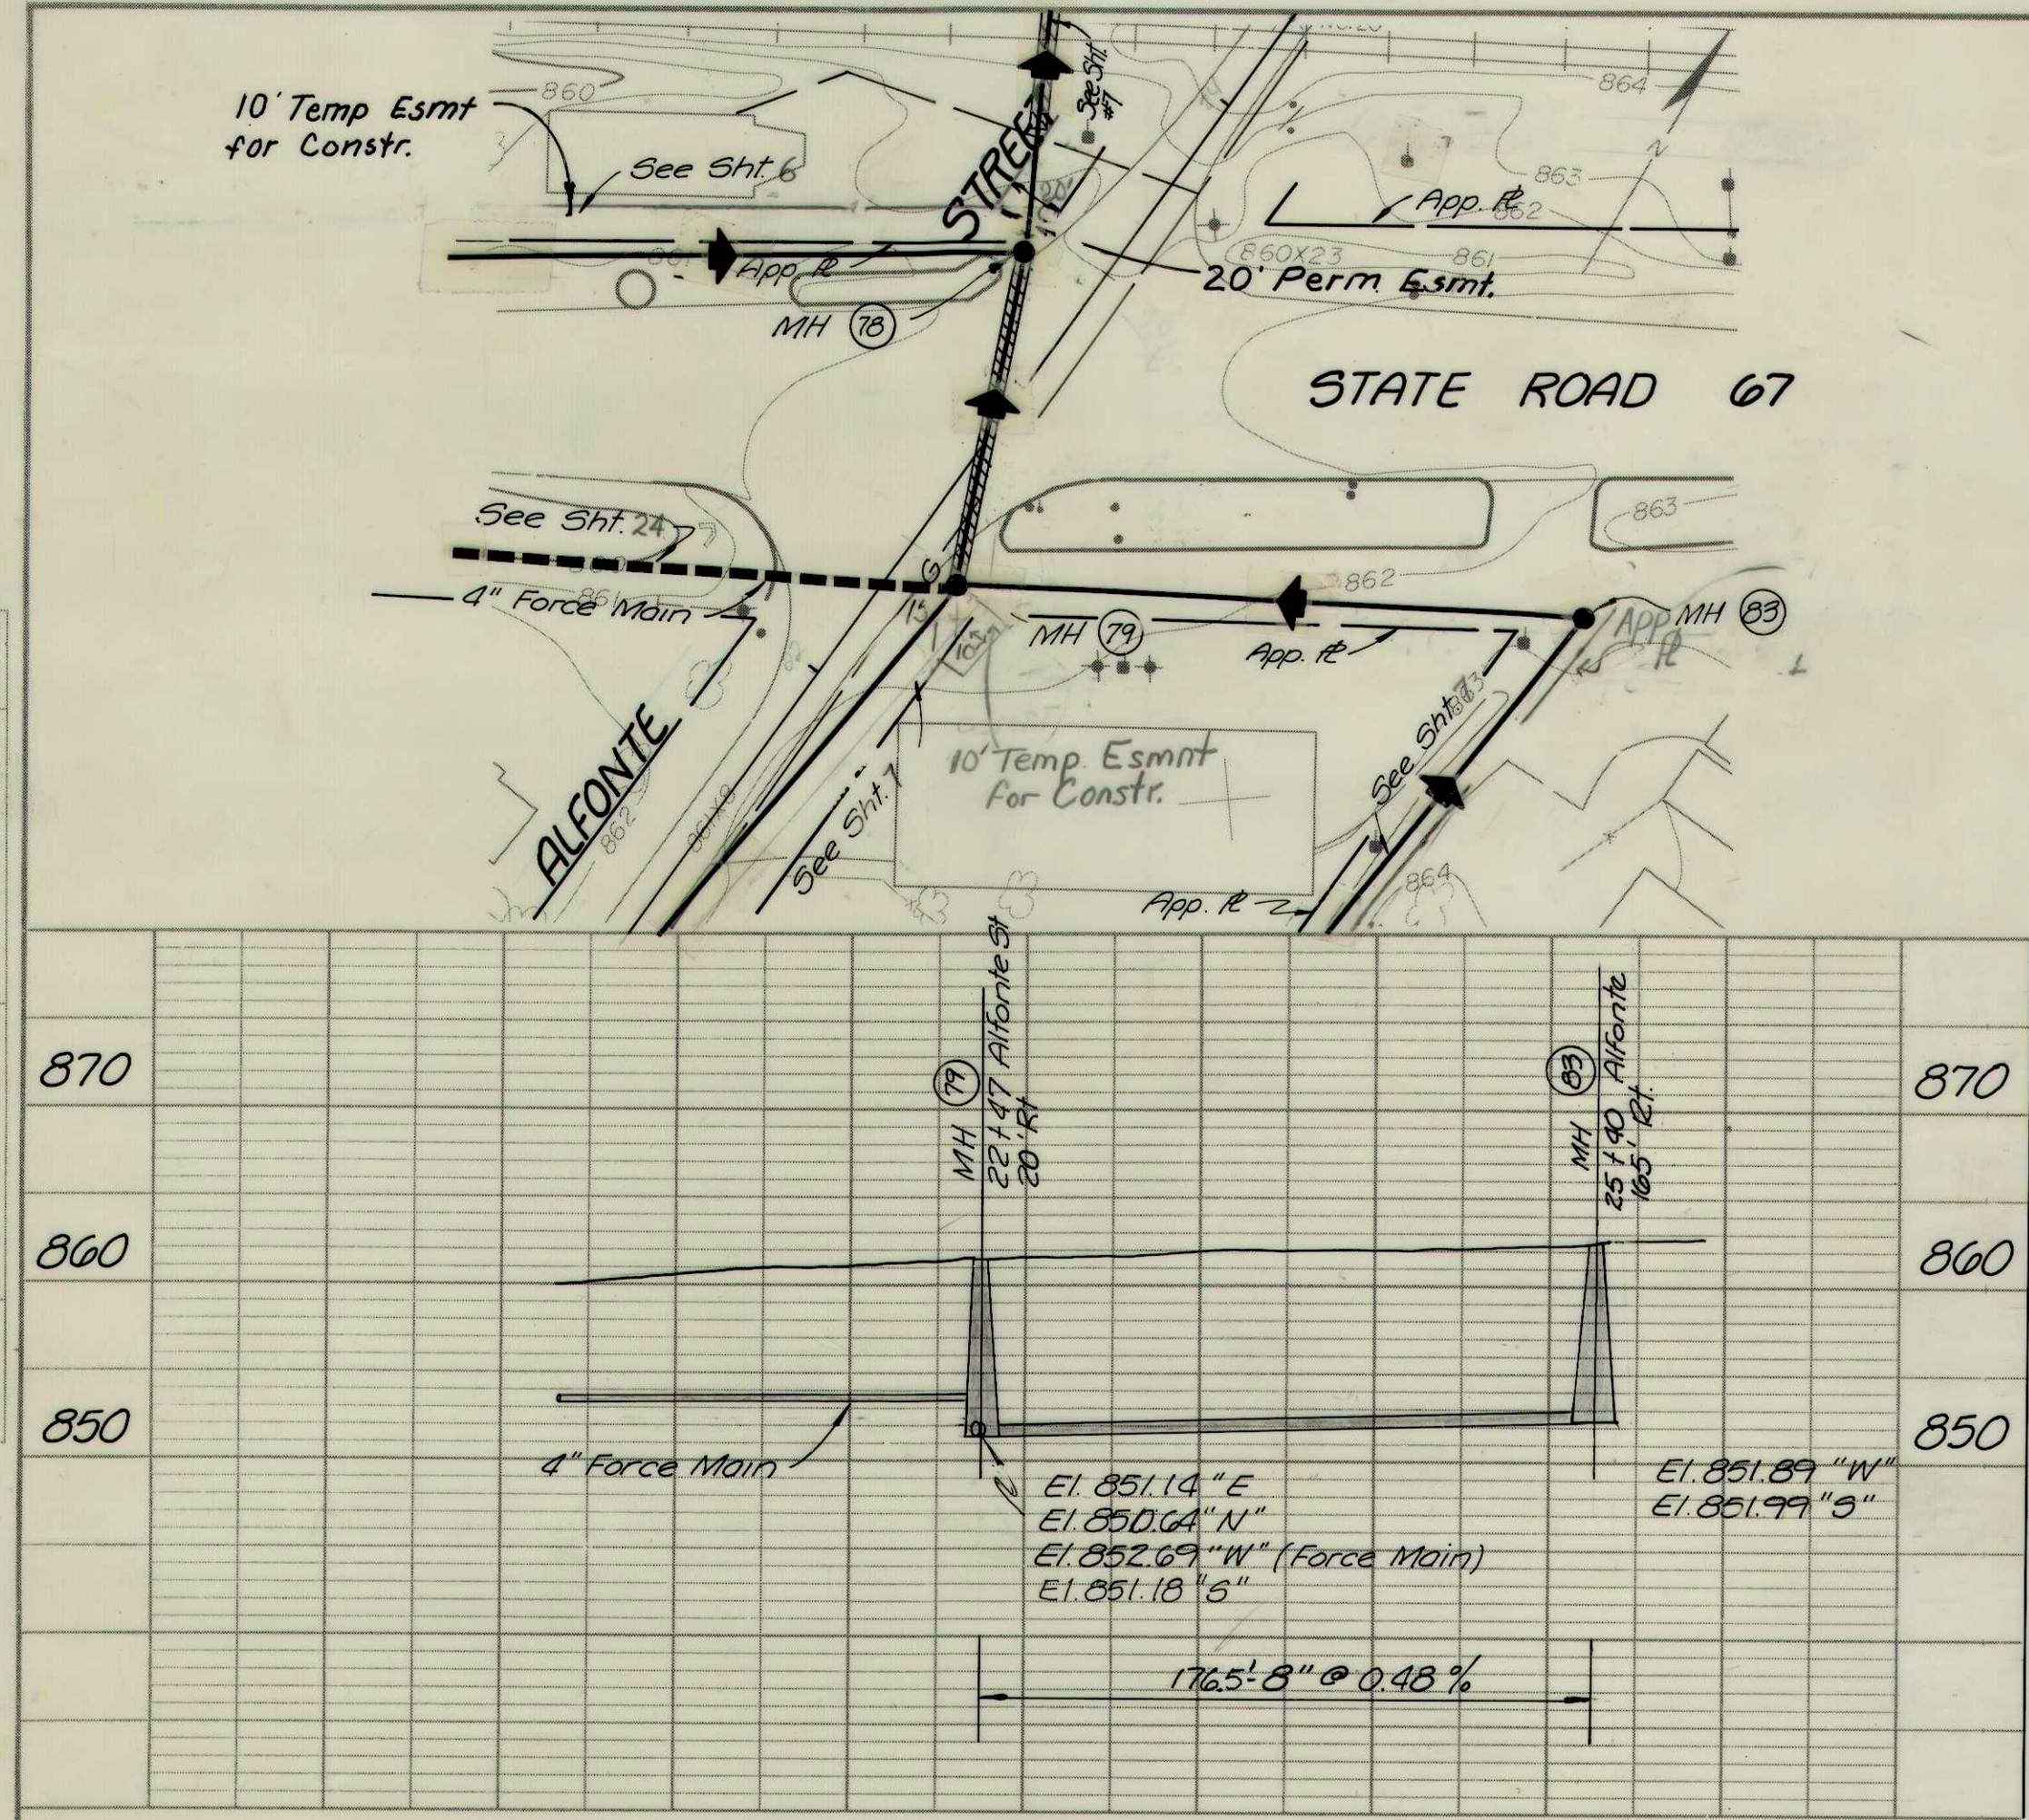

ALLEYS #7 & #9, HUSTON ST., FIRST ST., SECOND ST., S.R. 67
 FALL CREEK R.W.D. PLAN & PROFILE SHEET
 HORIZ. 1"=50' BEAM, LONGEST & NEFF, INC.
 VERT. 1"=10' CONSULTING ENGINEERS
 INDIANAPOLIS, INDIANA