






PLAN
Scale: 3/16" = 1'-0"

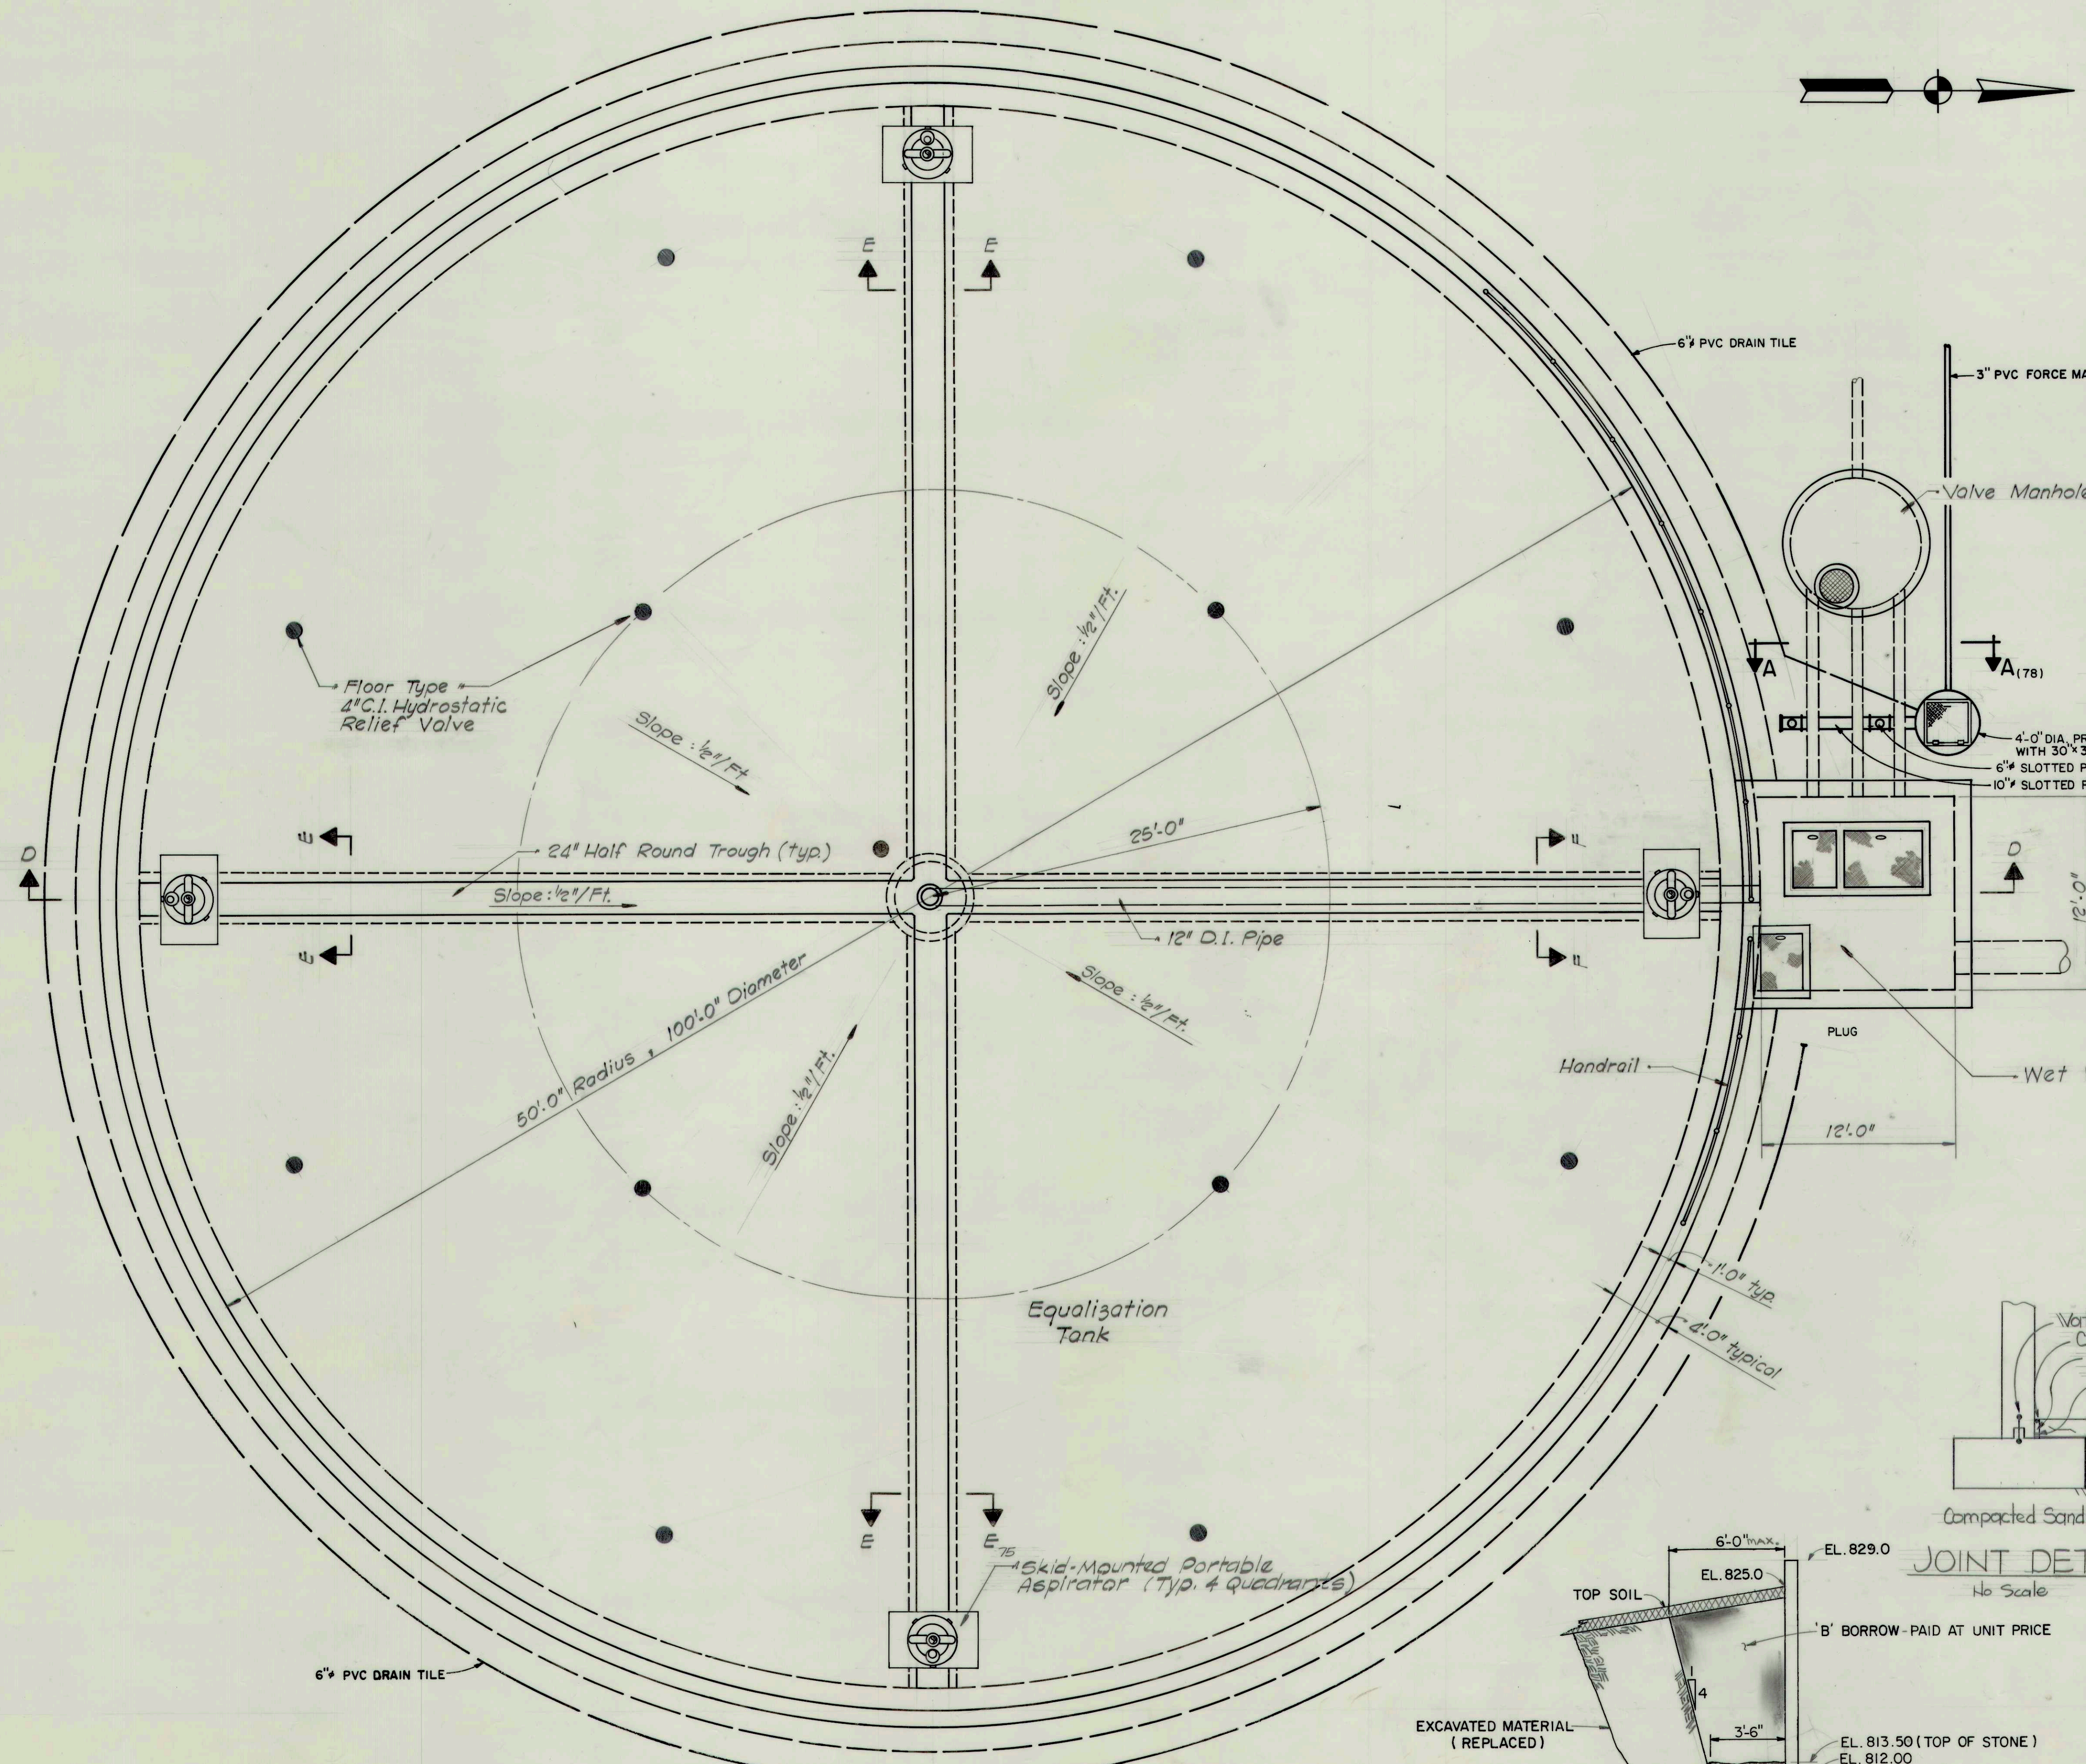


SECTION B-B (TYPICAL)
NO SCALE

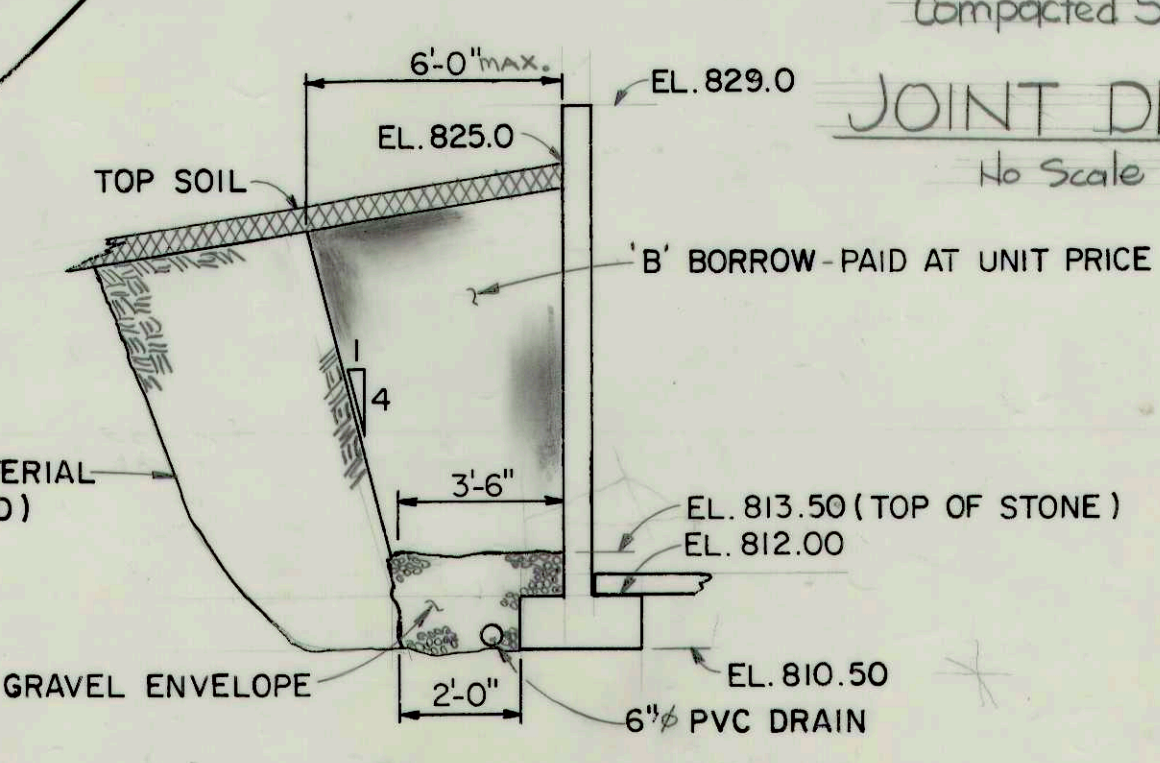

JOINT DETAIL
No Scale

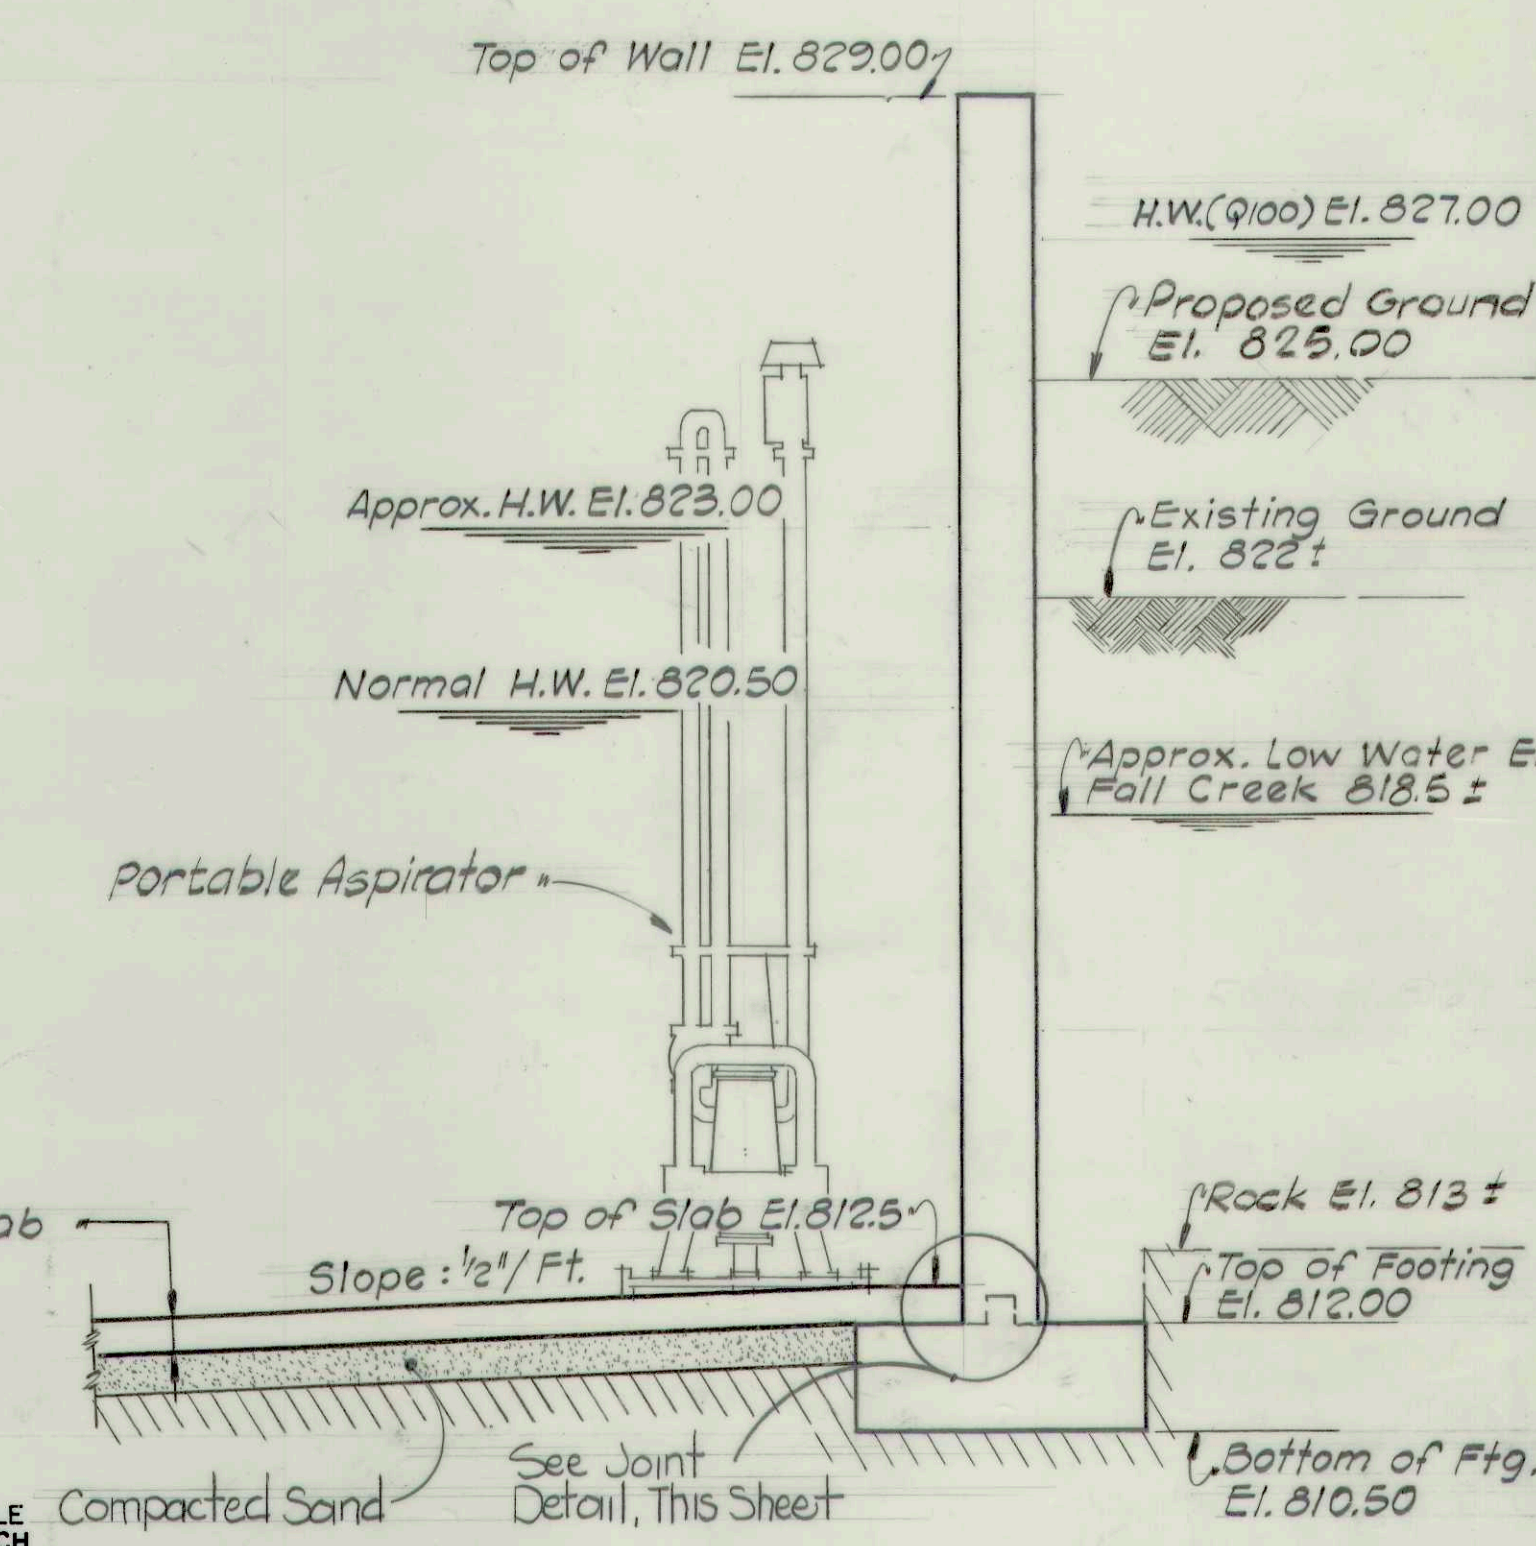

TYPICAL WALL SECTION
Scale: 3/8" = 1'-0"

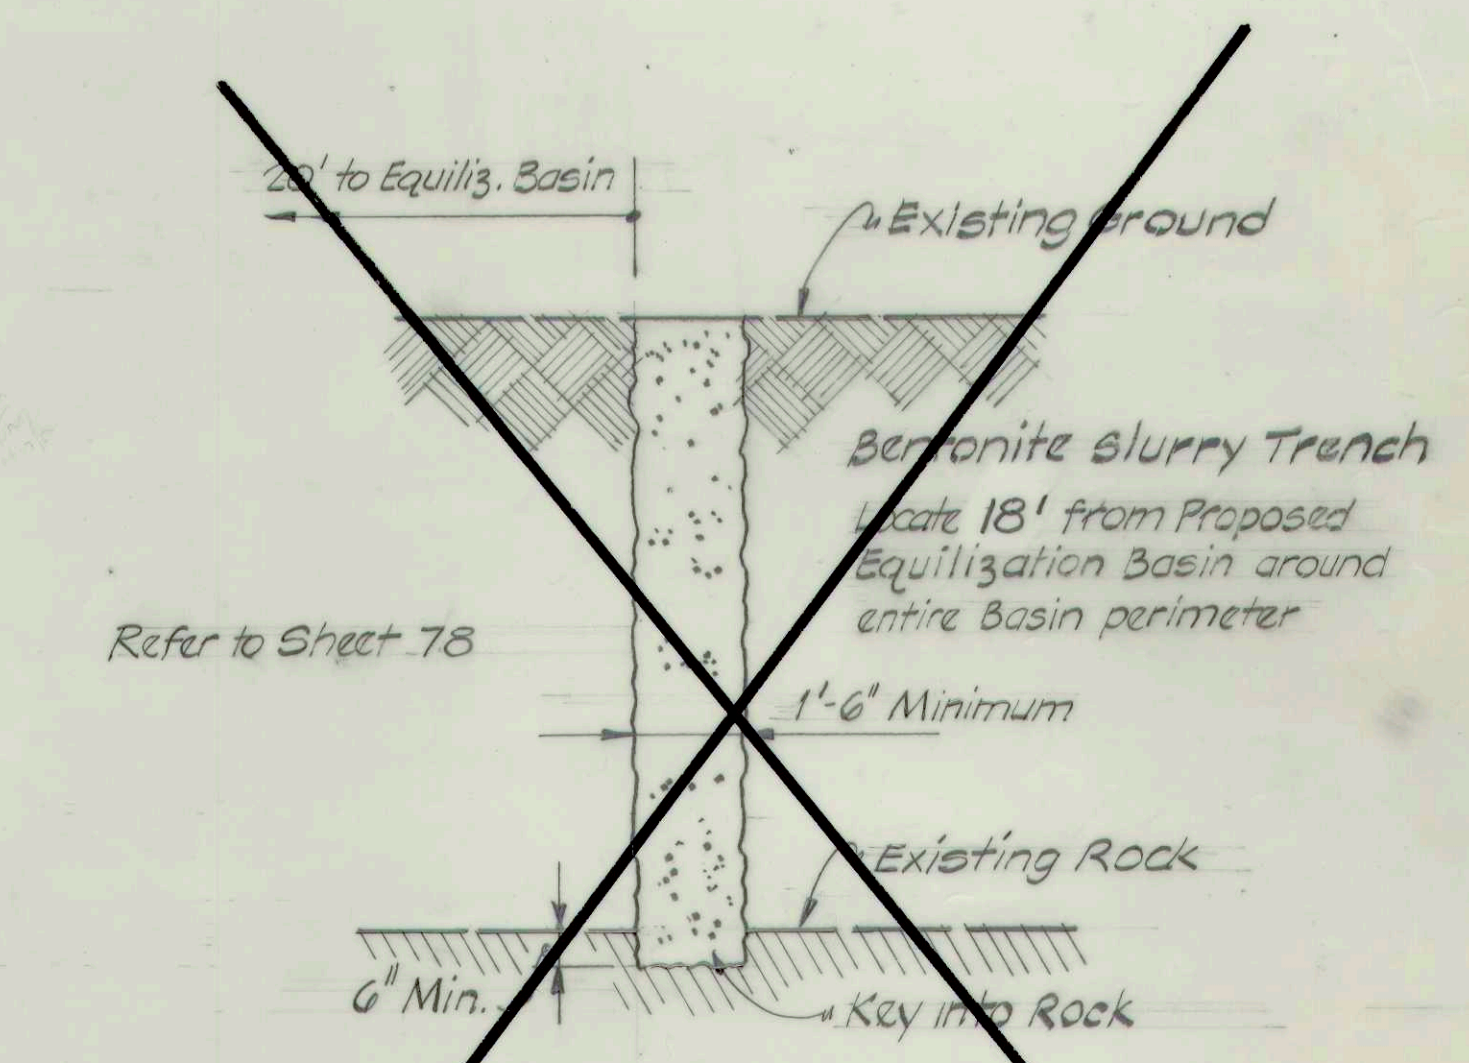

TYPICAL BENTONITE SLURRY TRENCH DETAIL
Not to Scale

DELETED

RECORD DRAWING

EQUALIZATION TANK PLAN - STRUCTURAL		
Scale: 3/16" = 1'-0"	FAIL CREEK R.W.D.	Sheet
Drawn By: J.B.	BEAM, LONGEST & NEFF	79
Designed By: RPS	Consulting Engineers	
Certified By: E.H.	8136 Castleton Road Indianapolis In. 46250	



REVISED 10/11/84