



See Section G-G
for Reinf. Steel


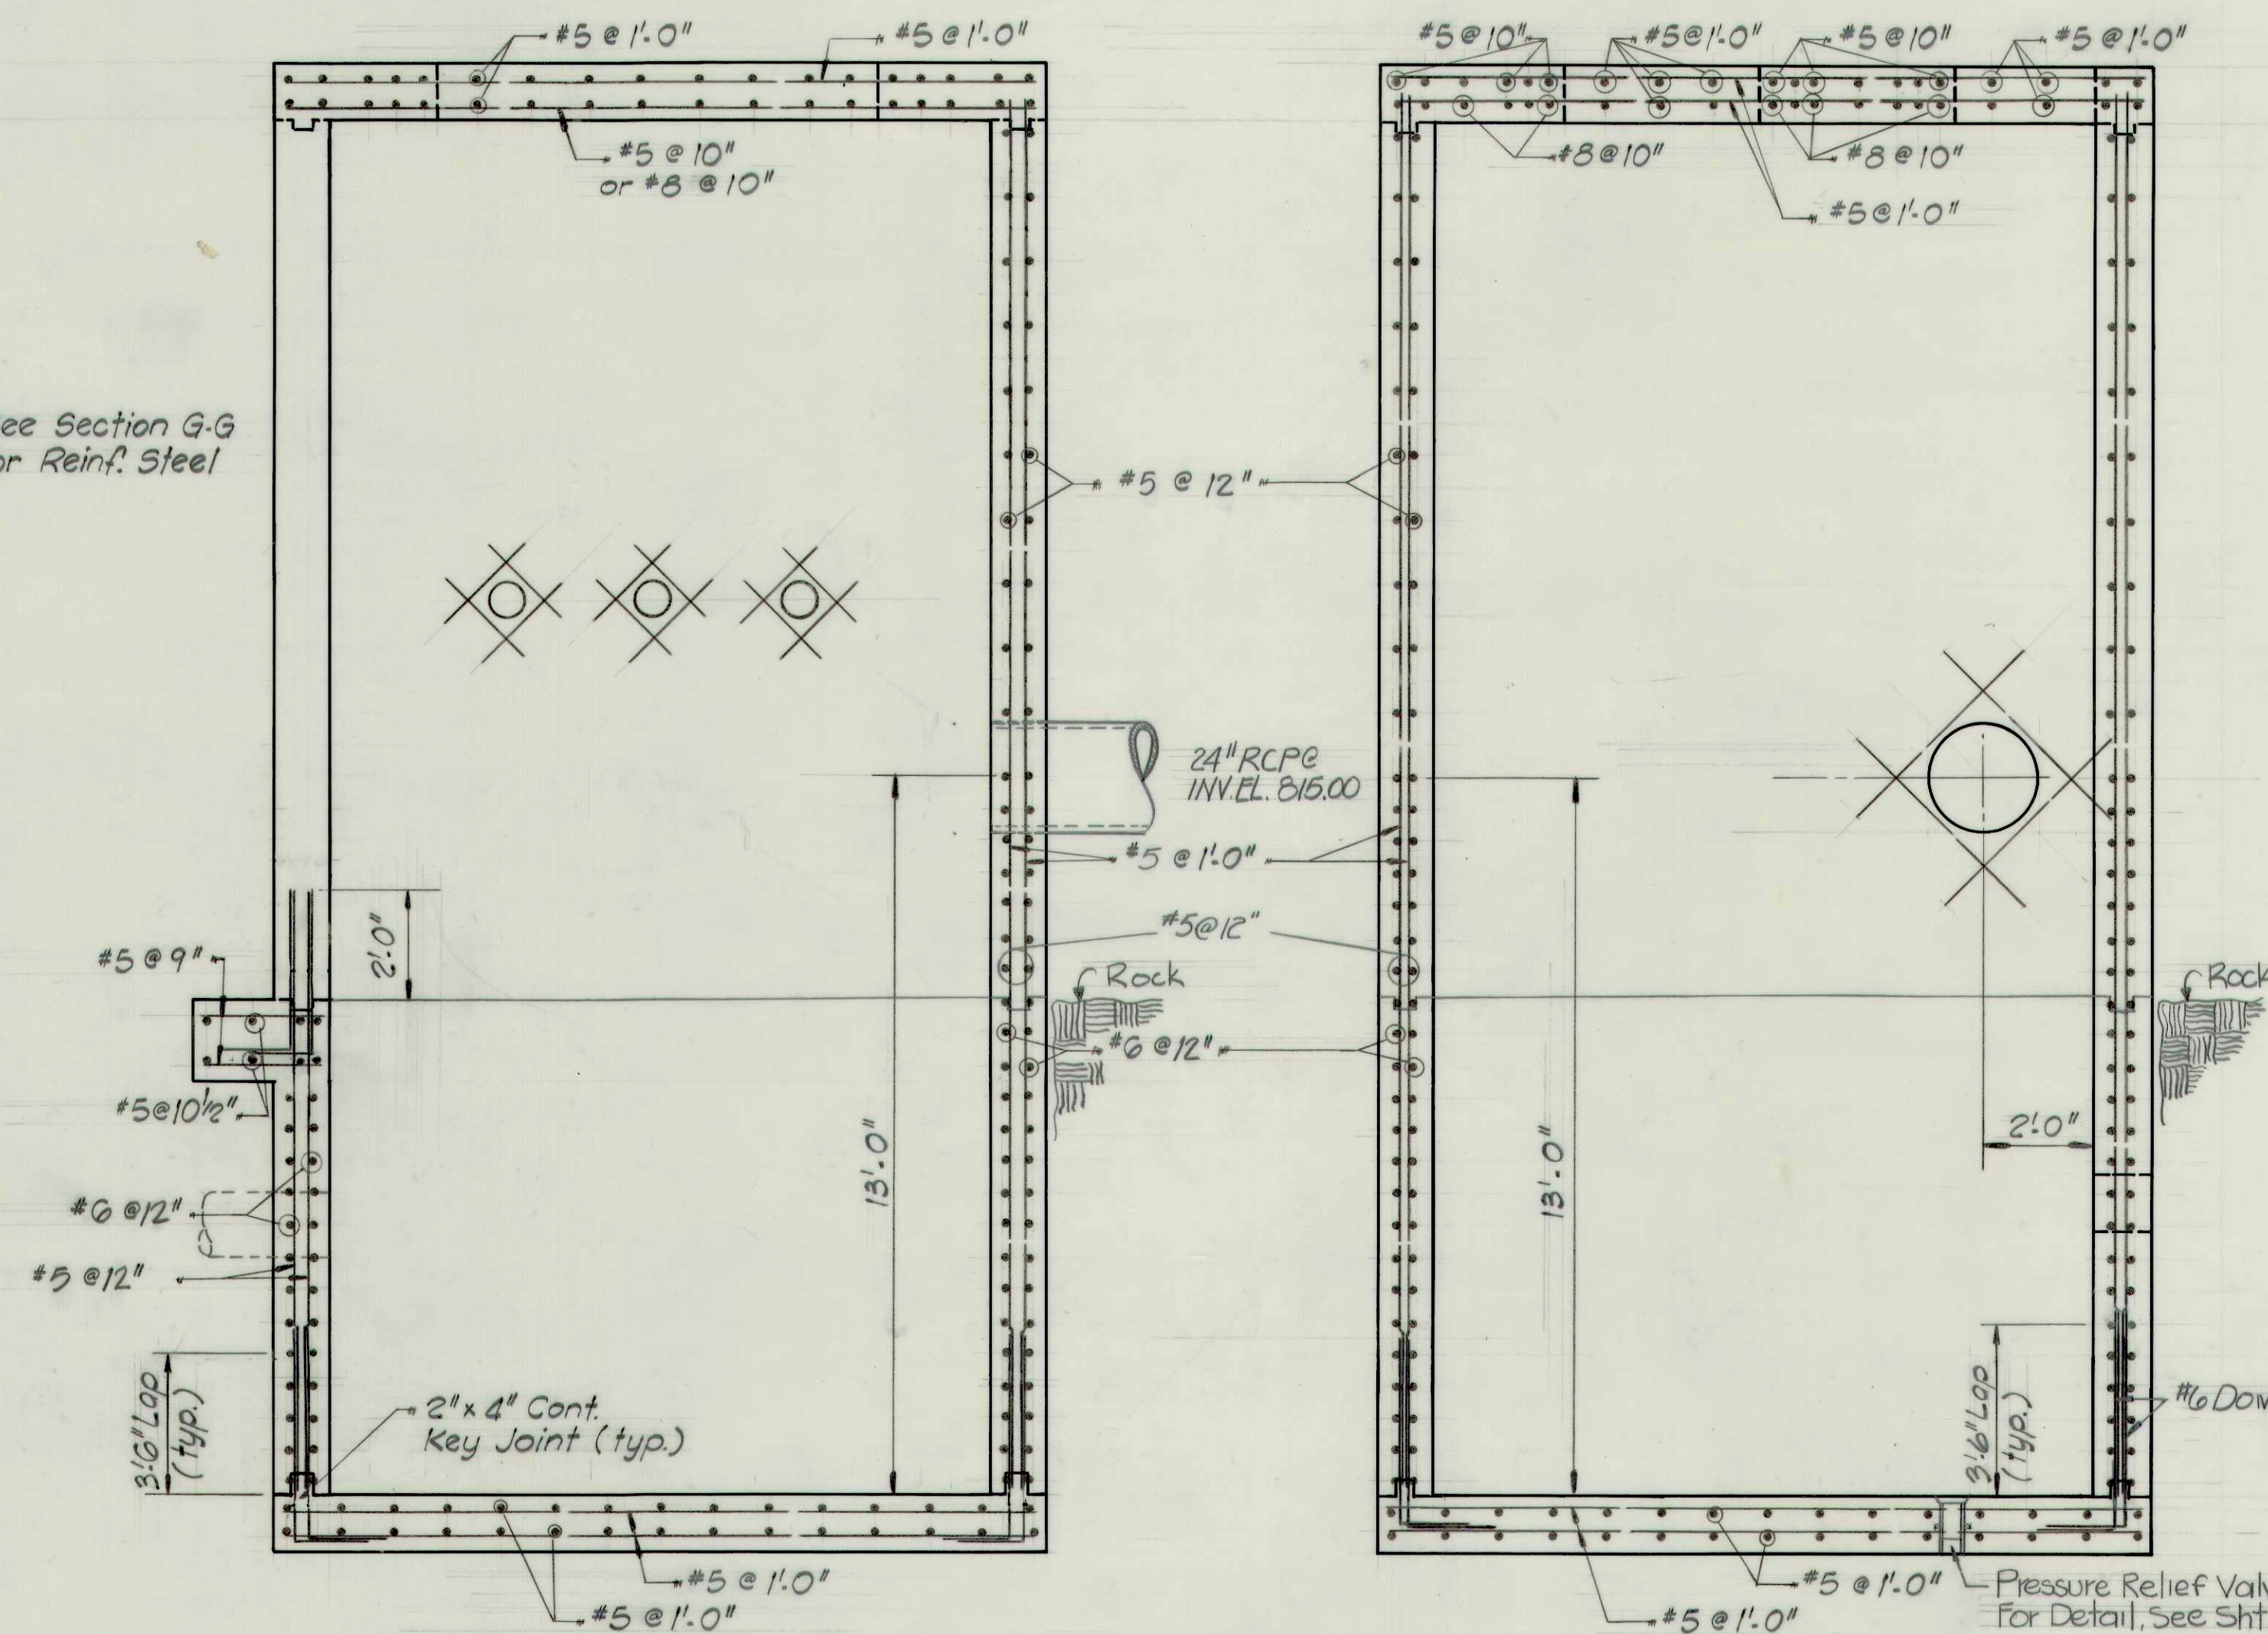


SECTION A-A


SECTION B-B

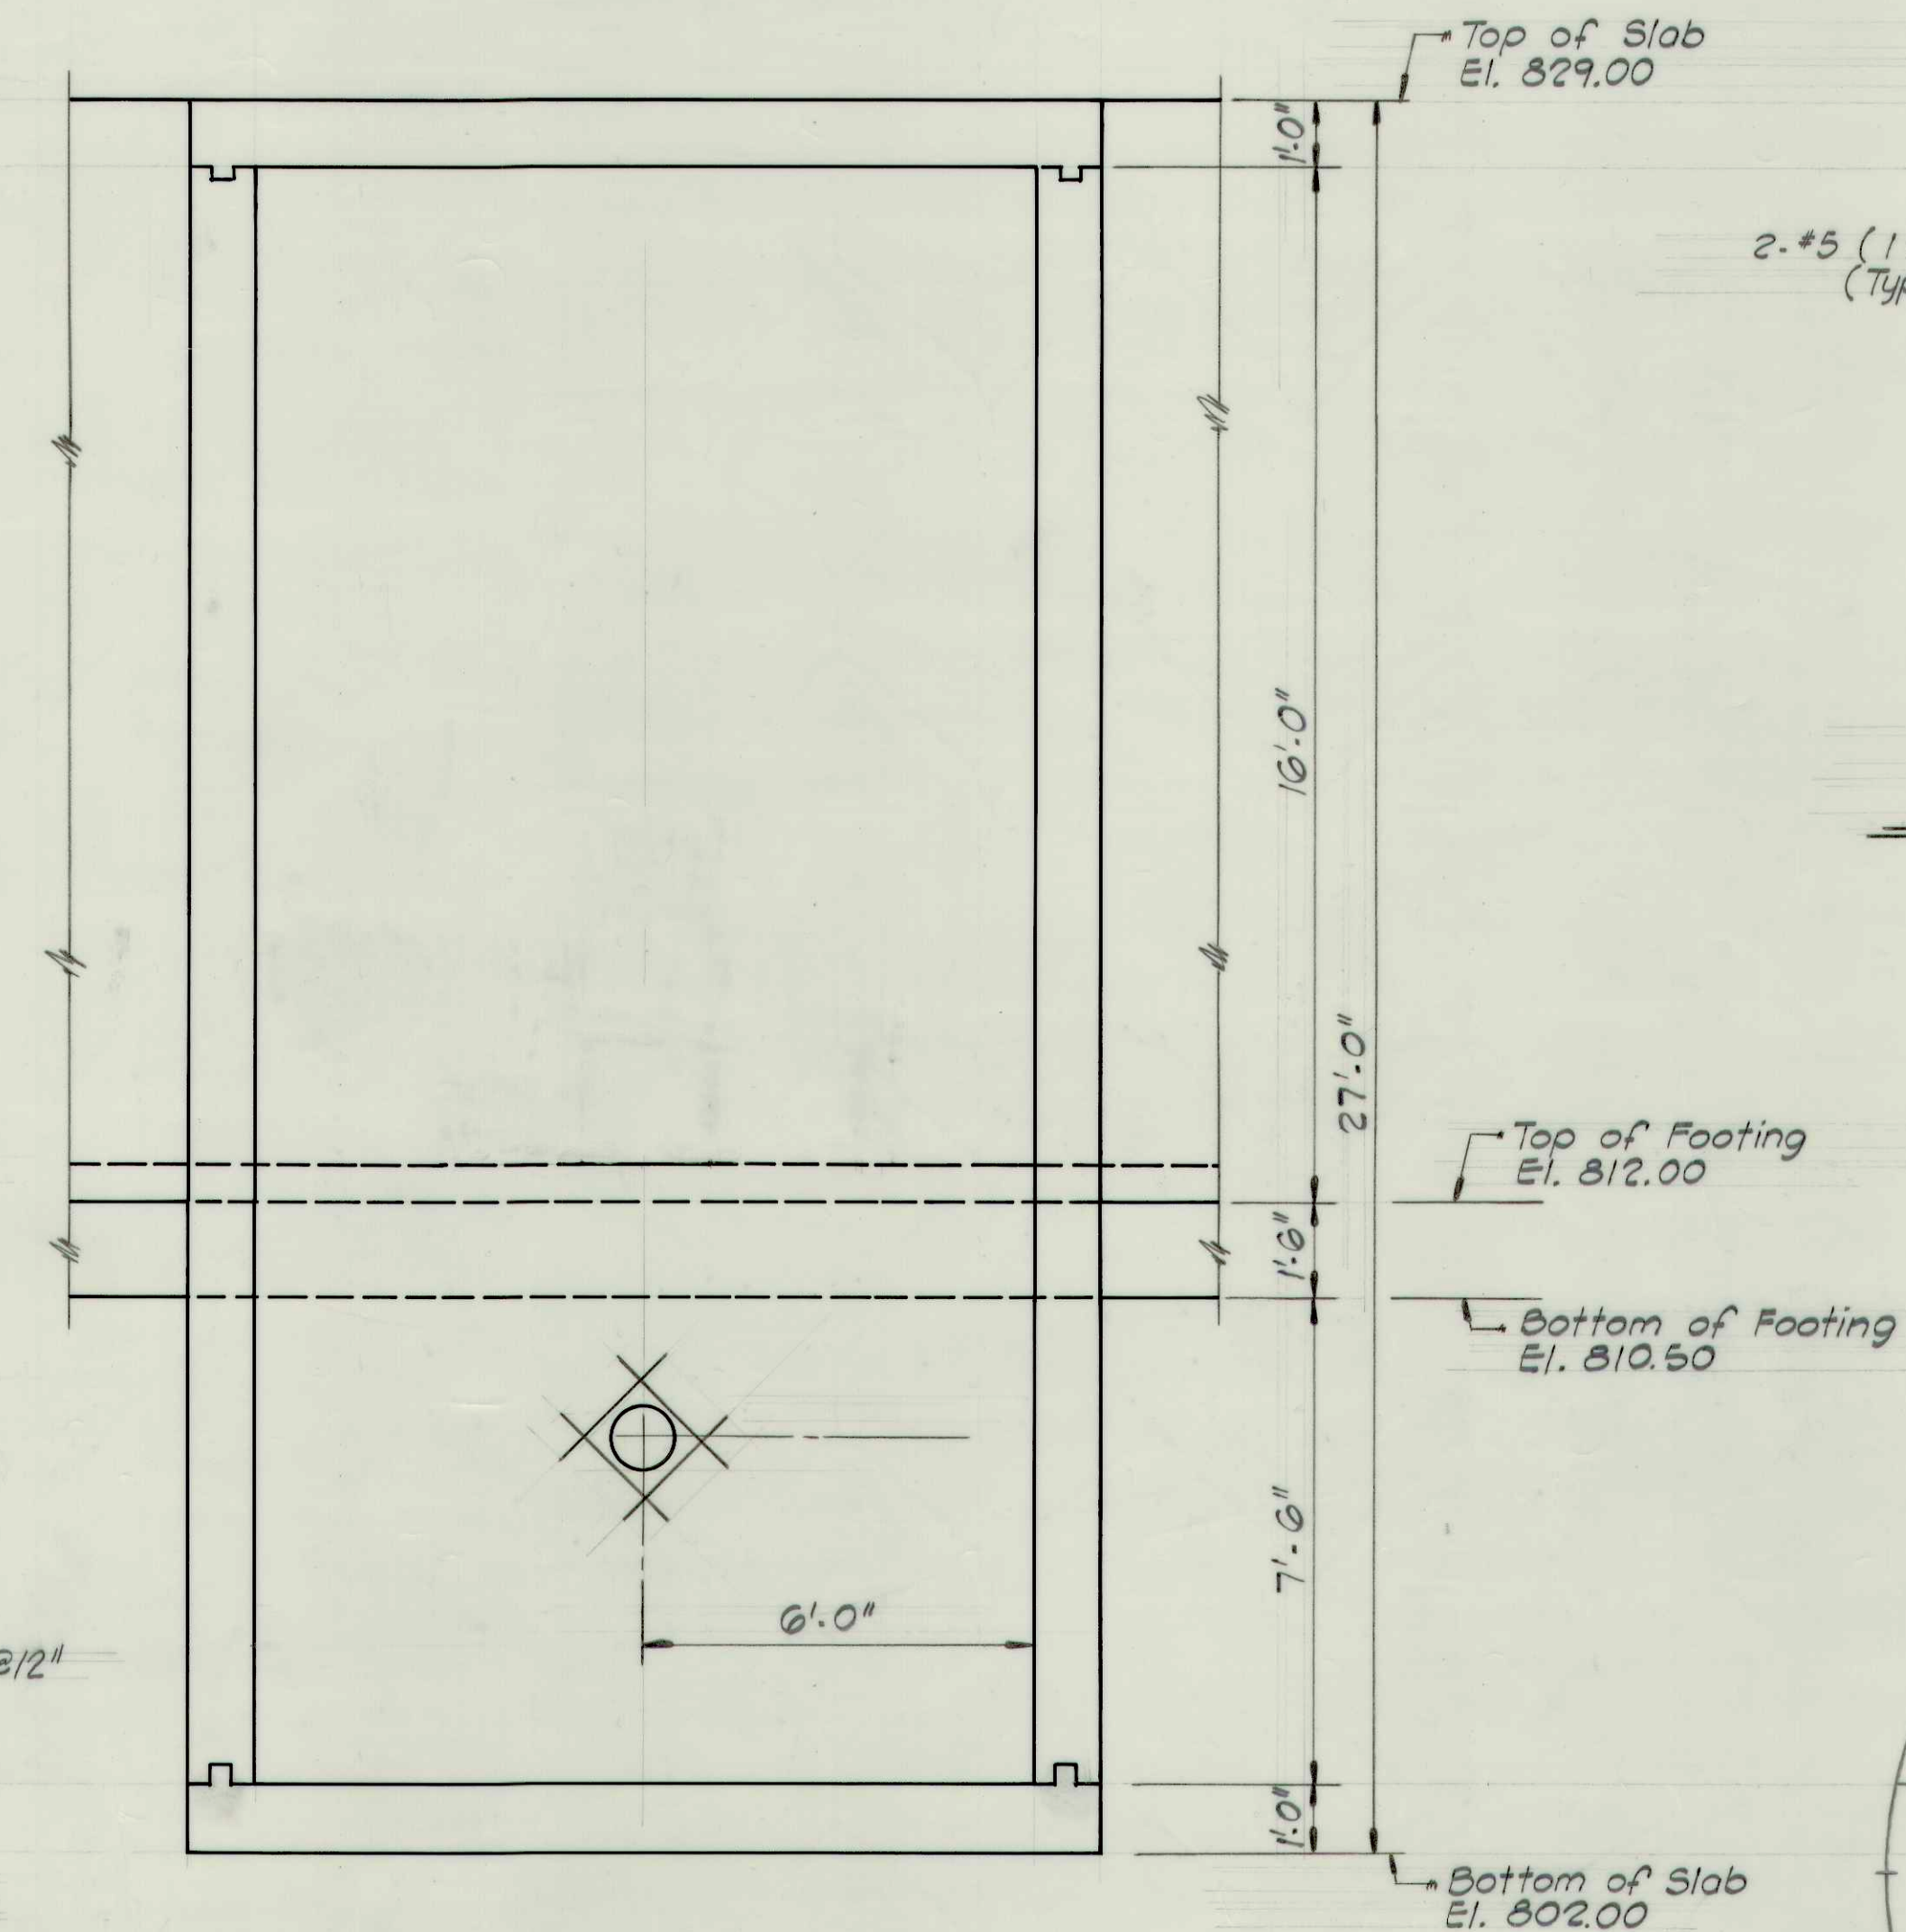


SECTION C-C
For Reinforcing See Section B-B

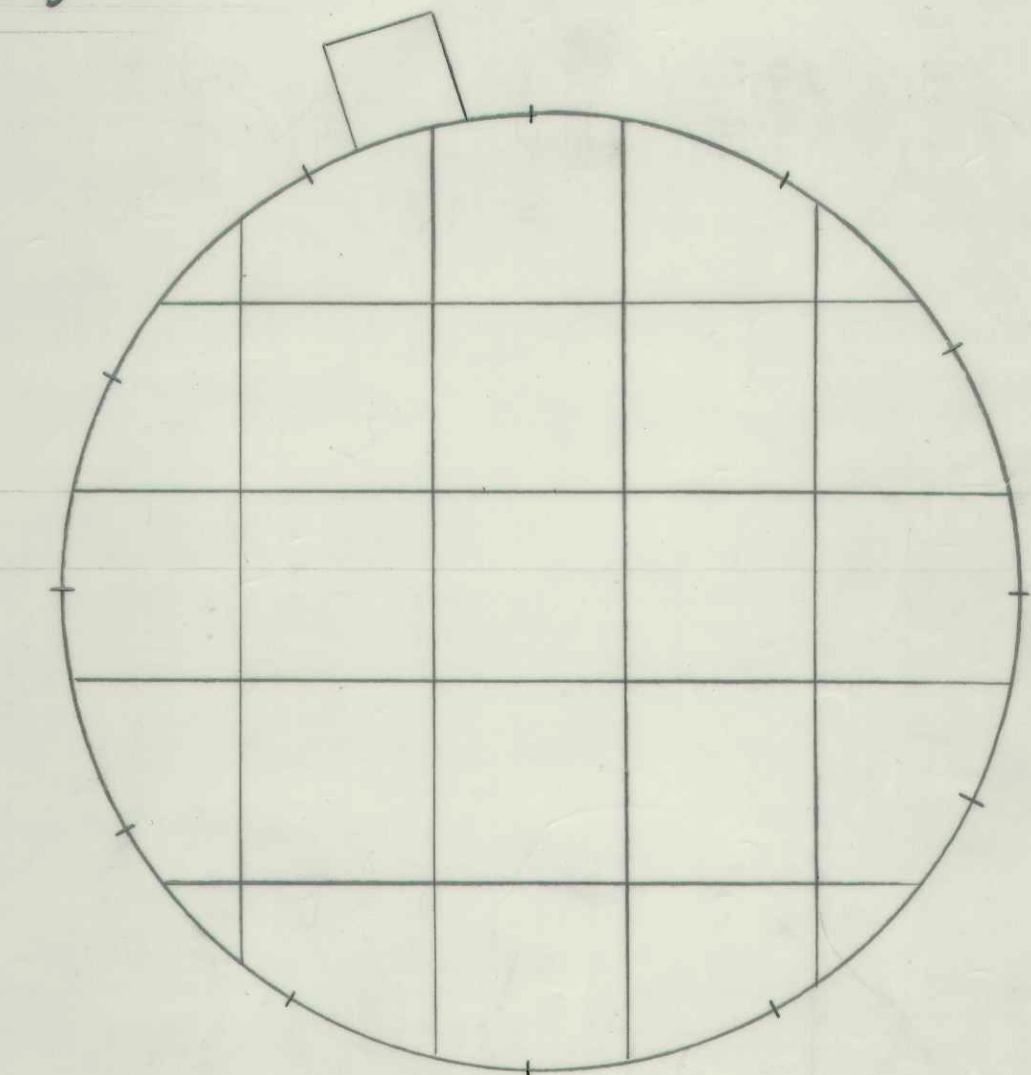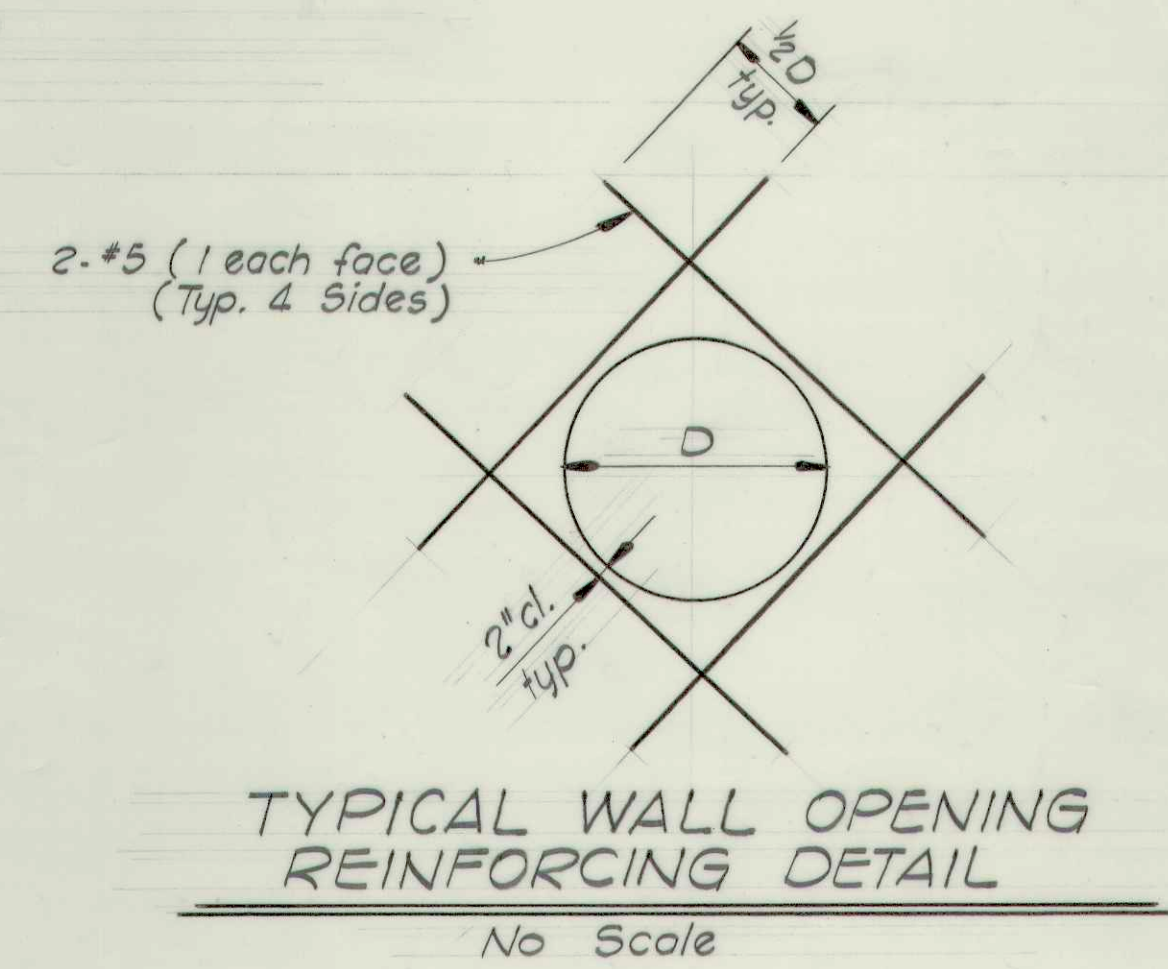


TANK CONSTRUCTION JOINTS
(Four Constr. Joints in Checkered Board Pattern
Approx. 20 x 20 Sq.)
No Scale

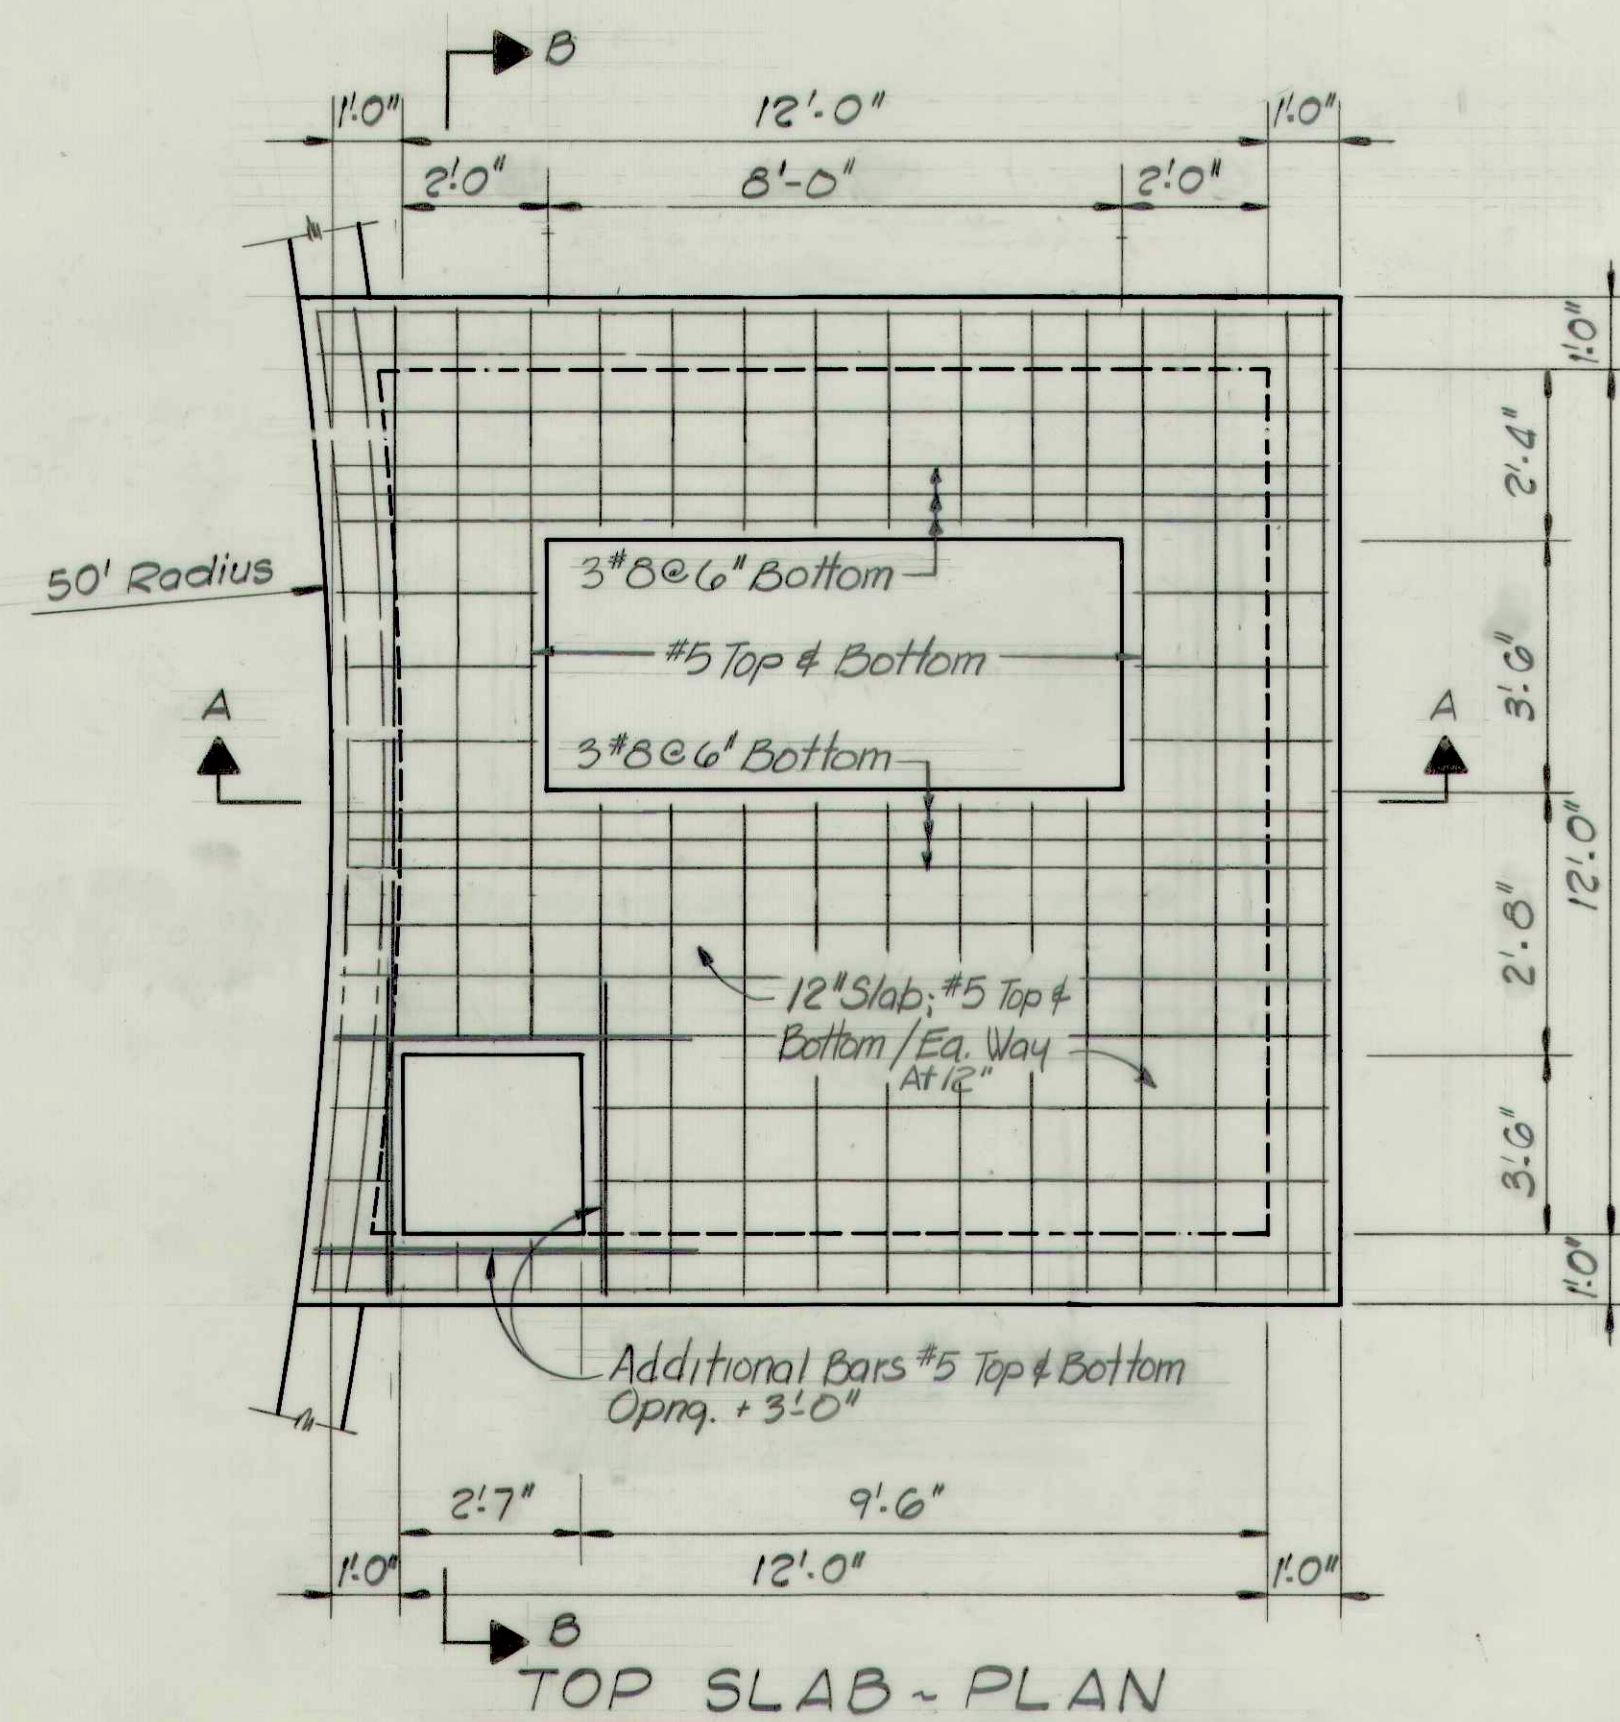

(Verify Opening With Hatch Cover Manufacturer)

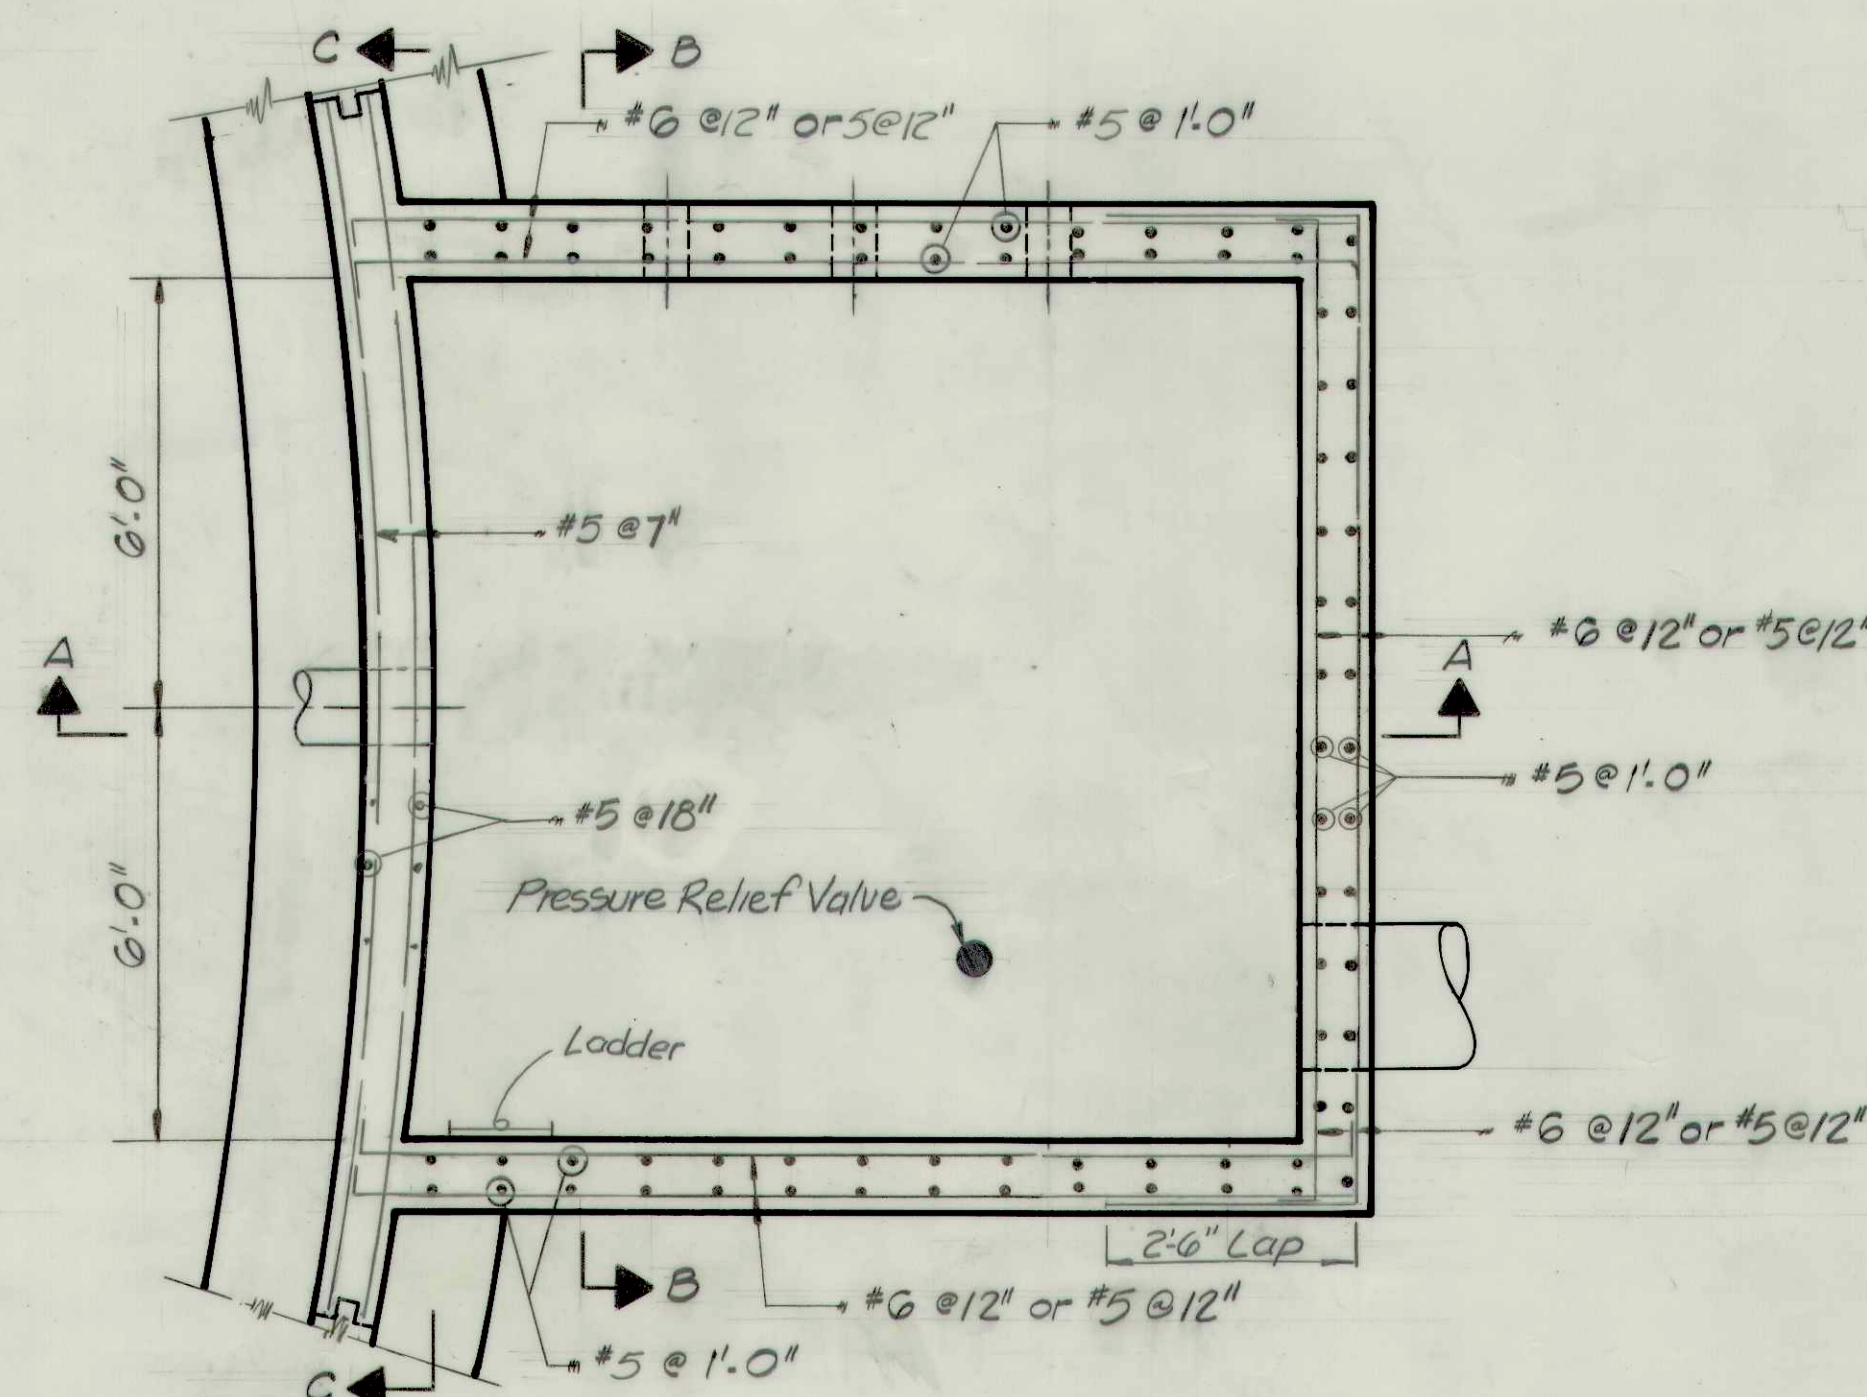

PLAN
(SHOWN WITH TOP SLAB REMOVED)

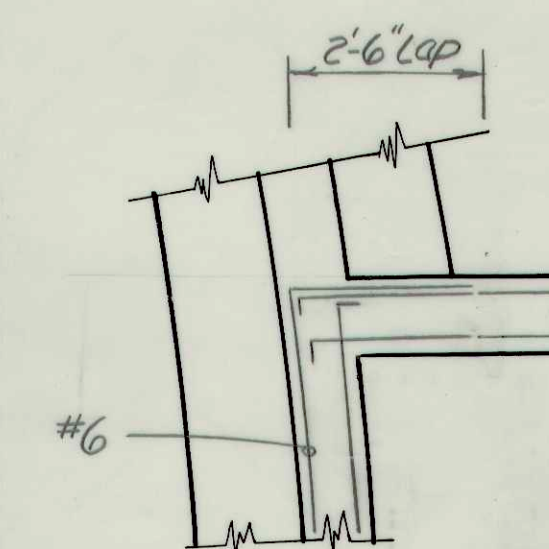

CORNER BELOW TANK FOOTING
No Scale

RECORD DRAWING



EQUALIZATION TANK
SECTIONS - STRUCTURAL

Scale: 3/8" = 1'-0"	FALL CREEK R.W.D.	Sheet
Drawn By: JFB	BEAM, LONGEST & NEFF	80
Designed By: RFS	Consulting Engineers	
Certified By: E.R.	8136 Castleton Road Indianapolis, IN 46250	