
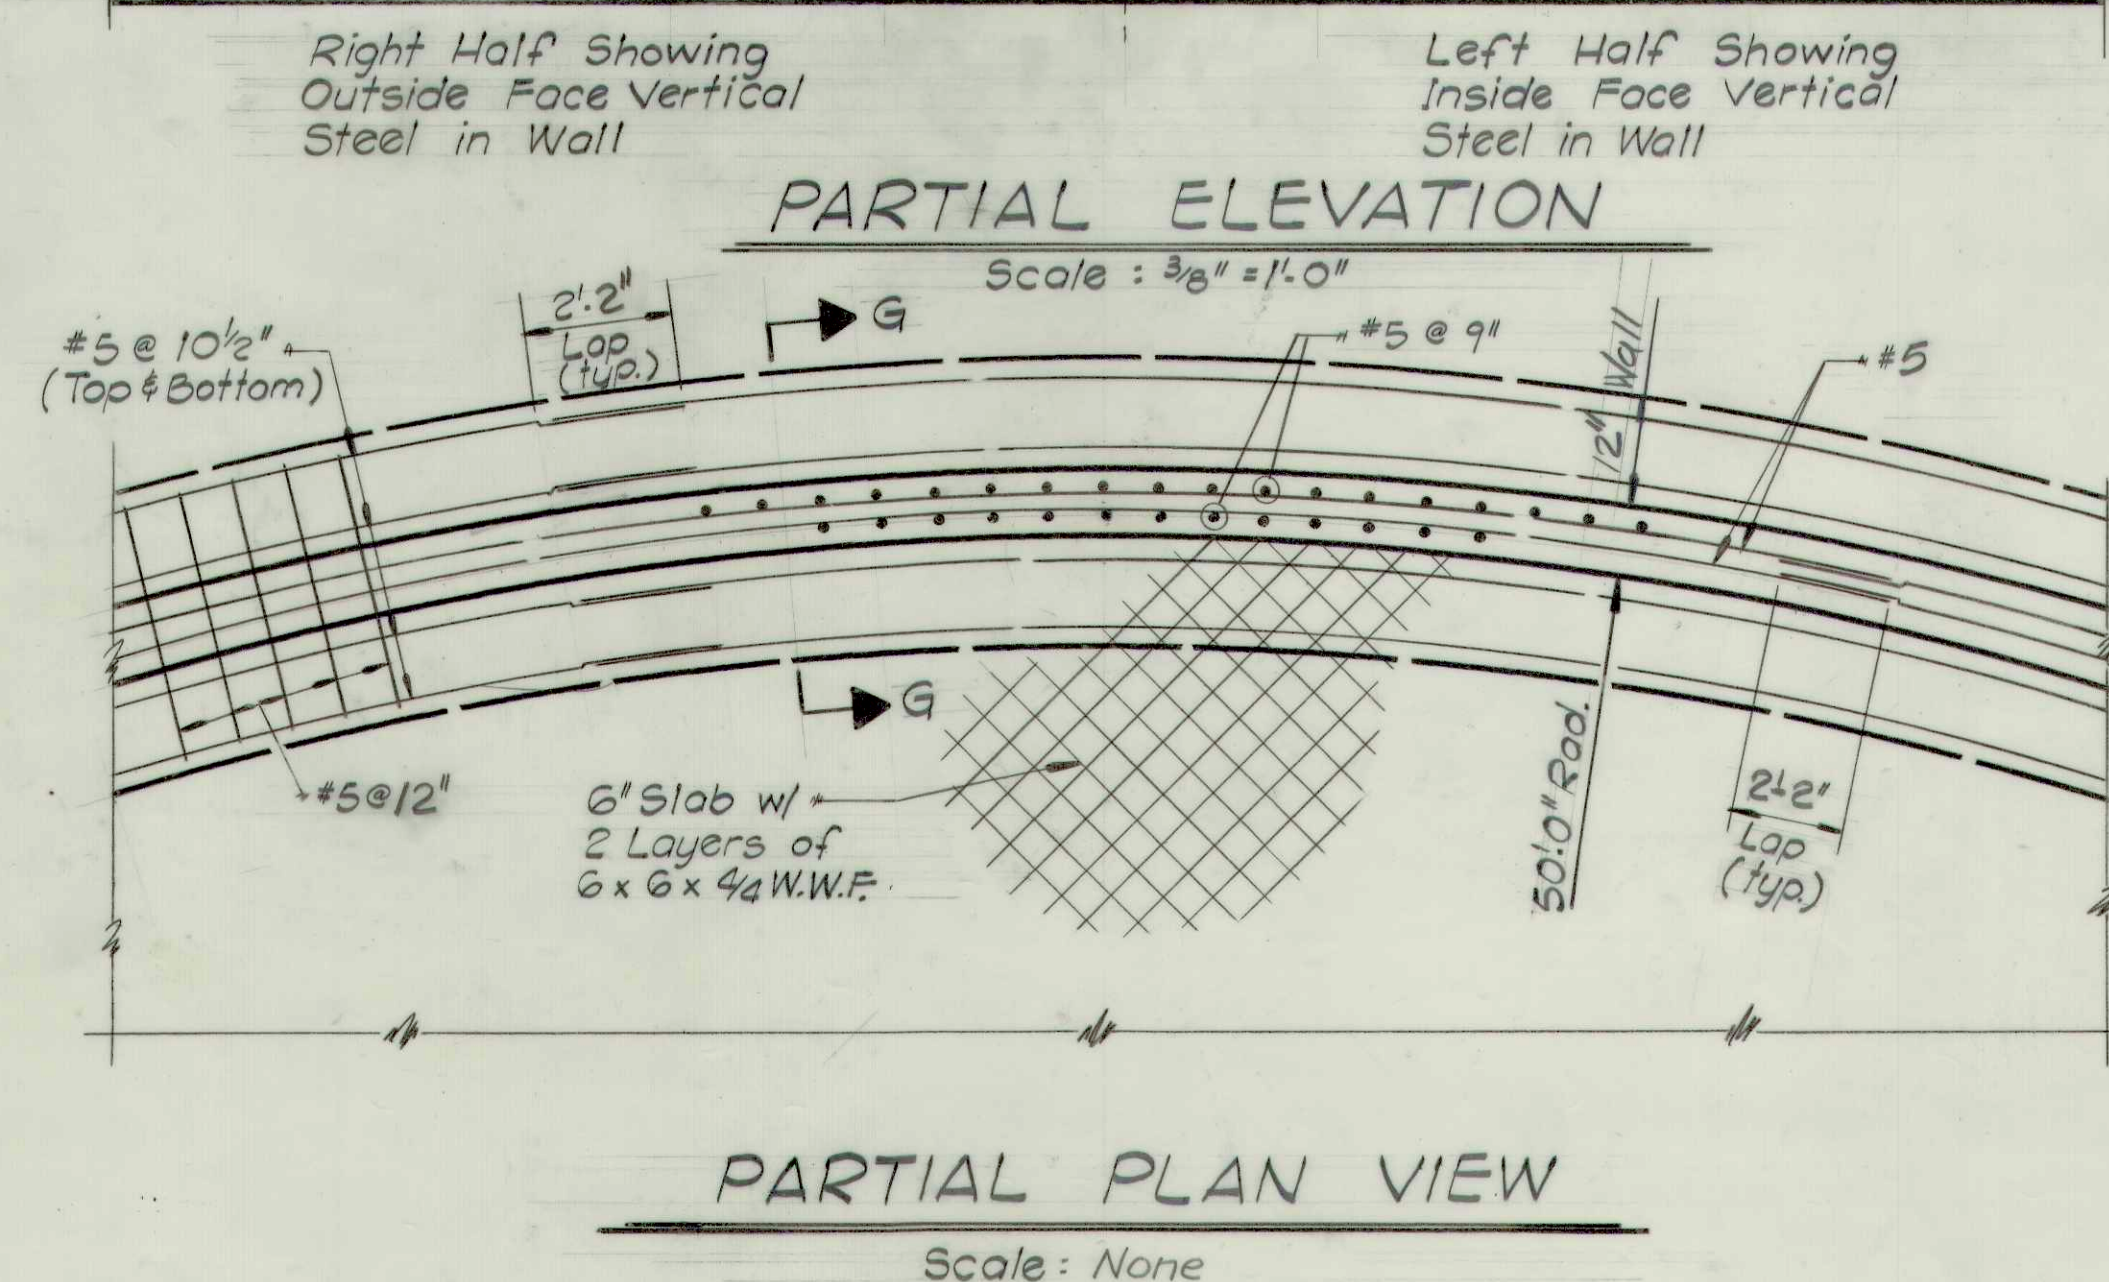
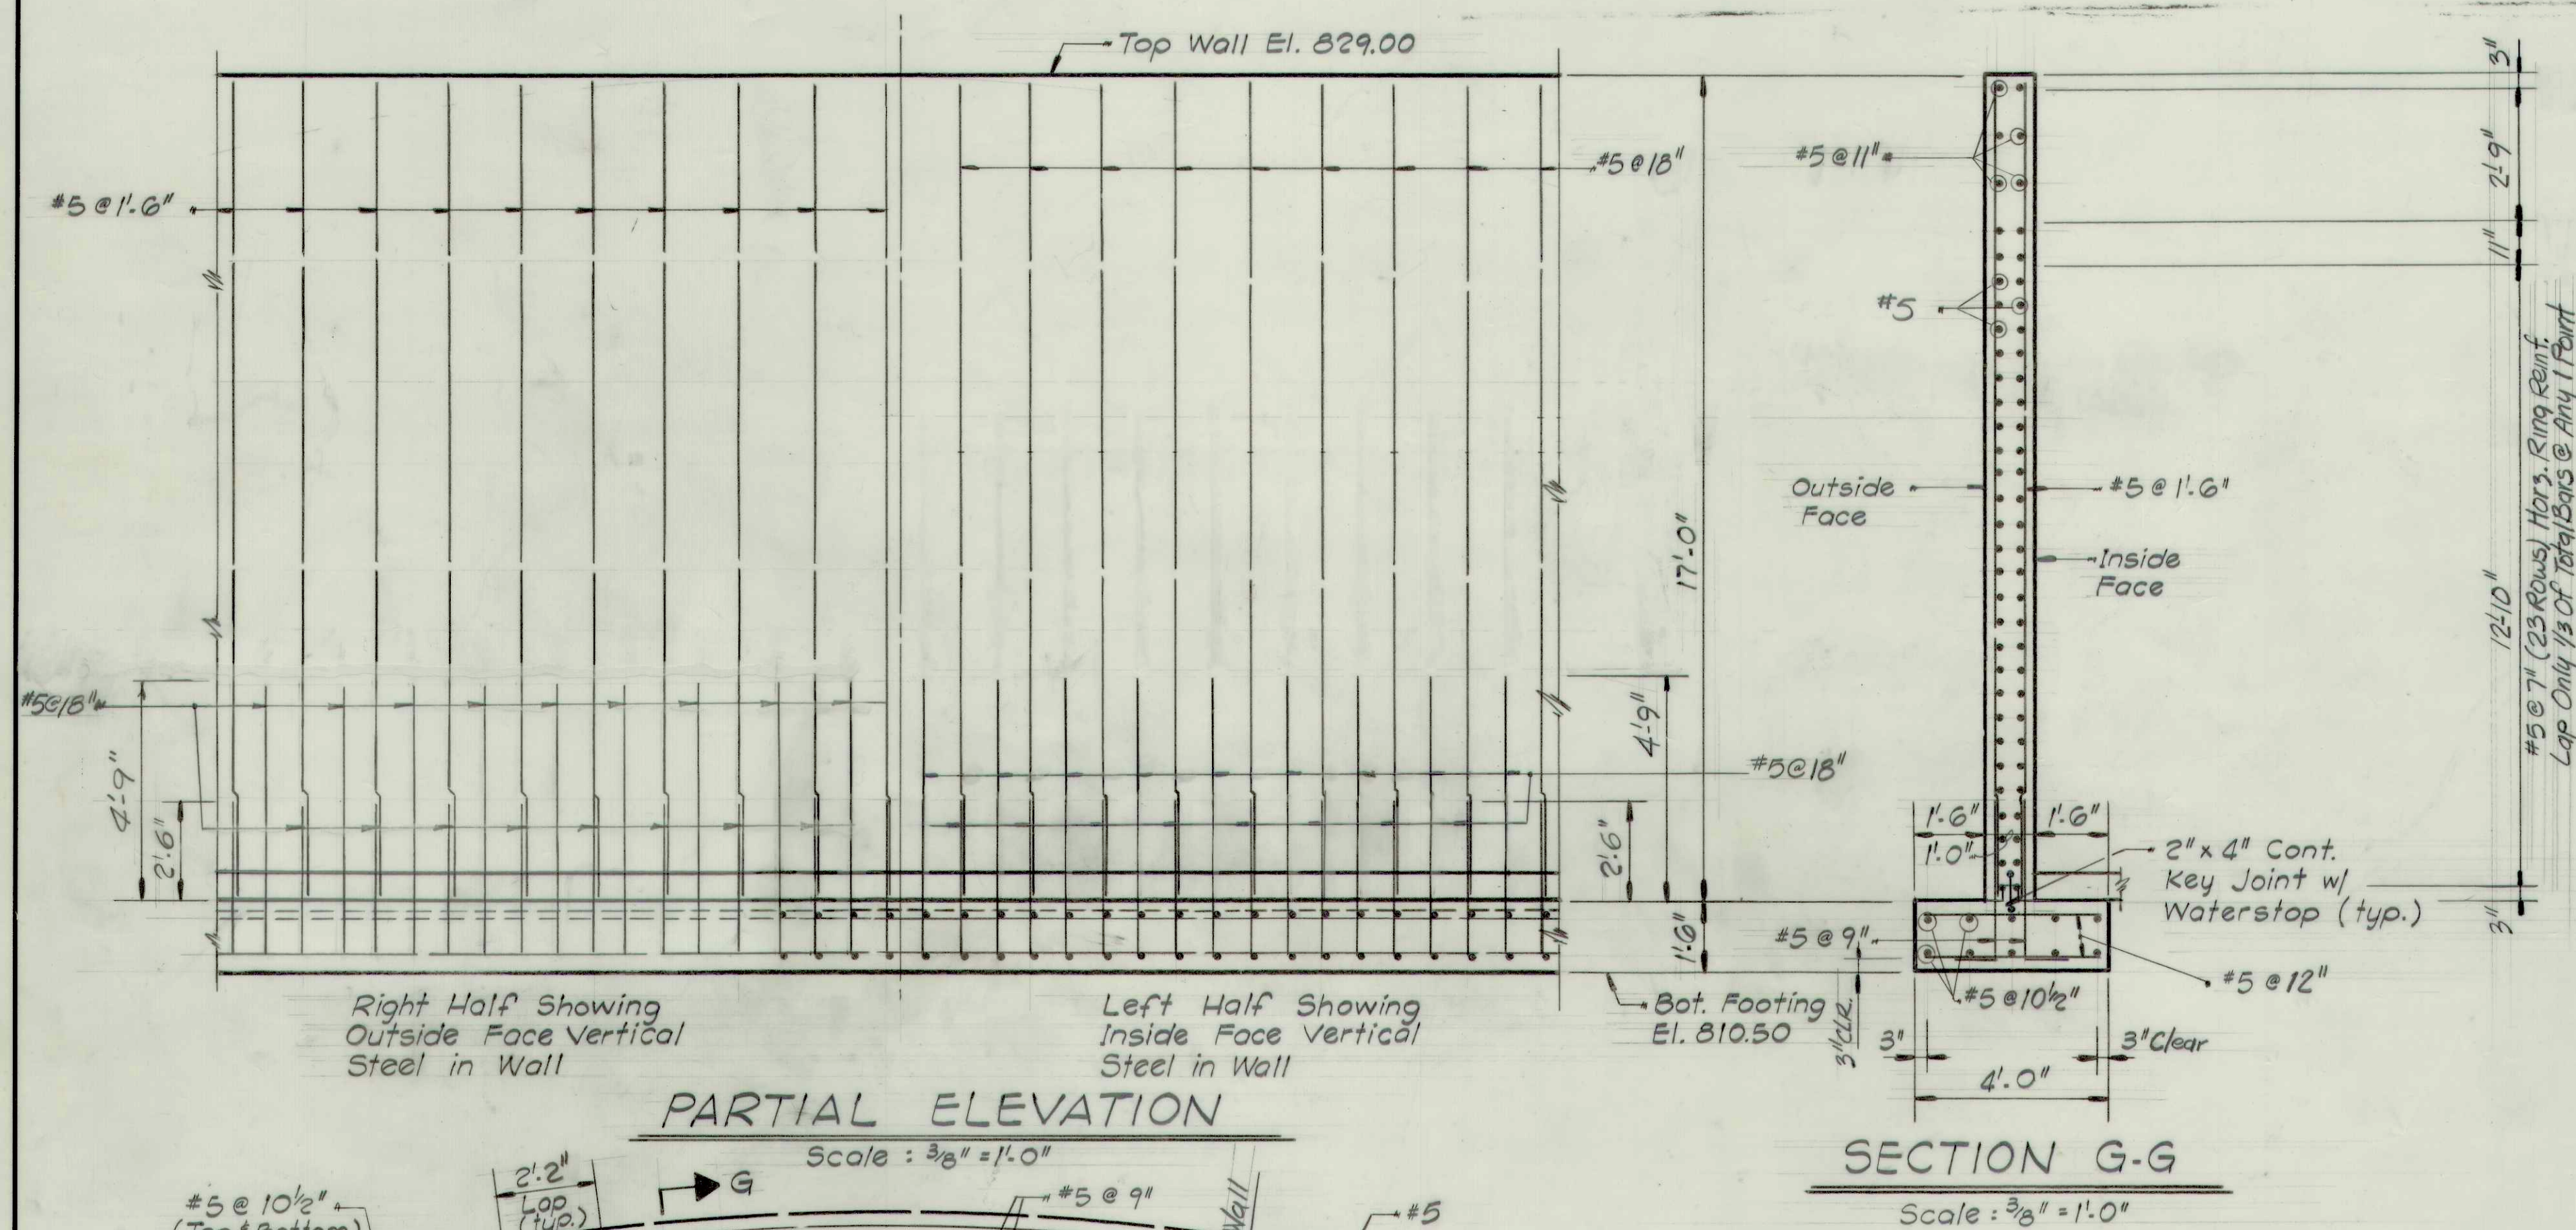
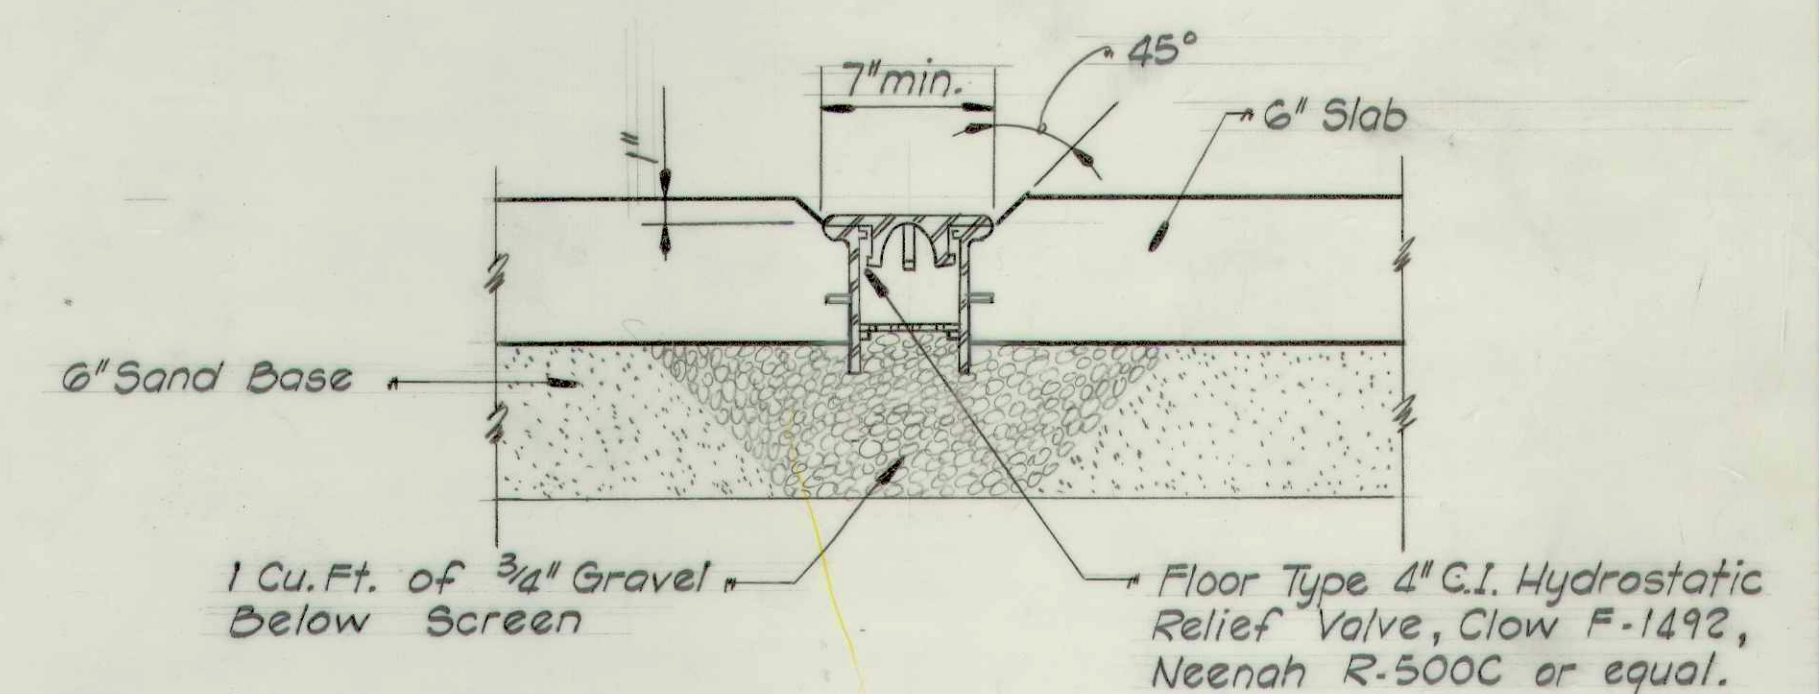
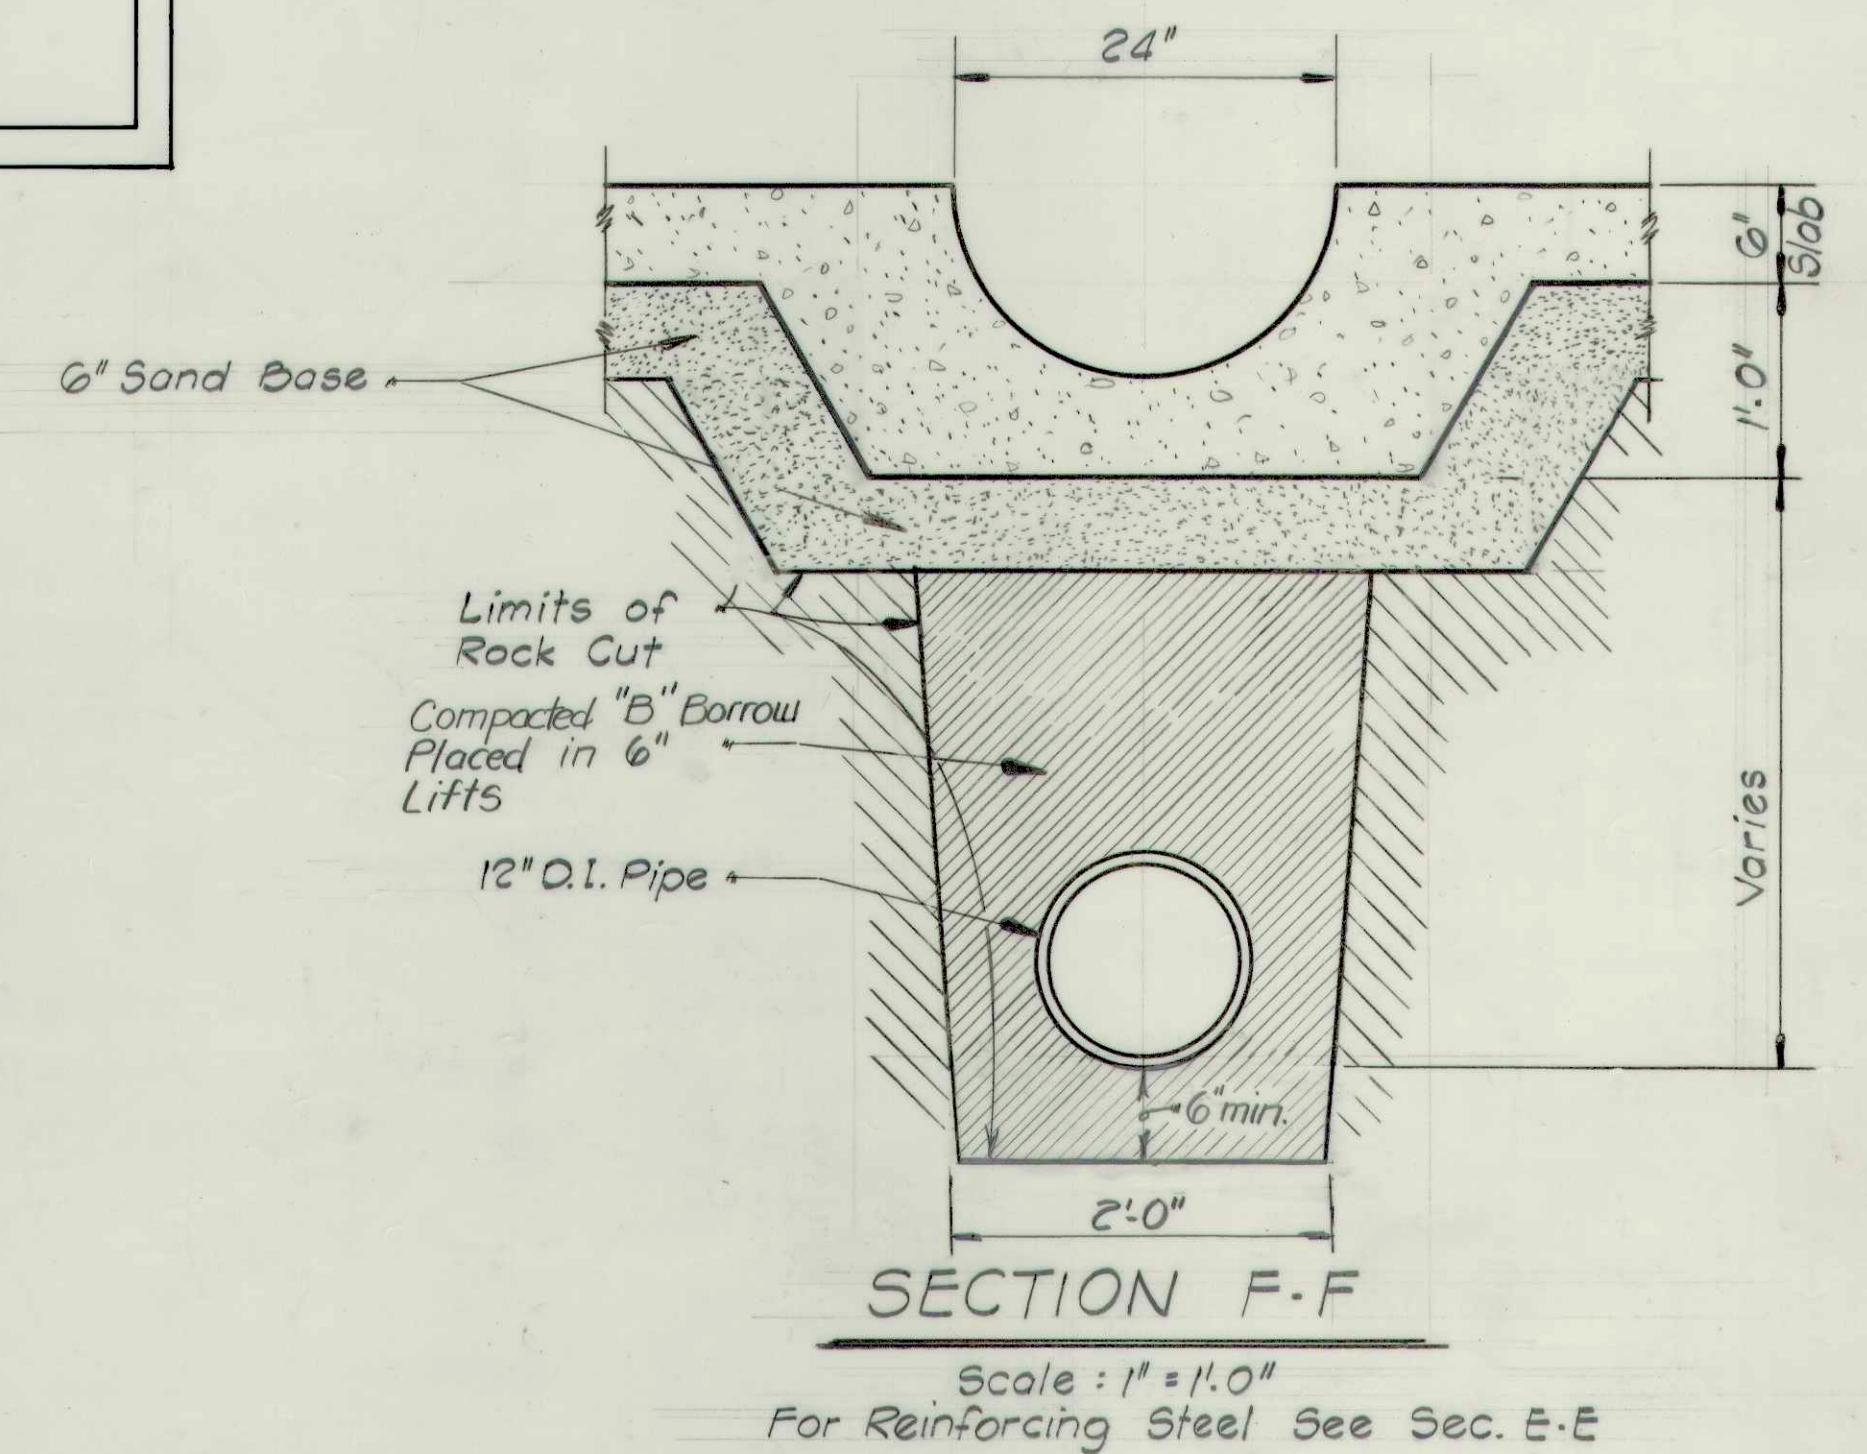
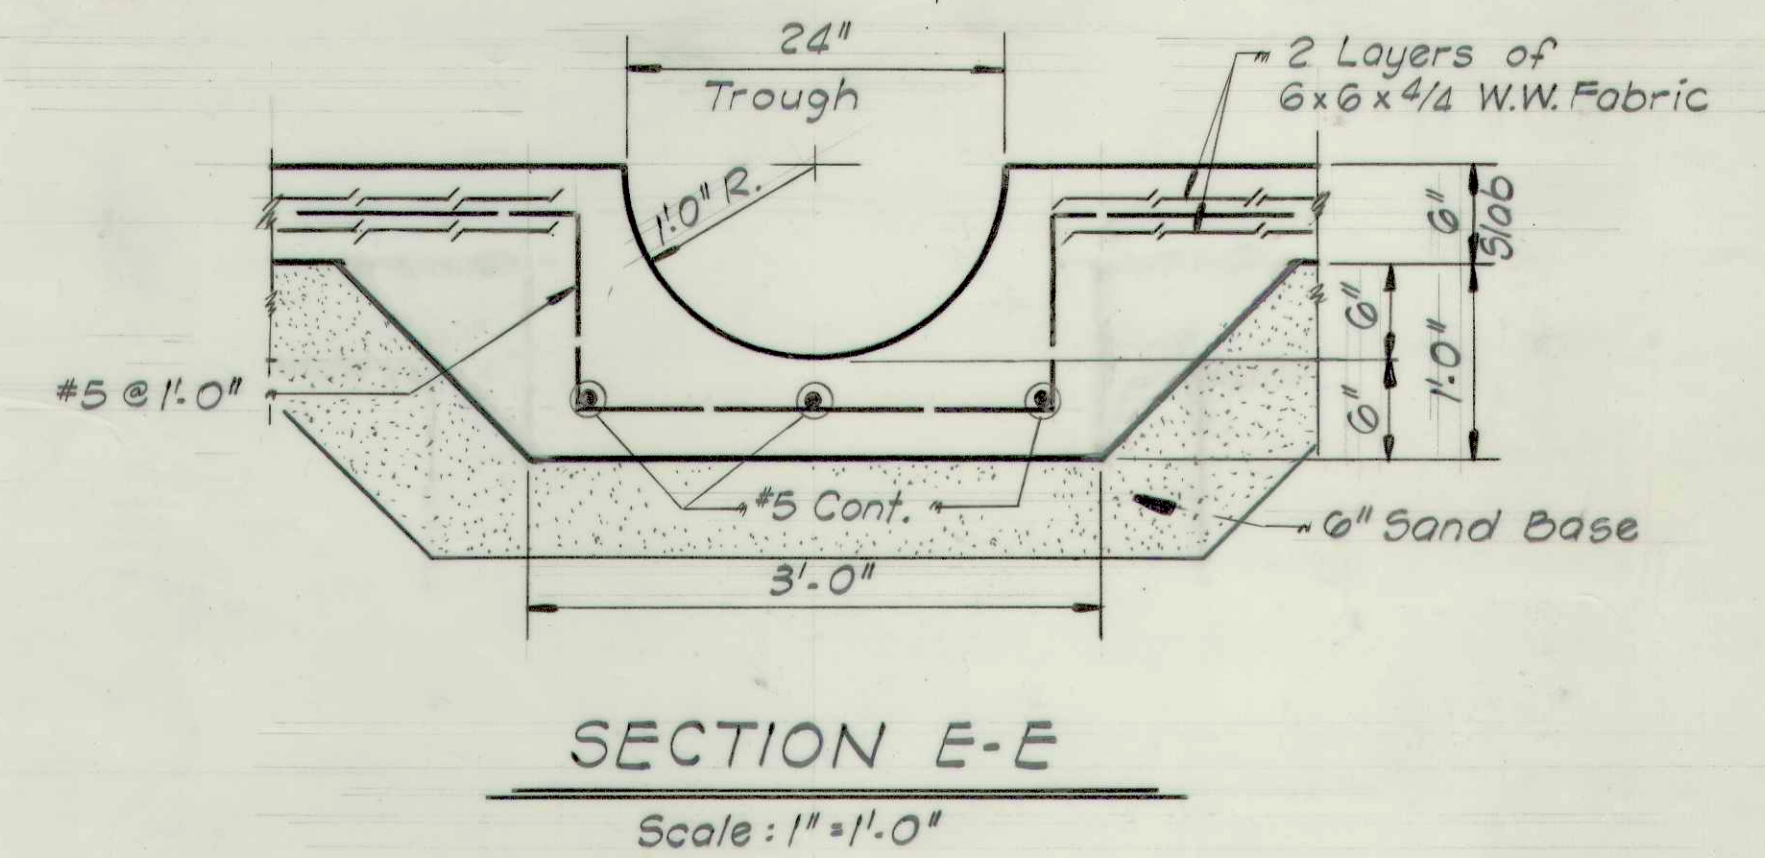


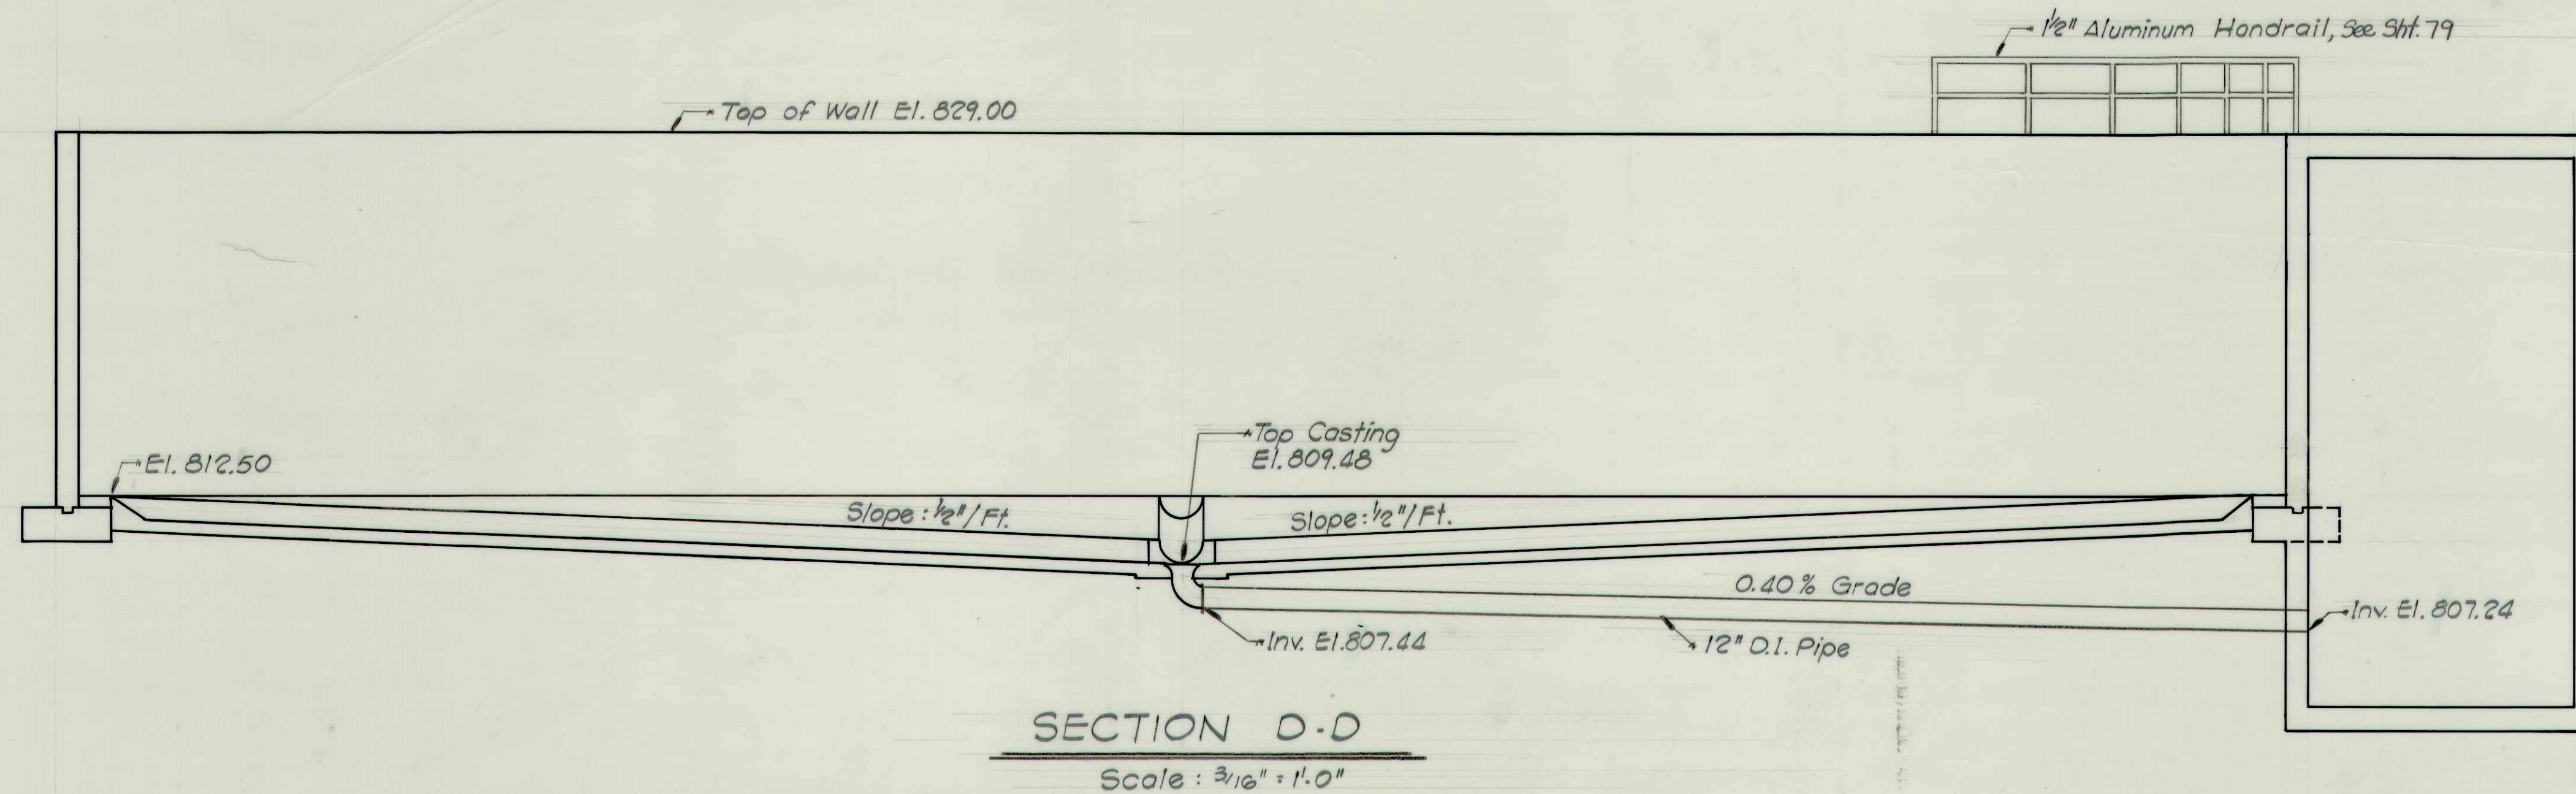

RECORD DRAWING

EQUALIZATION TANK DETAILS - STRUCTURAL		
Scale: AS SHOWN	FALL CREEK R.W.D.	Sheet
Drawn By: JB	BEAM, LONGEST & NEFF	81
Designed By: RFS	Consulting Engineers	
Certified By: E.R.	8136 Castleton Road Indianapolis, IN 46250	