

Technical drawings of a 12-inch diameter pipe with a 12-inch diameter manhole opening. The drawings include a plan view, an elevation view, and a detail view of the manhole opening.

PLAN

2/3 D, 8" Min.

W

C - W

D/4

E

ELEVATION

D/4

E

E

D/4

E

Carry Conc. To Solid Ground.

PLAN

D/4

G

G






E

ELEVATION




D/4

Scale: None
(Thrust Blocks To Be Provided At All Bends In Force Mains)

ends In Force Mains)

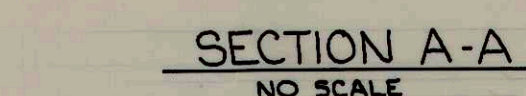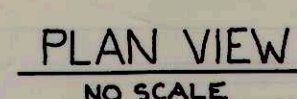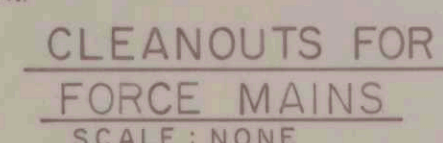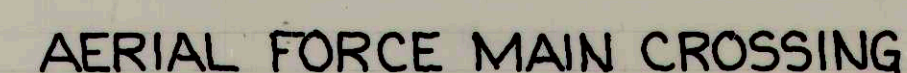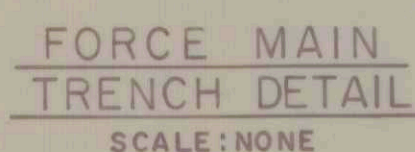

STREAM CROSSING DETAIL

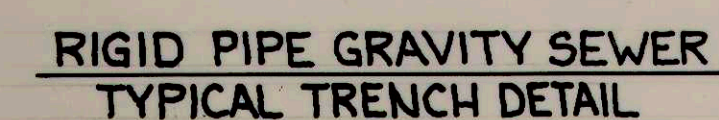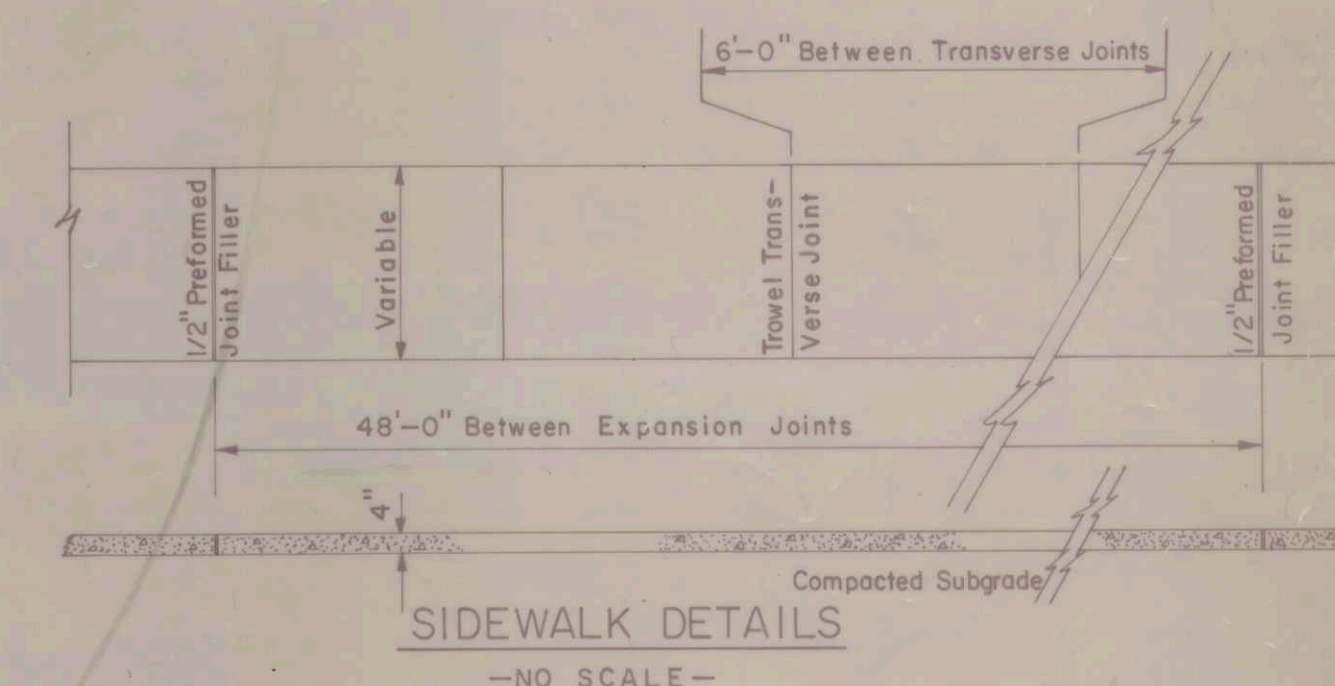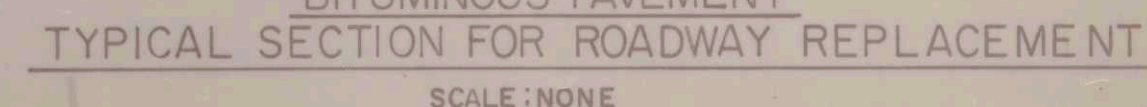

FALL CREEK R. W. D.

84