


PLAN	SURVEYED	DATE
NOTED	BY	
NO.		

PROFILE	SURVEYED	DATE
NOTED	BY	
NO.		



RECORD DRAWING

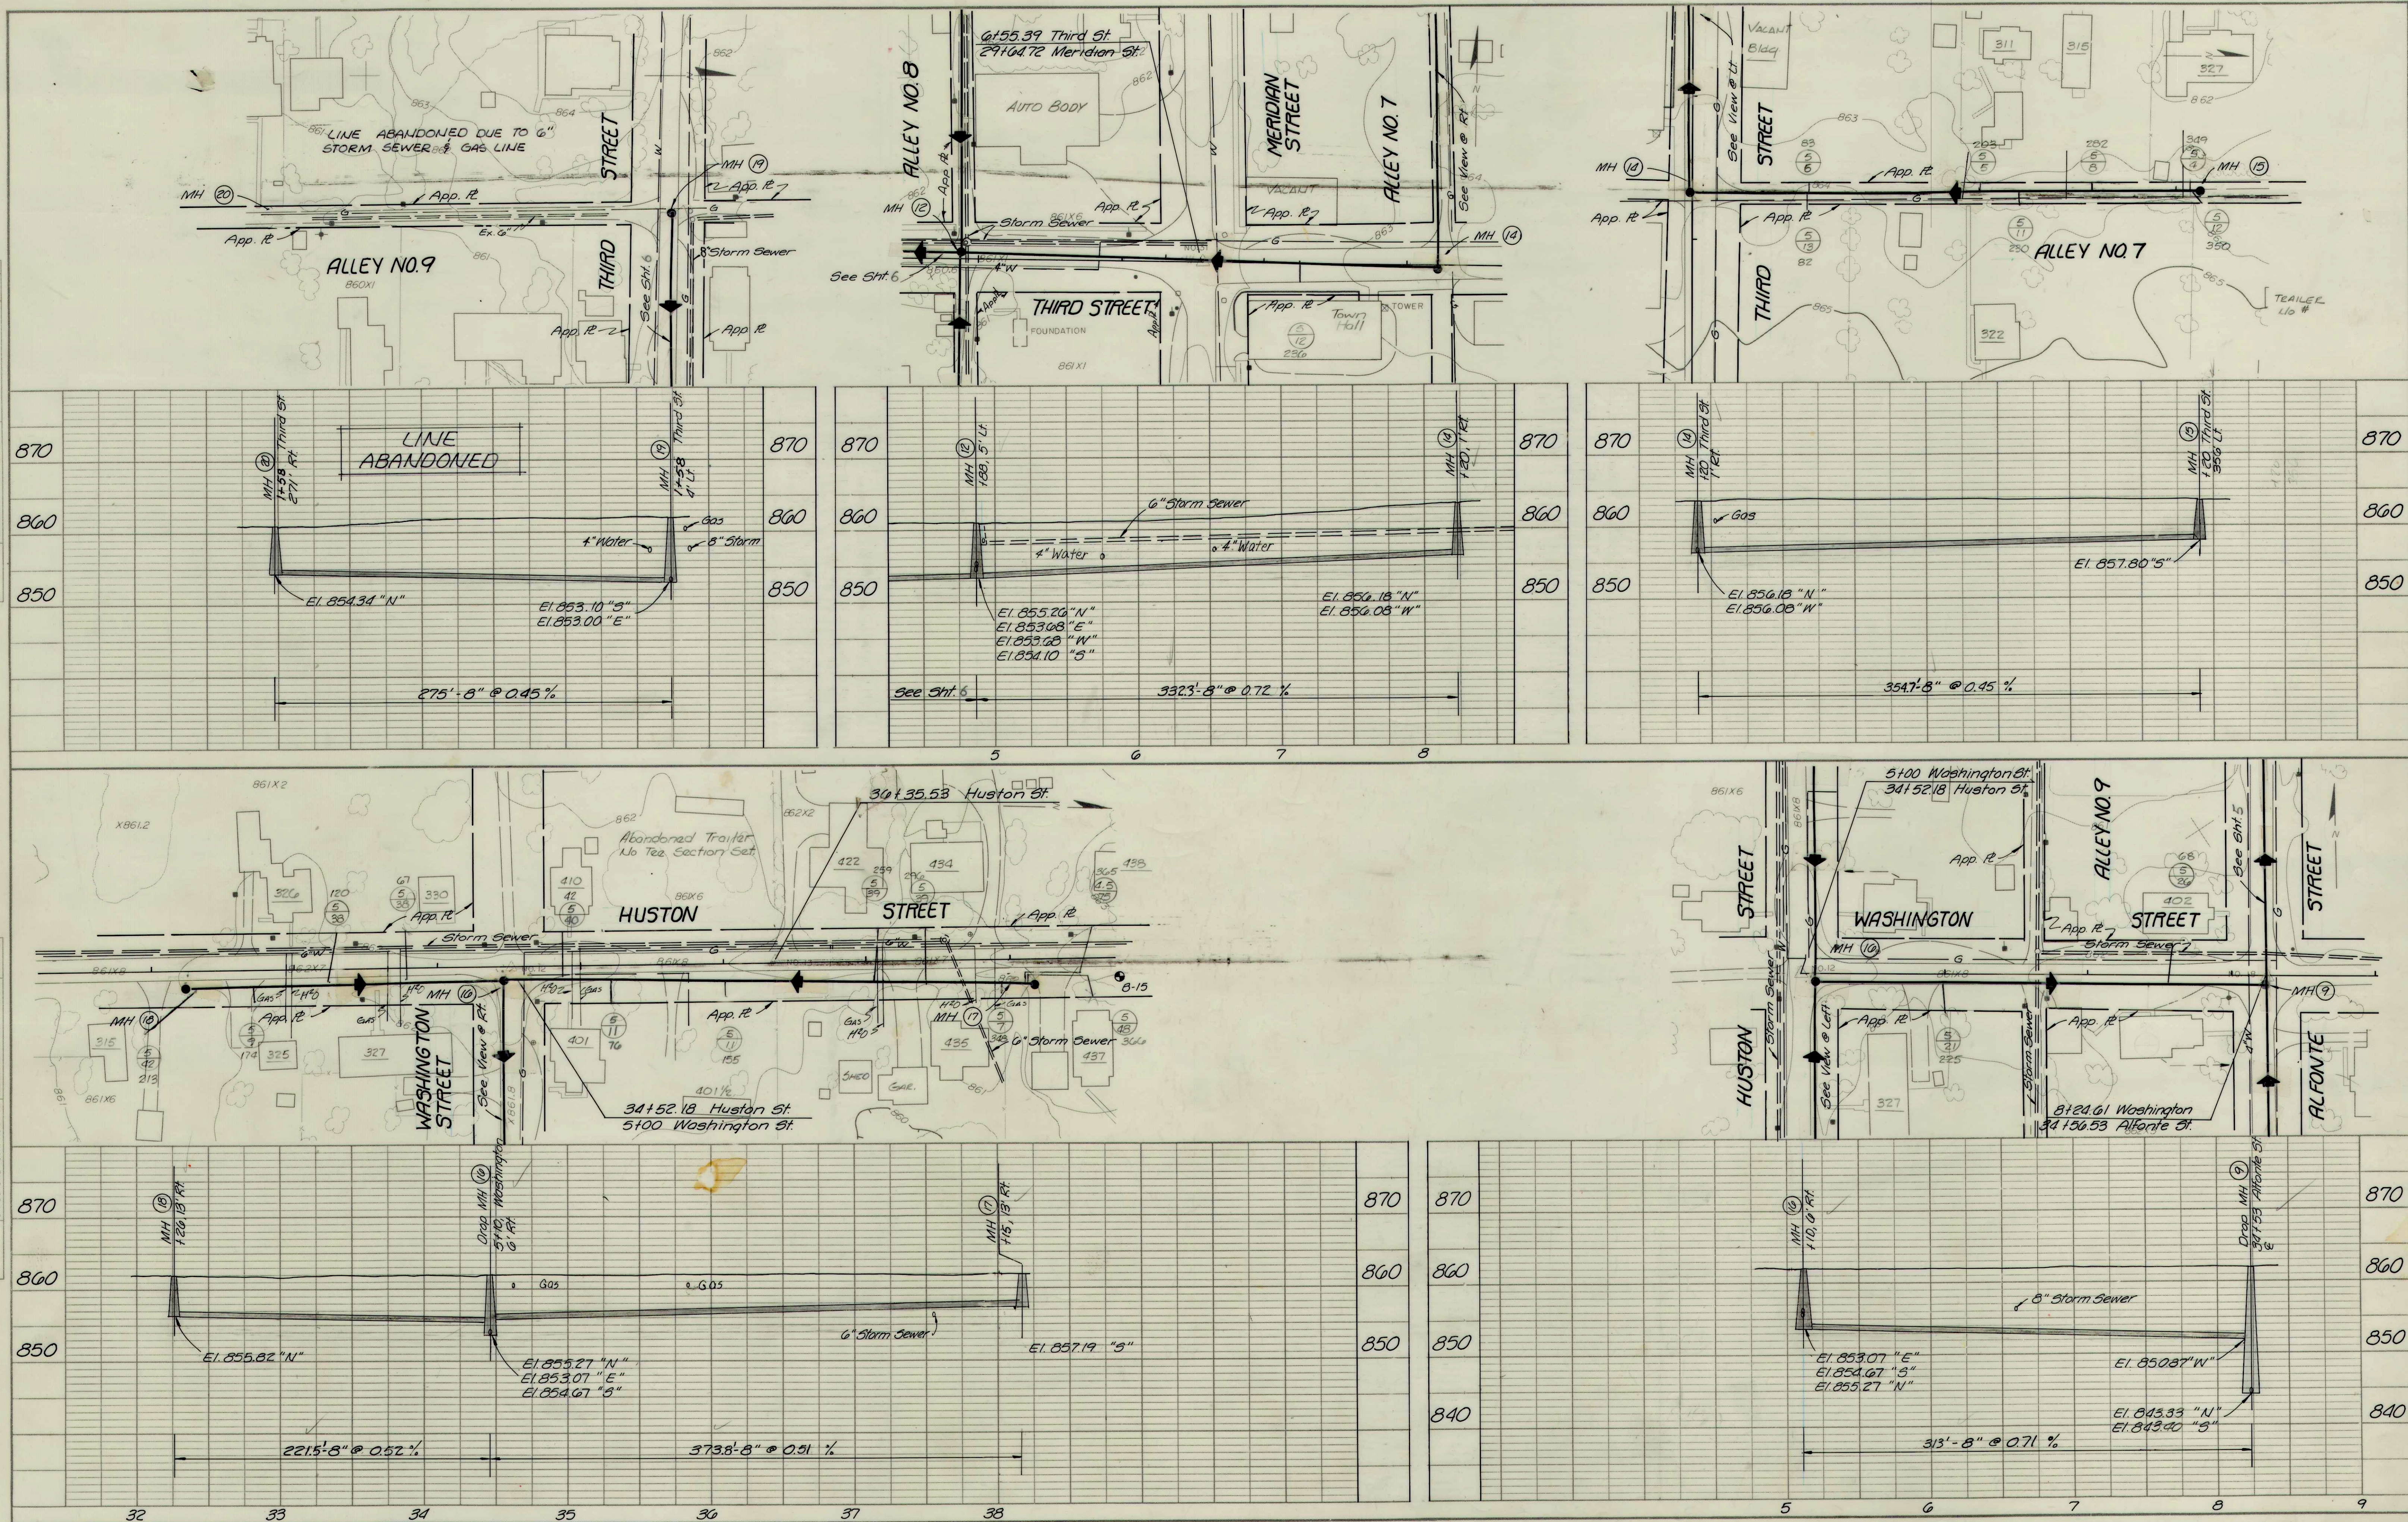

ALLEYS #7 & #9 WASHINGTON ST.
HUSTON ST. THIRD ST.
FALL CREEK R.W.D. PLAN & PROFILE SHEET
HORIZ. 1"=50' BEAM, LONGEST & NEFF, INC.
VERT. 1"=10' CONSULTING ENGINEERS
INDIANAPOLIS, INDIANA 9