


862 E Broadway, Ingalls, IN

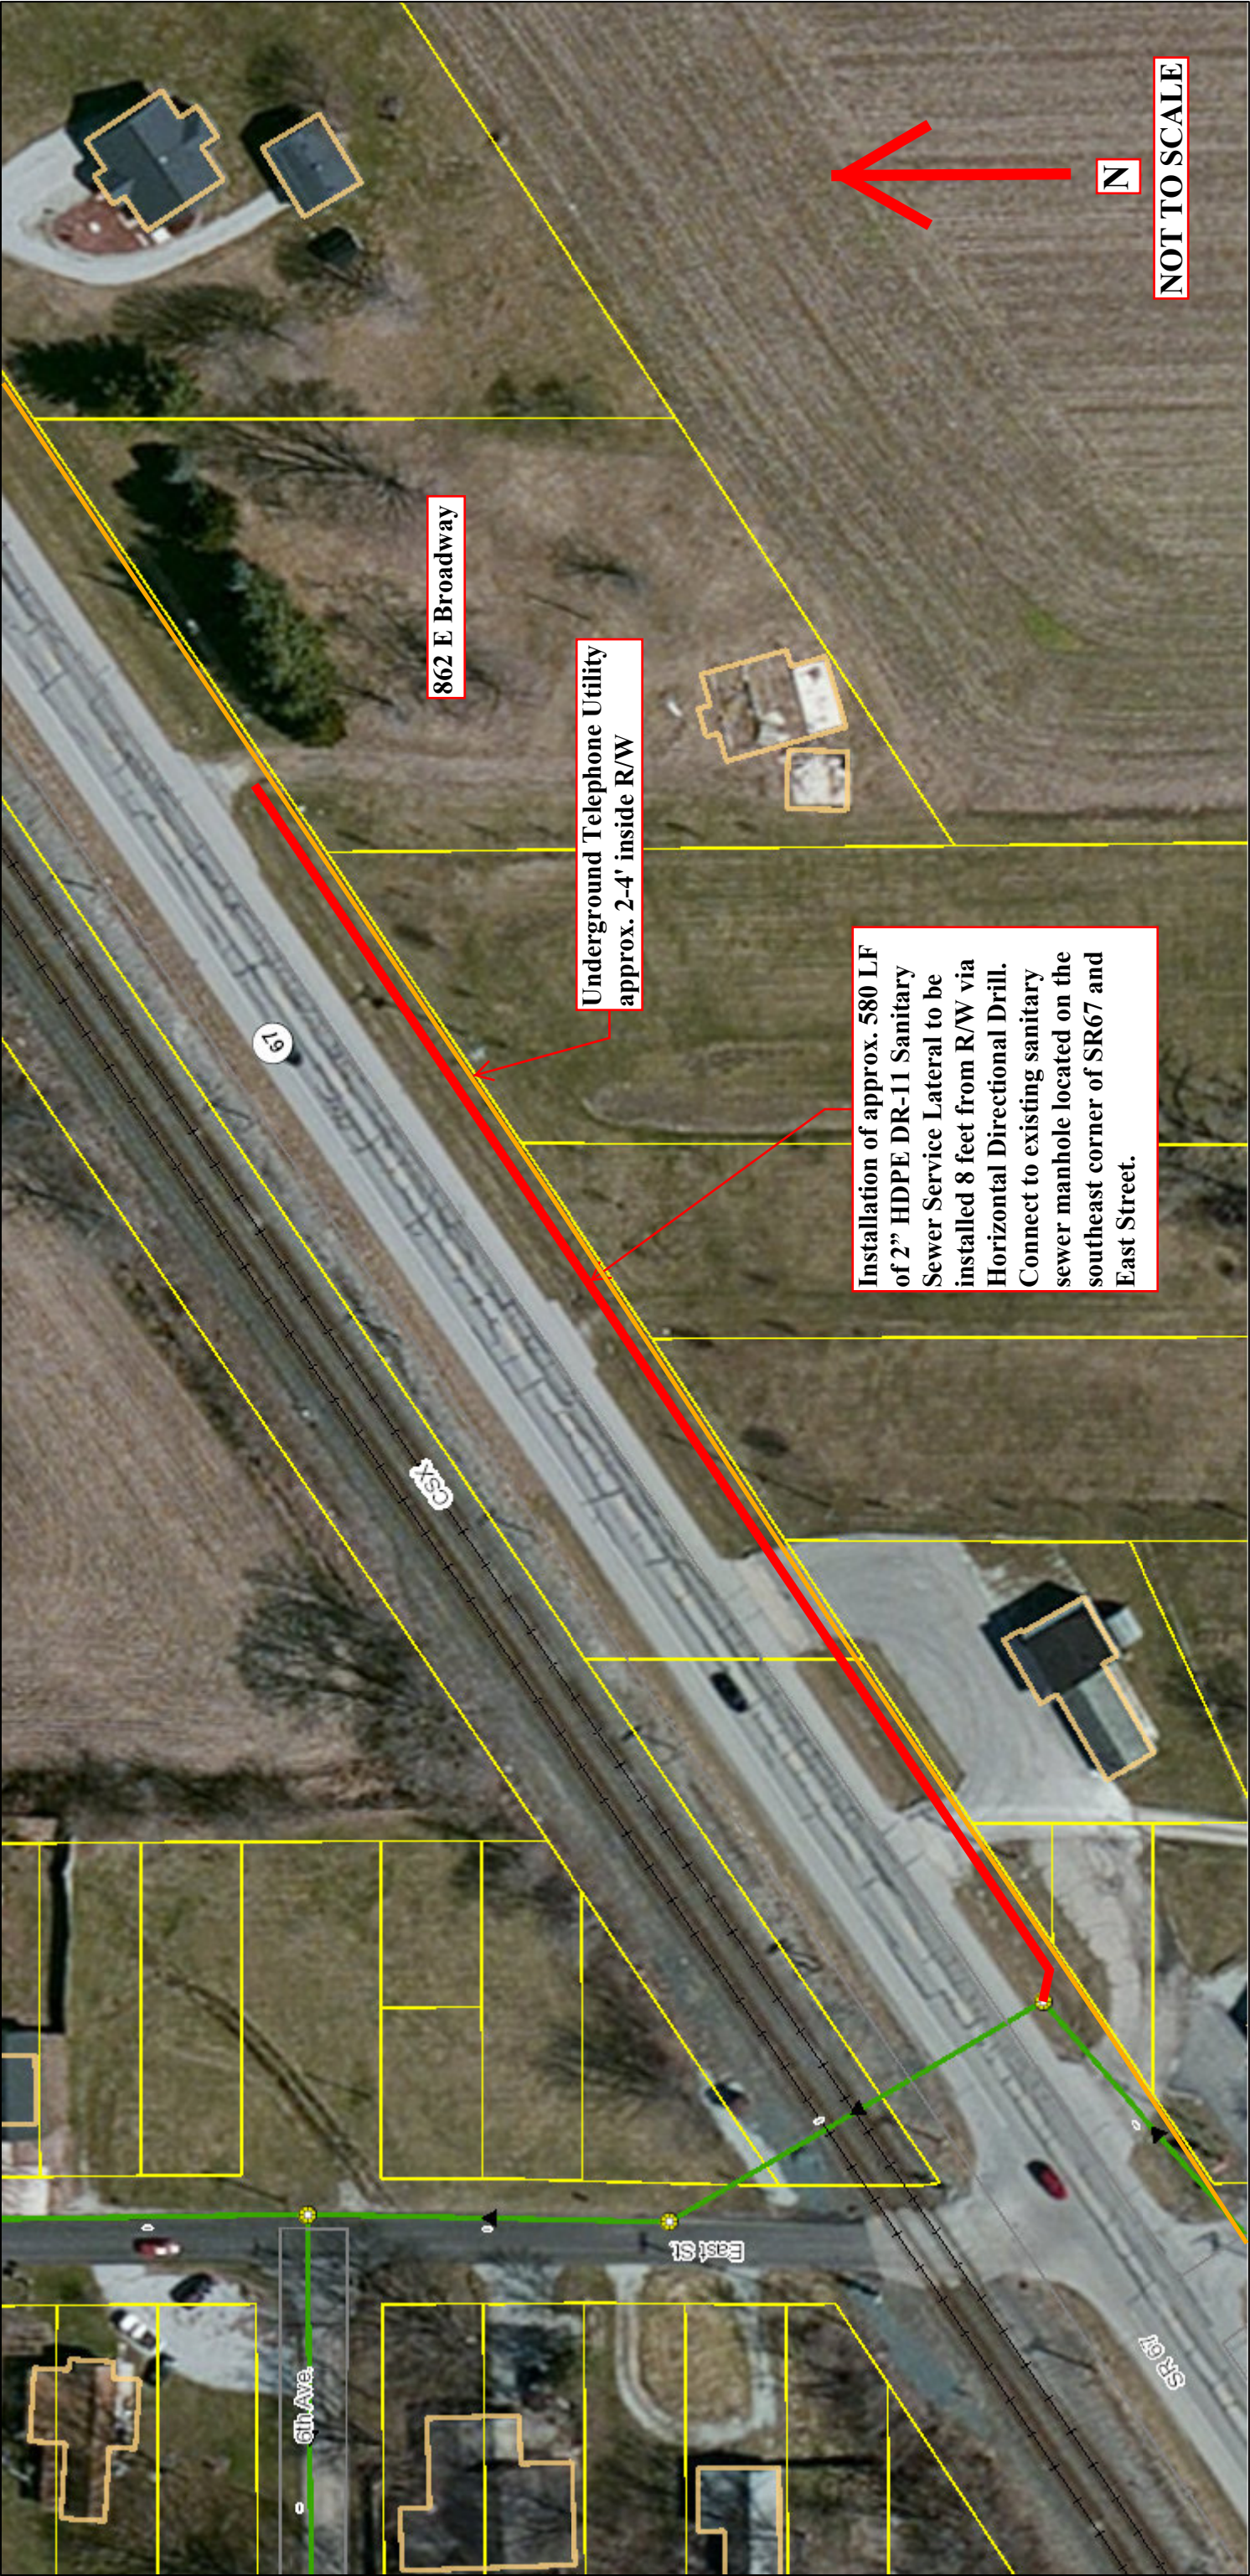

September 13, 2016

Lateral Top Connection

	Not Plugged		State Highways		Network Structure		Sanitary Main		Buildings		Main and Lateral (R/W only) Rehabs
	Plugged		Interstate Labels		Lateral Line		Proposed Sanitary Main		Parcels		MapGrid
	Road Edge		Interstate 69		Not Plugged		Curb Inlet		Hydrology		Lateral Connections
	Railroads		Manhole		Plugged		Catch Basin		Sewer Rehabilitation Main and Lateral Rehab		Lateral Connections with Permits
	Street Centerlines		Proposed Manhole		Sanitary Main		Storm Manhole		Lateral Rehabs Only		
					Abandoned Main		Storm Pipe				

Source: Esri, DigitalGlobe, GeoEye, Earthstar Geographics, CNES/Airbus DS, USDA, USGS, AEX, Getmapping, Aerogrid, IGN, IGP, swisstopo, and the GIS User Community