



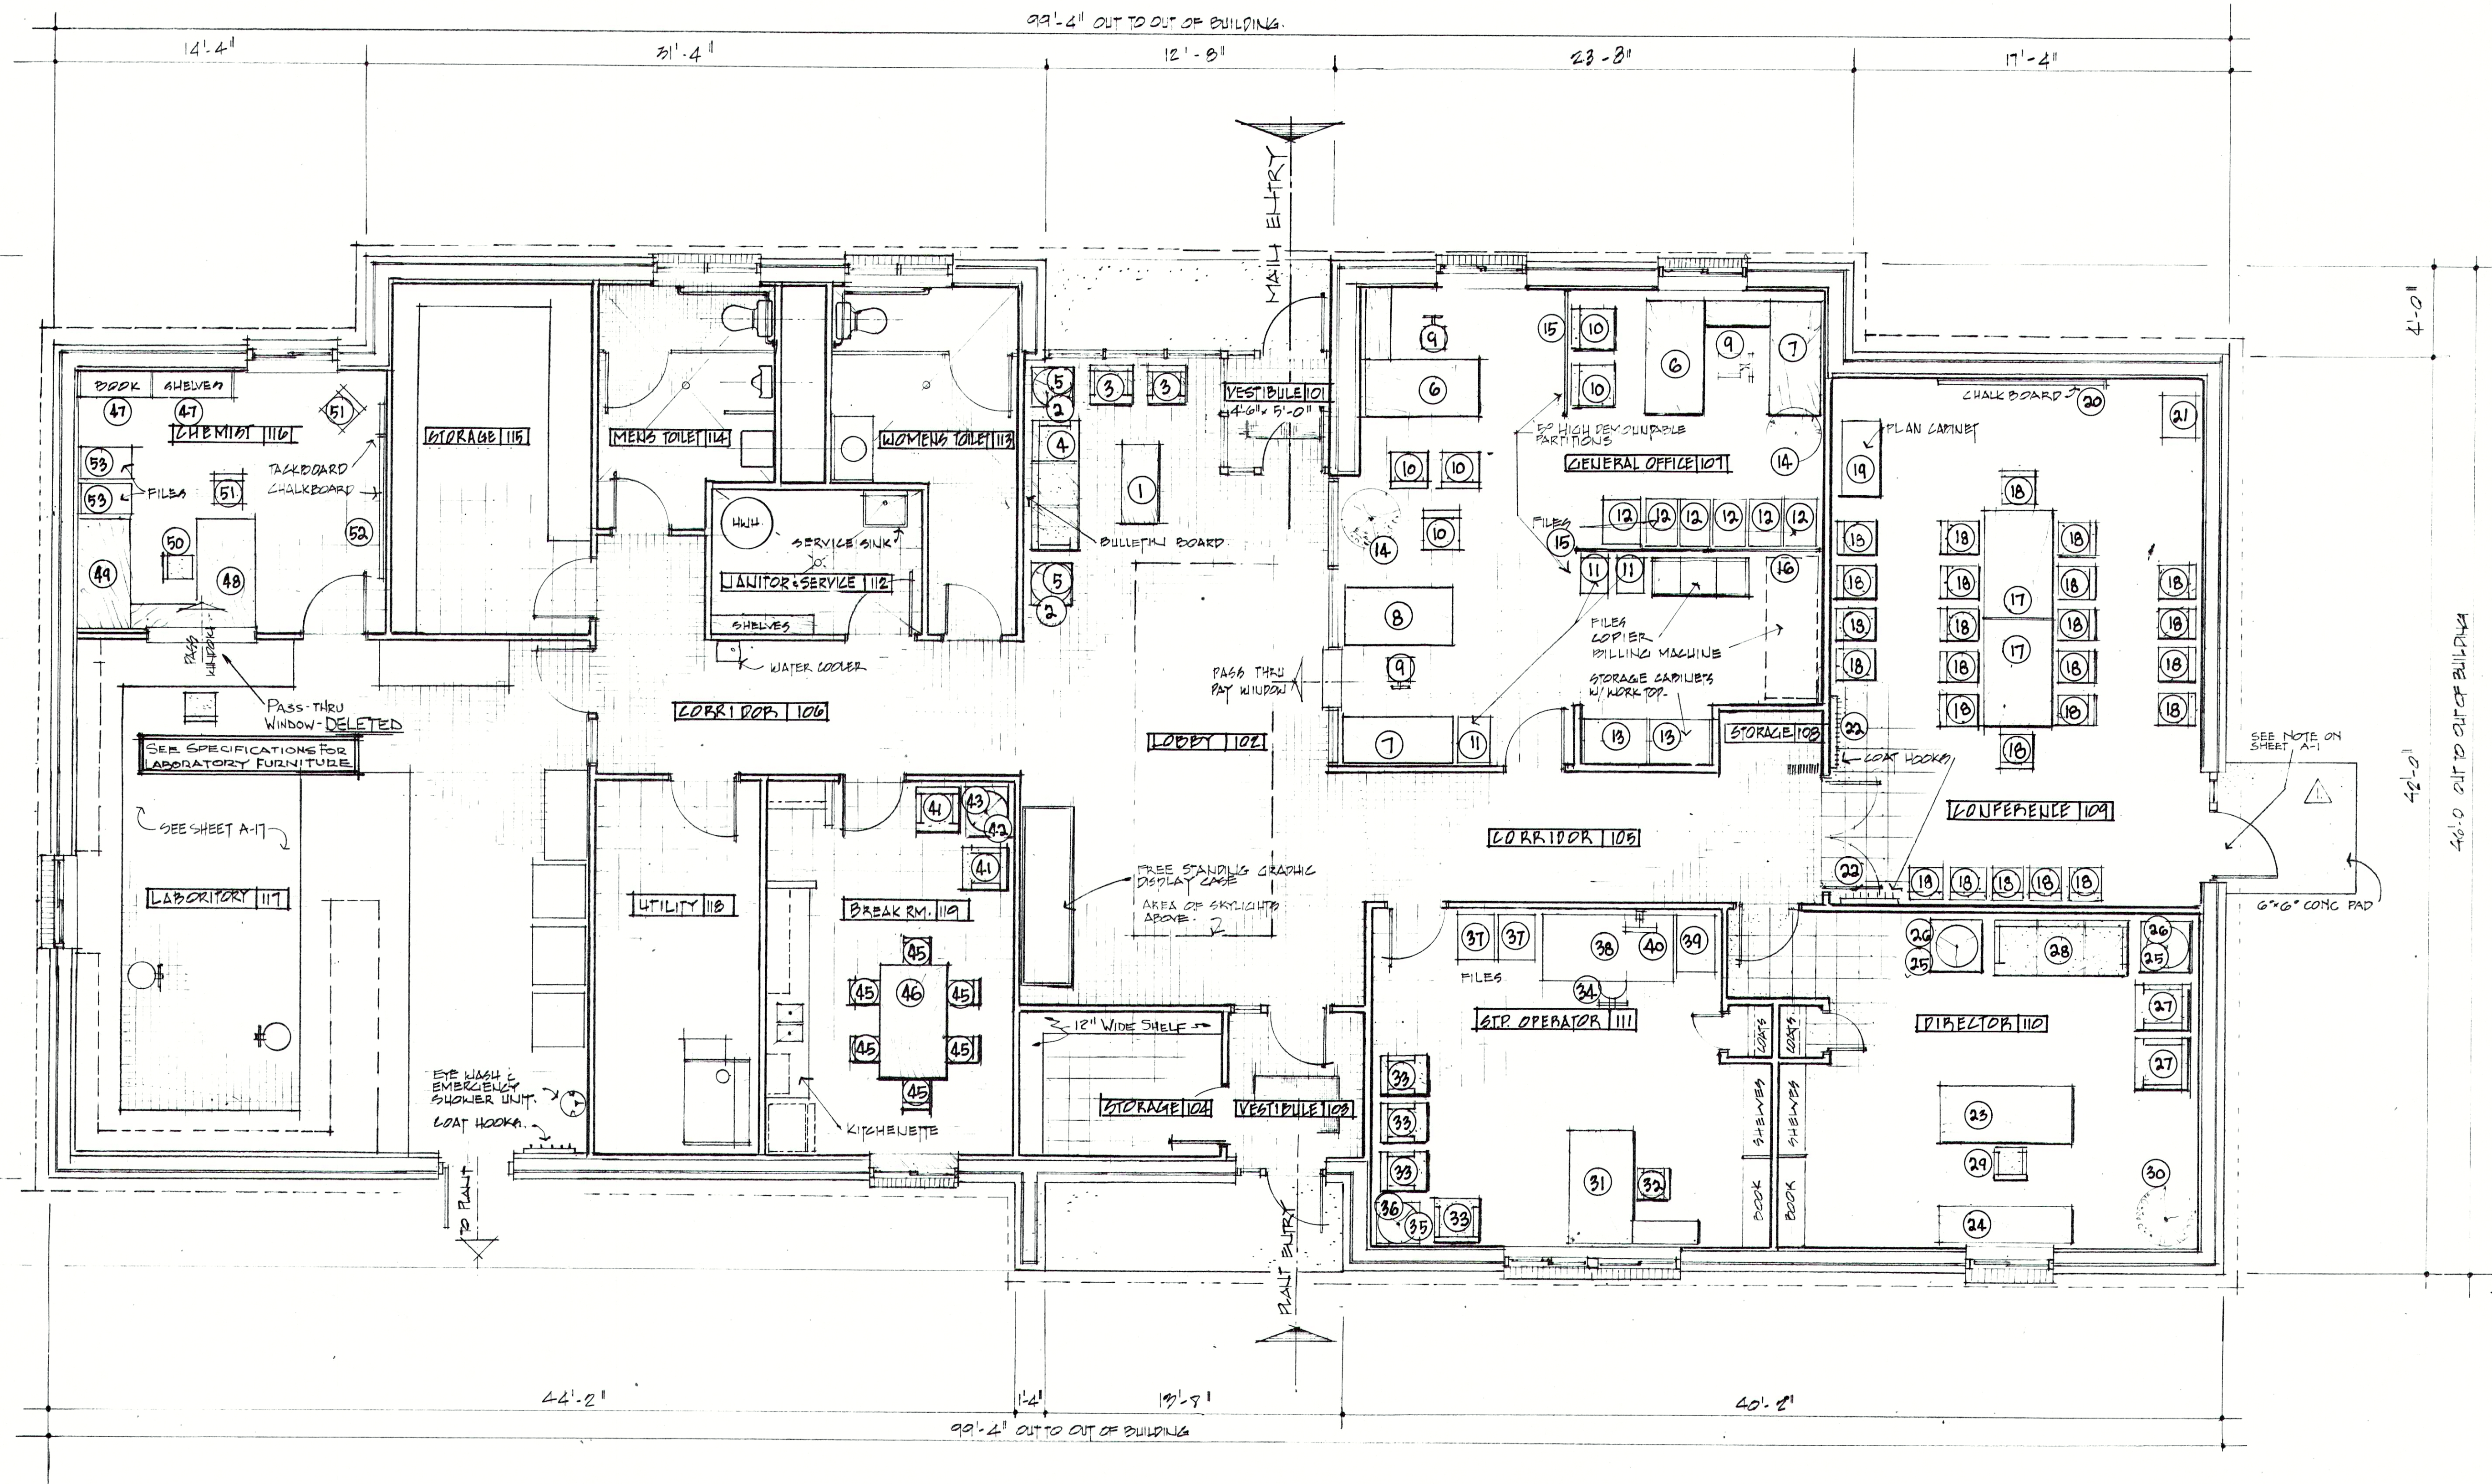

ADMINISTRATION / LABORATORY

SCALE: 1/4" = 1'-0"

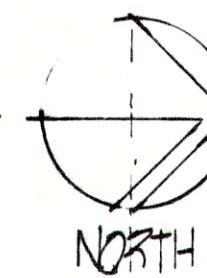


OFFICE FURNITURE LAYOUT

RECORD DRAWING

REVISIONS	
1. REV. 6-29-83	ELN

FALL CREEK REGIONAL
WASTE DISTRICT
WASTEWATER FACILITIES
PENDLETON, INDIANA

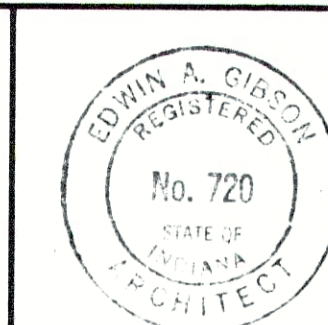

edgibson and associates
INCORPORATED

ARCHITECTS
INDIANAPOLIS, INDIANA

DRAWN BY **RKD** ACCT. NO.

CHECKED BY **EXG** DATE **3-30-83**

CERTIFIED BY **Edwin A. Gibson**

SHEET NO.

A-2

39

OF