


WEST ELEVATION

SCALE: $\frac{1}{8}'' = 1'-0''$

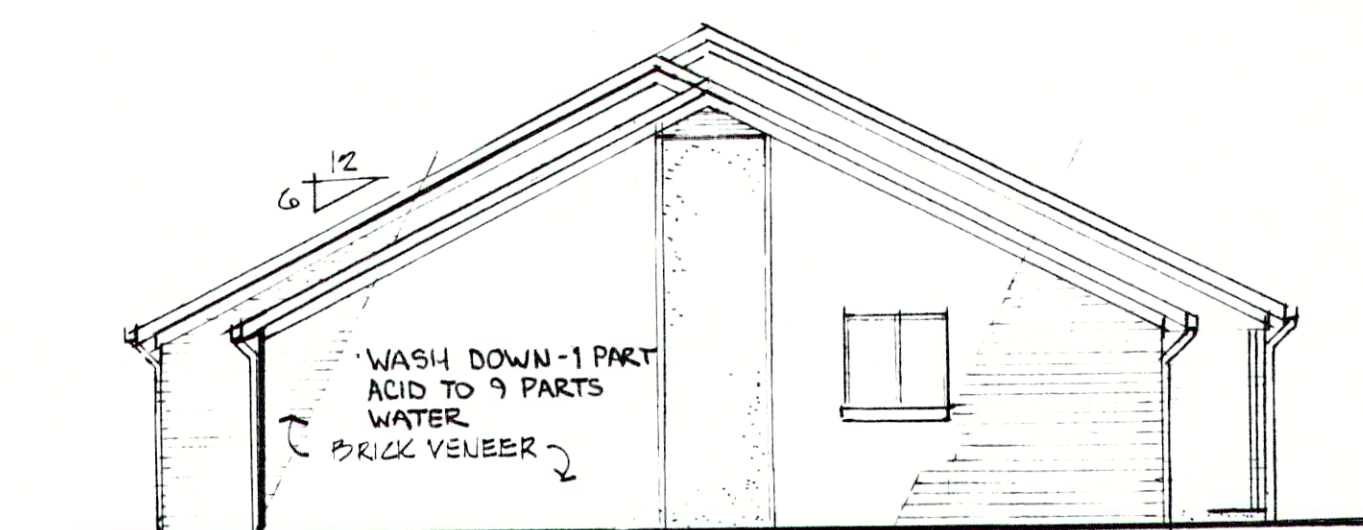


SOUTH ELEVATION

SCALE: $\frac{1}{8}'' = 1'-0''$



EAST ELEVATION

SCALE: $\frac{1}{8}'' = 1'-0''$

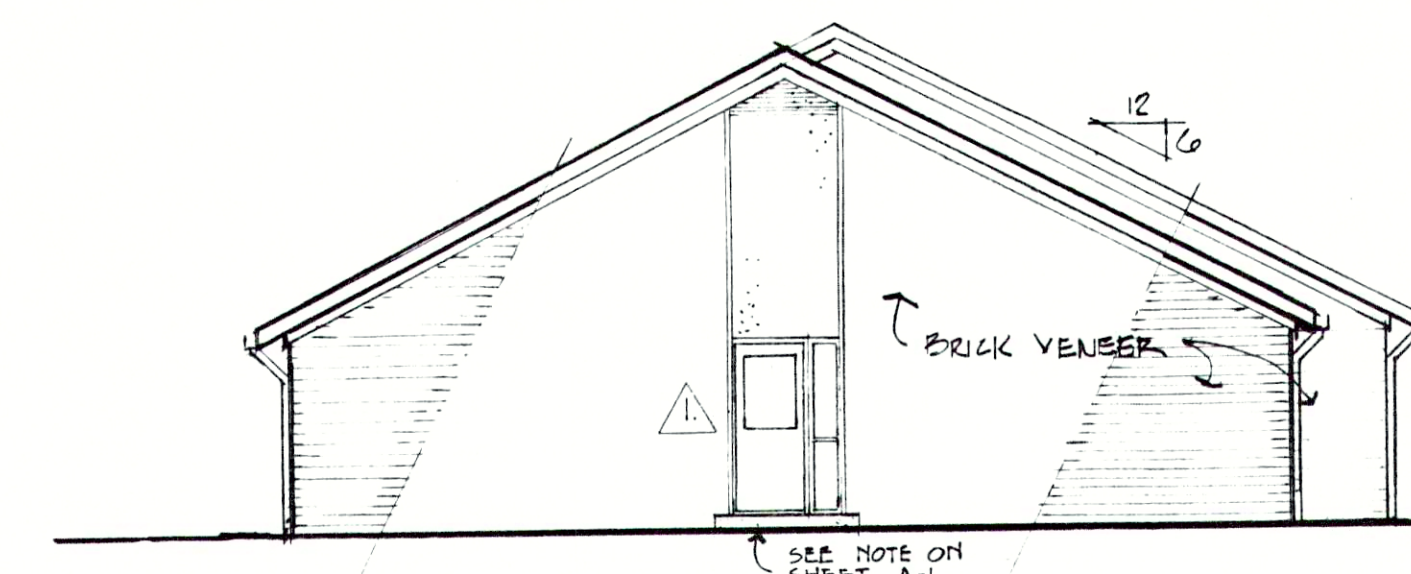

NORTH ELEVATION

SCALE: $\frac{1}{8}'' = 1'-0''$

NOTE: ALL DOWNSPOUTS SHALL BE EXTENDED BE GRADE AND CONNECTED TO 15" STORM AT WEST SIDE OF BUILDING

RECORD DRAWING

REVISIONS			SHEET NO.	
1	REV. 6-29-83	ELN	A-4	
			</	