
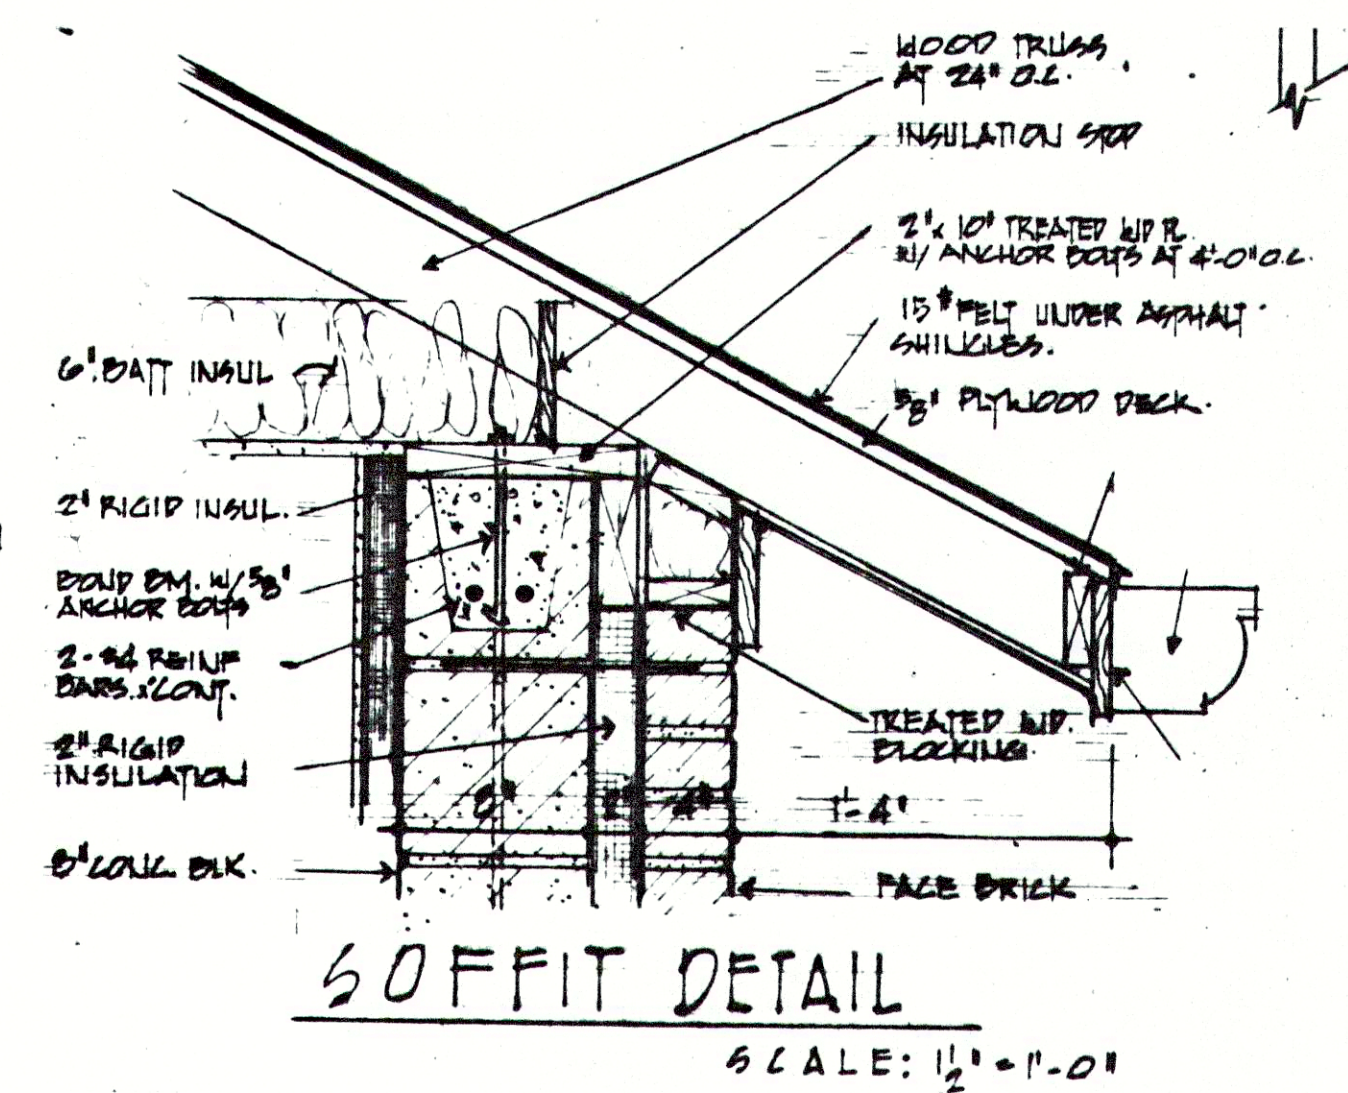
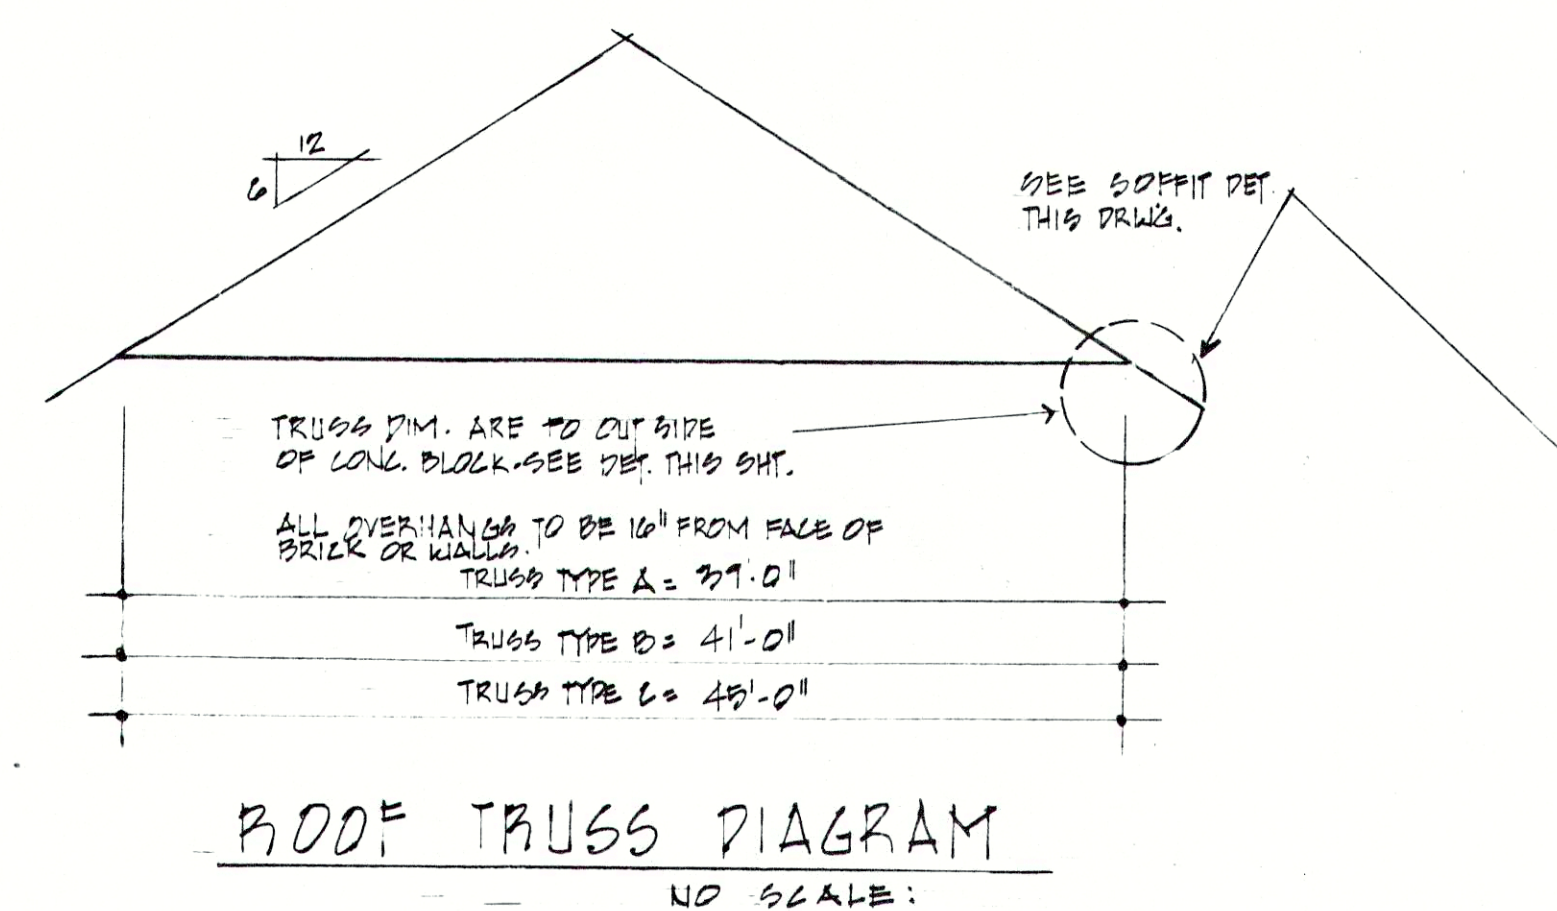
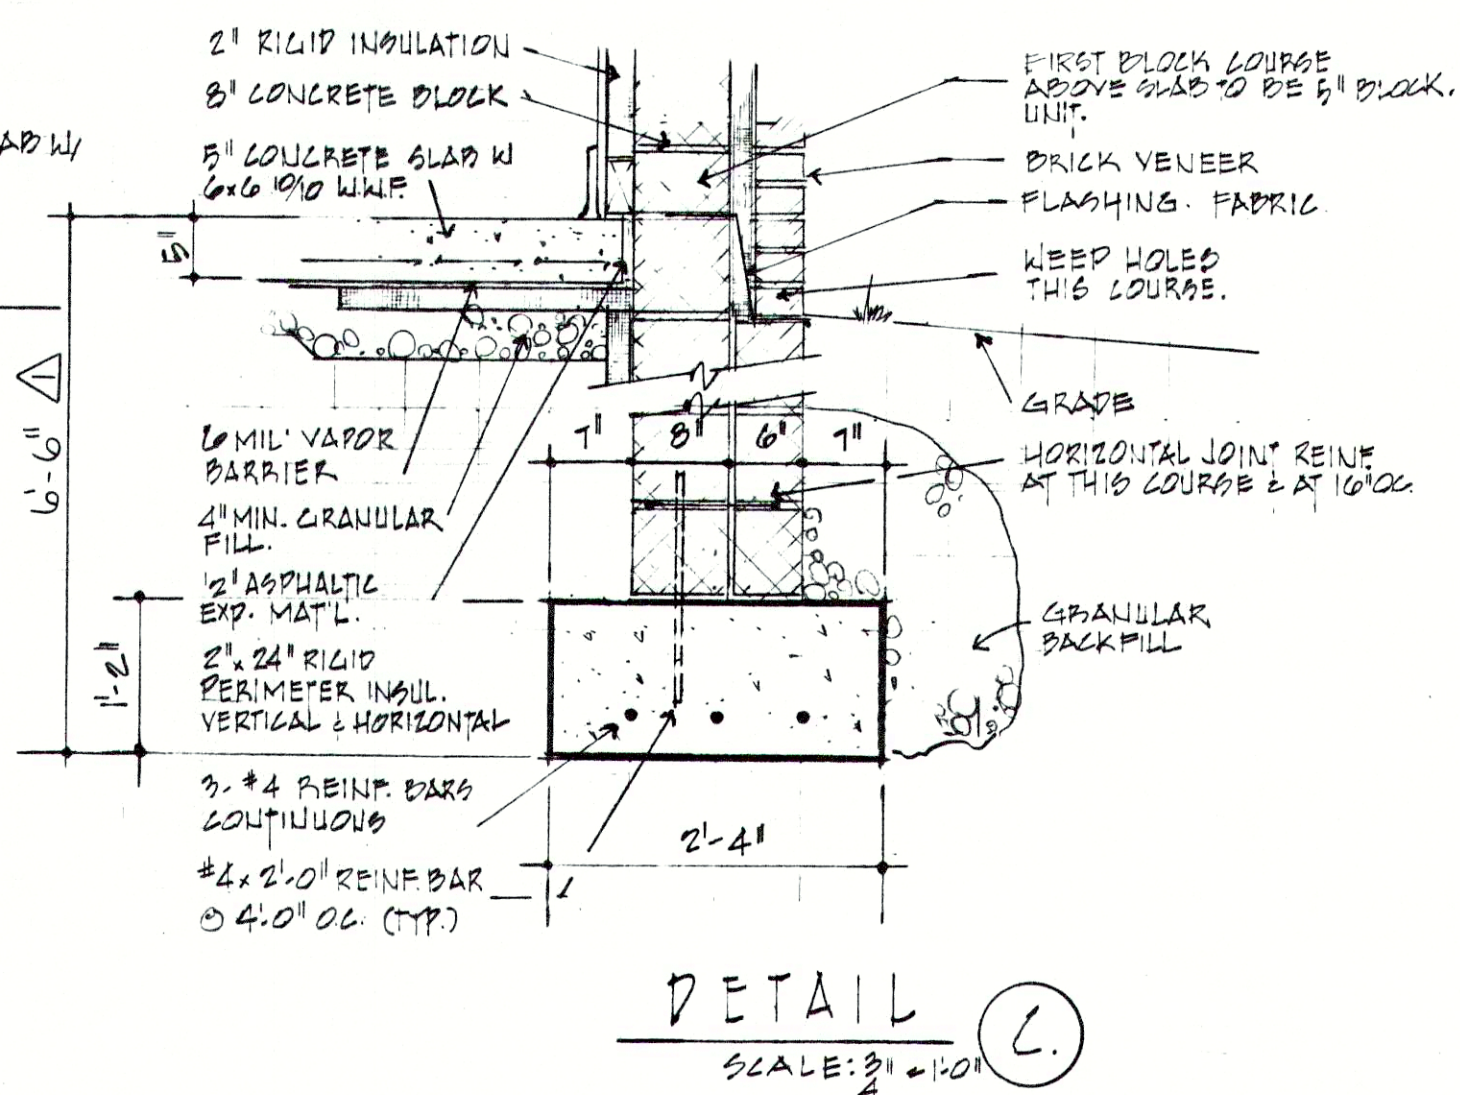
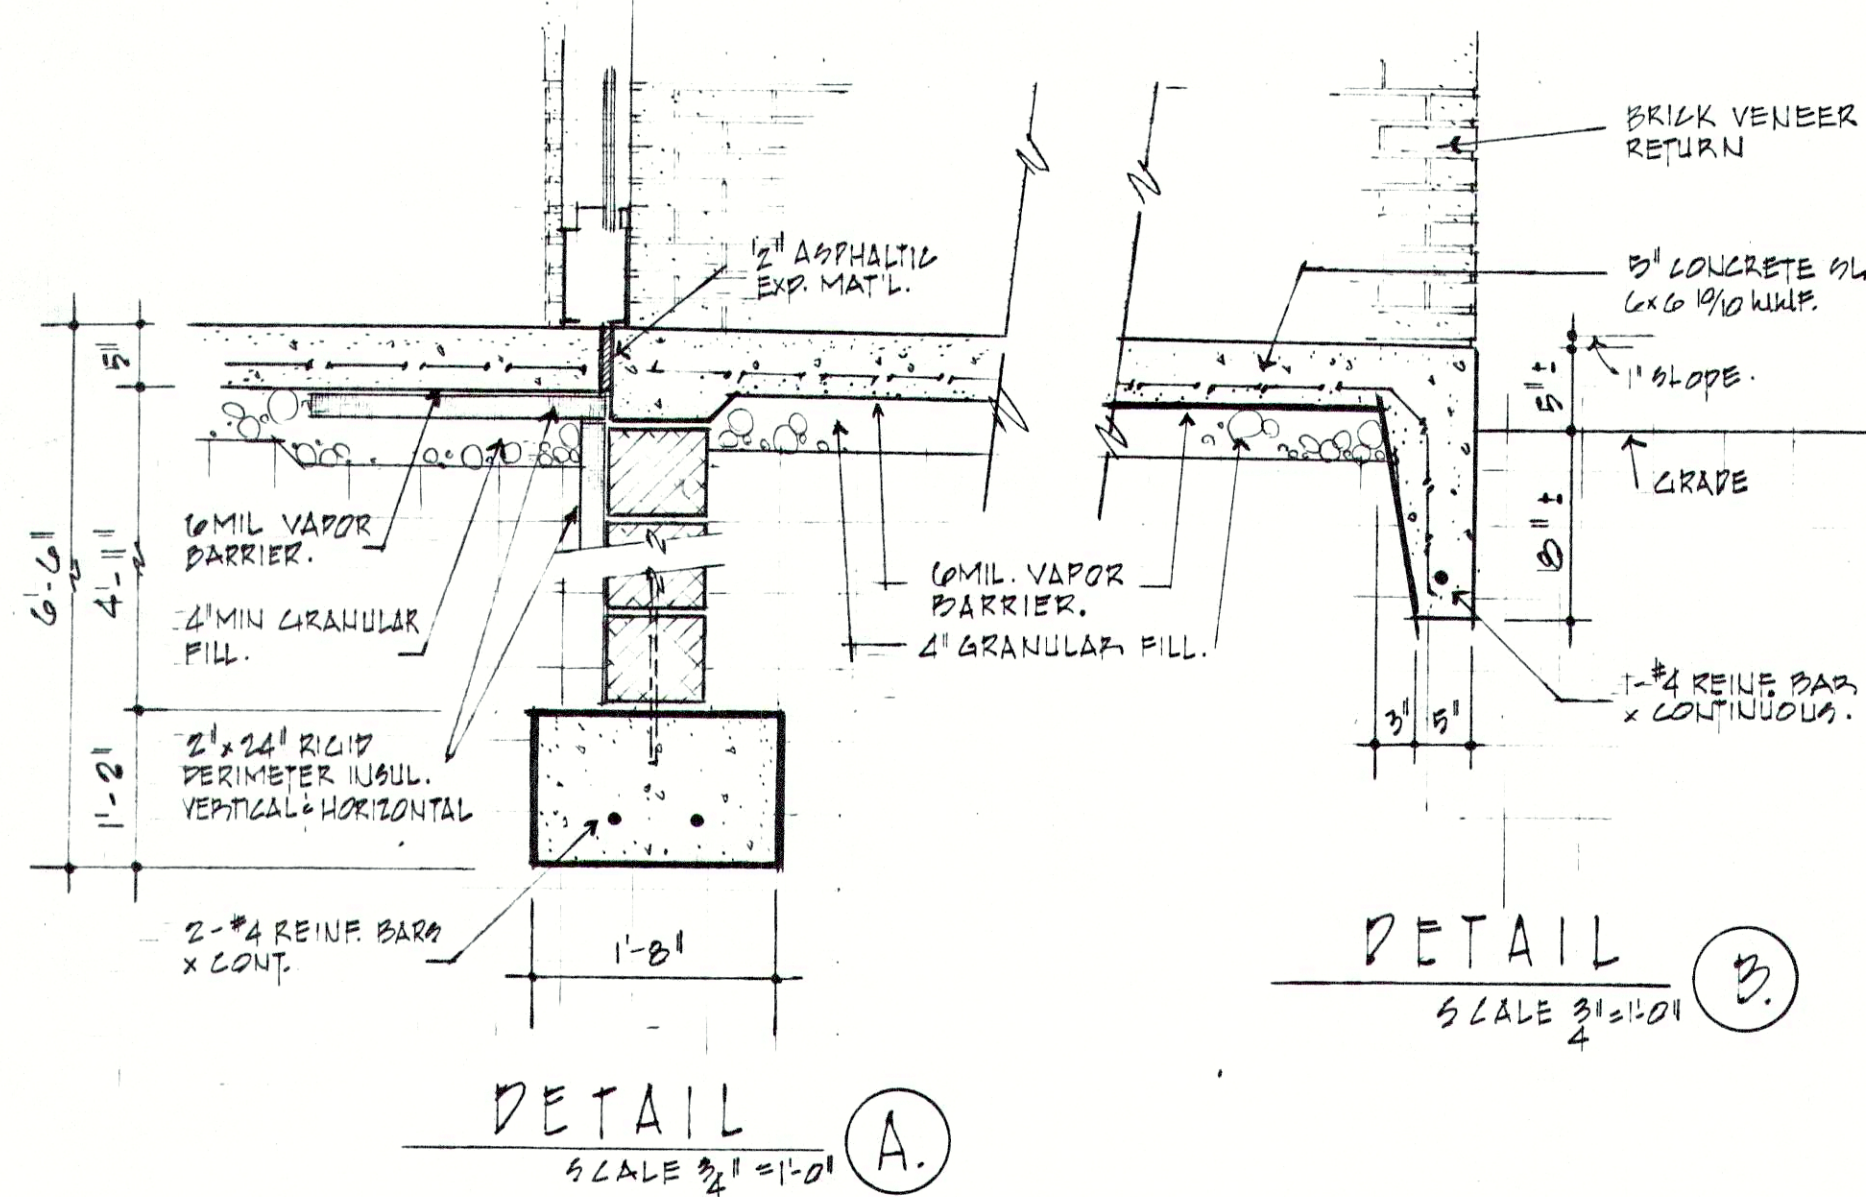
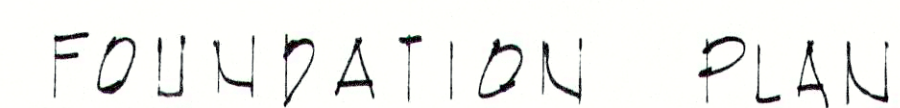
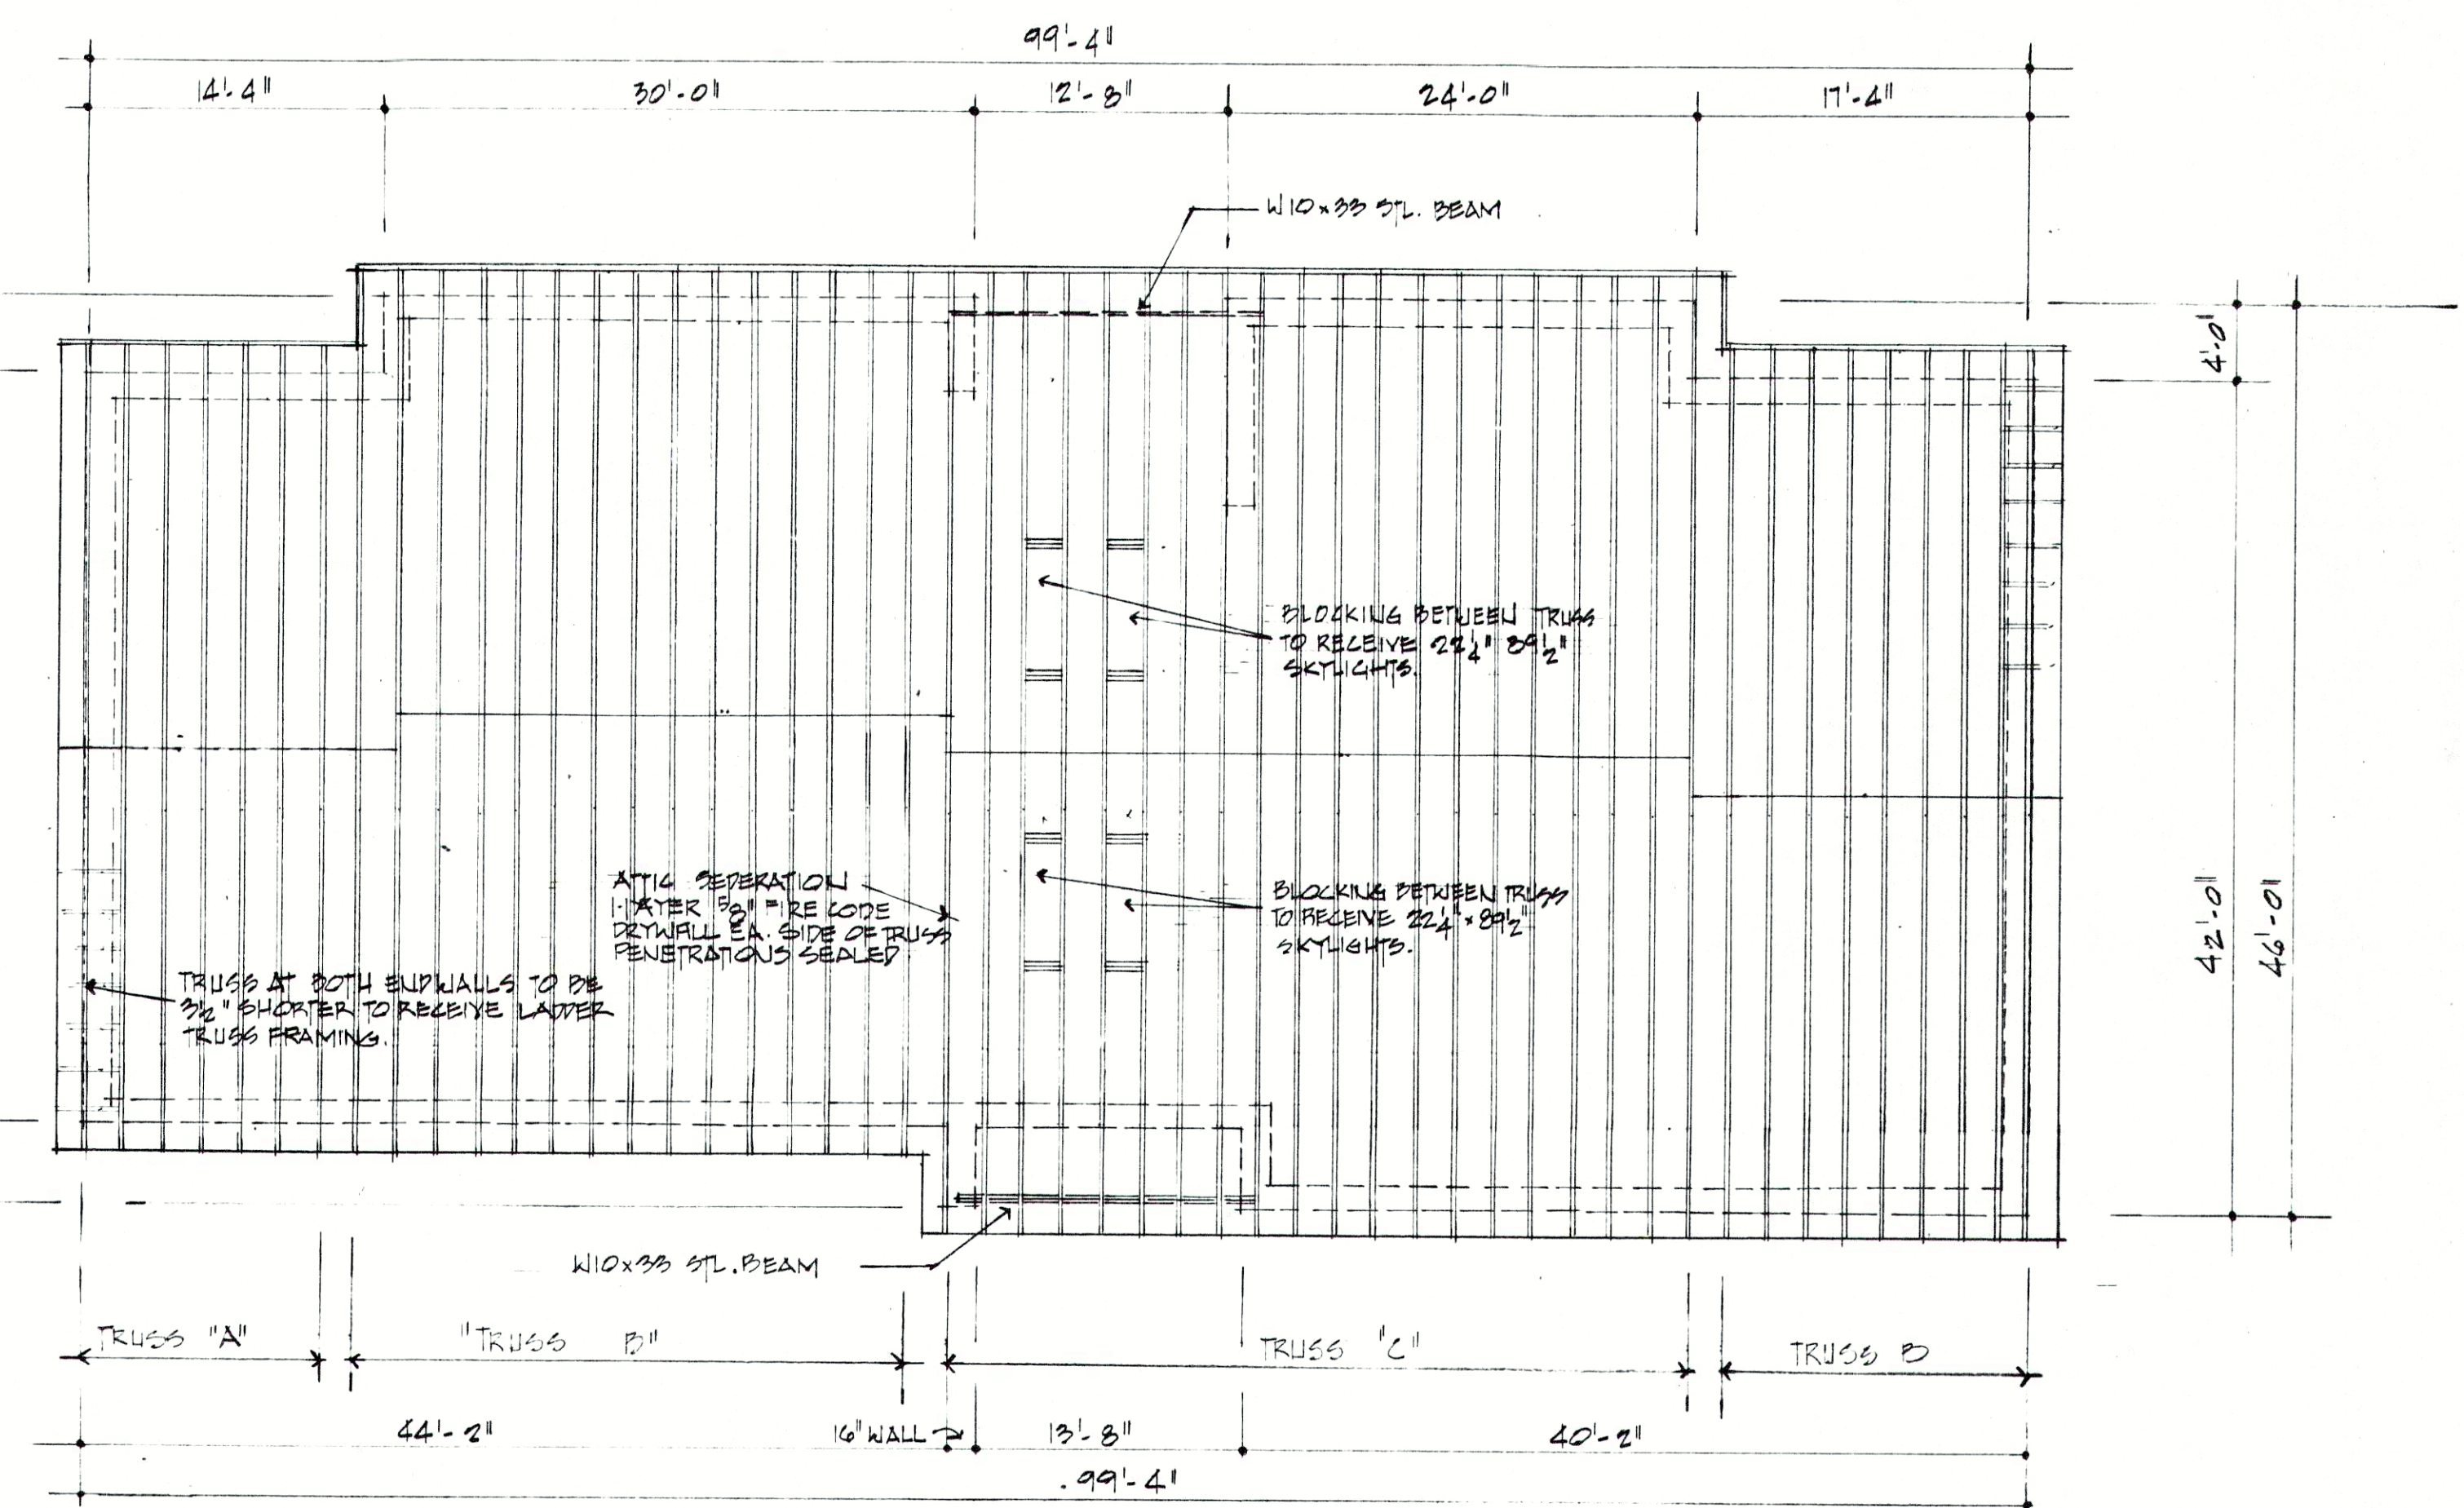


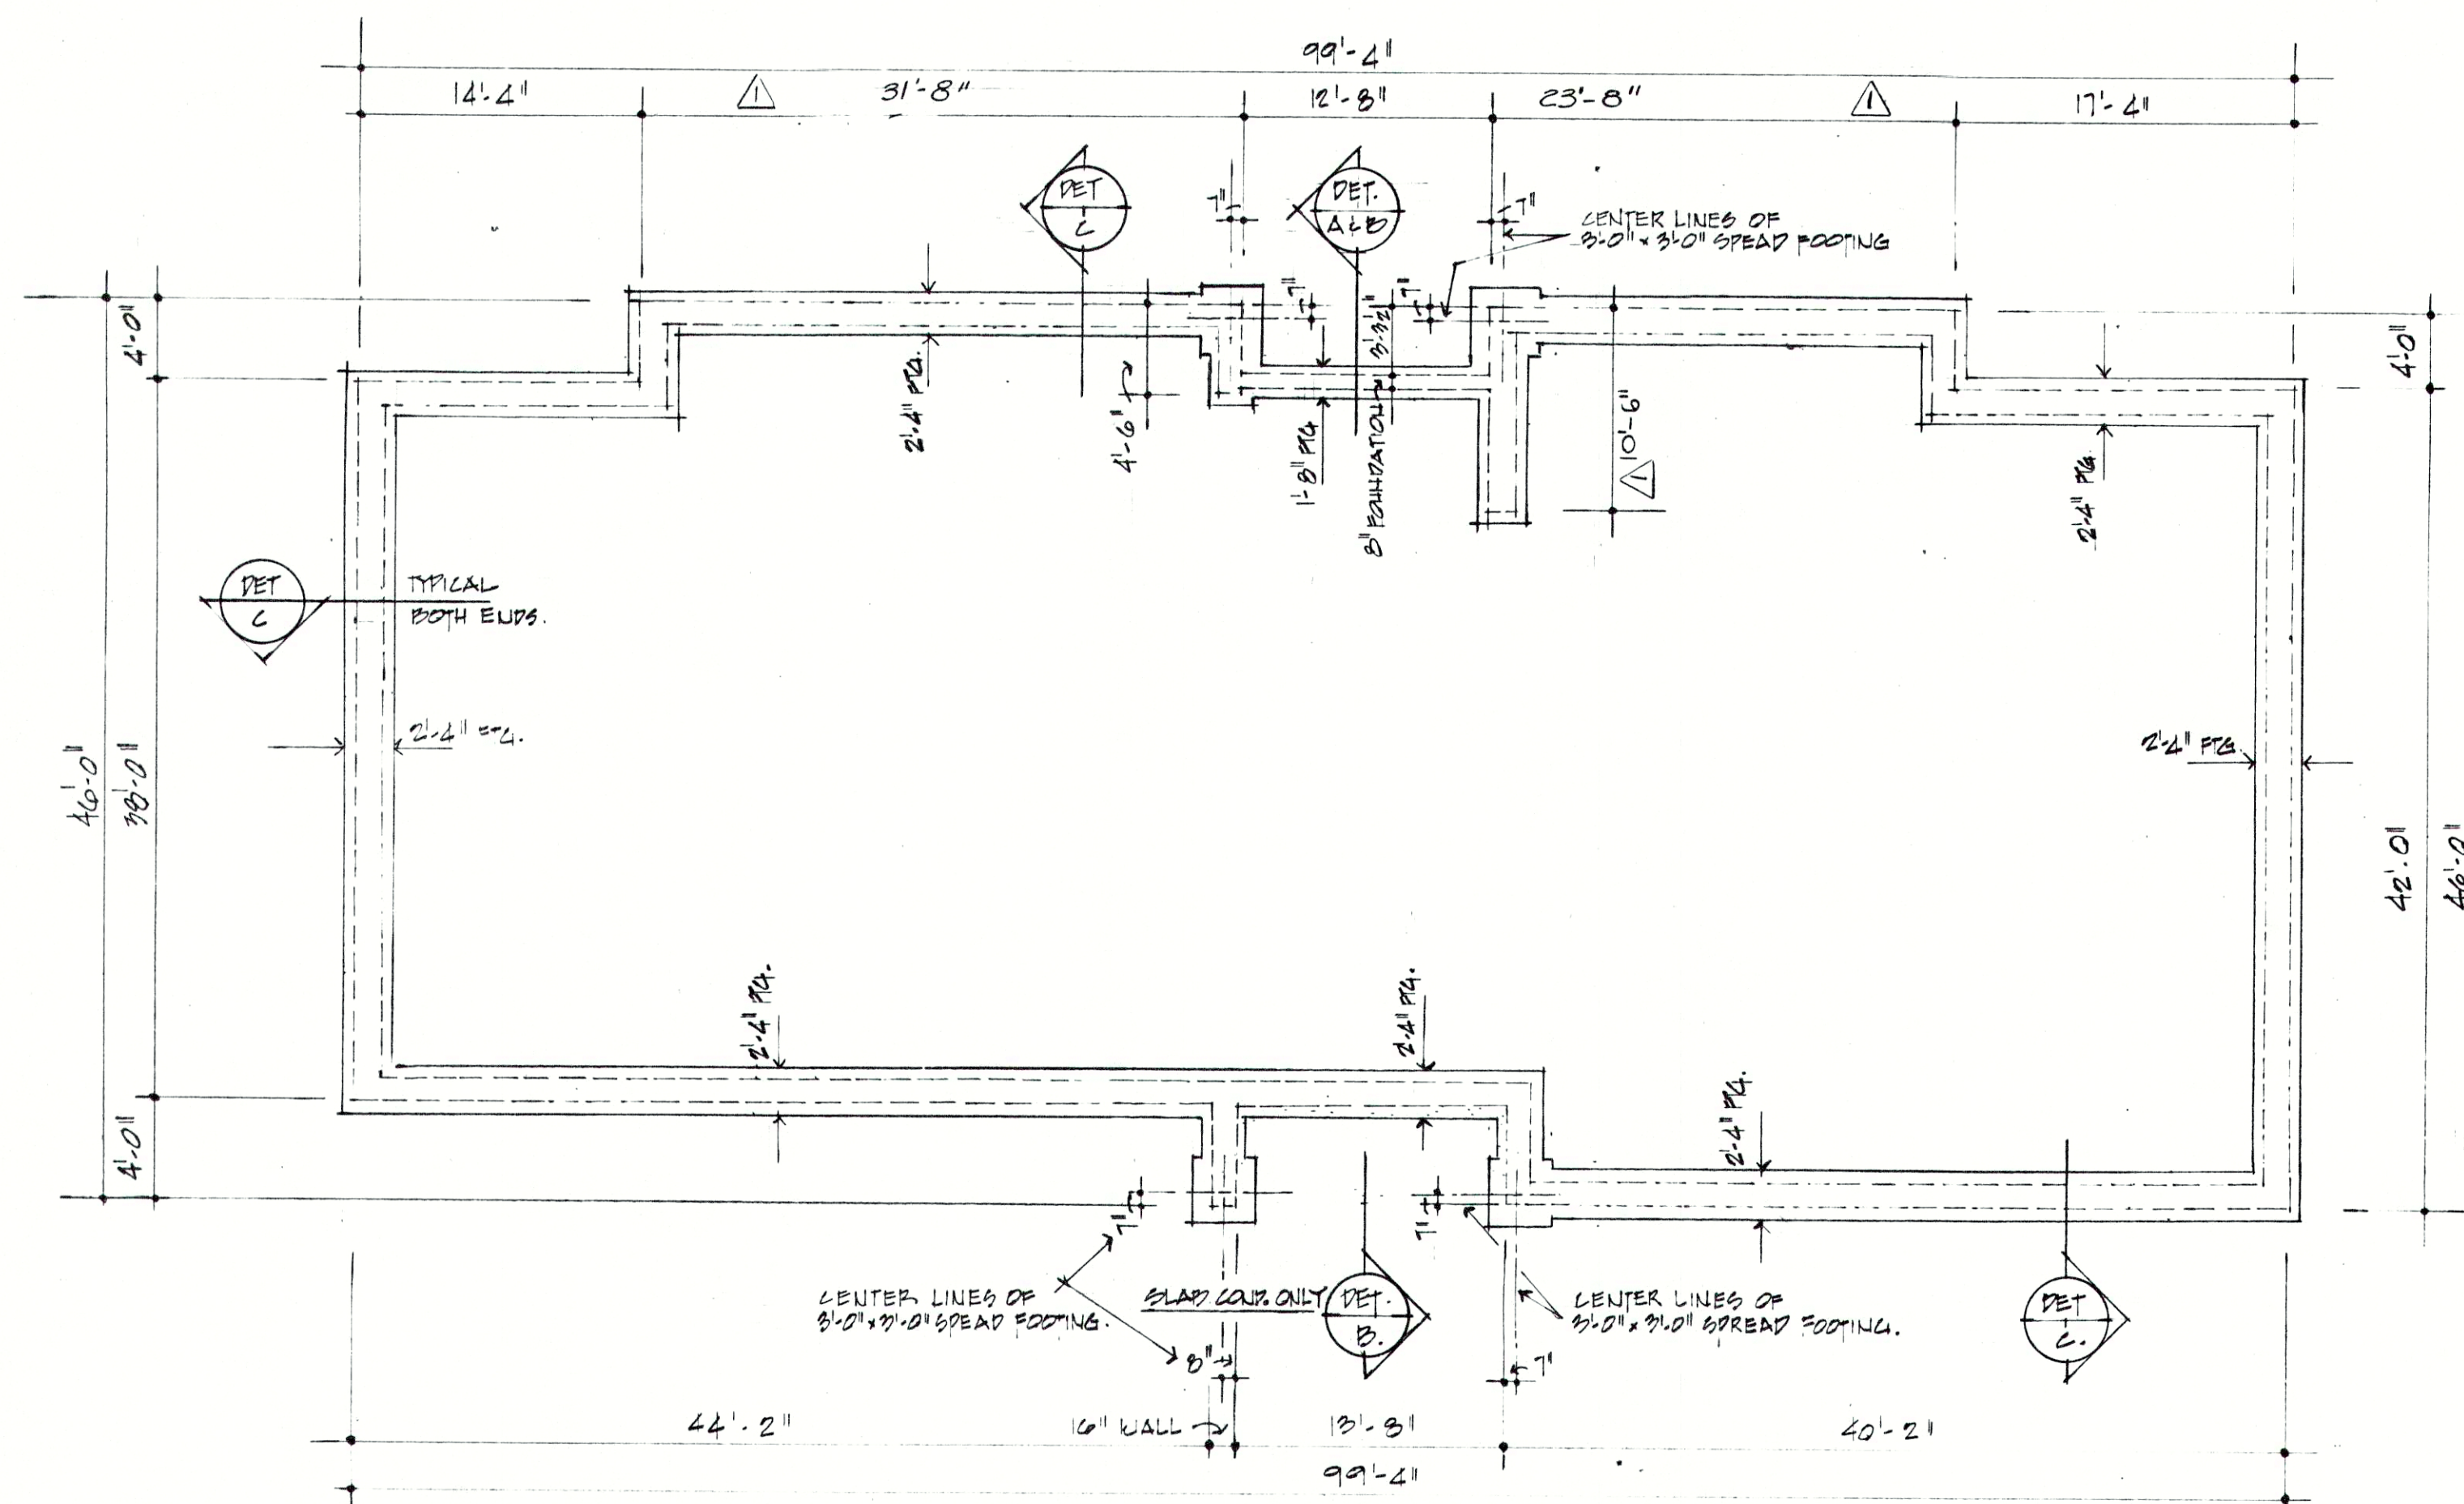

RECORD DRAWING

REVISIONS 1 Rev. 8-24-84 50			FALL CREEK REGIONAL WASTE DISTRICT WASTEWATER FACILITIES PENDLETON, INDIANA				edgibson and associates INCORPORATED ARCHITECTS INDIANAPOLIS, INDIANA DRAWN BY R10 ACCT. NO. CHECKED BY EAG. DATE 3-20-89 CERTIFIED BY: <i>Edwin A. Gibson</i>		SHEET NO. A-5 42
--------------------------------	--	--	--	--	---	--	---	--	-----------------------------------