

DOOR SCHEDULE:

ADMINISTRATION/LABORATORY BLD'G.

DOOR NO.	DOOR SIZE	DOOR THICK.	DOOR TYPE	DOOR MATERIAL	GLASS	DOOR FRAME	HWDR. SET	REMARKS
1	3-0 X 7-0	1-3/4	F	STEEL	SAFETY	SPECIAL SEE DETAILS.	9	
2	3-0 X 7-0	1-3/4	F	STEEL	SAFETY	SPECIAL SEE DETAILS.	7	
3	3-0 X 7-0	1-3/4	F	STEEL	SAFETY	5	7	SIDELIGHT.
4	3-0 X 7-0	1-3/4	F	STEEL	SAFETY	6	9	SIDELIGHT.
5	2-8 X 7-0	1-3/8	C	STEEL	-	7	4	
6	3-0 X 7-0	1-3/8	G	STEEL	1/4" PLATE	7	4	
7	3-0 X 7-0	1-3/4	G	STEEL	1/4" PLATE	8	3	
8	3-0 X 8-1	-	H	WOOD	-	-	-	SEE SPECIFICATIONS.
9	2-6 X 7-0 PR.	1-3/8	G	STEEL	1/4" PLATE	7	10	
10	2-8 X 7-0	1-3/8	G	STEEL	1/4" PLATE	7	4	
11	1-6 X 7-0	1-3/8	D	STEEL	-	7	11	
12	1-6 X 7-0	1-3/8	D	STEEL	-	7	11	
13	2-8 X 7-0	1-3/8	G	STEEL	1/4" PLATE	7	3	
14	3-4 X 7-0	1-3/4	D	STEEL	-	8	4	
15	2-8 X 7-0	1-3/4	D	STEEL	-	8	7	
16	3-0 X 7-0	1-3/4	C	STEEL	-	8	4	
17	1-8 X 7-0	1-3/8	E	STEEL	-	7	8	
18	2-8 X 7-0	1-3/4	D	STEEL	-	8	7	
19	3-0 X 7-0	1-3/4	D	STEEL	-	8	4	
20	3-0 X 7-0	1-3/4	F	STEEL	1/4" PLATE	9	3	FRAME SIMILAR TO #5. SEE NOTE AT FRAME #5.
21	2-8 X 7-0	1-3/4	G	STEEL	1/4" PLATE	7	4	
22	3-0 X 7-0	1-3/4	F	STEEL	1/4" PLATE	10	1	
23	3-0 X 7-0	1-3/4	A	STEEL	1/4" PLATE	6	1	

GARAGE/MAINTENANCE BLD'G.

DOOR NO.	DOOR SIZE	DOOR THICK.	DOOR TYPE	DOOR MATERIAL	GLASS	DOOR FRAME	HWDR. SET	REMARKS
1	3-0 X 7-8	1-3/4	A	STEEL	SAFETY	1	1	
2	3-0 X 7-8	1-3/4	A	STEEL	SAFETY	1	1	
3	3-0 X 7-8	1-3/4	A	STEEL	SAFETY	1	1	
4	3-0 X 7-8	1-3/4	A	STEEL	SAFETY	1	1	
5	12-0 X 12-0	1-1/2	B	STEEL	PLASTIC	2	2	ROLL-UP SECTIONAL
6	10-0 X 10-0	1-1/2	B	STEEL	PLASTIC	2	2	ROLL-UP SECTIONAL
7	10-0 X 10-0	1-1/2	B	STEEL	PLASTIC	2	2	ROLL-UP SECTIONAL
8	2-8 X 7-0	1-3/4	A	STEEL	SAFETY	3	3	
9	2-8 X 7-0	1-3/4	C	STEEL	-	3	4	
10	3-0 X 7-0 PR.	1-3/4	A	STEEL	SAFETY	4	5	"T" ASTRAGAL
11	3-0 X 7-0 PR.	1-3/4	D	STEEL	-	1	6	
12	2-8 X 7-0	1-3/4	A	STEEL	SAFETY	3	3	
13	2-8 X 7-0	1-3/4	C	STEEL	-	3	7	
14	2-8 X 7-0	1-3/4	C	STEEL	-	3	7	
15	1-8 X 7-0	1-3/4	E	STEEL	-	3	8	
16	2-8 X 7-0	1-3/4	C	STEEL	-	3	7	
17	2-8 X 7-0	1-3/4	C	STEEL	-	3	4	

DOOR SCHEDULE:

MECHANICAL BLD'G.

DOOR NO.	DOOR SIZE	DOOR THICK.	DOOR TYPE	DOOR MATERIAL	GLASS	DOOR FRAME	HWDR. SET	REMARKS
1	3-0 X 7-0 PR.	1-3/4	A	STEEL	SAFETY	1	5	
2	3-0 X 7-0	1-3/4	A	STEEL	SAFETY	1	1	
3	3-0 X 7-0	1-3/4	H	STEEL	-	11	12	ACOUSTICAL SEAL FRAME
4	3-0 X 7-0	1-3/4	H	STEEL	-	11	13	ACOUSTICAL SEAL FRAME AND MULLION BY DOOR MANUFACTURER.
5	3-0 X 7-0	1-3/4	A	STEEL	SAFETY	12	14	
6	3-0 X 7-0	1-3/4	A	STEEL	SAFETY	1	5	
7	3-0 X 7-0	1-3/4	A	STEEL	SAFETY	1	1	

GRIT REMOVAL BLD'G.


DOOR NO.	DOOR SIZE	DOOR THICK.	DOOR TYPE	DOOR MATERIAL	GLASS	DOOR FRAME	HWDR. SET	REMARKS
101	3-0 X 7-0	1-3/4	A	STEEL	SAFETY	1	1	
102	8-0 X 8-0	1-1/2	B	STEEL	PLASTIC	14	2	ROLL-UP SECTIONAL.

DIGESTOR BLD'G.


DOOR NO.	DOOR SIZE	DOOR THICK.	DOOR TYPE	DOOR MATERIAL	GLASS	DOOR FRAME	HWDR. SET	REMARKS
101	3-0 X 7-0 PR.	1-3/4	A	STEEL	SAFETY	1	5	
102	3-0 X 7-0 PR.	1-3/4	A	STEEL	SAFETY	1	5	

CHLORINE BLD'G.

DOOR NO.	DOOR SIZE	DOOR THICK.	DOOR TYPE	DOOR MATERIAL	GLASS	DOOR FRAME	HWDR. SET	REMARKS
1	3-0 X 7-0 PR.	1-3/4	A	ALUMINUM	SAFETY	13	15	


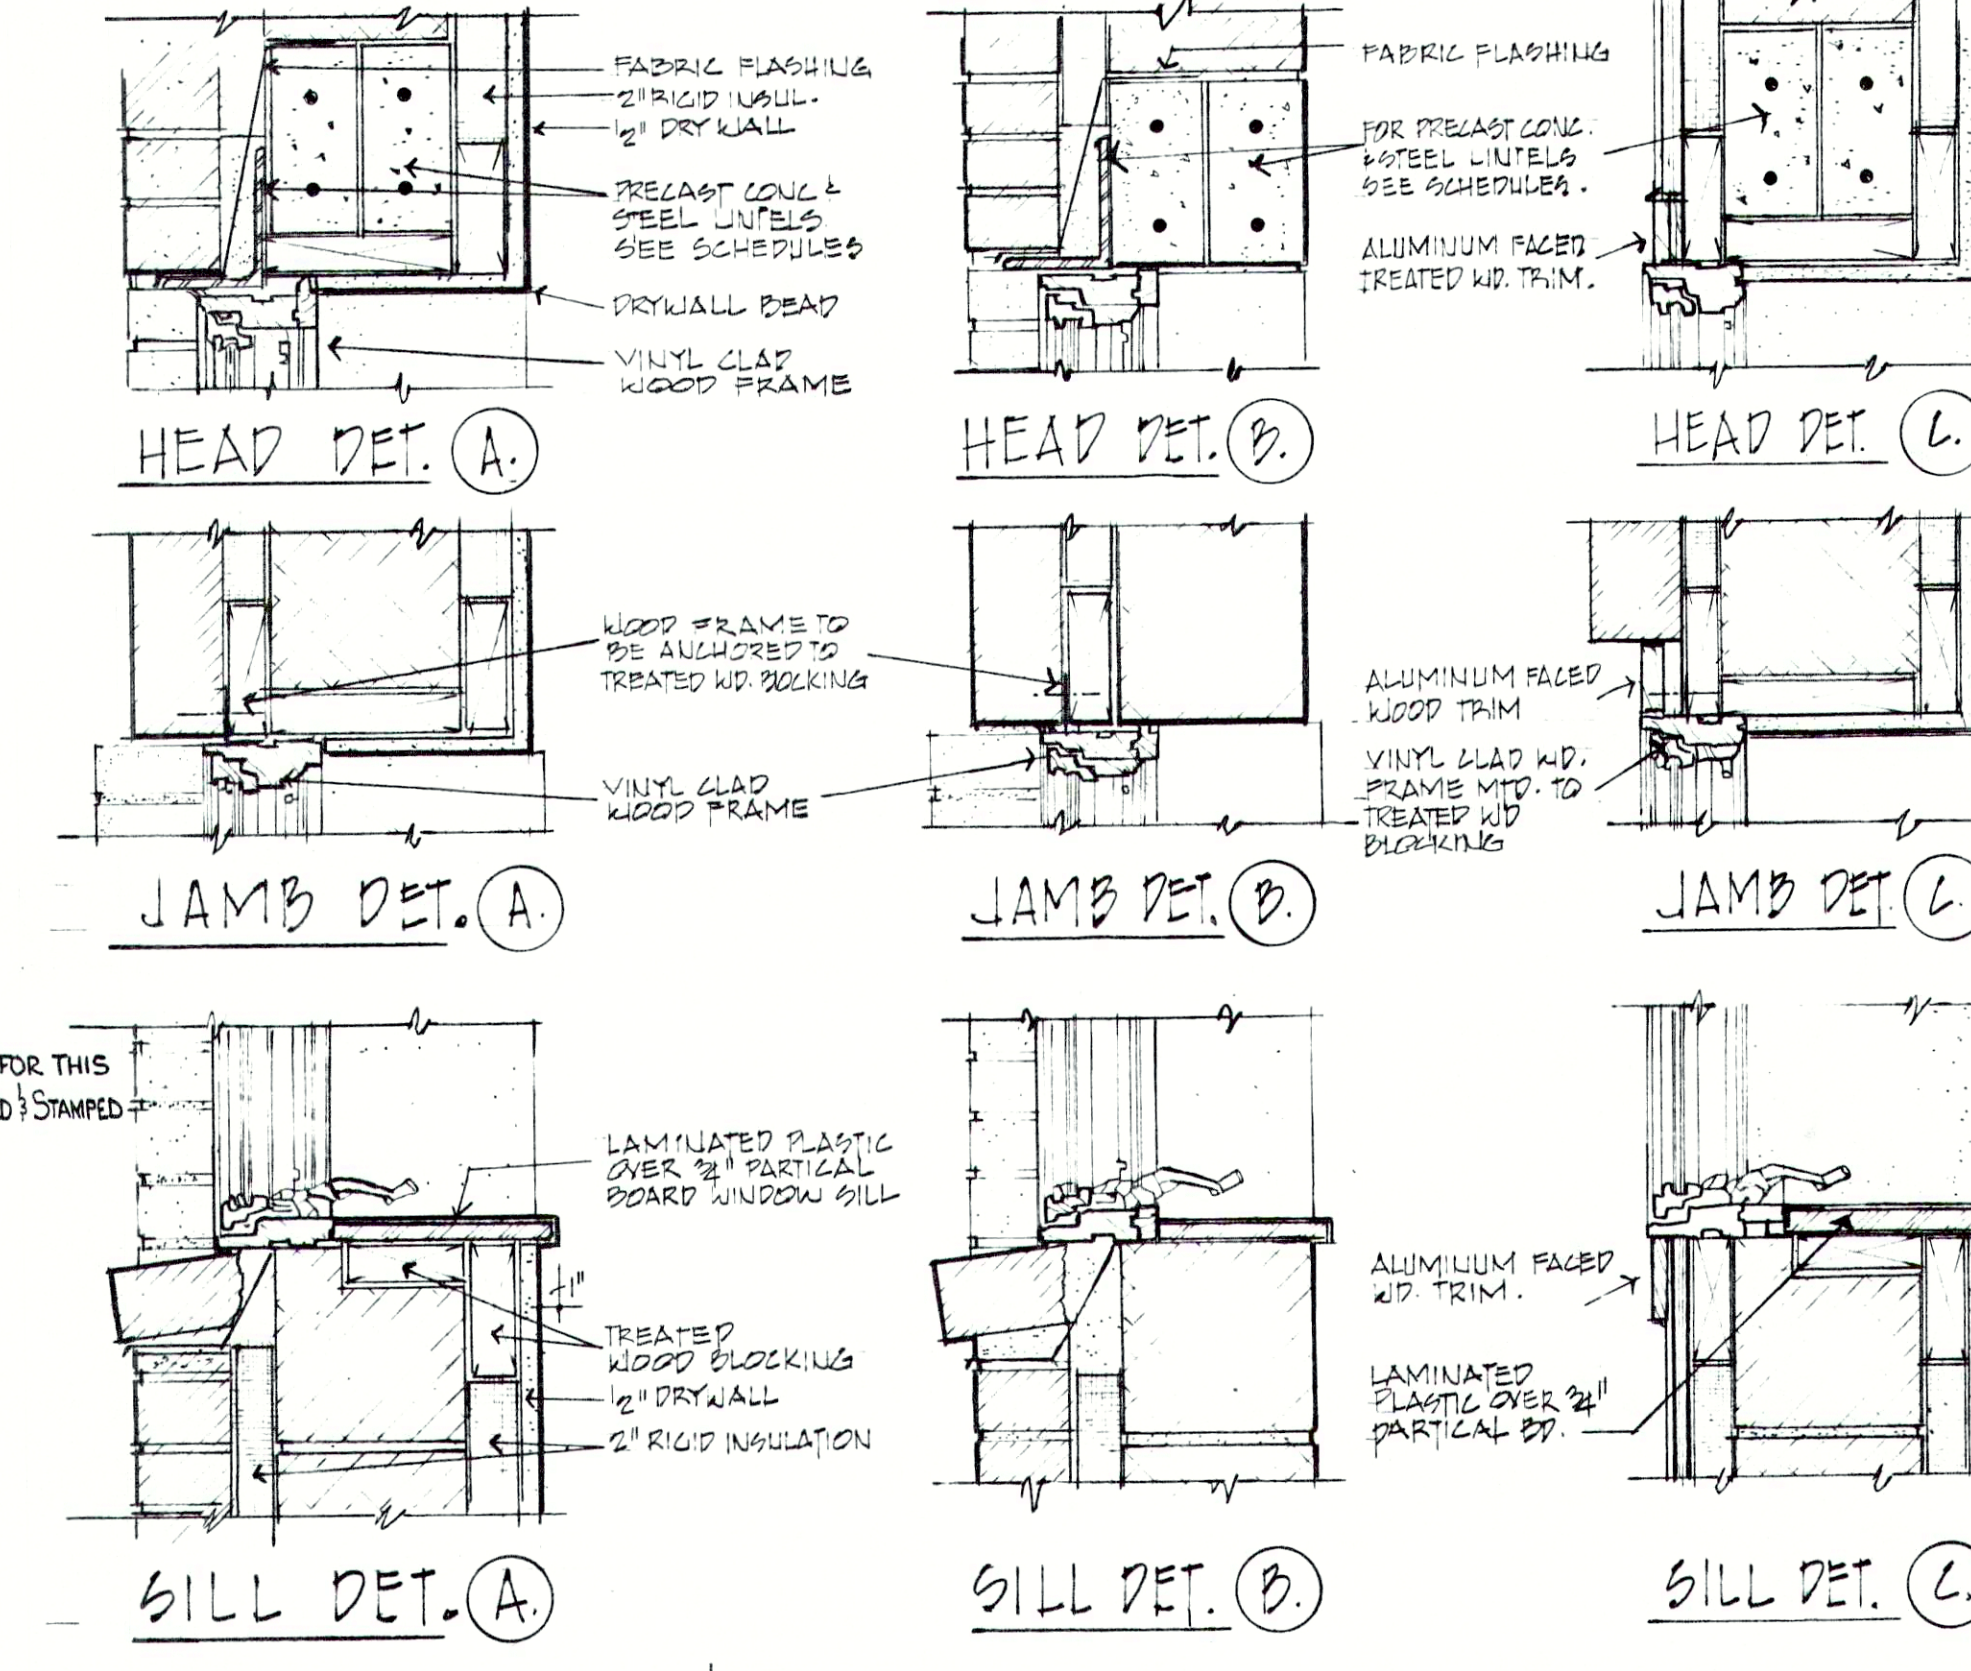


DOOR TYPES:

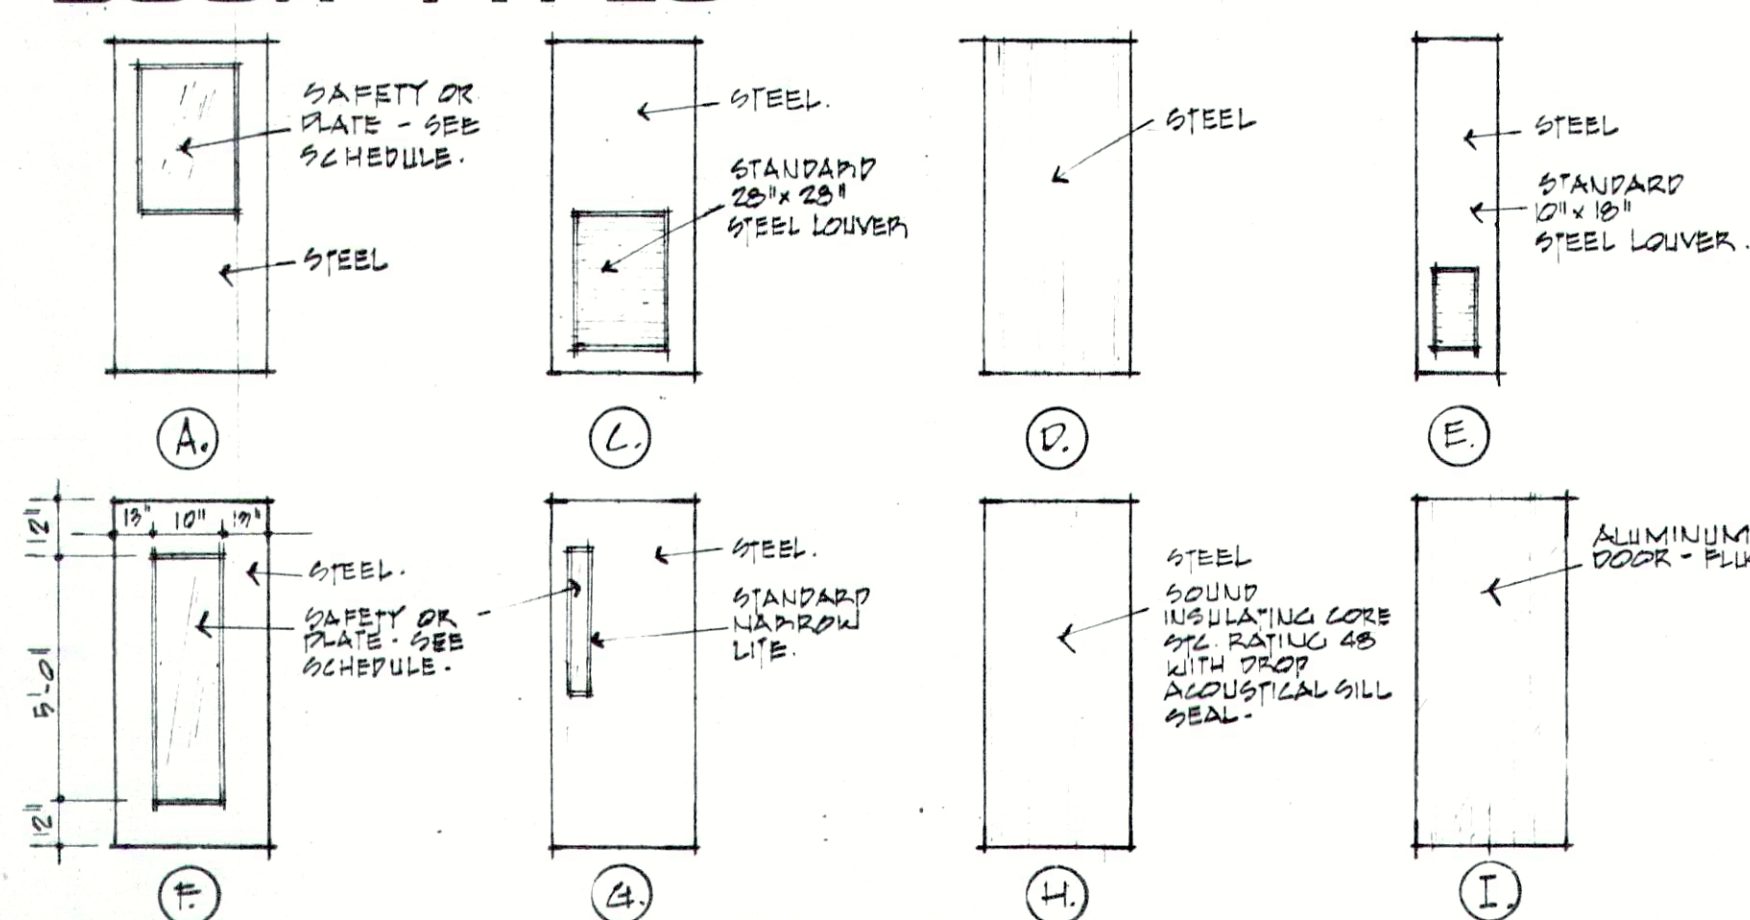

- WINDOW DETAIL NOTES:
1. HEAD, JAMB & SILL DETAILS A. APPLY TO ADMINISTRATION/LABORATORY BLD'G. ONLY.
 2. HEAD, JAMB & SILL DETAILS B. APPLY TO ALL OTHER BLD'GS INCLUDING GARAGE/MAINTENANCE BLD'G, MECHANICAL, GRIT, DIGESTOR & CHLORINE BUILDINGS.
 3. HEAD JAMB & SILL DETAILS C. APPLY TO ADMINISTRATION/LABORATORY BLD'GS. END WALL COND.
 4. ALL DETAILS ARE DRAWN AT 1/2" = 1'-0"

WINDOW TYPES:

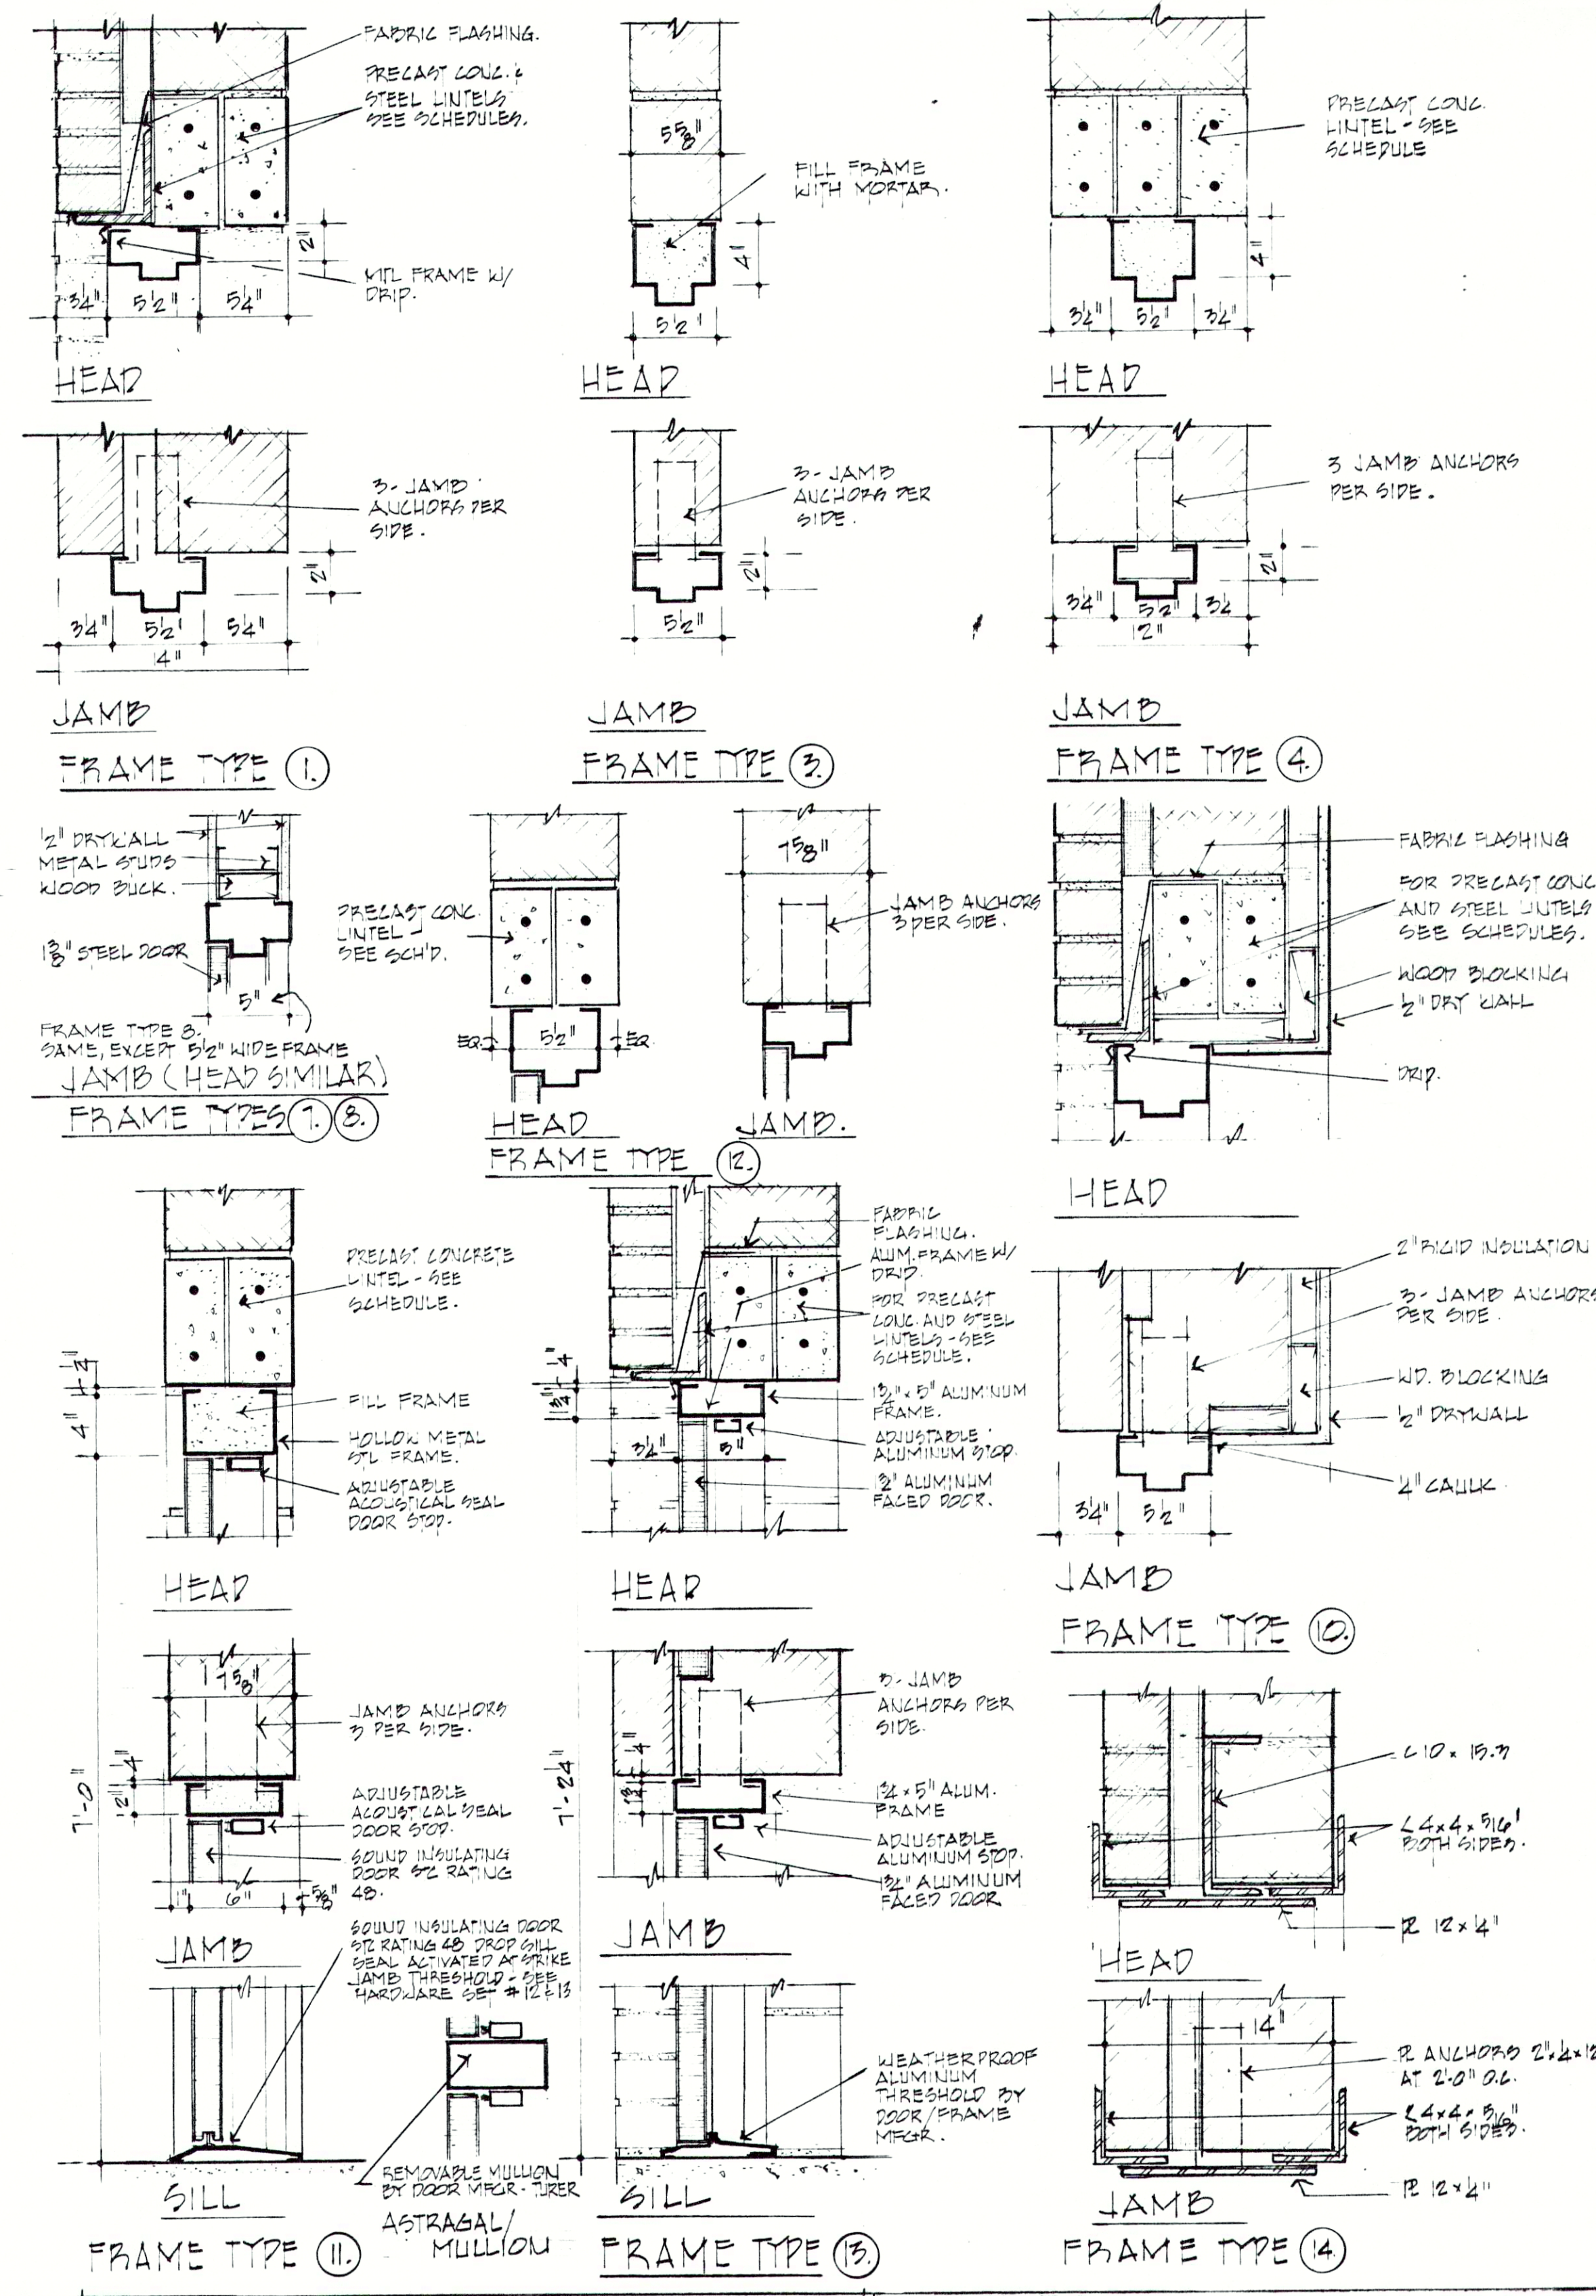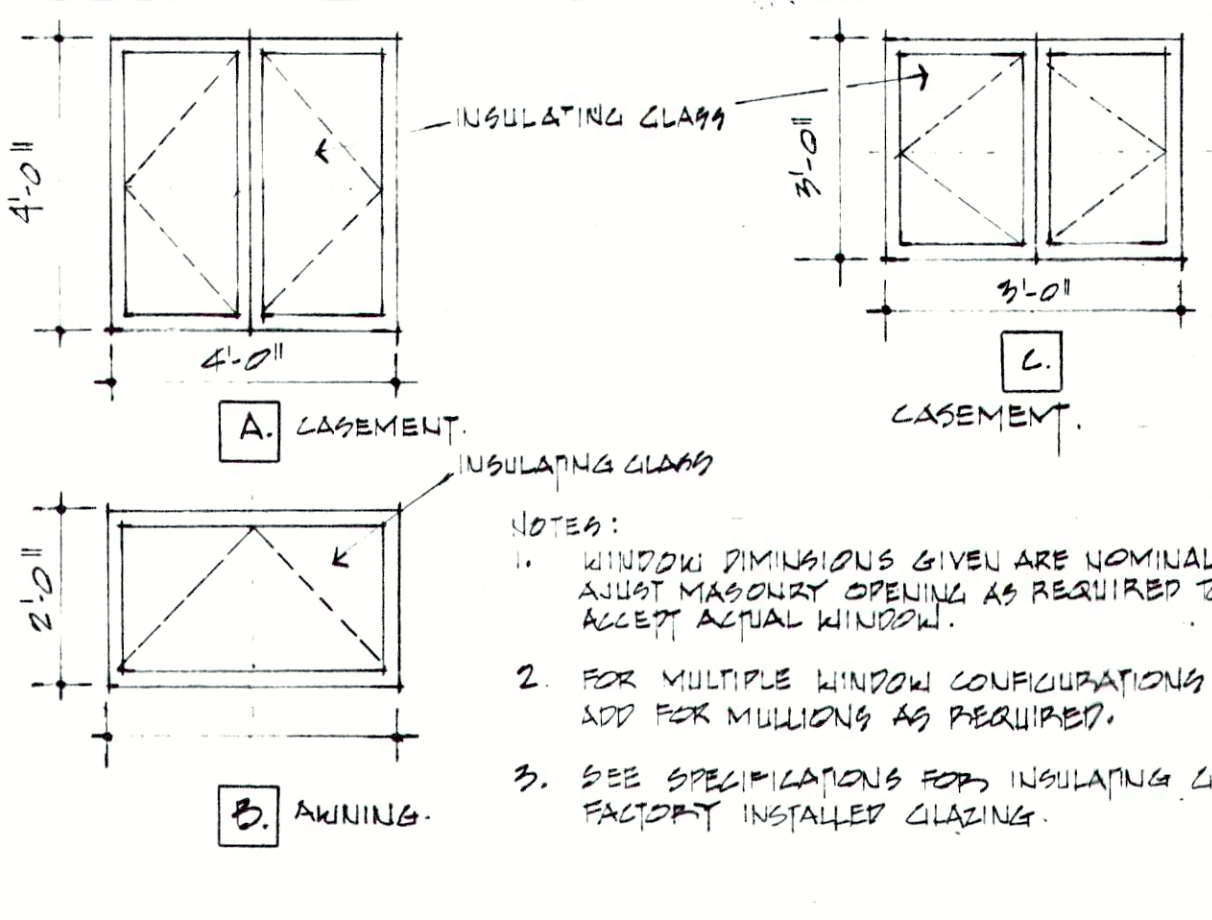

PRECAST CONCRETE LINTEL SCHEDULE

Safe Uniform superimposed loads, Pounds per Linear Foot, based on the use of the above reinforcing.

KIND	**CLEAR SPAN	2'-8"	3'-4"	4'-0"	4'-8"	6'-0"	8'-0"
4" x 8"		820 lbs.	650 lbs.	530 lbs.	310 lbs.	335 lbs.	180 lbs.
6" x 8"		1265 lbs.	1010 lbs.	825 lbs.	485 lbs.	520 lbs.	280 lbs.
8" x 8"		1720 lbs.	1370 lbs.	1135 lbs.	660 lbs.	710 lbs.	380 lbs.


**Based on a minimum 8" bearing projected into masonry.

It is recommended that lintels either over 10'-8" in length or larger than 8" x 12" be poured in place at the job site. A lintel design reference manual is available upon request for lintel loadings greater than indicated above. Lintels with increased steel size, hooked ends or stirrups will be made to order. Special shaped lintels also can be made to order.

RECORD DRAWING

REVISIONS	DATE	BY
1	REV. 6-29-83	ELN

FALL CREEK REGIONAL
WASTE DISTRICT
WASTEWATER FACILITIES
PENDLETON, INDIANA

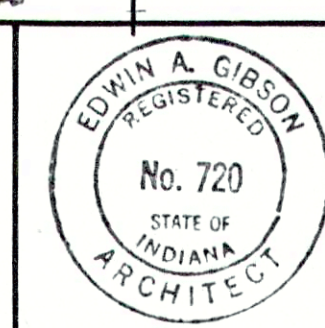

edgibson and associates

ARCHITECTS
INDIANAPOLIS, INDIANA

DRAWN BY: RLD ACCT. NO.

CHECKED BY: E.A.G. DATE: 3-30-83

CERTIFIED BY: Edw. A. Gibson

SHEET NO.
A-15
52